



PROFILE
SCALE: Horiz. 1"=50'
Vert. 1"=5'

PROFILE
SCALE: Horiz. 1"=50'
Vert. 1"=5'

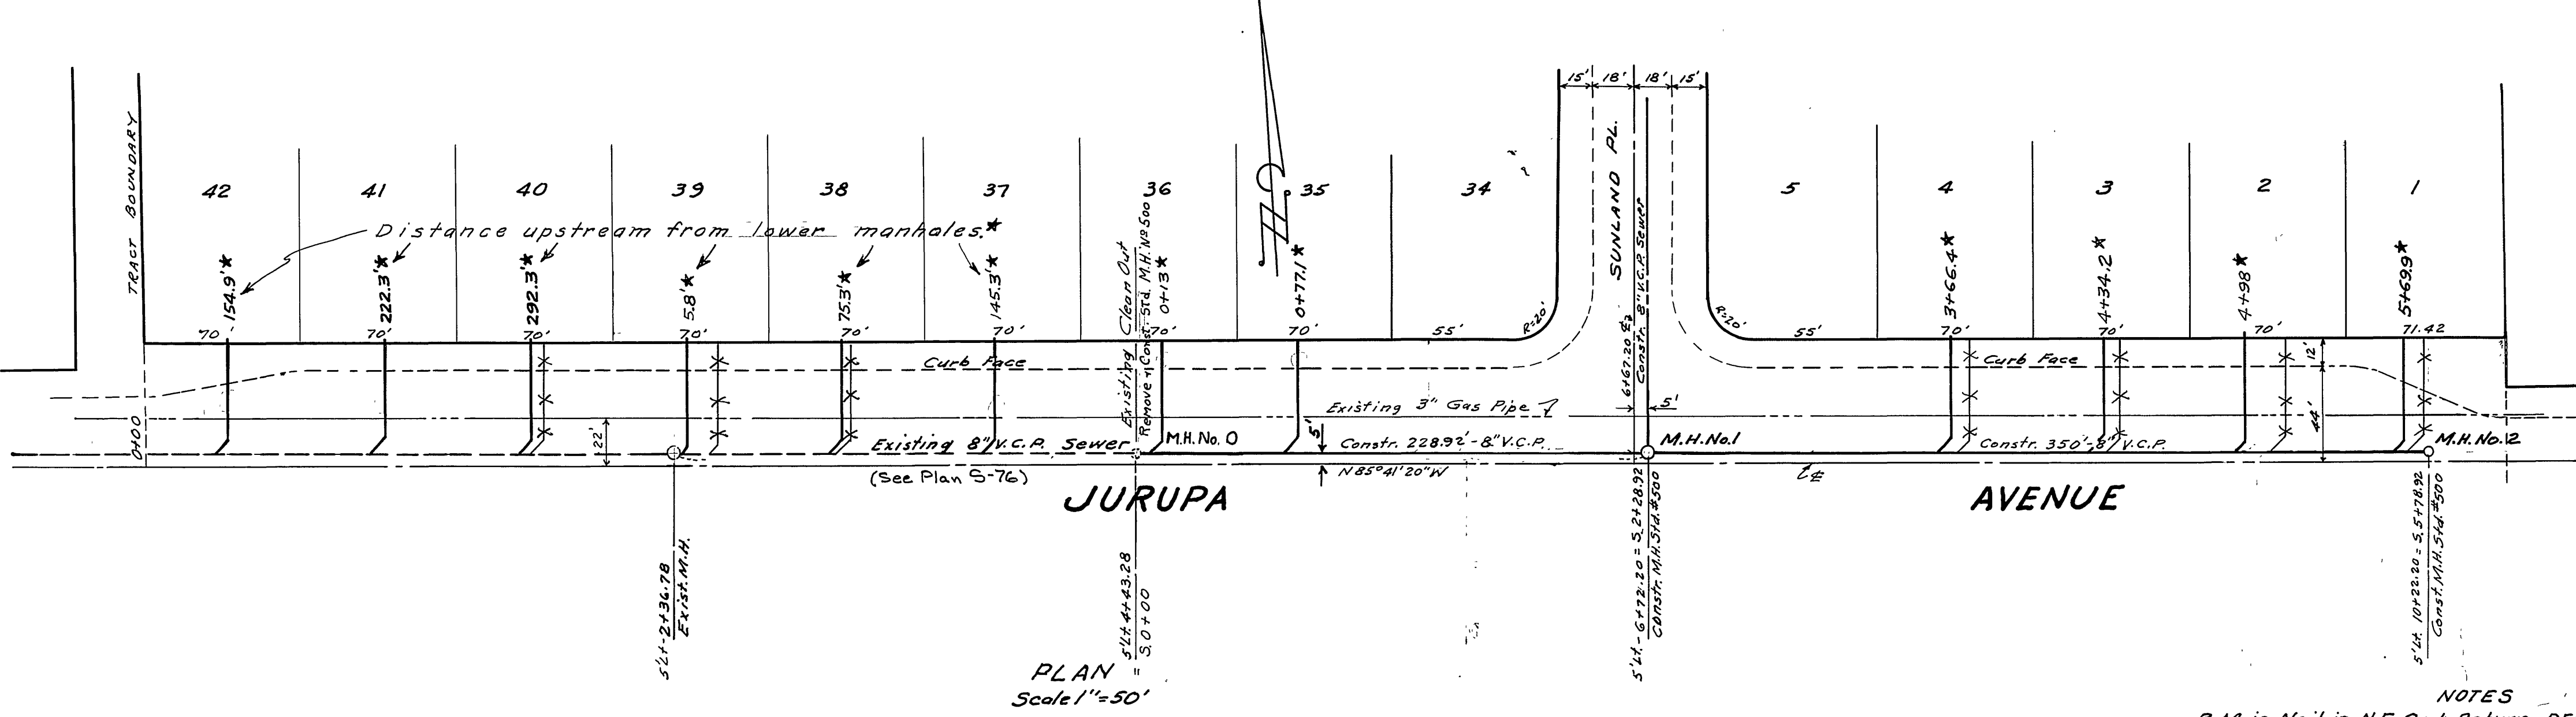

PLAN
Scale 1"=50'

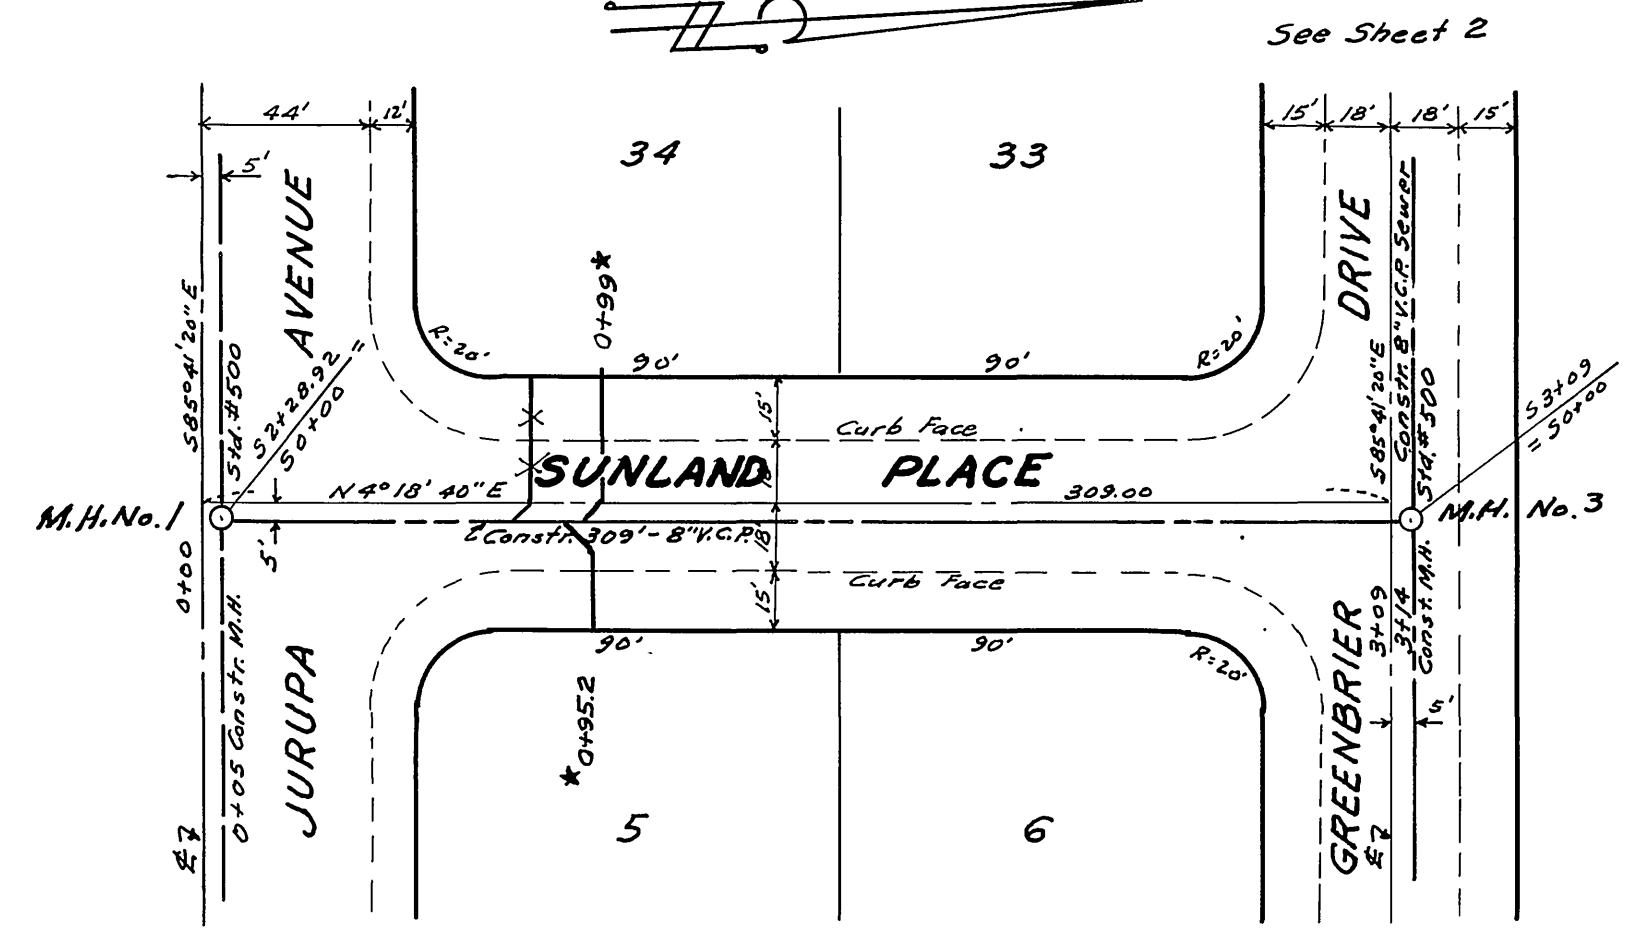

PLAN
Scale 1"=50'

SEE PLAN S-76 FOR S'LY SIDE LATERAL LOCATIONS

NOTES
B.M. is Nail in N.E. Curb Return - DEERFIELD RD. & JURUPA AVE., Elevation 788.59.

Exact Location of all 4" house connection laterals to be determined in the field.

* = "As Built" sewer laterals, 4-23-59, H. Ball

DONALD J. MCKEE-LIC. SURVEYOR
L.S. No. 1825
Riverside, California
Approved by *Donald J. McKee* Date 1/14/59



CITY OF RIVERSIDE, CALIFORNIA
DEPARTMENT OF PUBLIC WORKS

JURUPA AVENUE AND
SUNLAND PLACE
SEWER PLANS AND PROFILES

SUNLAND ESTATES
Horiz. Scale 1"=50' Vert. Scale 1"=5'

Approved by *Donald J. McKee*
Director of Public Works
Date Feb. 3, 1959

FILE NO. **S-159**
Sheet 1 of 2

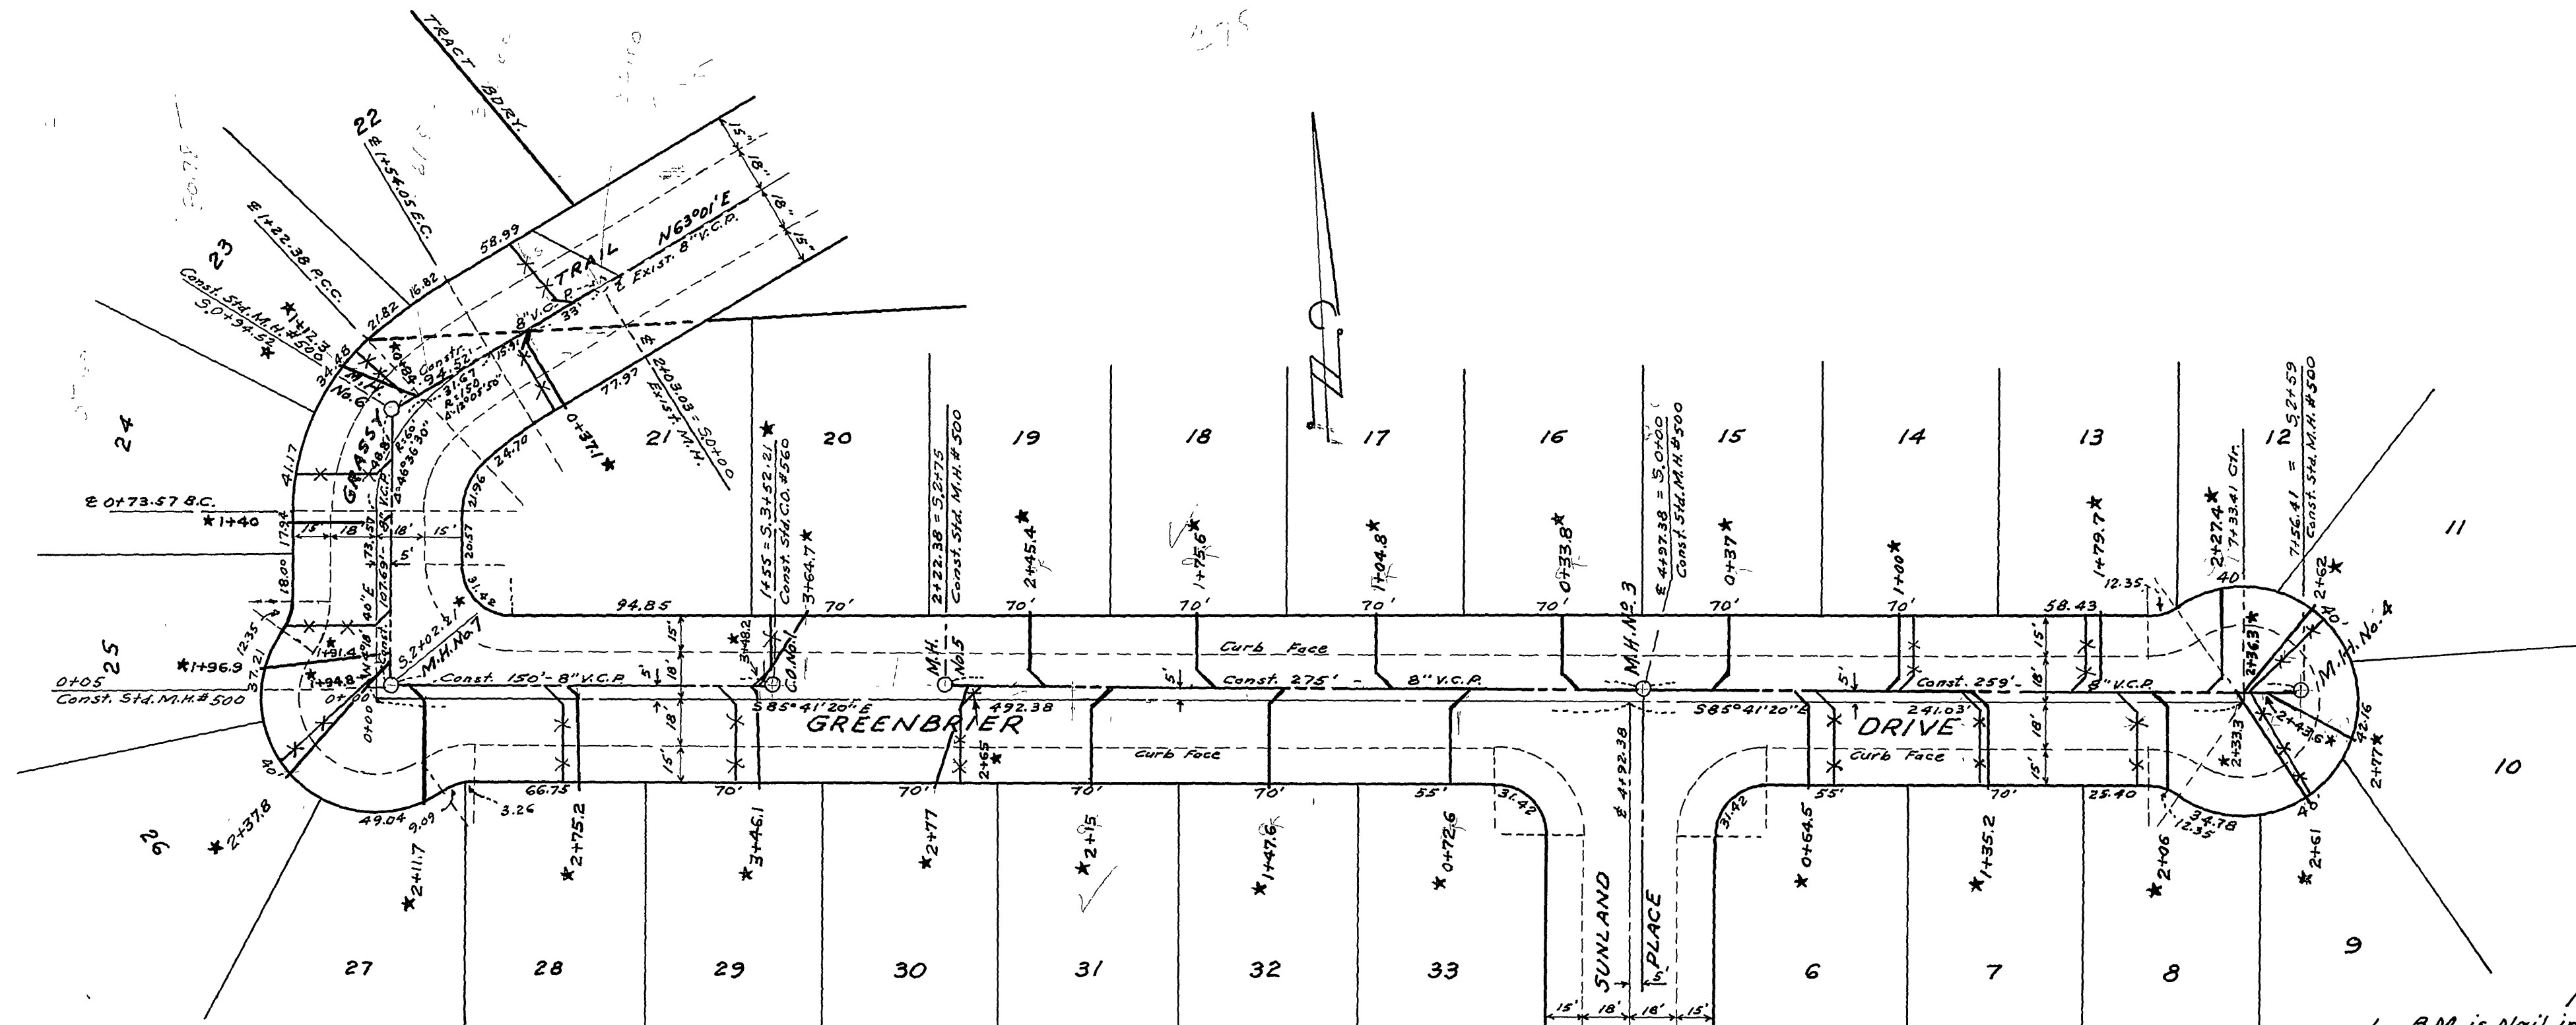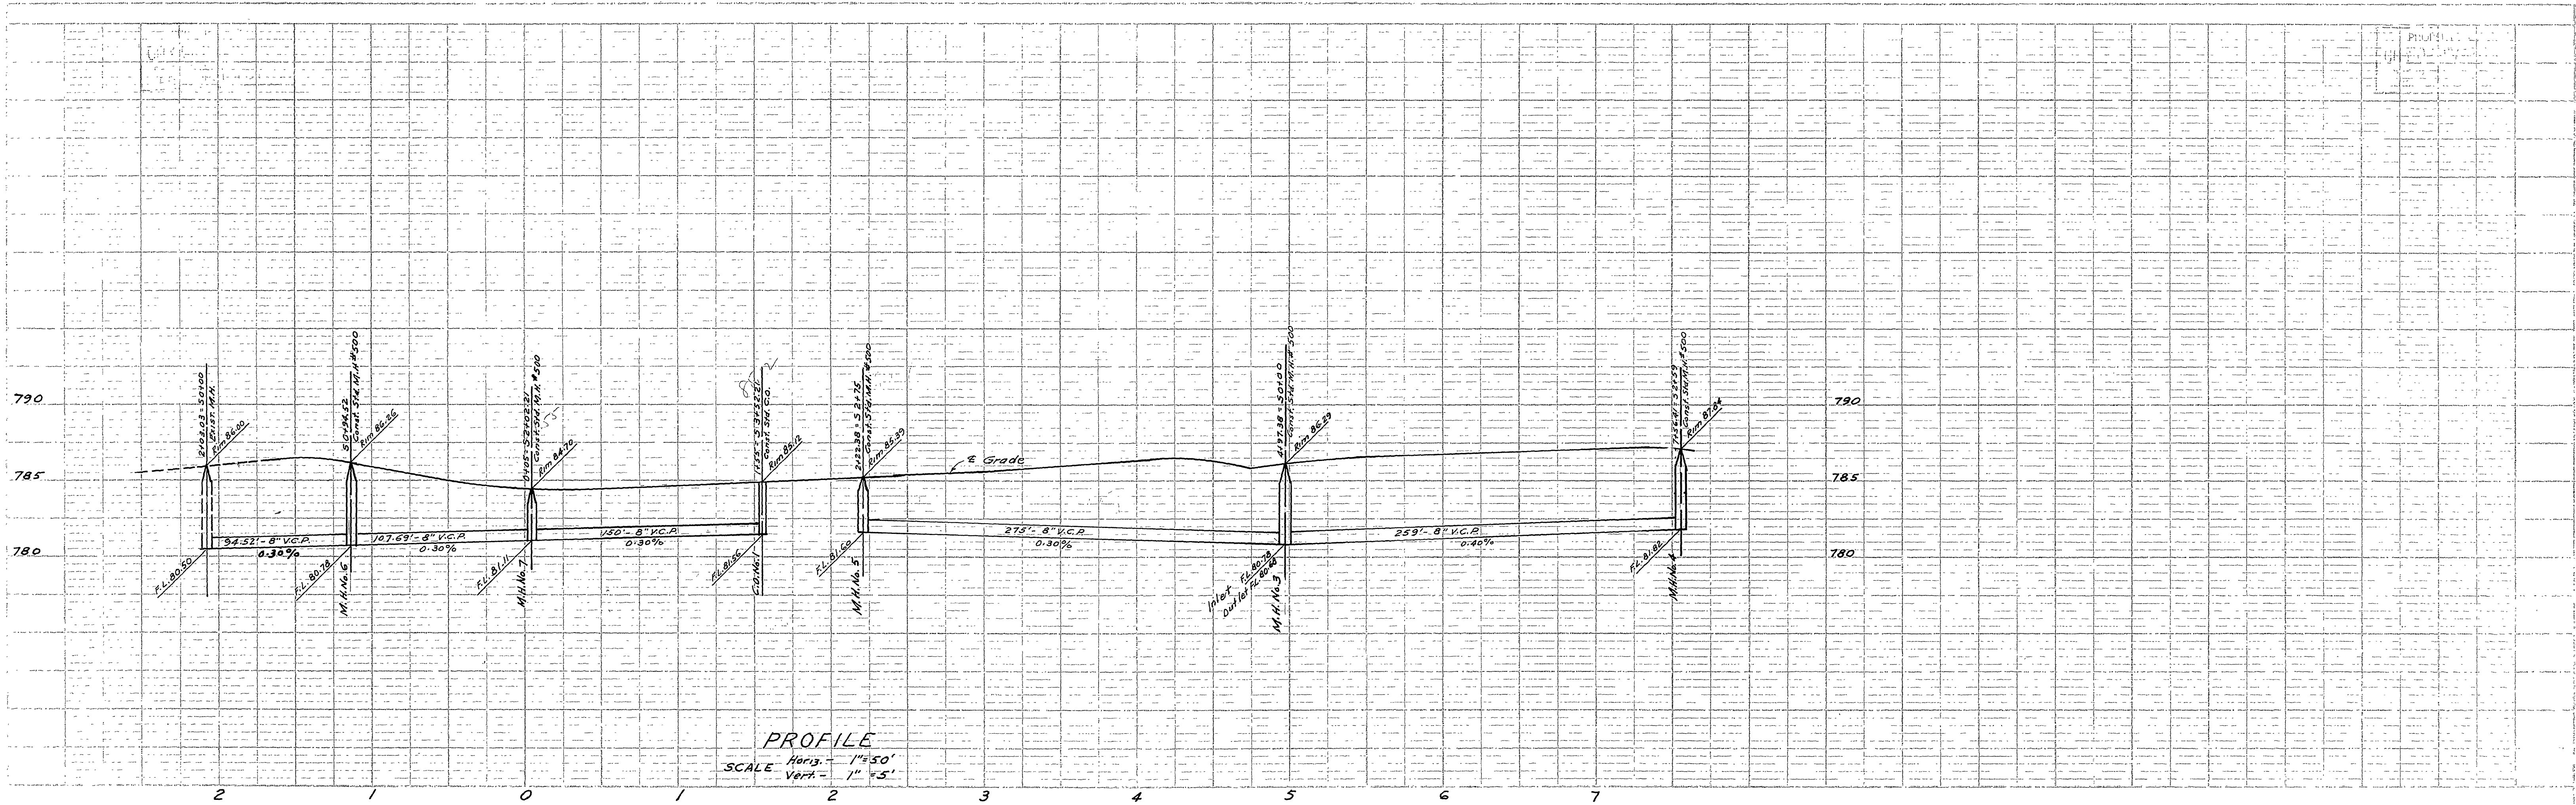

- NOTES
1. B.M. is Nail in N.E. Curb Ret. DEERFIELD RD. & JURUPA AVE., Elevation 788.59.
 2. Exact location of all 4" House connection laterals to be determined in the field.
 3. Lay Wyes flat on Lot Nos. 18 to 21 inclusive. " " " " " 25 to 31 inclusive.

DONALD J. McKEE-LIC. SURVEYOR
 L.S. No. 1825
 Riverside, California
 Approved by *[Signature]* Date 11/2/59
 CITY OF RIVERSIDE, CALIFORNIA
 DEPARTMENT OF PUBLIC WORKS

GREENBRIER DRIVE
 AND GRASSY TRAIL
 SEWER PLANS AND PROFILES
SUNLAND ESTATES
 Horiz. Scale 1"=50' Vert. Scale 1"=5'

Approved by *[Signature]*
 Director of Public Works
 Date 7-20-59
 FILE NO. **S-159**
 Sheet 2 of 2

* = "As Built", 4-17-59, H. Ball

PROJECT	SEWER
DATE	7-20-59
BY	D. J. McKEE-LIC.
CHECKED	
DATE	
BY	
CHECKED	
DATE	
BY	

DATE	7-20-59
BY	D. J. McKEE-LIC.
CHECKED	
DATE	
BY	
CHECKED	
DATE	
BY	