



PROFILE SCALE  
 VERT: 1 in = 4 ft  
 HORIZ: 1 in = 40 ft

7+00 8+00 9+00 10+00 11+00


SEE SHEET 5 PLAN S-1685

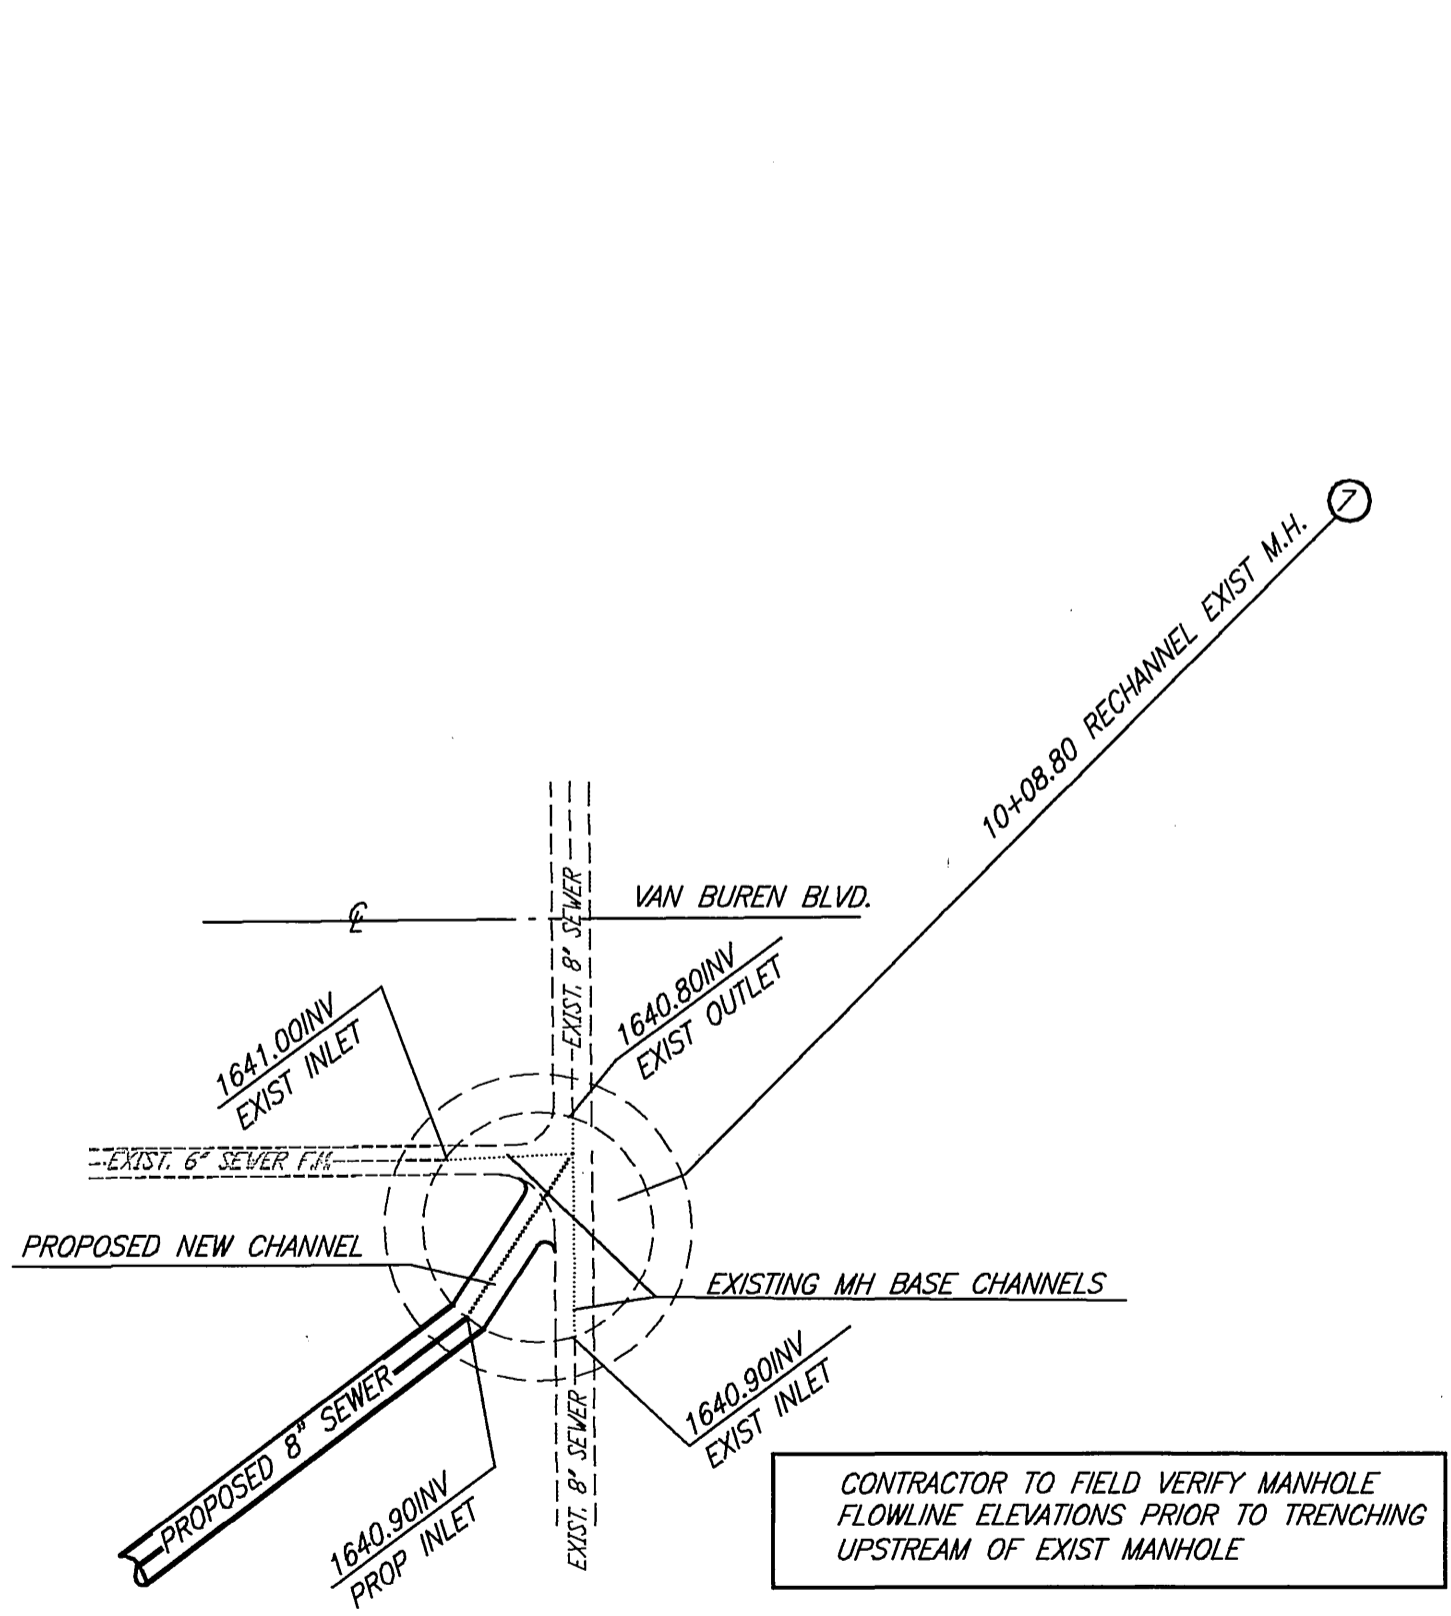

EXIST. MH BASE RECHANNEL  
 NOT TO SCALE

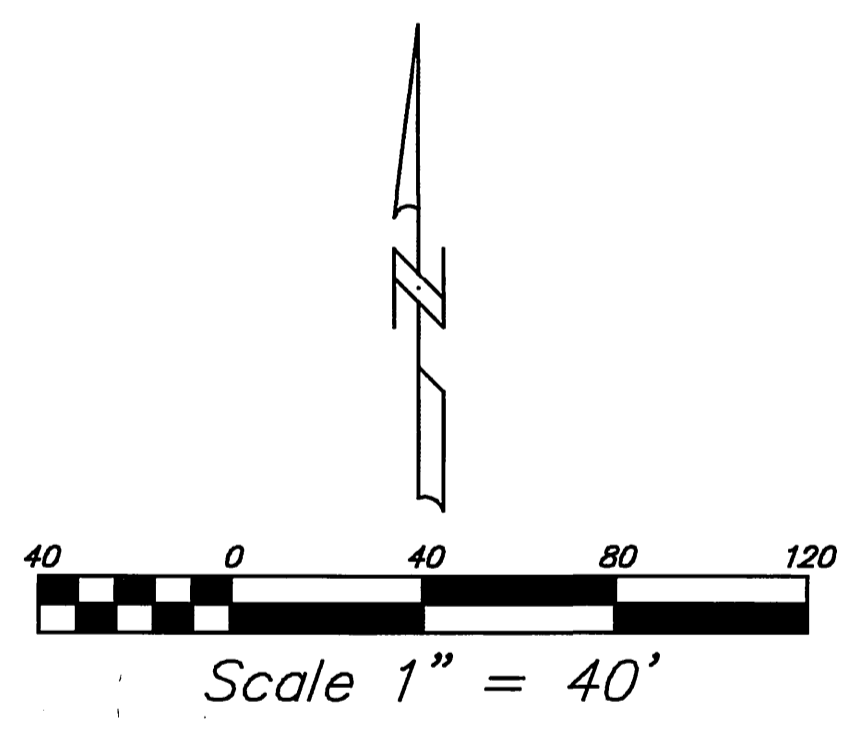

SEE SHEET 4 PLAN S-1685

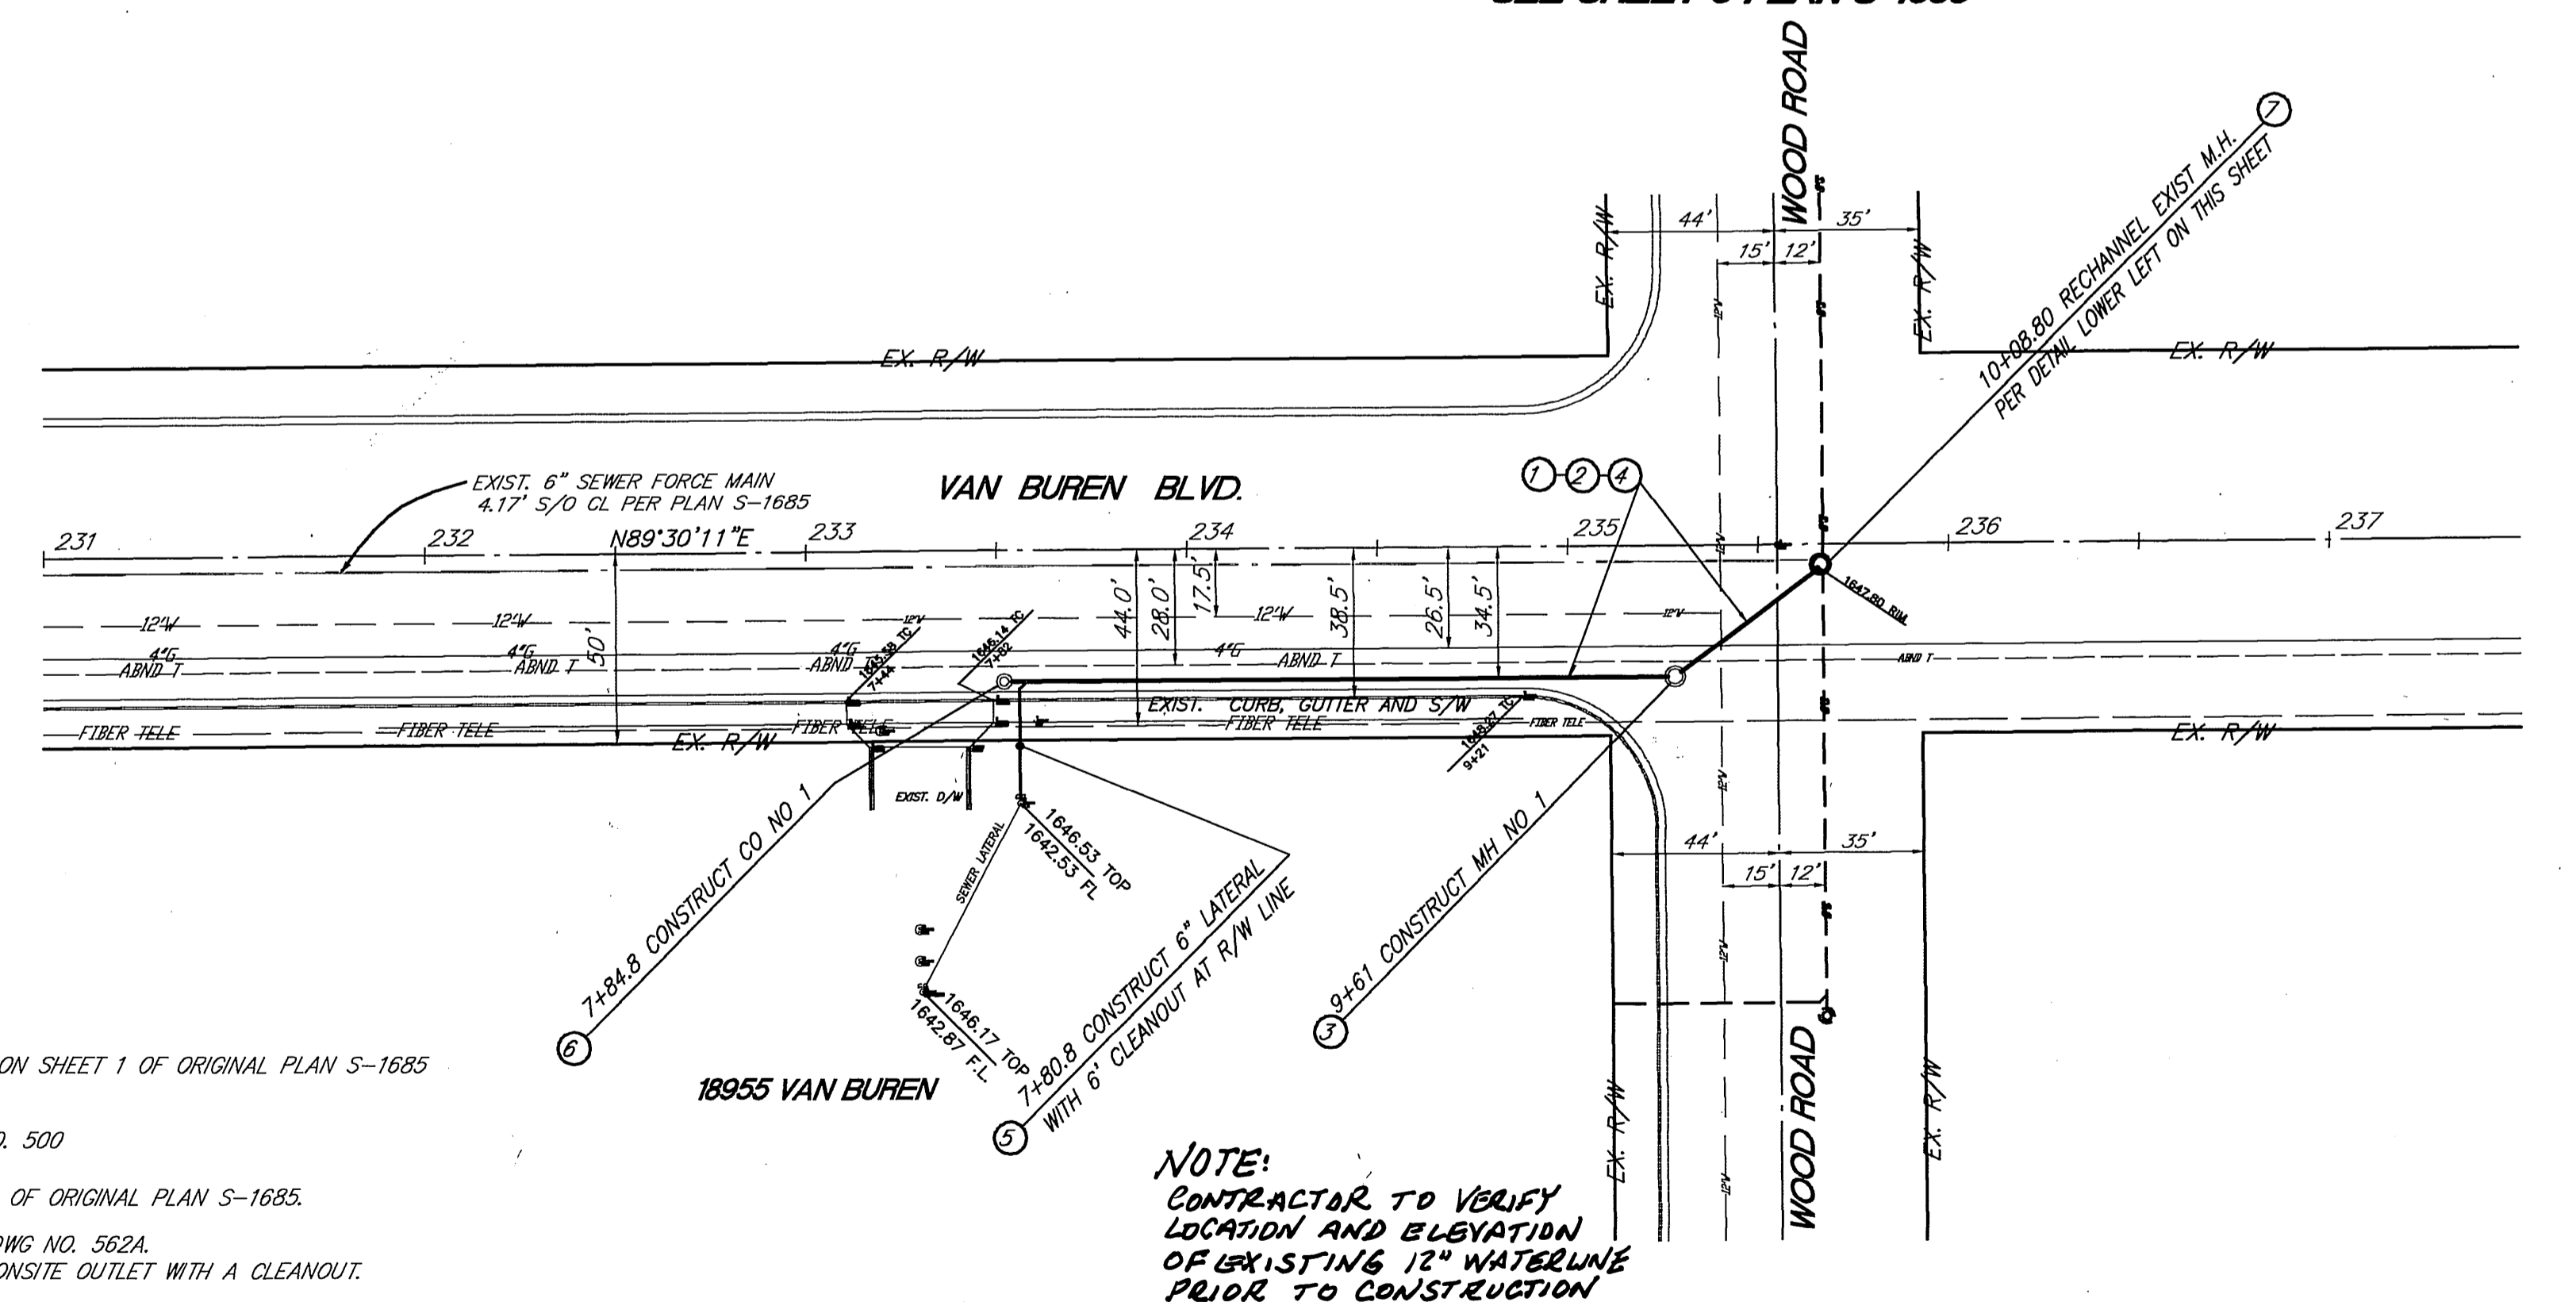

SEE SHEET 4 PLAN S-1685

**CONSTRUCTION NOTES:**  
 ALL REFERENCES TO OTHER PLAN SHEETS ARE TO THE ORIGINAL PLAN S-1685

- ① SAWCUT AND REMOVE EXISTING AC PAVEMENT PER DETAIL ON SHEET 1 OF ORIGINAL PLAN S-1685
- ② CONSTRUCT 8" VCP SEWER.
- ③ CONSTRUCT MANHOLE PER CITY OF RIVERSIDE STD. DWG NO. 500
- ④ CONSTRUCT AC OVER AB PER TRENCH DETAIL ON SHEET 1 OF ORIGINAL PLAN S-1685.
- ⑤ CONSTRUCT 6" VCP WYE AND 6" LATERAL PER CITY STD. DWG NO. 562A. WITH 6" C.O. AT R/W. JOIN NEW LATERAL TO EXISTING 4" ONSITE OUTLET WITH A CLEANOUT.
- ⑥ CONSTRUCT CLEANOUT PER CITY OF RIVERSIDE STD. DWG NO. 560
- ⑦ JOIN EXIST. MANHOLE, RECHANNEL BOTTOM TO ACCEPT PROPOSED 8" VCP.

NOTE:  
 CONTRACTOR TO VERIFY LOCATION AND ELEVATION OF EXISTING 12" WATERLINE PRIOR TO CONSTRUCTION

SOUTHERN CALIFORNIA GAS COMPANY APPROVED BY: <i>[Signature]</i> DATE: 6/6/04		WESTERN MUNICIPAL WATER DISTRICT REVIEWED FOR NON-INTERFERENCE COMPLIANCE APPROVED BY: <i>[Signature]</i> DATE: 10/15/04		SOUTHERN CALIFORNIA EDISON COMPANY APPROVED BY: <i>[Signature]</i> DATE: 6/15/04		PACIFIC BELL TELEPHONE COMPANY APPROVED BY: <i>[Signature]</i> DATE: 6/15/04		RIVERSIDE TRANSIT AUTHORITY APPROVED BY: <i>[Signature]</i> DATE: 6/15/04				Prepared By: <i>[Signature]</i> (909) 313-2058 3351 Pachappa Hill, Riverside, Ca 92506 DATE: 11/2/03 CITY BUSINESS TAX CERTIFICATE No. 110858, EXP. DATE 04/14/2004		BENCH MARK: P.K. NAIL AND TAG EASTERLY SIDE OF TRAUTWEIN ROAD 100' NORTHERLY OF VAN BUREN BOULEVARD, NORTHERLY WALL OF CATCH BASIN, 2' EASTERLY OF CURB FACE IN S/W LL 43/FG 10 ELEV. 1674.985 ADJ.		CITY OF RIVERSIDE, CALIFORNIA PUBLIC WORKS DEPARTMENT APPROVED BY: <i>[Signature]</i> DATE: 3/28/05 PRINCIPAL ENGINEER: <i>[Signature]</i> STREET SERVICES: <i>[Signature]</i> TRAFFIC DIVISION: <i>[Signature]</i> PARKS DEPARTMENT: <i>[Signature]</i>				VAN BUREN BLVD. REVISION TO PLAN S-1685 18955 VAN BUREN PROPOSED 8" MAIN AND 6" LATERAL HORIZ. SCALE: 1" = 40' VERT. SCALE: 1" = 4' INDEXED 10-26-05 LFH		PW05-0175 S-1685-A SHEET 1 OF 1	
---------------------------------------------------------------------------------	--	--------------------------------------------------------------------------------------------------------------------------------	--	-------------------------------------------------------------------------------------	--	---------------------------------------------------------------------------------	--	------------------------------------------------------------------------------	--	--	--	------------------------------------------------------------------------------------------------------------------------------------------------------------------------------	--	-----------------------------------------------------------------------------------------------------------------------------------------------------------------------------------------------------------	--	-------------------------------------------------------------------------------------------------------------------------------------------------------------------------------------------------------------------------------------------------------------------------	--	--	--	-------------------------------------------------------------------------------------------------------------------------------------------------------------------------	--	---------------------------------------	--