



B.M. ELEV 761.76 R.R. SPK. IN
POLE #12297J
F.B. 611/1, 600/52
SCALE: HOR. 1"=50'
VERT. 1"=5'

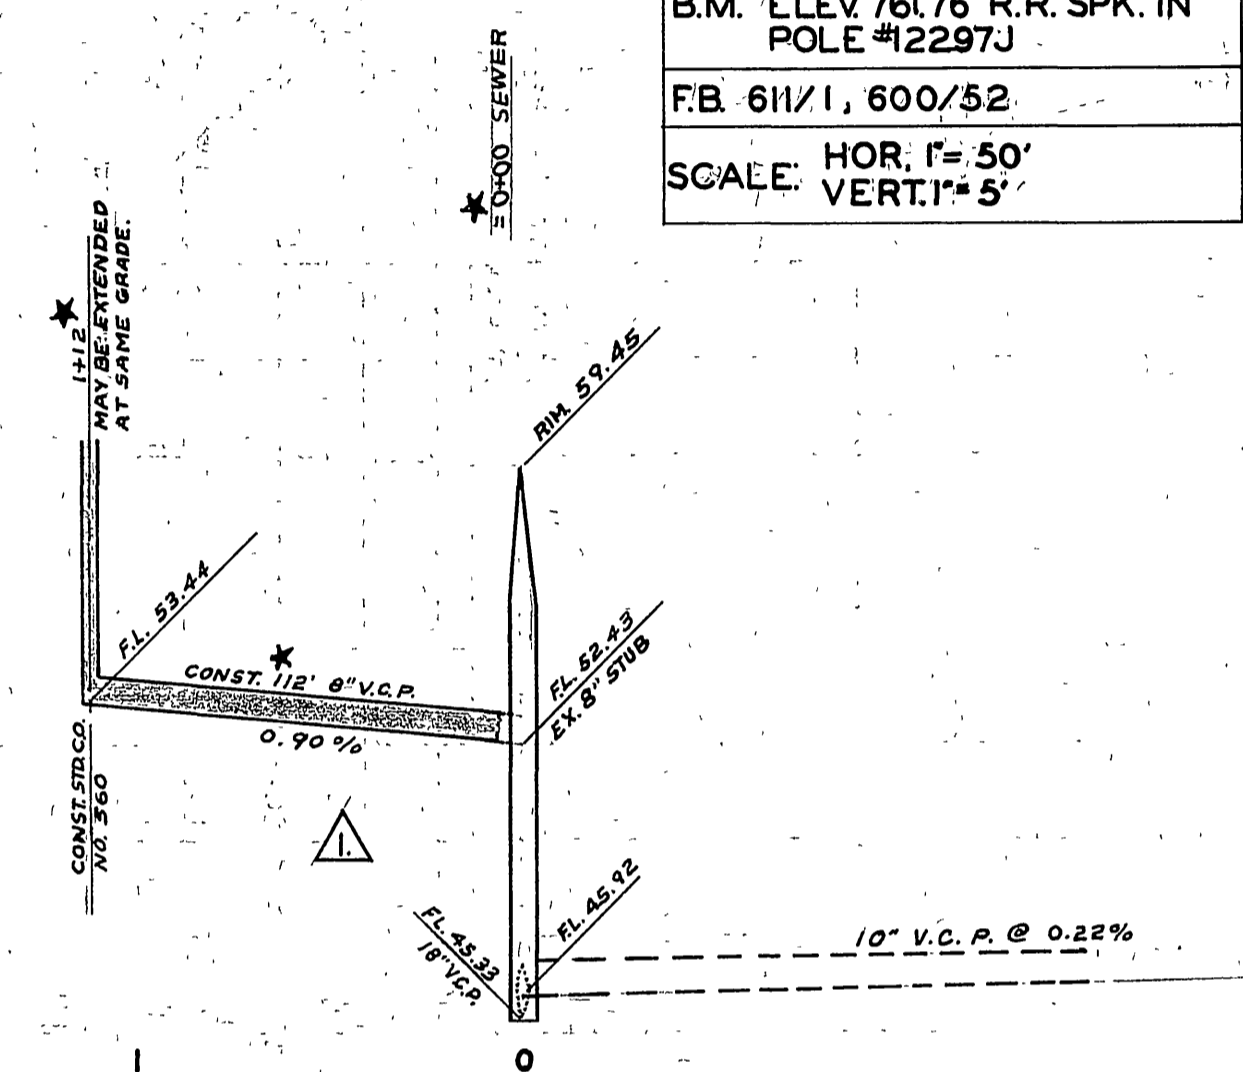

NOTE:
1. IT SHALL BE THE RESPONSIBILITY OF THE CONTRACTOR TO CLEAR THE RIGHT-OF-WAY IN ACCORDANCE WITH THE PROVISIONS OF LAW AS IT AFFECTS EACH UTILITY, INCLUDING IRRIGATION LINES AND APPURTENANCES AND AT NO COST TO THE CITY.
2. THE LENGTH OF 8\"/>

▲ 4/20/59 SUPERSEDES PLAN 4
B.L. ADDED 112' SEWER I.
★ 8-4-59 As Built, H.Ball

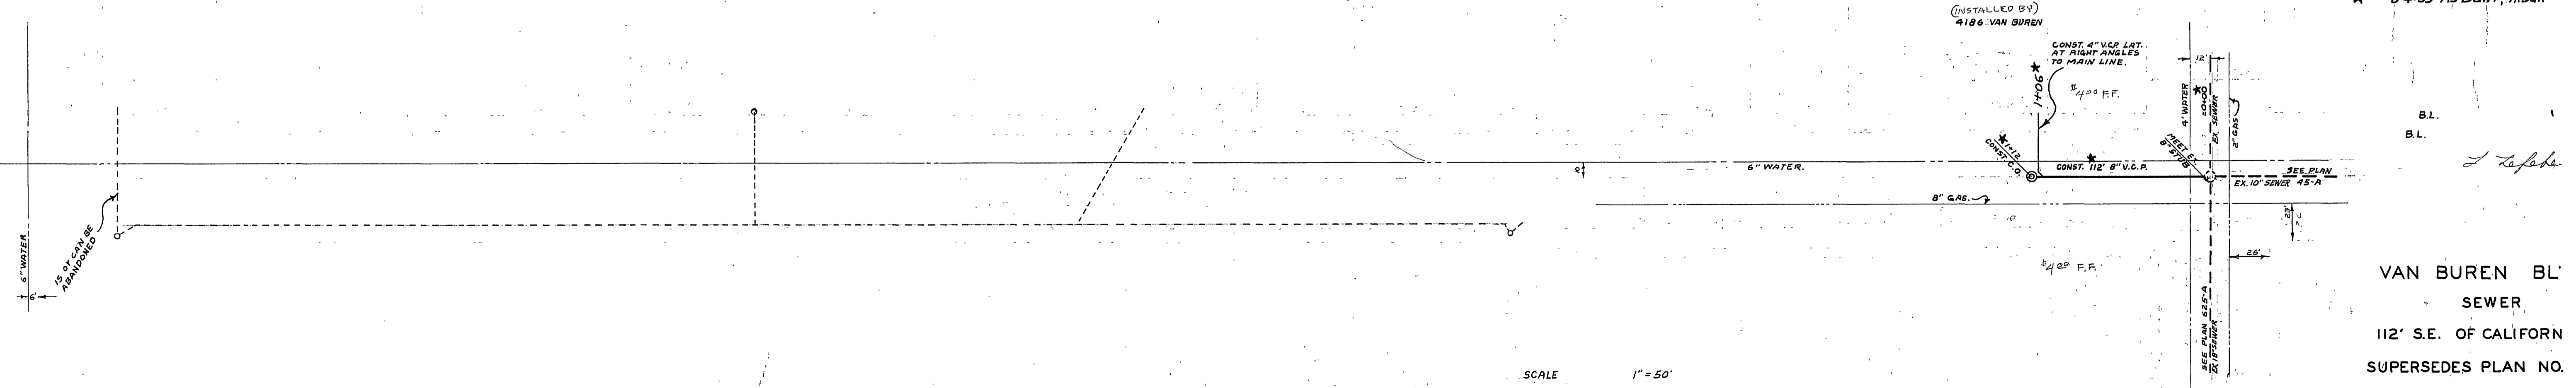

VAN BUREN BL
SEWER
112' S.E. OF CALIFORN
SUPERSEDES PLAN NO.

J. Mathis
May 15, 1959

S-1

5-171

SCALE 1"=50'

DATE _____ BY _____
 PROFILE SURVEYED _____
 PLOTTED _____
 NOTE BOOK _____
 NO. _____
 STRUCTURE NOTATIONS CHKD.


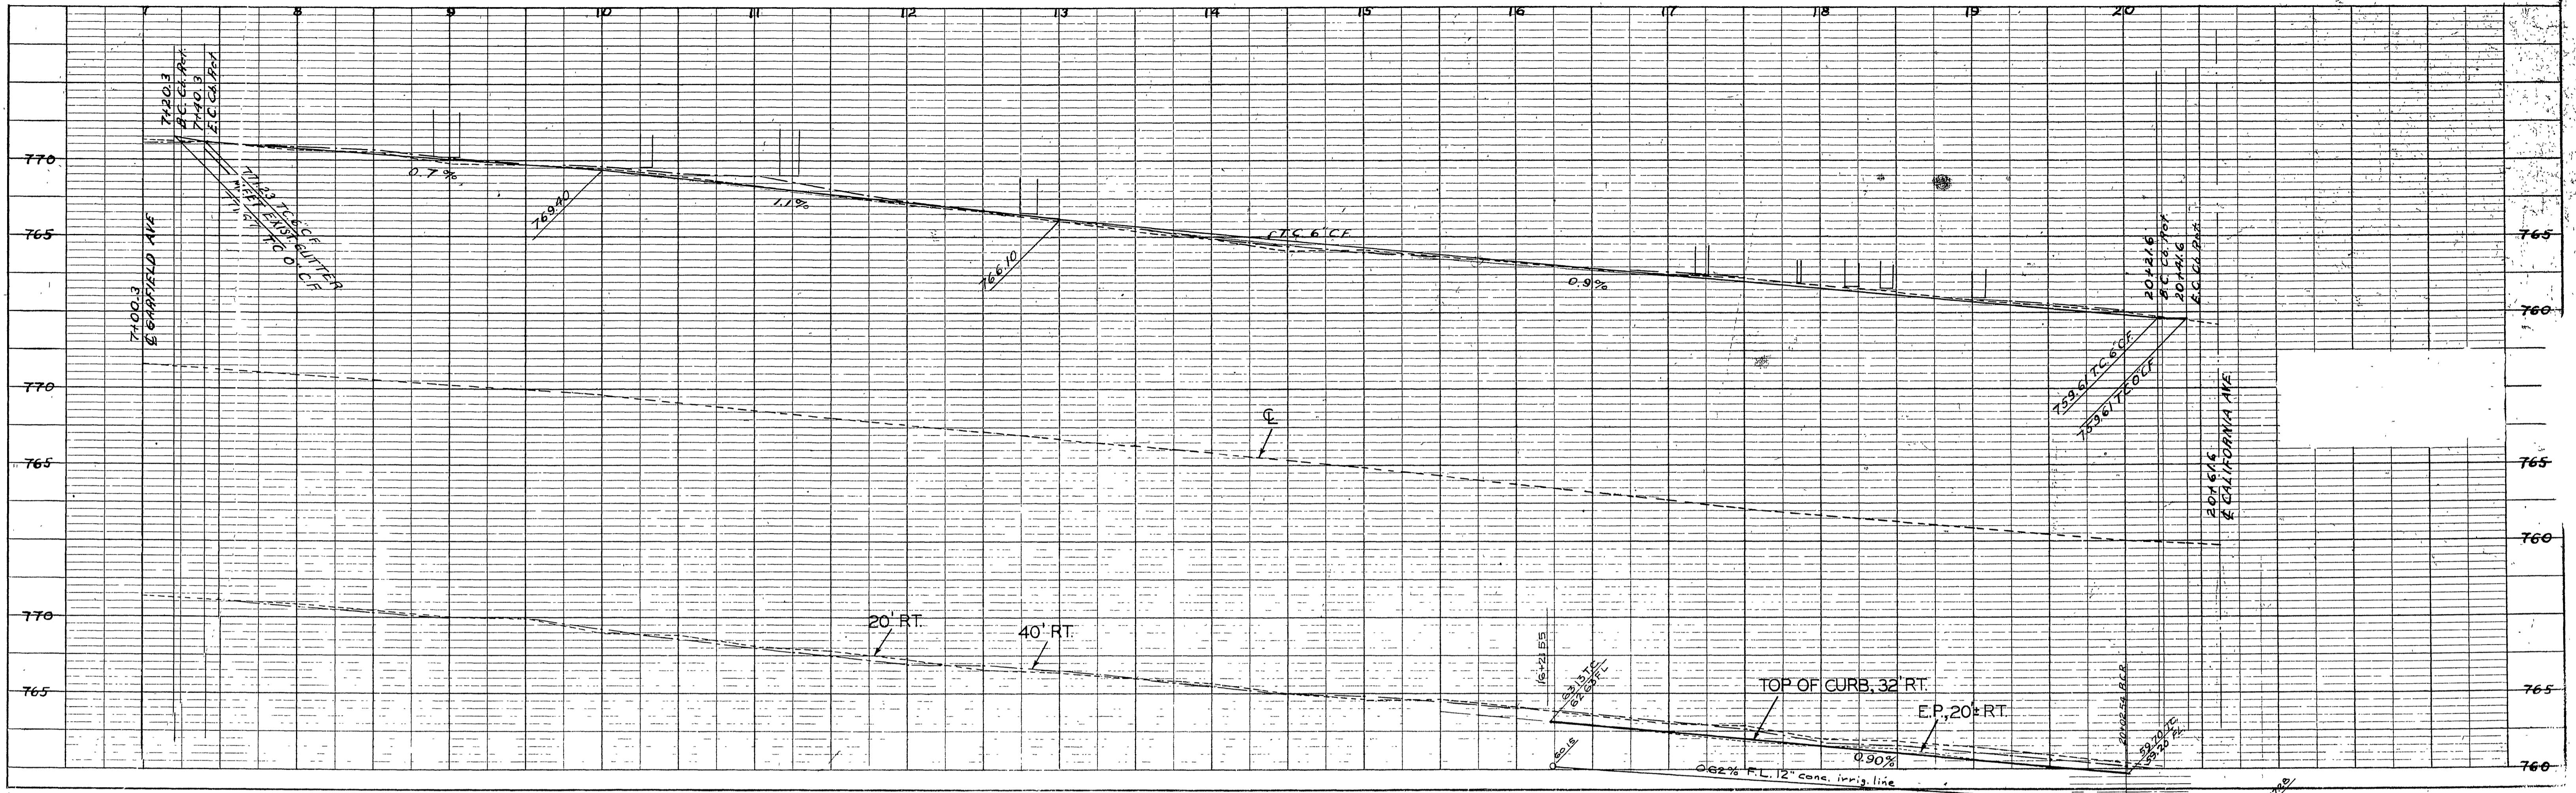


PLATE 1-F 11-PROFILE O.P.P. - F STANDARD

DATE _____ BY _____
 PLAN SURVEYED _____
 PLOTTED _____
 NOTE BOOK _____
 NO. _____
 ALIGNMENT CHECKED _____
 RT. OF WAY CHECKED _____

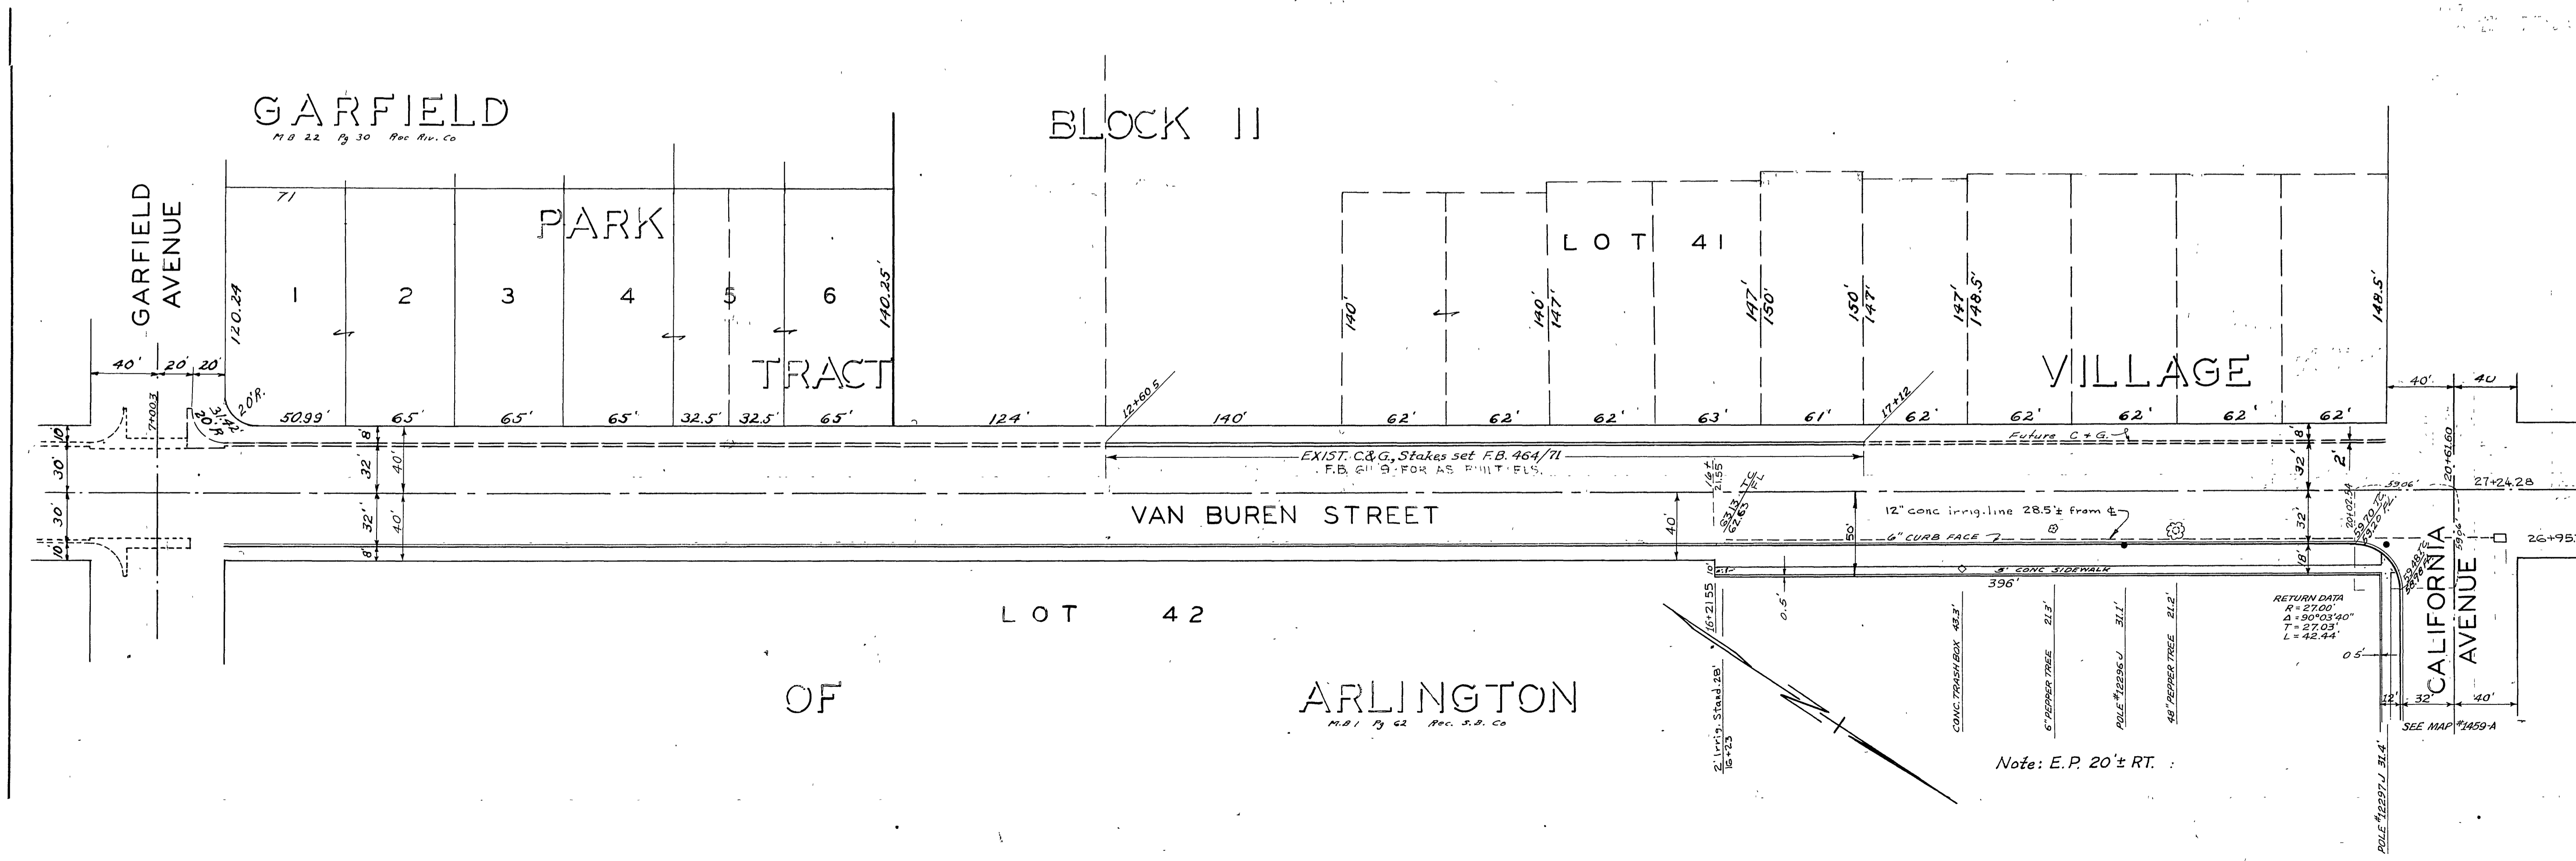

REVISIONS		
MARK	DATE	DESCRIPTION

DESIGNED BY	CHECKED BY
DRAWN BY	
RECOMMENDED BY	ASSISTANT CITY ENGINEER
CITY OF RIVERSIDE CA DEPARTMENT OF PUBLIC WORKS	
APPROVED BY	DIRECTOR OF PUBLIC WORKS
DATE	SHEET

S-171