

B.M. - PK Nail in West Curb of Colorado and Monroe 2' North of Curb Return  
ELEV. = 750.39

NOTE: Exact location of House Connections to be determined in the Field.

Engineers Estimate of Quantities for Sewer Const.		
Std. Manholes - Std. Design No 500	each	8
Std. Cleanouts - Std. Design No 560	each	1
Lineal Ft. 8" V.C.P.		2,183.3
No. Std. House Connections		60

**RIVERSIDE ENGINEERING CO. INC.**  
RIVERSIDE, CALIFORNIA  
APPROVED *George O. Crowley* CE 9455 DATE 4-14-59


**CITY OF RIVERSIDE, CALIFORNIA**  
DEPARTMENT OF PUBLIC WORKS

SEWER PLAN & PROFILE  
BRUNSWICK AVE.  
VERBENA DR.  
LARKSPUR RD.  
HALECREST HOMES UNIT 2




HORIZ 1"=50' VERT 1"=5'  
APPROVED *George O. Crowley*  
Director of Public Works  
Date May 15, 1959  
No. S-177  
Sheet 1 of 3

★ = "As Built", 8-5-59, H. Ball

J.O. 2319

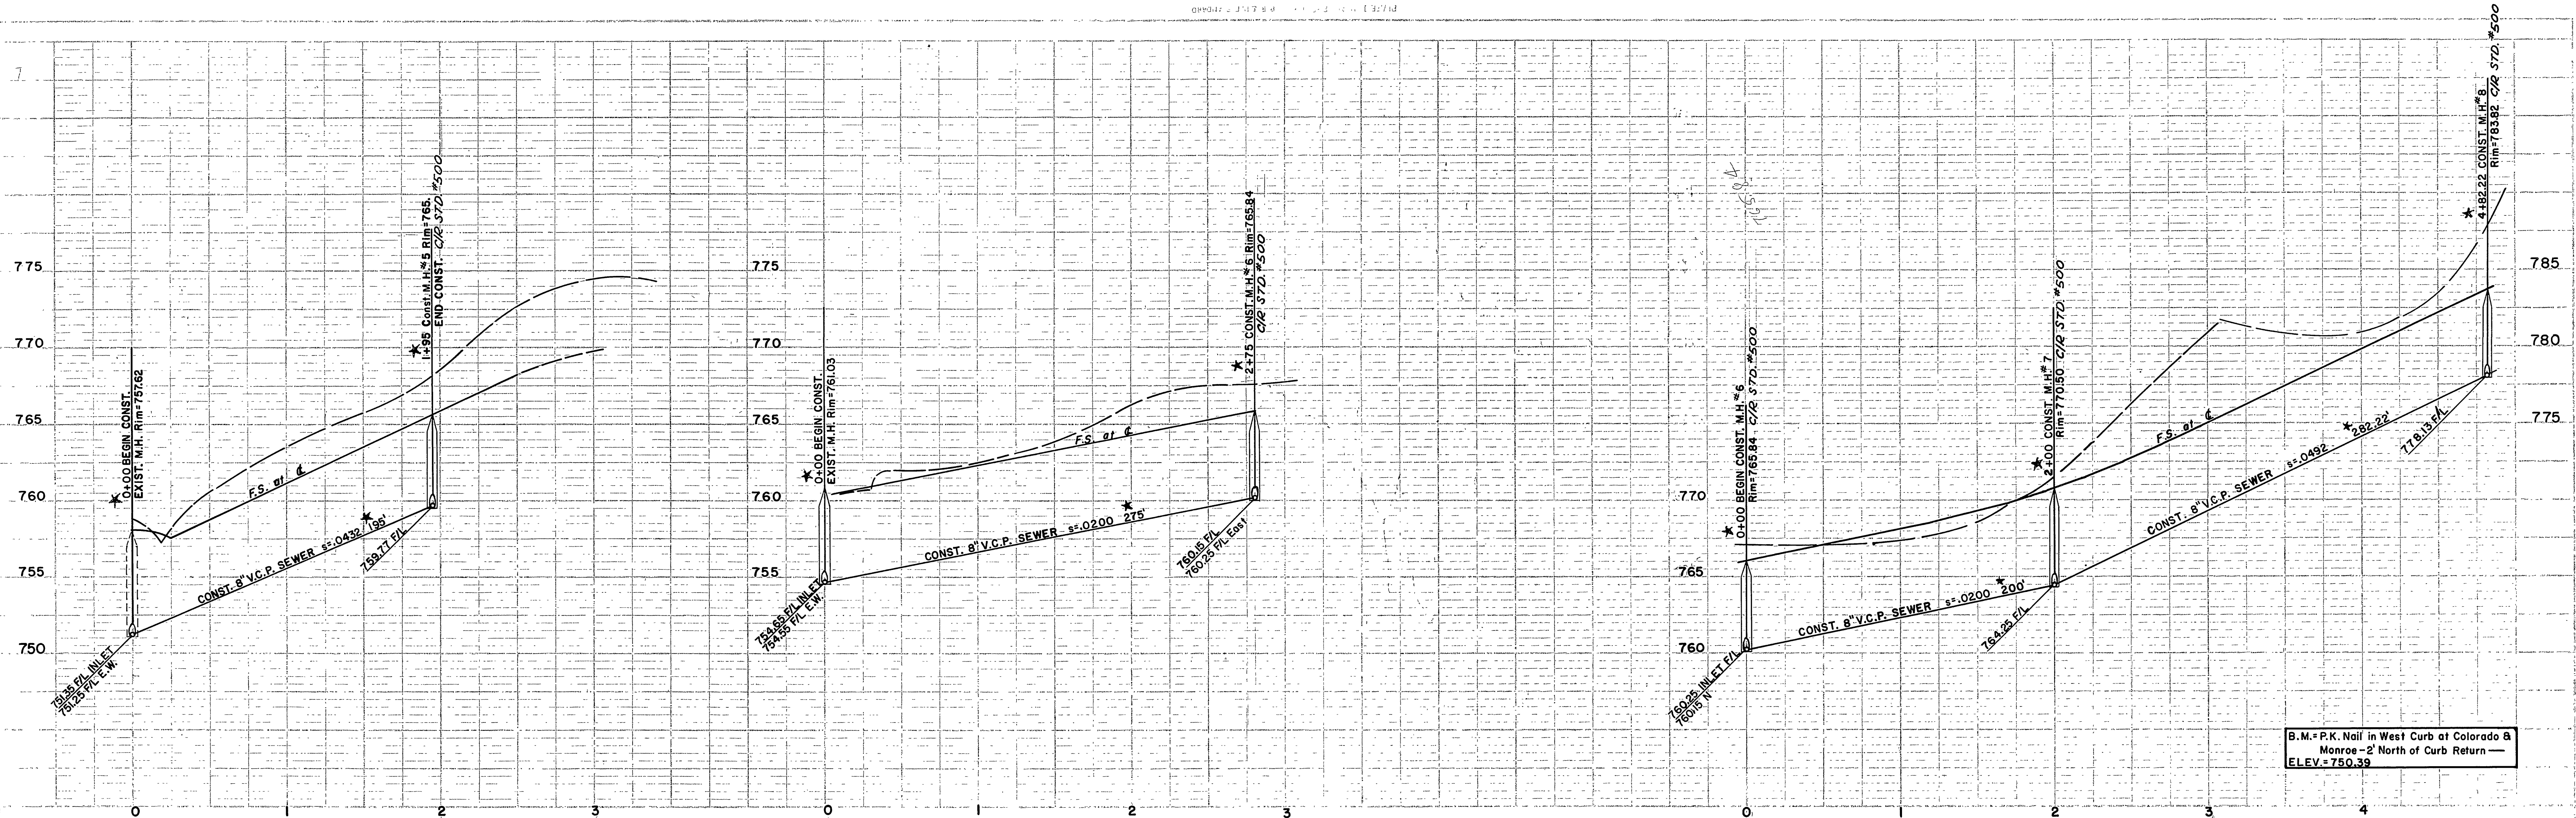

B.M. = P.K. Nail in West Curb at Colorado & Monroe - 2' North of Curb Return  
ELEV. = 750.39

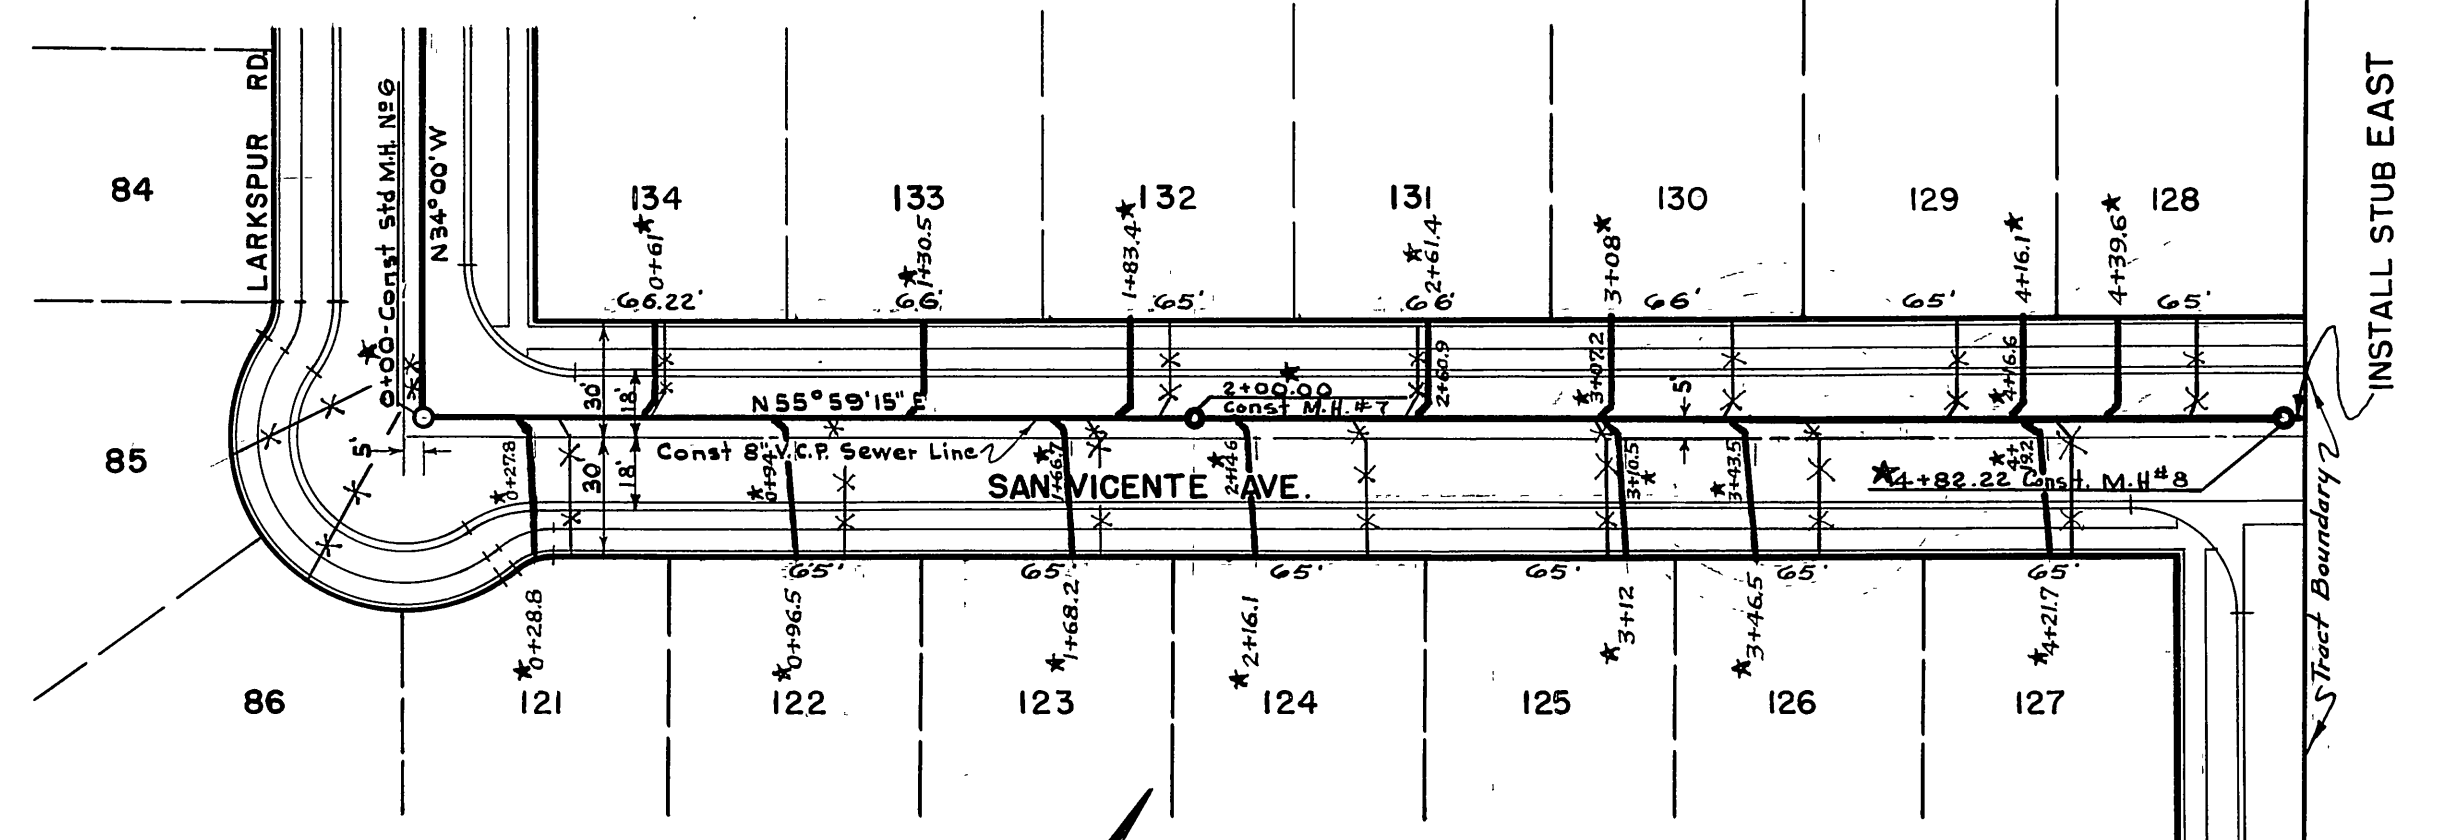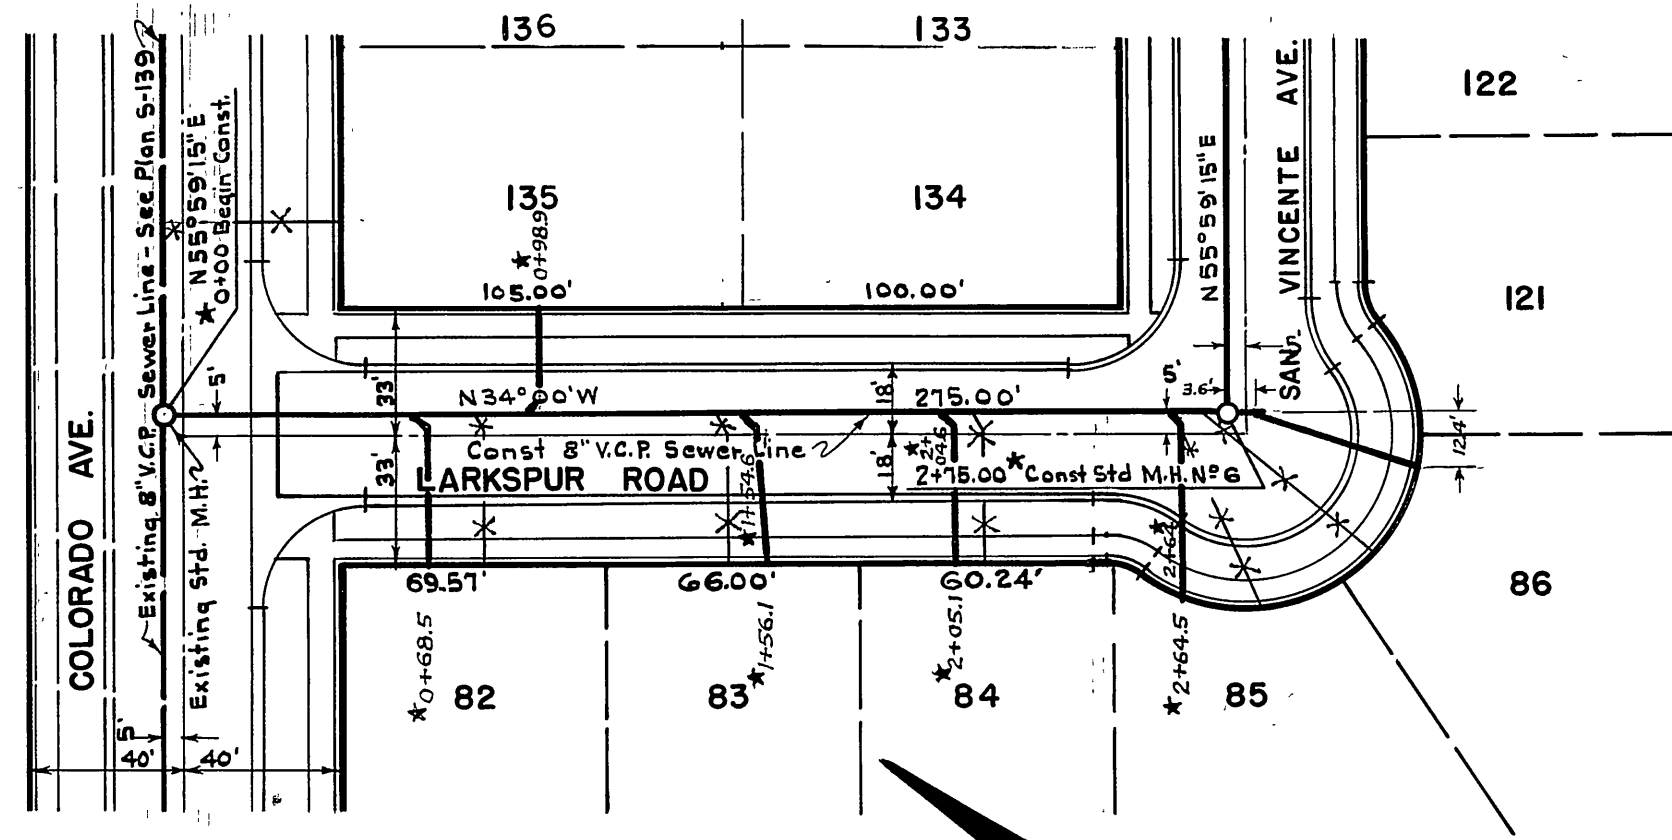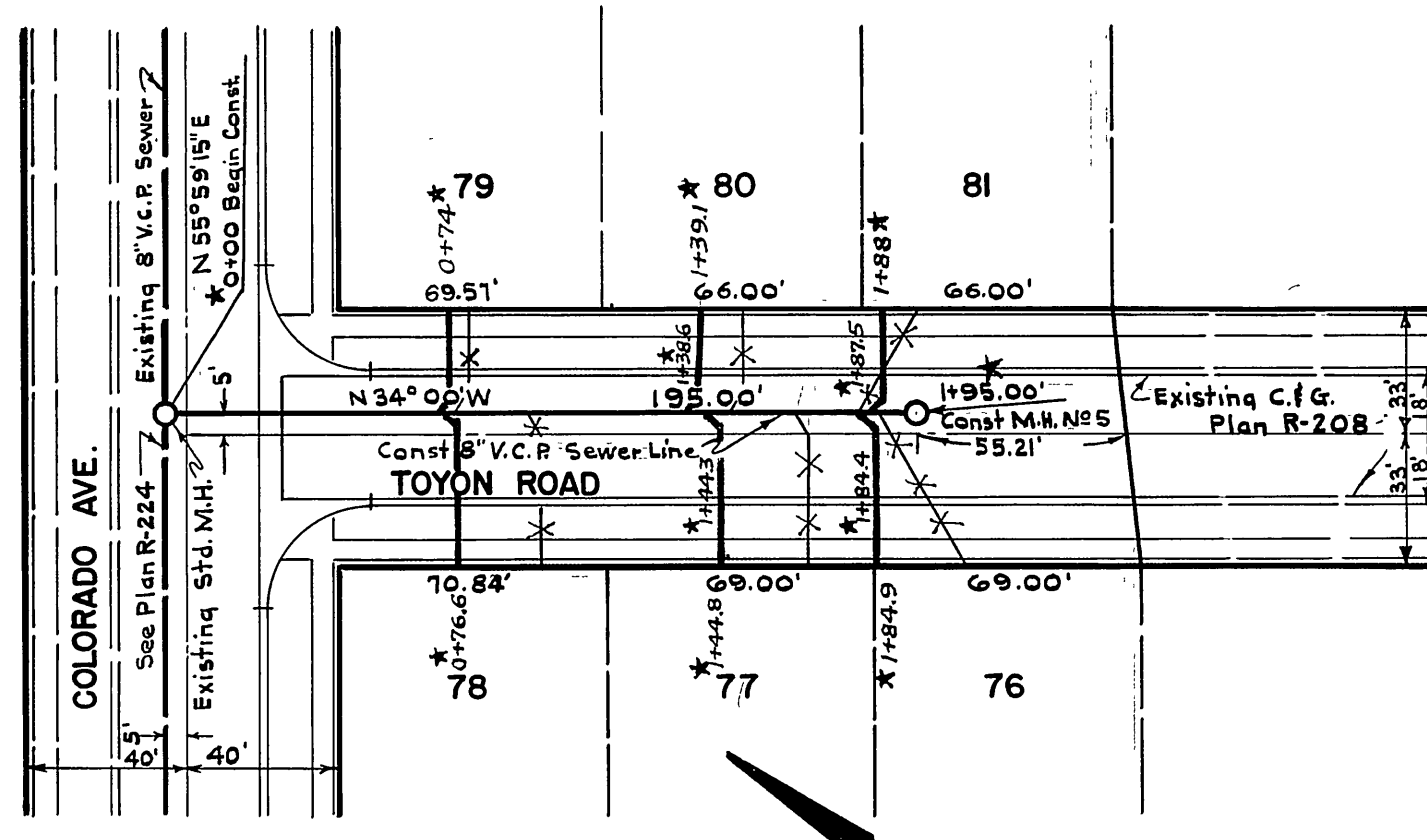



NOTE - EXACT LOCATIONS OF HOUSE CONNECTIONS TO BE DETERMINED IN THE FIELD.

RIVERSIDE ENGINEERING CO. INC. RIVERSIDE, CALIFORNIA	
APPROVED <i>George O. Crawley</i> C.E. 9455	DATE 4-14-59
CITY OF RIVERSIDE, CALIFORNIA DEPARTMENT OF PUBLIC WORKS	
SEWER PLAN & PROFILE SAN VICENTE AVE. TOYON RD. LARKSPUR RD. HALECREST HOMES UNIT 2	
HORZ 1"=50'	VERT 1"=5'
APPROVED <i>Tom Mathews</i> DIRECTOR OF PUBLIC WORKS	No. S-177
Date May 15, 1959	Sheet 2 of 3

\* = "As Built", 8-5-59, H. Ball

PROFILES  
RIVERSIDE ENGINEERING CO.  
RIVERSIDE, CALIFORNIA

HALECREST HOMES UNIT 2  
SAN VICENTE AVE.  
TOYON RD.  
LARKSPUR RD.

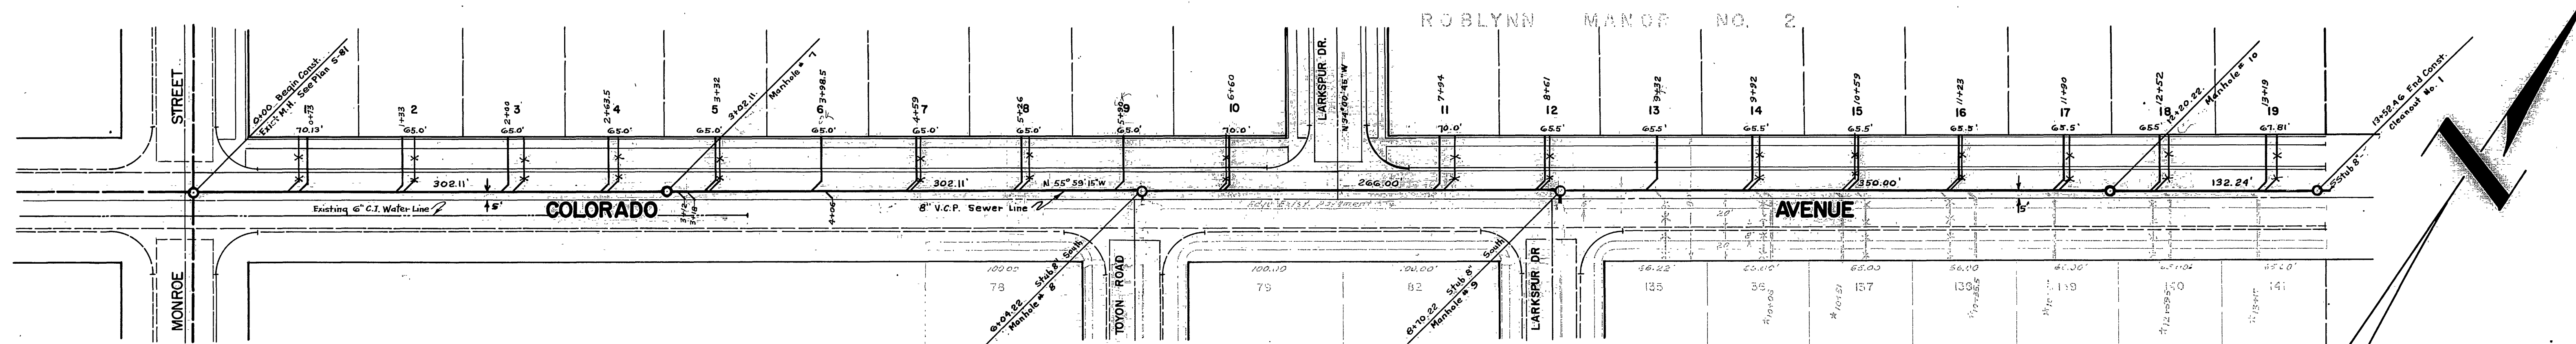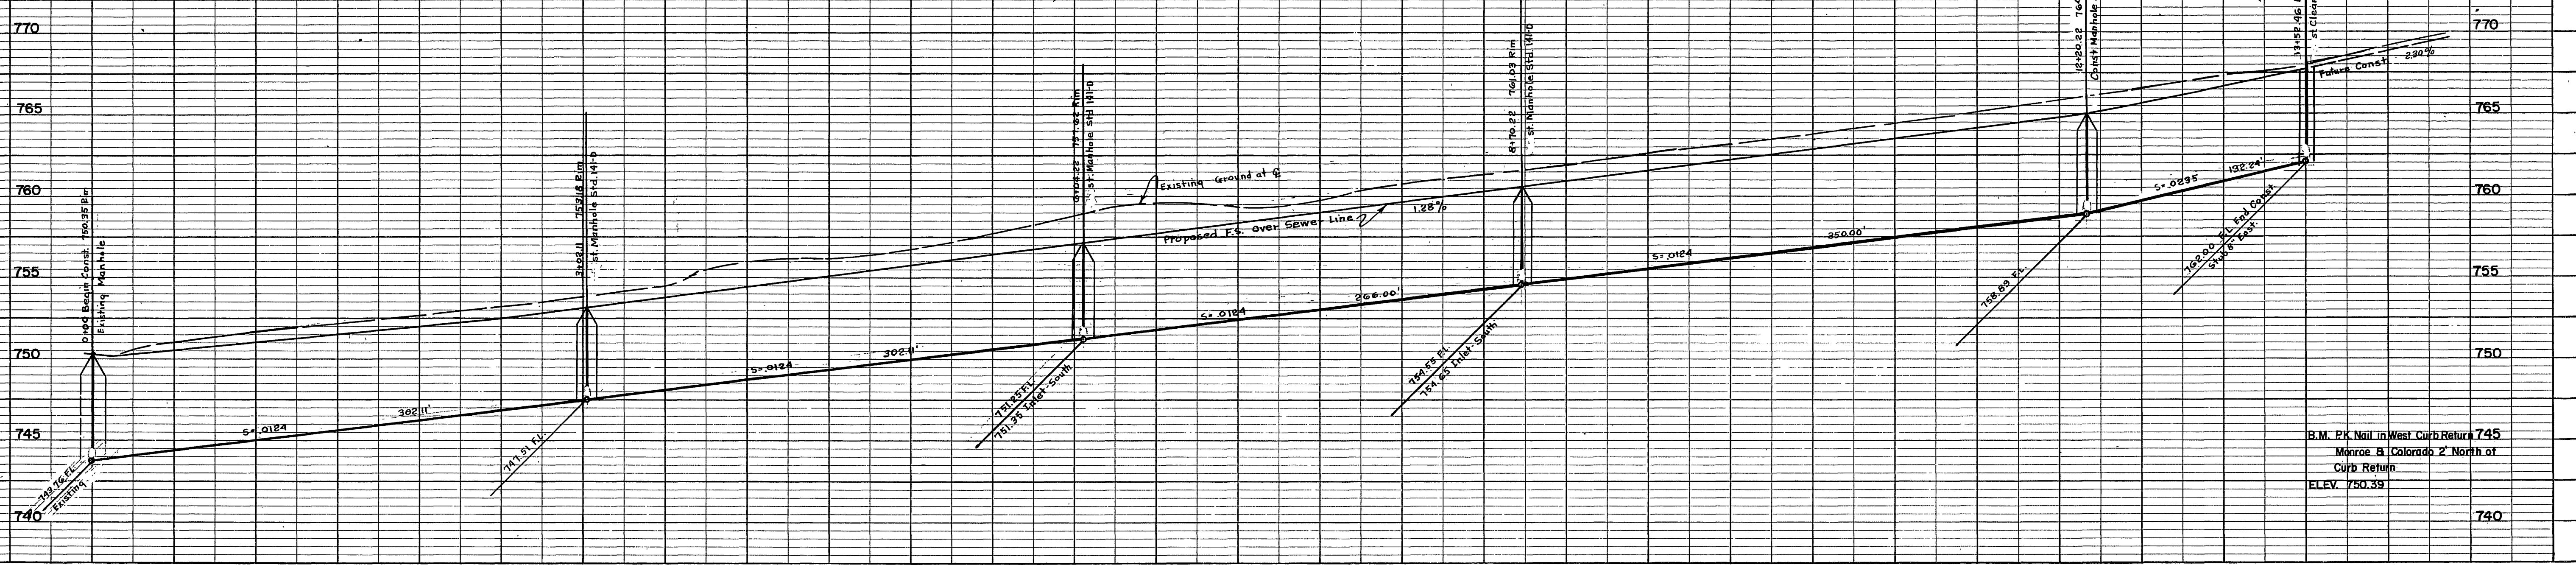

NOTE  
 Exact location of house connections to be determined in the field.

HALECREST HOMES UNIT 2

**RIVERSIDE ENGINEERING CO. INC.**  
 RIVERSIDE, CALIFORNIA  
 APPROVED: \_\_\_\_\_ RE. 9455 DATE: \_\_\_\_\_

**CITY OF RIVERSIDE, CALIFORNIA**  
 DEPARTMENT OF PUBLIC WORKS

SEWER PLAN & PROFILE  
 COLORADO AVENUE - ROBLYNN MANOR UNIT 2  
 PALECREST HOMES UNIT 2

1"=50' HORIZ. SCALE 1"=5' VERT.

APPROVED BY: \_\_\_\_\_ NO. \_\_\_\_\_  
 DIRECTOR OF PUBLIC WORKS

DATE: \_\_\_\_\_ SHEET OF 3

PROFILE	
SURVEYED	BY
PLOTTED	DATE
ALIGNED/CHECKED	
NO. OF MAN CHECKED	
STRUCTURE NOTATIONS CHD.	

PLAN	
SURVEYED	BY
PLOTTED	DATE
ALIGNED/CHECKED	
NO. OF MAN CHECKED	

As Built House Connections, 10-28-58, H.B. 11  
 House connections Halecrest Homes Unit 2, 10-28-58 & 11-59  
 H.B. 11, 10-28-58 & 11-59  
 H.B. 11, 10-28-58 & 11-59