
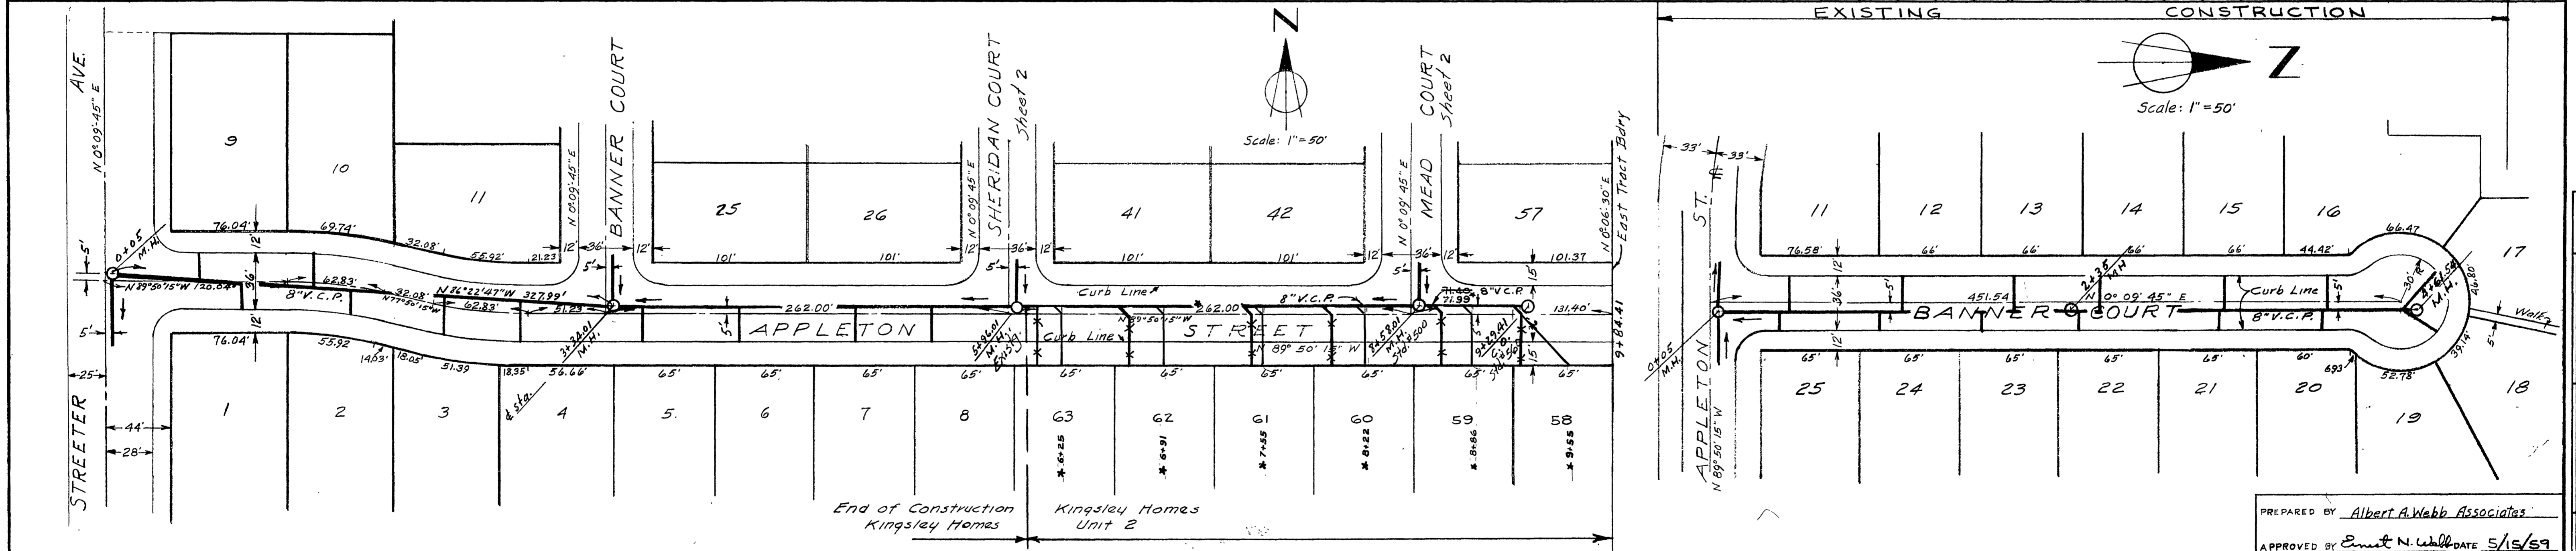


PLATE 1 - PLAN, PROFILE, & S. F. C.A.  
CLEARING PAPER CO. S. F. CAL.  
NO. 1000-1

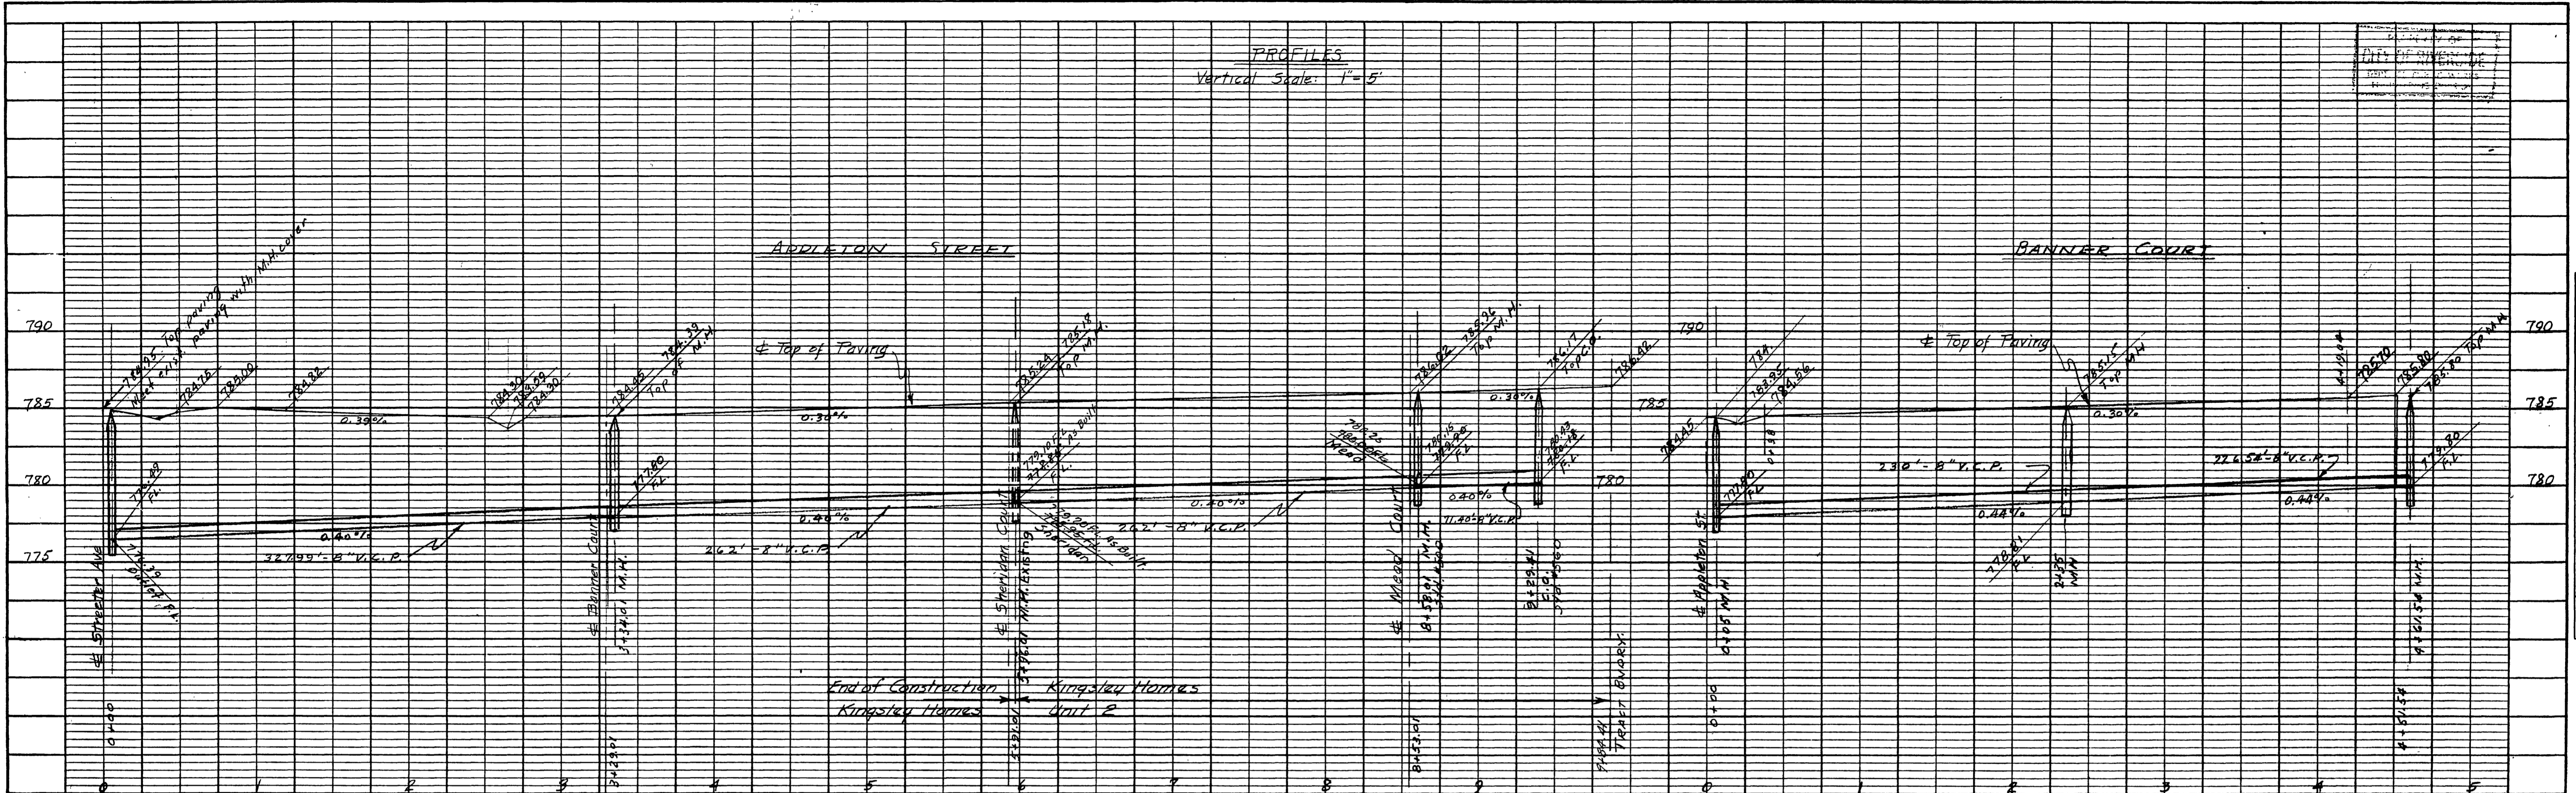

PROFILE	NO. 52-501	BY	DATE
NOTE BOOK	PLOTTED		
	RECORDED		
	FILED		
	STRUCTURE LAYOUTS & CHANGES		

PLAN	NO. 52-501	BY	DATE
NOTE BOOK	PLOTTED		
	RECORDED		
	FILED		
	STRUCTURE LAYOUTS & CHANGES		


PREPARED BY Albert A. Webb Associates  
 APPROVED BY Emmet N. Webb DATE 5/15/59  
 CITY OF RIVERSIDE, CALIFORNIA  
 DEPARTMENT OF PUBLIC WORKS

SEWER PLAN & PROFILE  
 KINGSLEY HOMES  
 UNIT NO. 2  
 APPLETON ST. & BANNER COURT





APPROVED BY S. J. Mott  
 DIRECTOR OF PUBLIC WORKS  
 5-28-59  
 DATE 12-23-55 UNIT#1 SHEET 1 OF 2

Revised 1-26-60  
 Sewer grades Unit 2 NM.  
 Revised 4-23-59 REC

\*AS BUILT 2/17/60 B. LOW UNIT#2

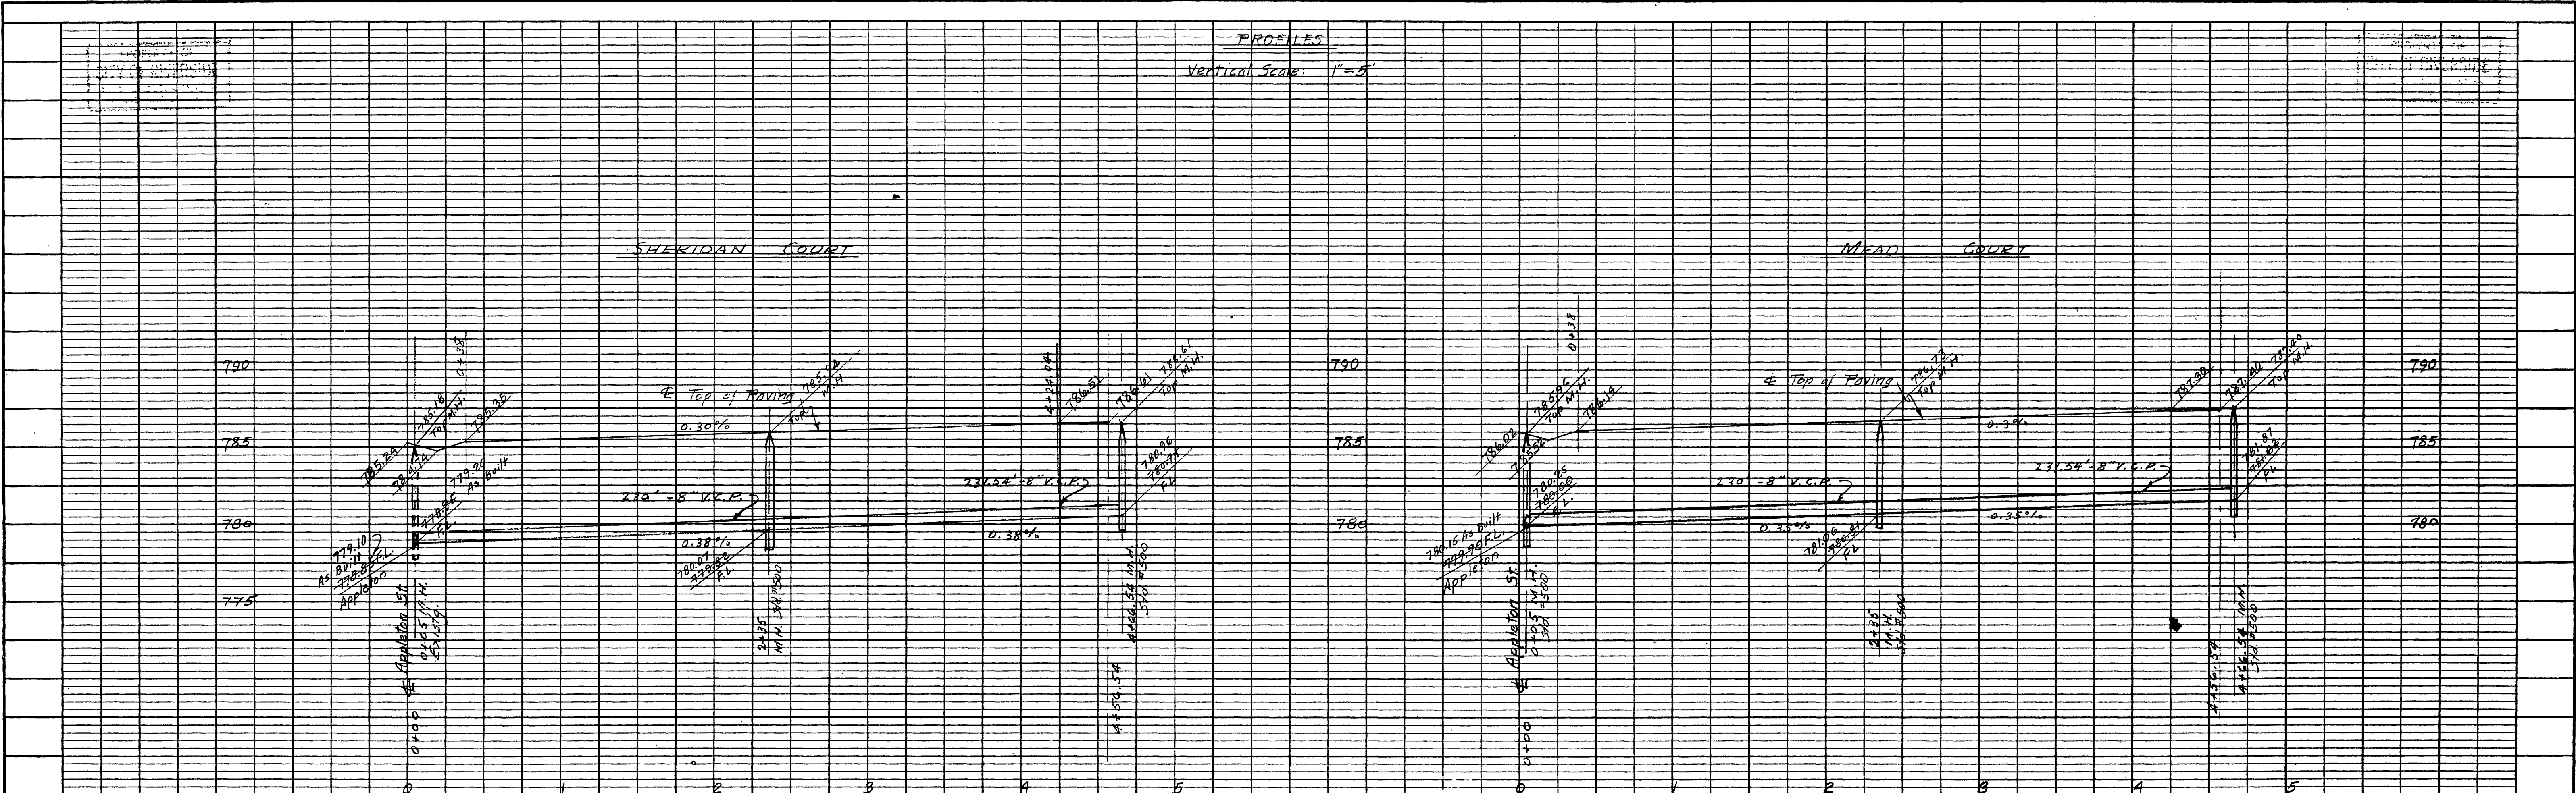

PROFILE	DATE
SUBMITTED	
NOTED	
GRADING CHECKED	
STRUCTURE NOTING CHECKED	

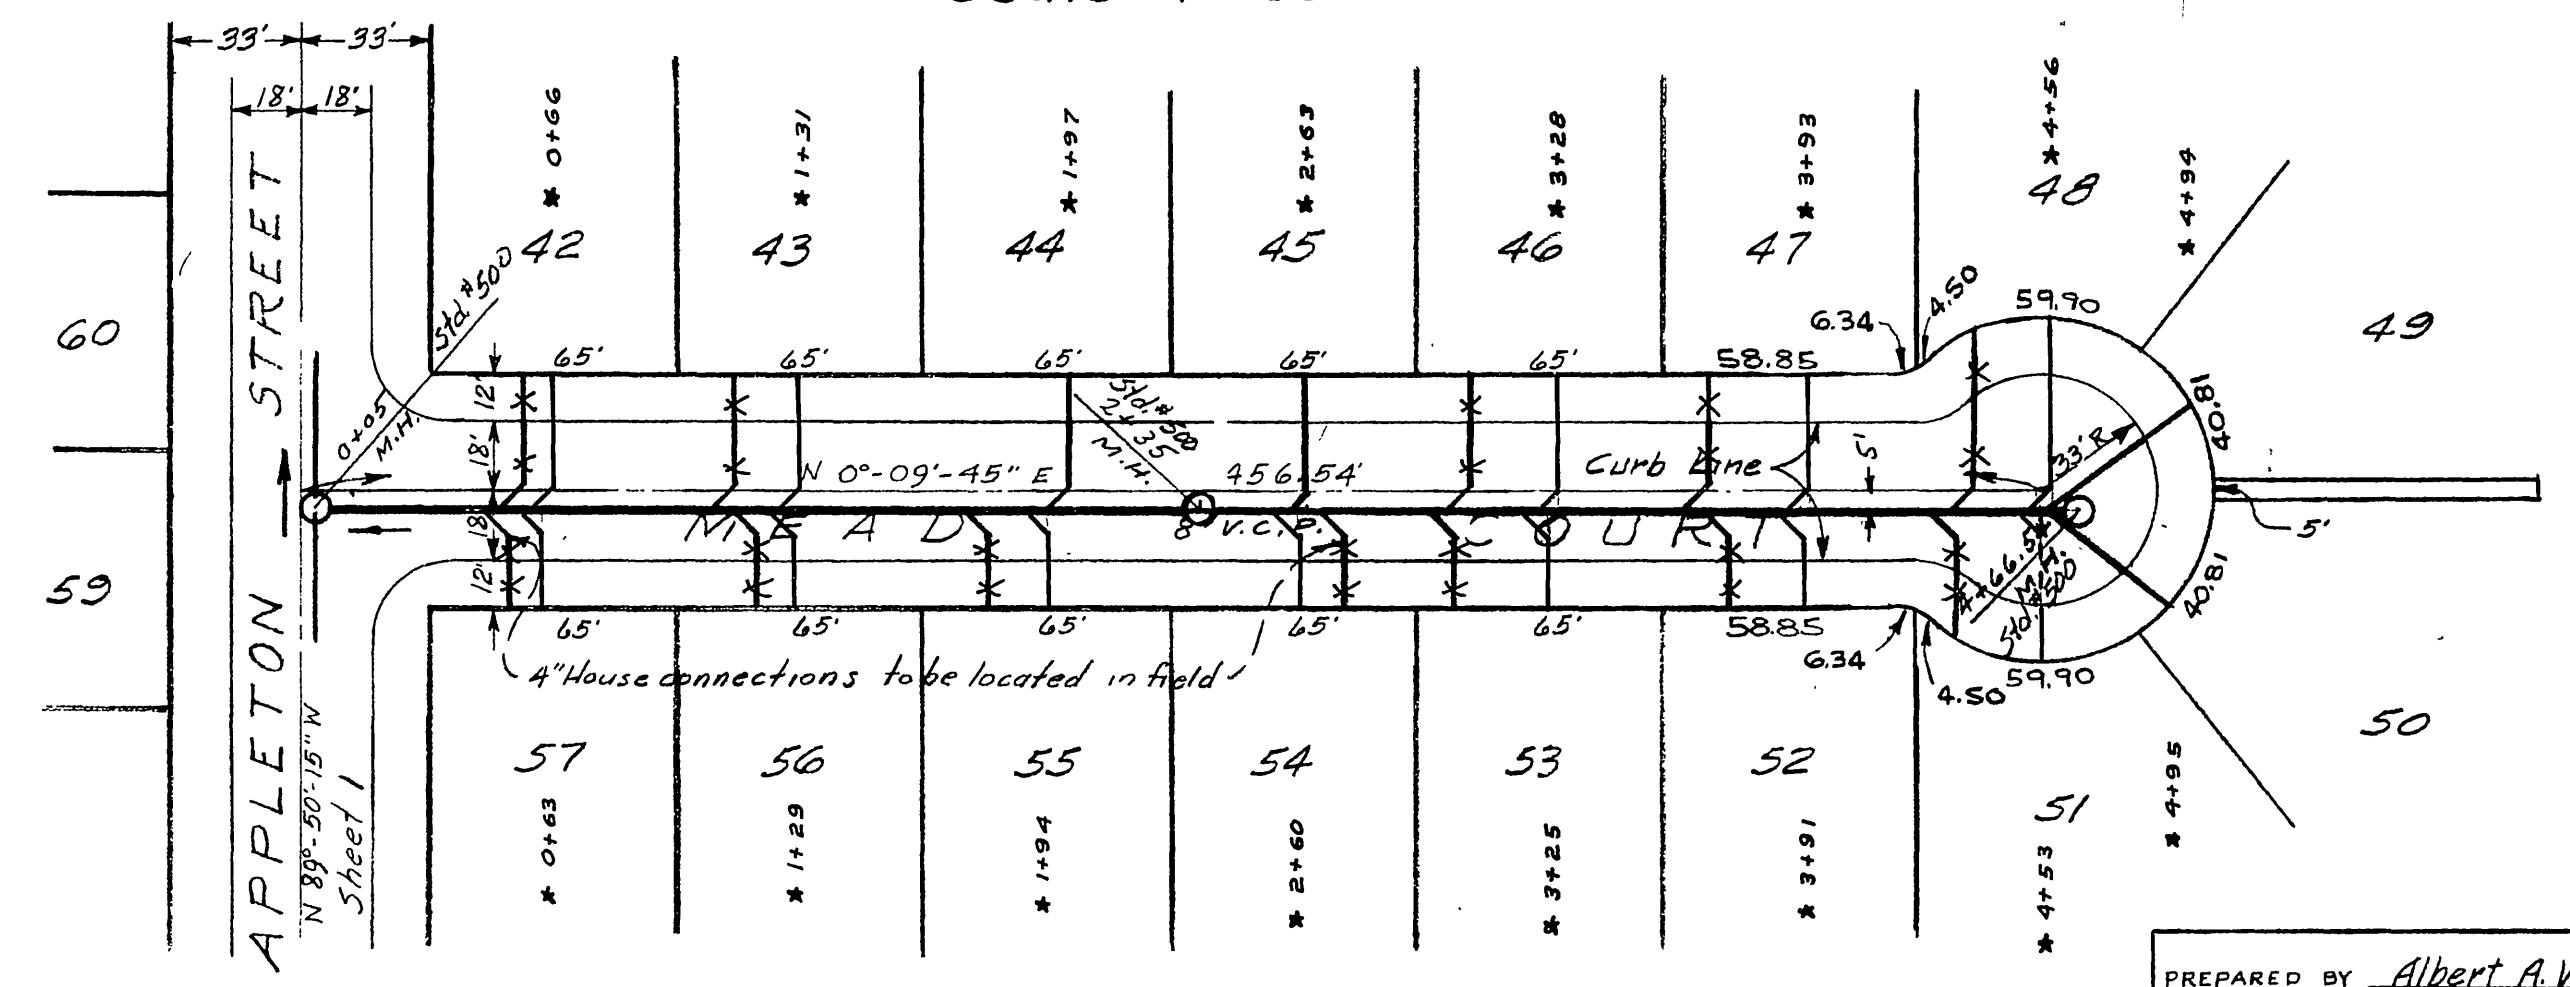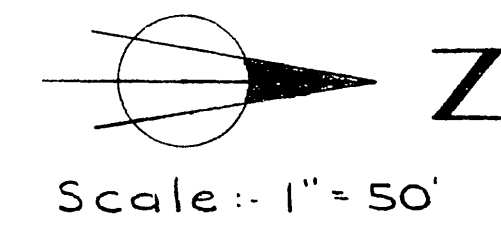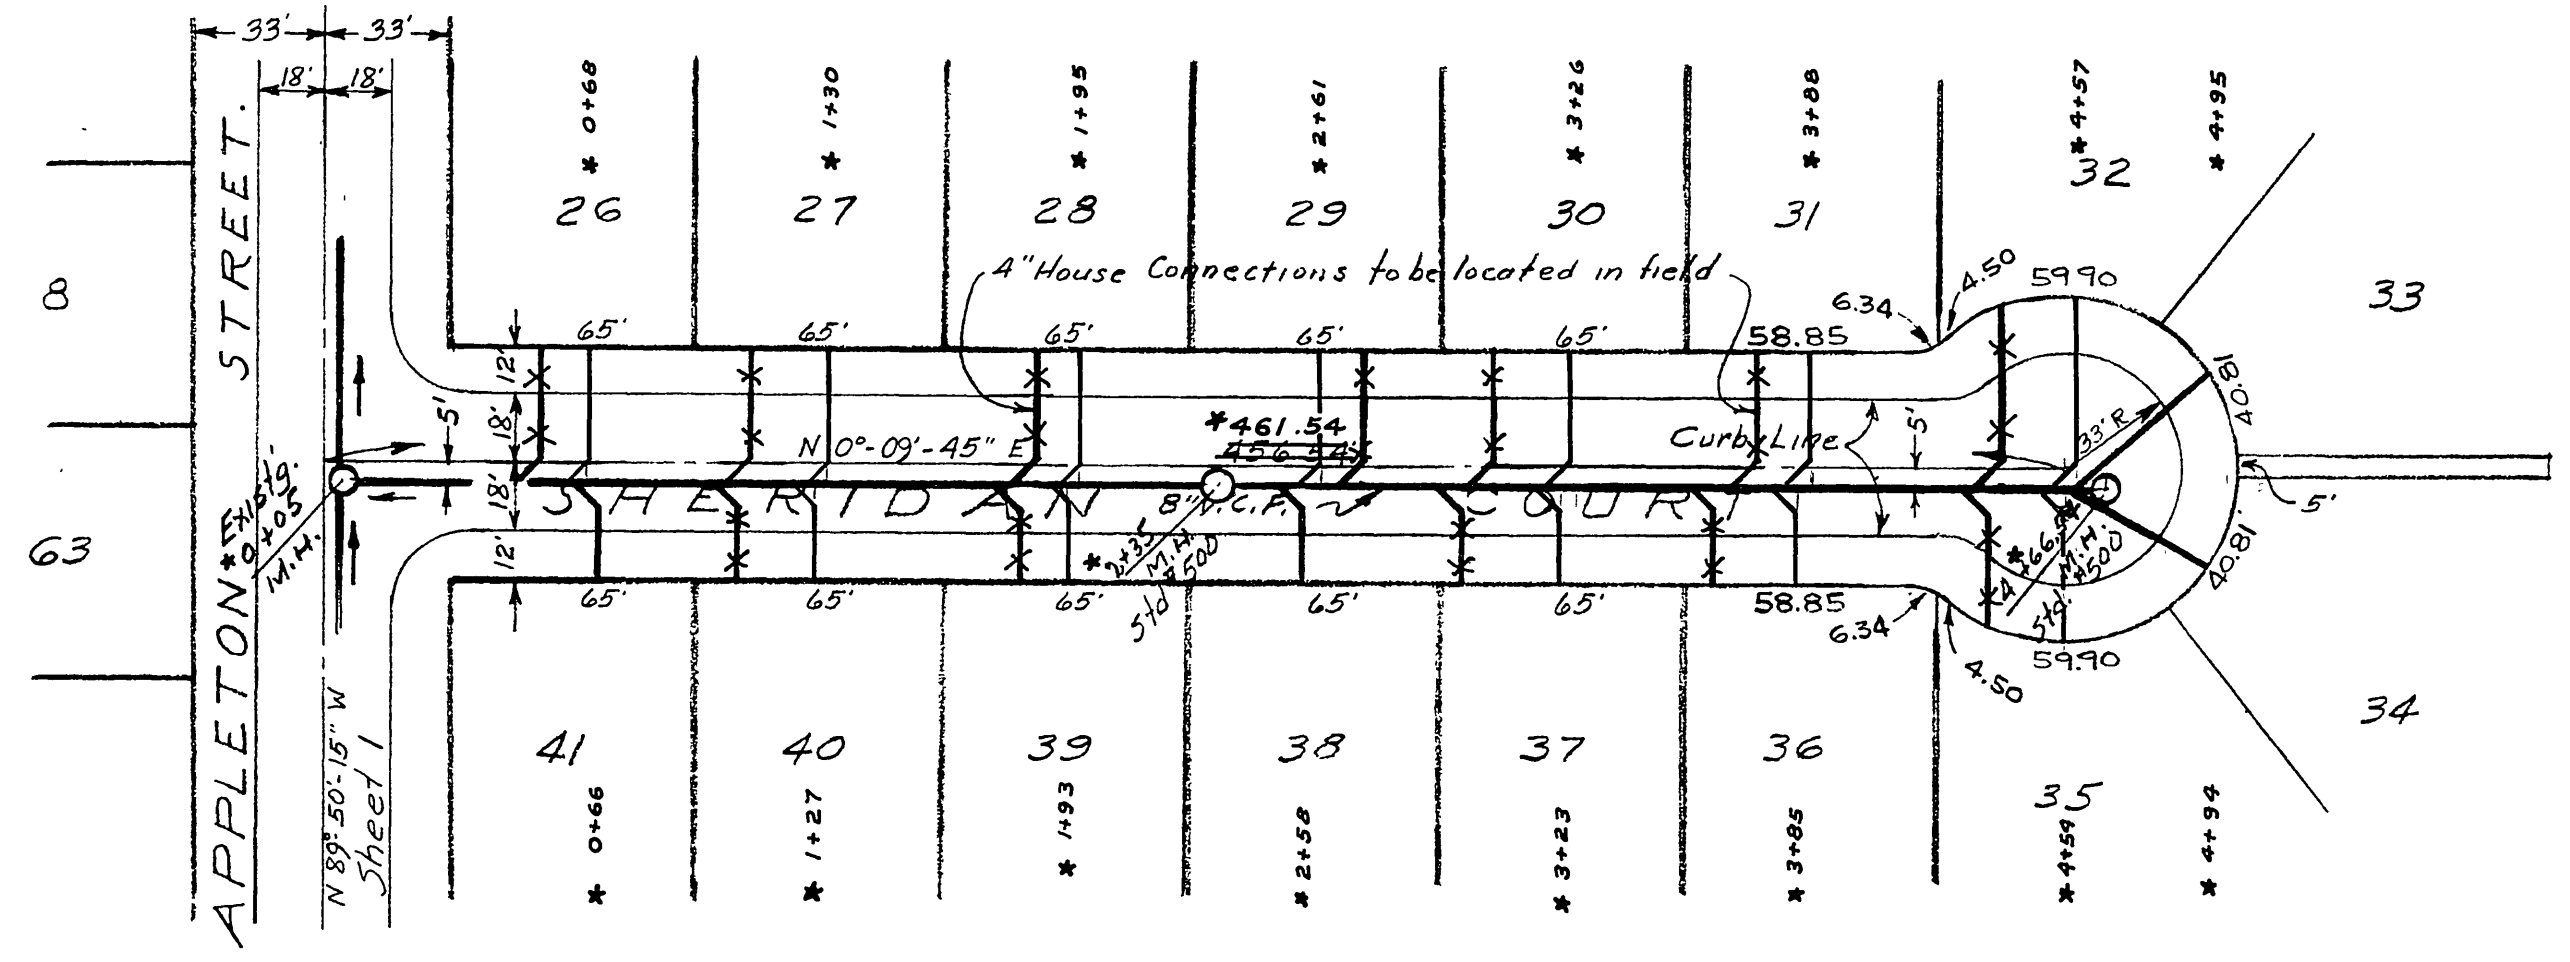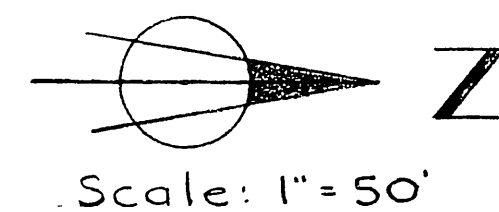

PLAN	DATE
ALIGNED	
CHECKED	
BY	
DATE	

**KINGSLEY HOMES UNIT NO. 2**  
**QUANTITY ESTIMATE**

STREET	8" V.C.P.	4" V.C.P.	8" x 4" Wye	54" 500 M.H.	54" 500 C.O.
APPLETON	334 lin. ft.	228 lin. ft.	6	1	1
SHERIDAN	462 lin. ft.	530 lin. ft.	16	2	—
MEAD	462 lin. ft.	530 lin. ft.	16	2	—
TOTALS	1258 lin. ft.	1288 lin. ft.	38	5	1

Revised 1-26-69  
Sewer Grades Unit 2 HM.  
Revised 4-23-59 REC

PREPARED BY Albert A. Webb Associates  
APPROVED BY *E. N. Webb* DATE 5/15/59  
CITY OF RIVERSIDE, CALIFORNIA  
DEPARTMENT OF PUBLIC WORKS  
**SEWER PLAN & PROFILE**  
KINGSLEY HOMES  
UNIT NO. 2  
SHERIDAN COURT & MEAD COURT  
APPROVED BY *A. J. Martindale*  
DIRECTOR OF PUBLIC WORKS  
5-28-59 UNIT NO. 2  
DATE 12-23-55 UNIT NO. 1  
**S-180**  
SHEET 2 OF 2

\*= AS BUILT 2/17/60 B.L.W.