



B.M. ELEV. 799.454 S&L IN WEIR BOX
 N.W. COR. ADAMS AND MAGNOLIA
 F.B. G-26/31, 658/18
 SCALE: HOR. 1"=50'
 VERT. 1"=5'

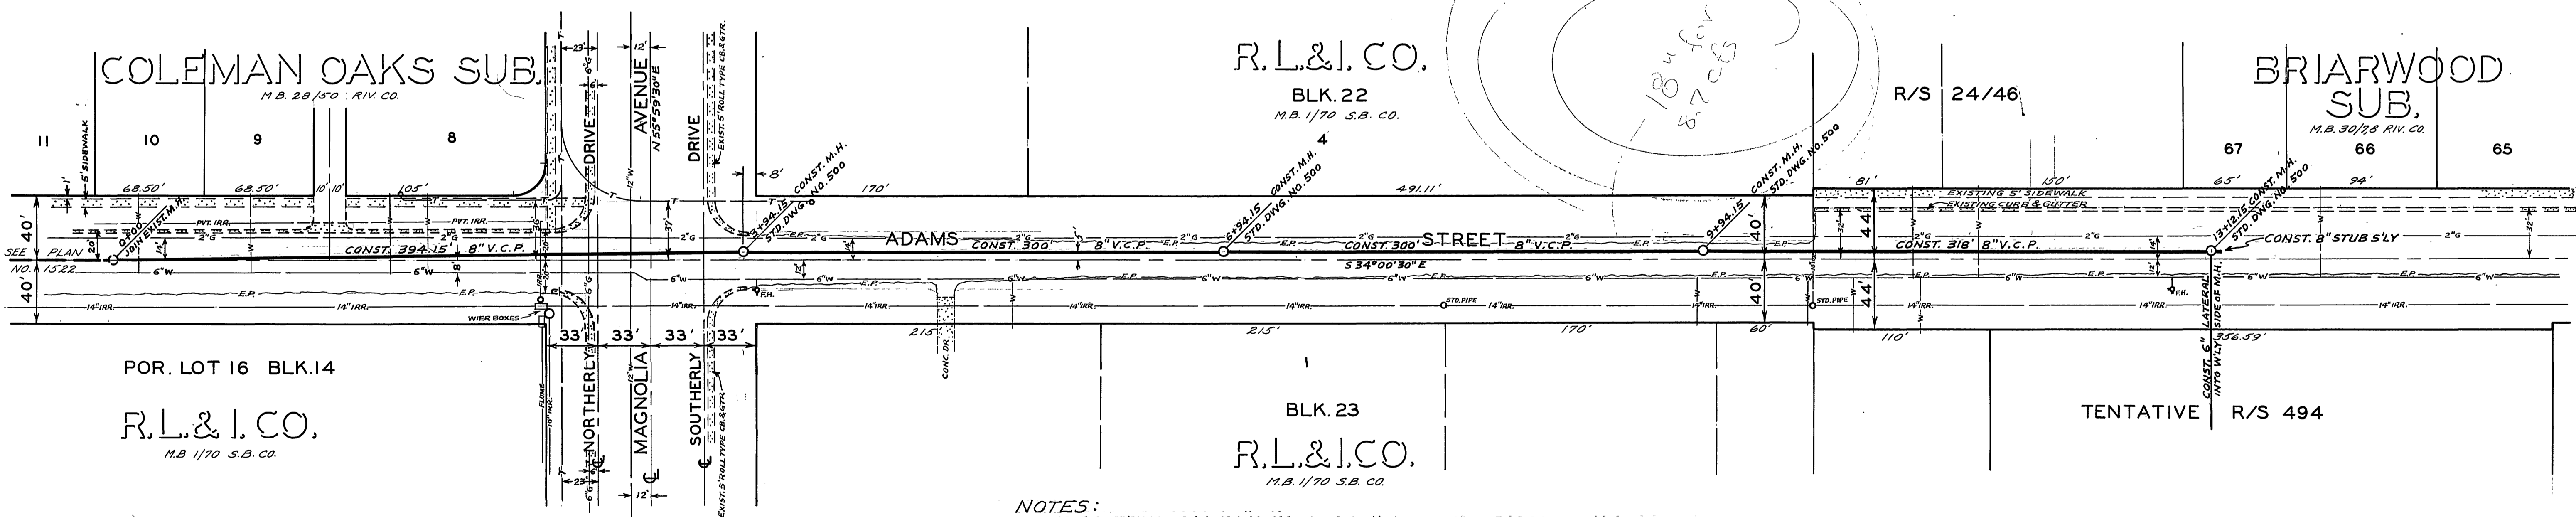

NOTES:
 1- For additional topo. near property lines see Plan R-292.
 2- Water line laterals shown are approximate only. Locate in field.

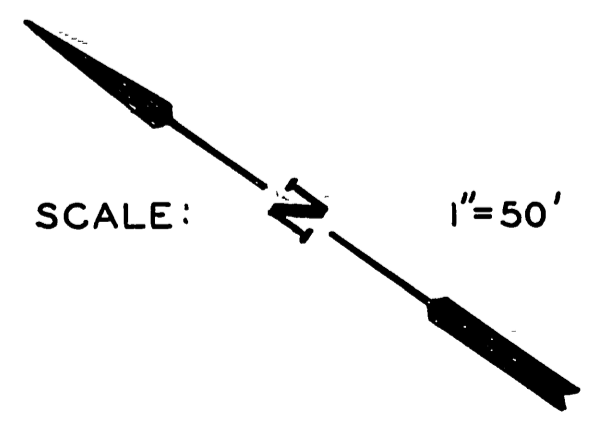

NOTE:
 It shall be the responsibility of the Contractor to clear the right of way in accordance with the provisions of the law as it affects each utility including irrigation lines and appurtenances and at no cost to the City.

REVISIONS		CITY OF RIVERSIDE CALIFORNIA DEPARTMENT OF PUBLIC WORKS
MARK	DATE	
		ADAMS STREET SEWER 336' NLY. TO 976.11' SLY. OF CL MAGNOLIA AVE.

S-186