
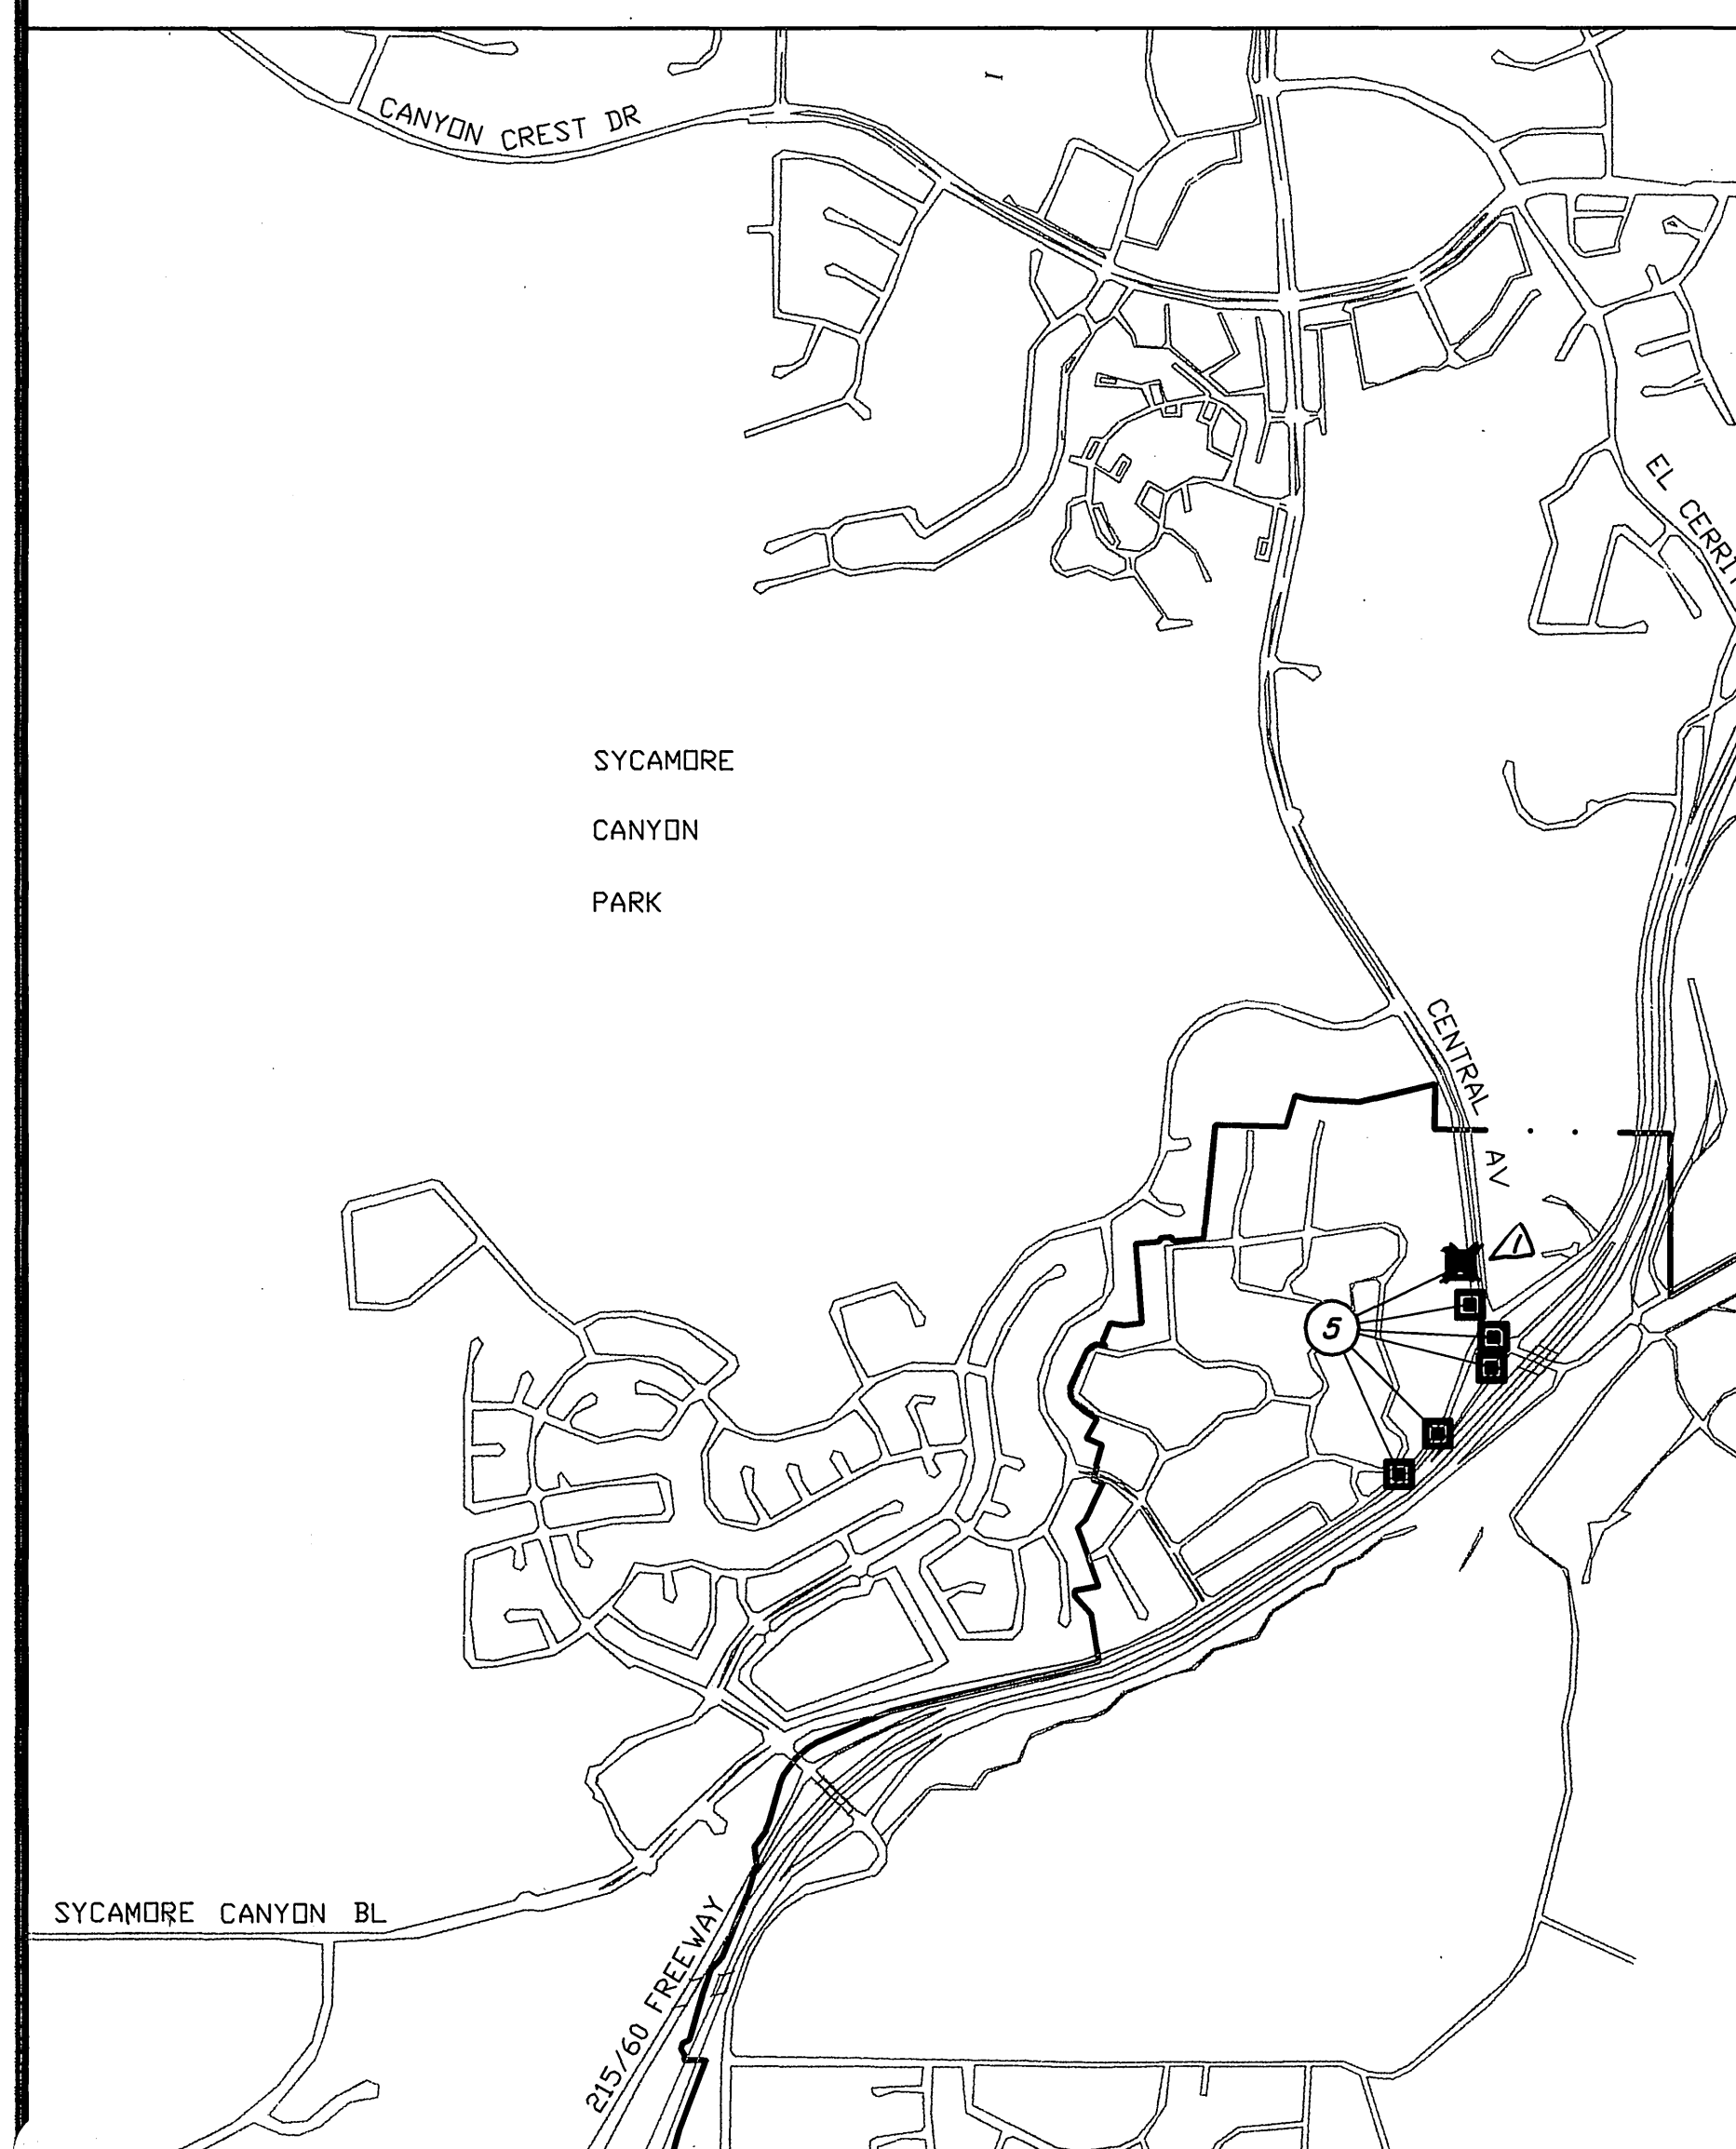


GENERAL CONSTRUCTION NOTES:

- ① PRIME CONTRACTORS BIDDING THIS WORK SHALL HAVE A CLASS "A", "C-34", OR A "C-42" LICENSE.
- ② CONSTRUCTION SHALL BE IN ACCORDANCE WITH THE CITY OF RIVERSIDE STANDARD DRAWINGS AND STANDARD SPECIFICATIONS FOR PUBLIC WORKS CONSTRUCTION, 1997 EDITION.

SPECIFIC CONSTRUCTION NOTES:

- # PROJECT SITE NUMBER.
- ADJUST OR RECONSTRUCT CONCRETE SEWER MANHOLES TO GRADE PER CITY OF RIVERSIDE STD. DWG. 500.
- ★ REMOVE BRICK SEWER MANHOLES AND RECONSTRUCT PER CITY OF RIVERSIDE STD. DWG. 500.
- ▣ ADJUST OR RECONSTRUCT "T-LOCK" PVC LINED SEWER MANHOLES TO GRADE PER CITY OF RIVERSIDE STD. DWG. 500 AND EXHIBIT "A" (ATTACHED TO THE SPECIAL PROVISIONS).

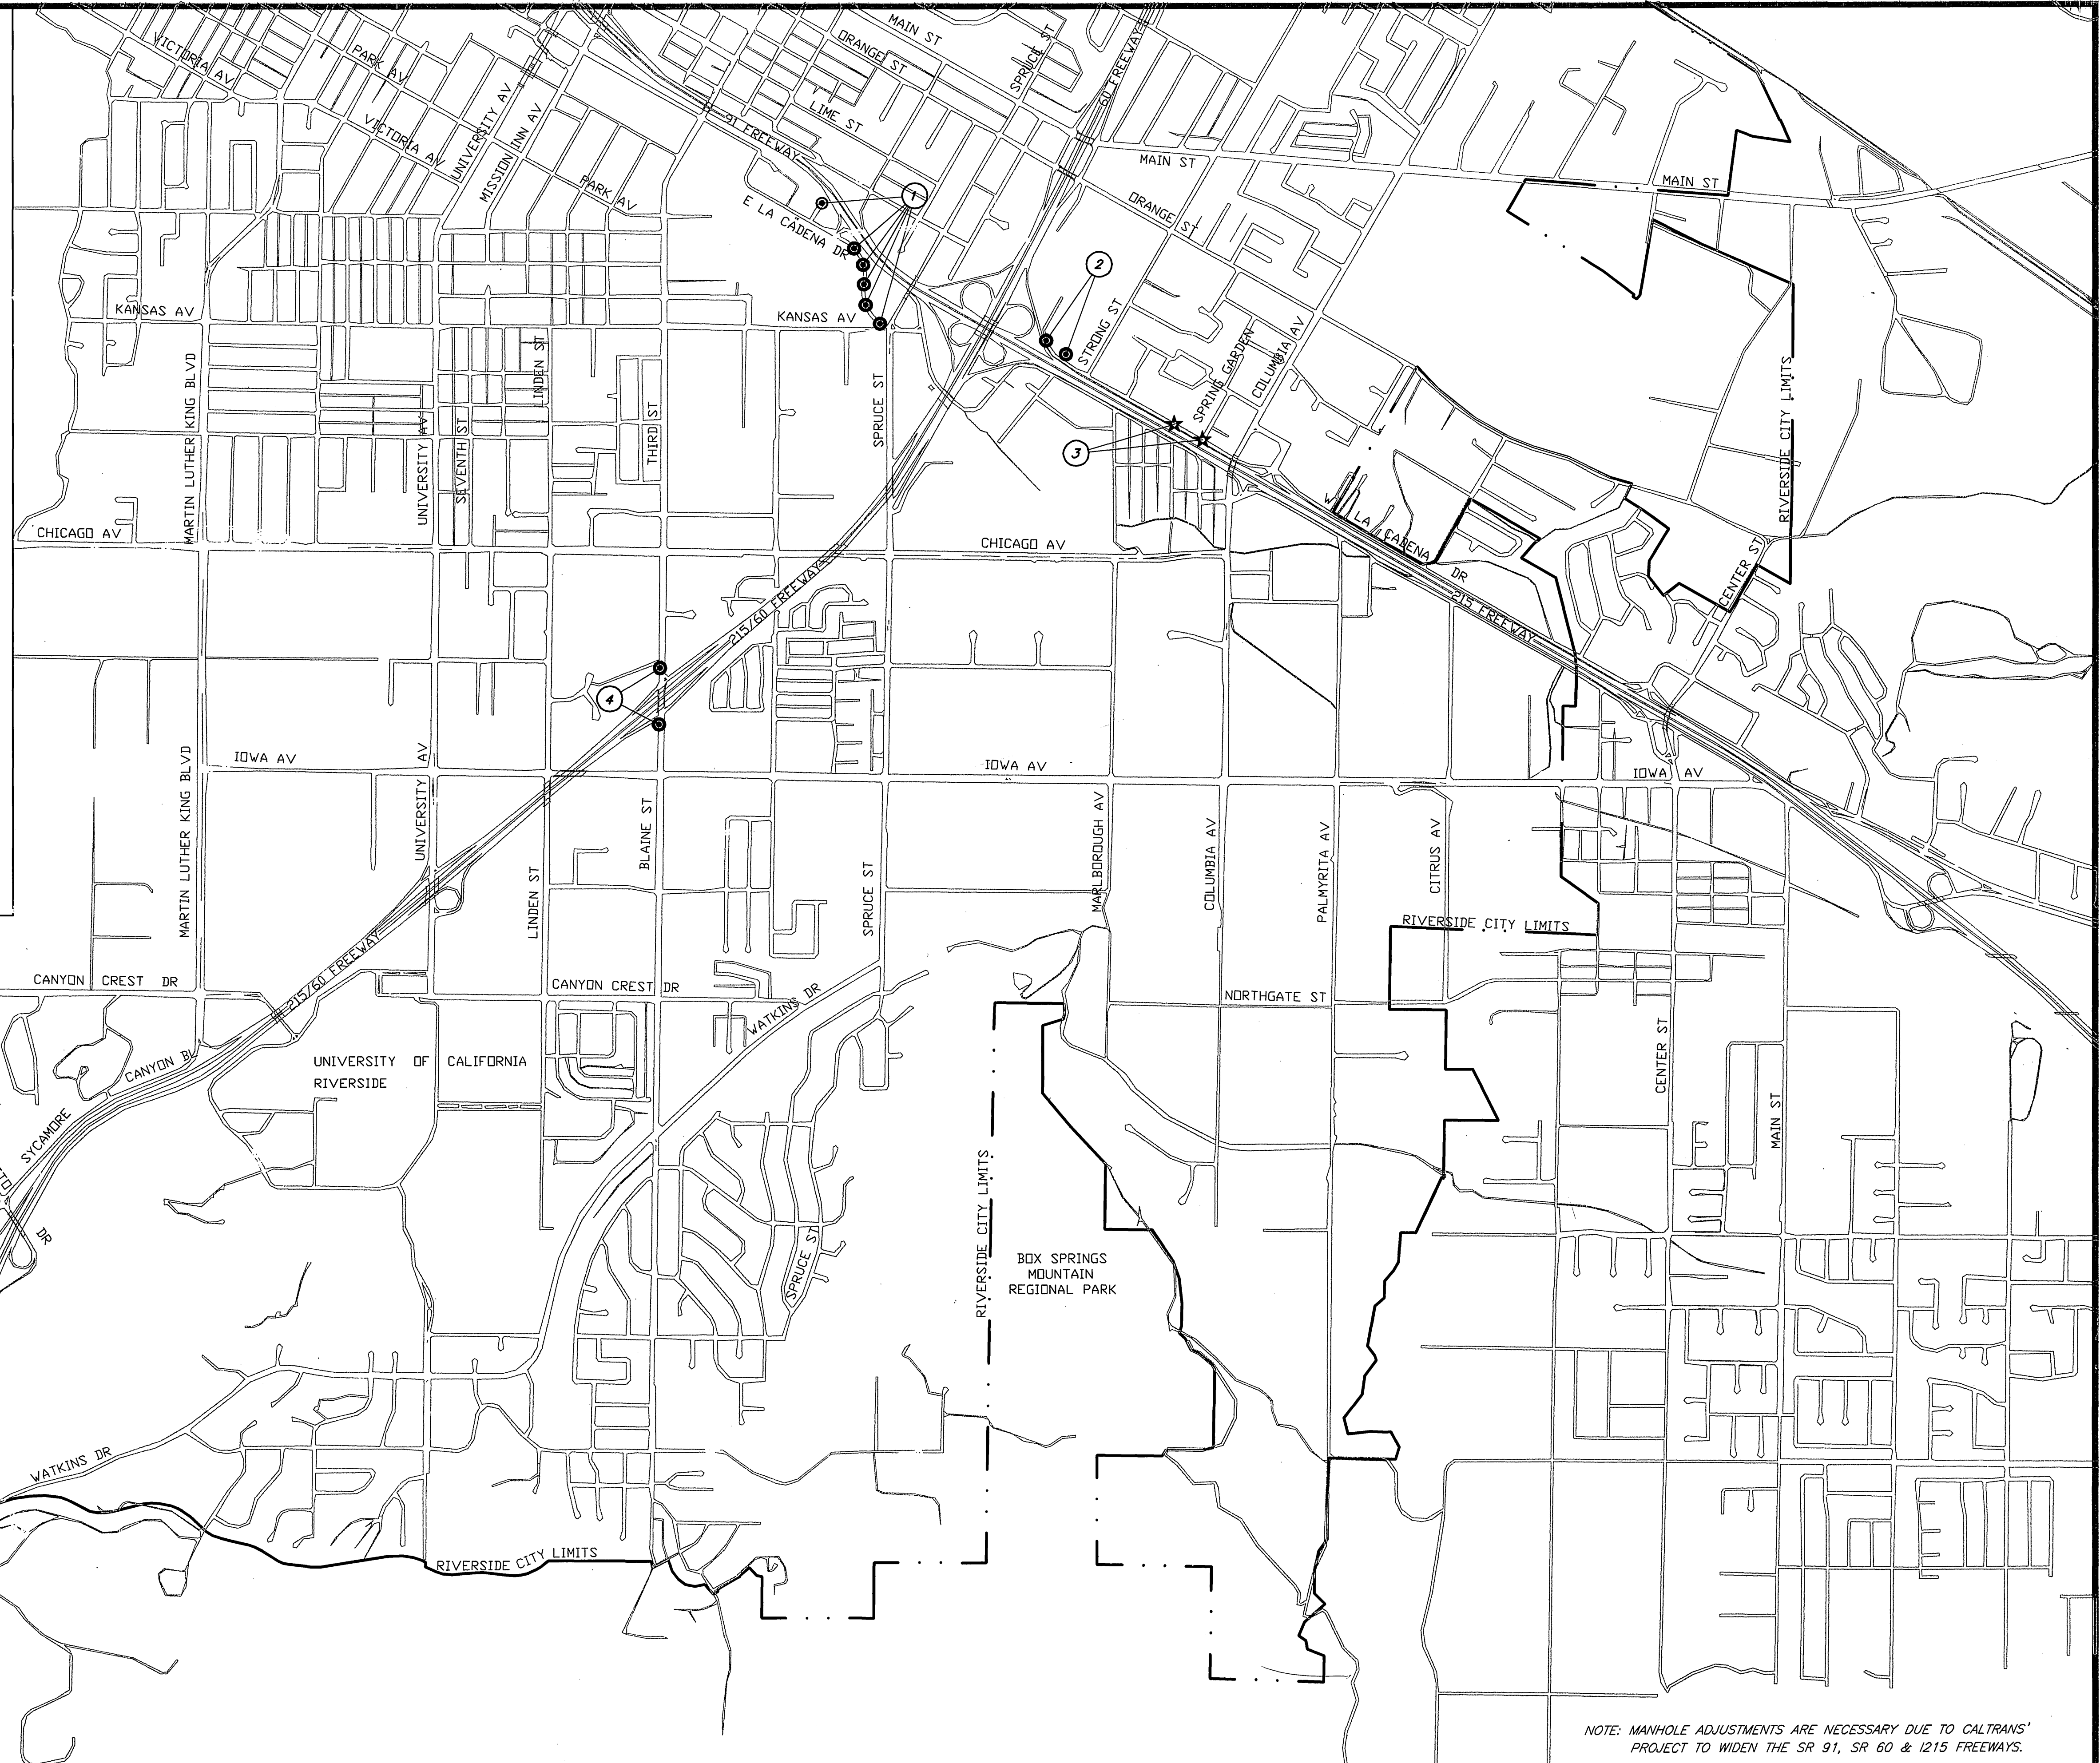

NOTE: MANHOLE ADJUSTMENTS ARE NECESSARY DUE TO CALTRANS' PROJECT TO WIDEN THE SR 91, SR 60 & I215 FREEWAYS.

ENGINEER IN RESPONSIBLE CHARGE
Lauren F. Caldwell
 LAUREN F. CALDWELL
 R.C.E. No. 39441 expires 12/31/2005
 DATE 3/1/2005



ADDED SHEET 2 WHICH INCLUDES PROJECT SITE #6 & SHALLOW M.H. MODIFICATION DETAIL. DELETED ONE M.H. FROM PROJECT SITE #5 ON SHEET 1.	
MARK	REVISIONS
DESIGNED BY SK	DRAWN BY SK
CHECKED BY	DATE

CITY OF RIVERSIDE, CALIFORNIA PUBLIC WORKS DEPARTMENT			
APPROVED BY	BY	DATE	APPROVED BY
PRINCIPAL ENGINEER	<i>[Signature]</i>		<i>[Signature]</i>
CONTRACT ADMINISTRATOR	<i>[Signature]</i>		CITY ENGINEER
INSPECTION			
SEWER DIVISION			
STREET SERVICES			
PARKS DEPARTMENT			
			DATE 3/1/05

ADJUST SEWER MANHOLES AT VARIOUS LOCATIONS

SCALE: 1" = 400'

ACT. NOS.: 976121001-44030109
 976221001-44030109
 976321001-44030109
 976421001-44030109




S-1888
 SHEET 1 OF 2

FILE NO.

INDEXED 7-11-05 LHH

SPECIFIC CONSTRUCTION NOTES:

- ① PROJECT SITE NUMBER.
- △ MODIFY 4' SQUARE MANHOLE AS SHOWN IN "SHALLOW MANHOLE MODIFICATION" DETAIL, BELOW.

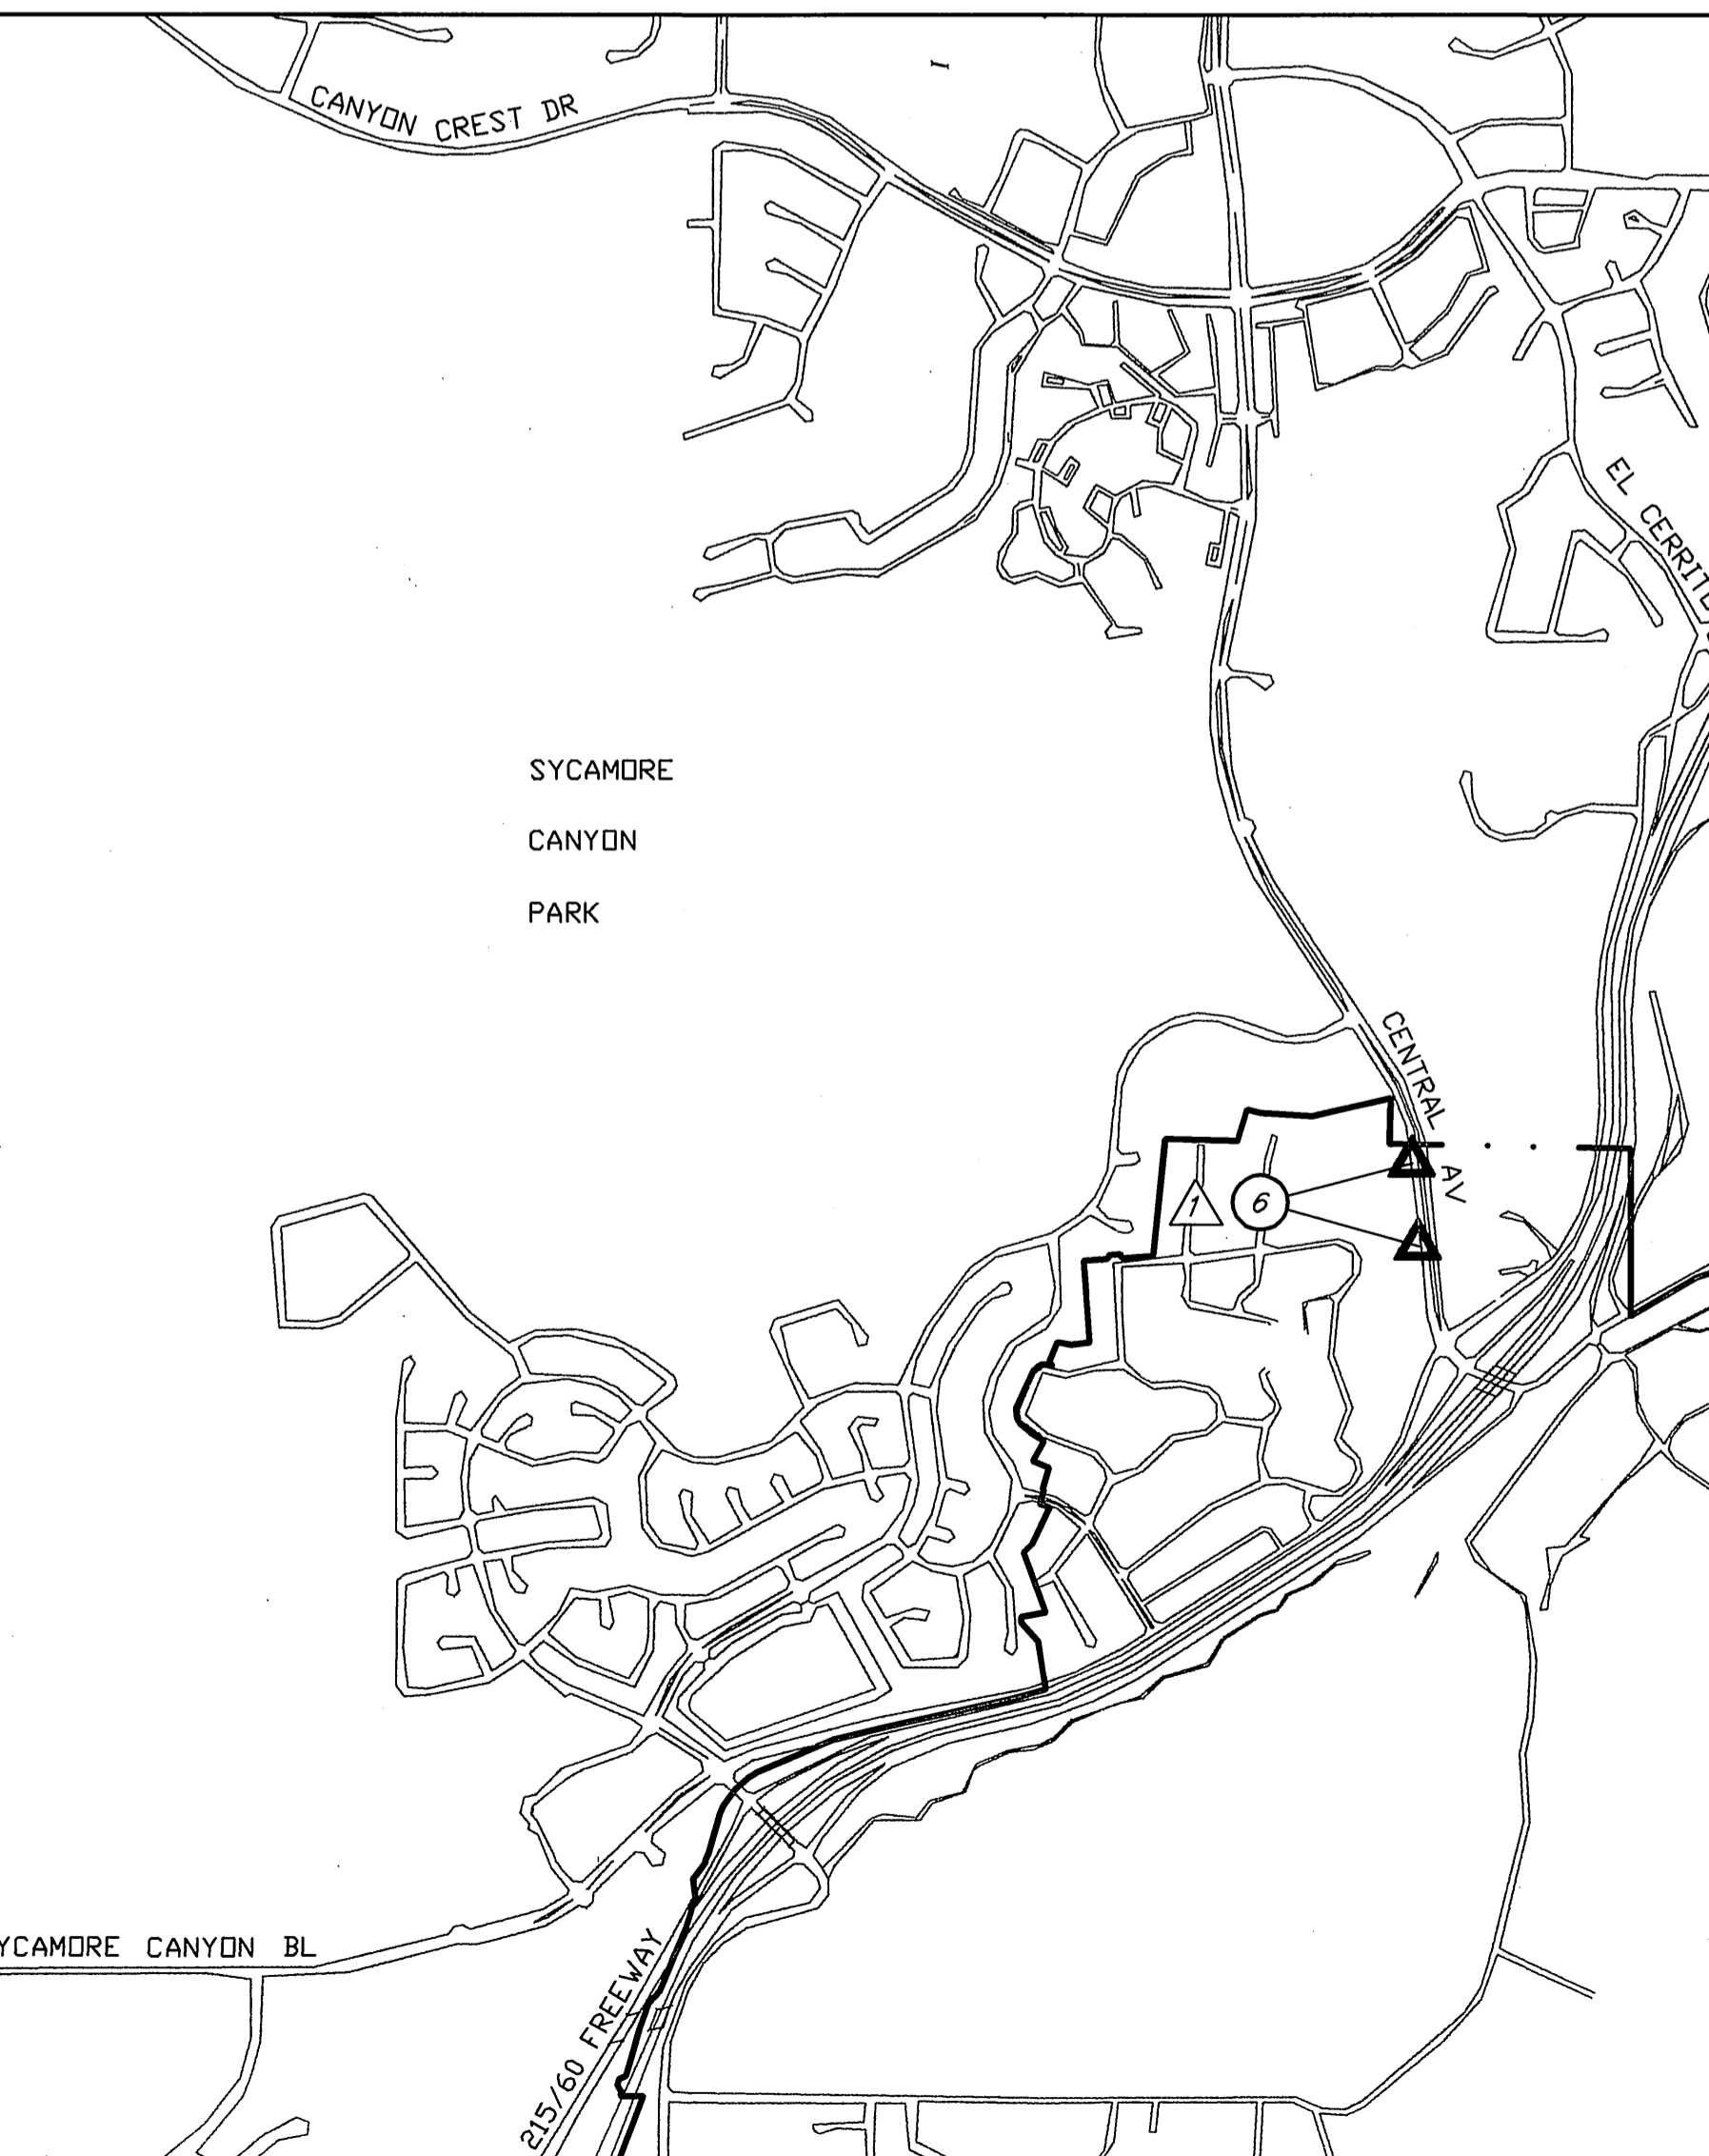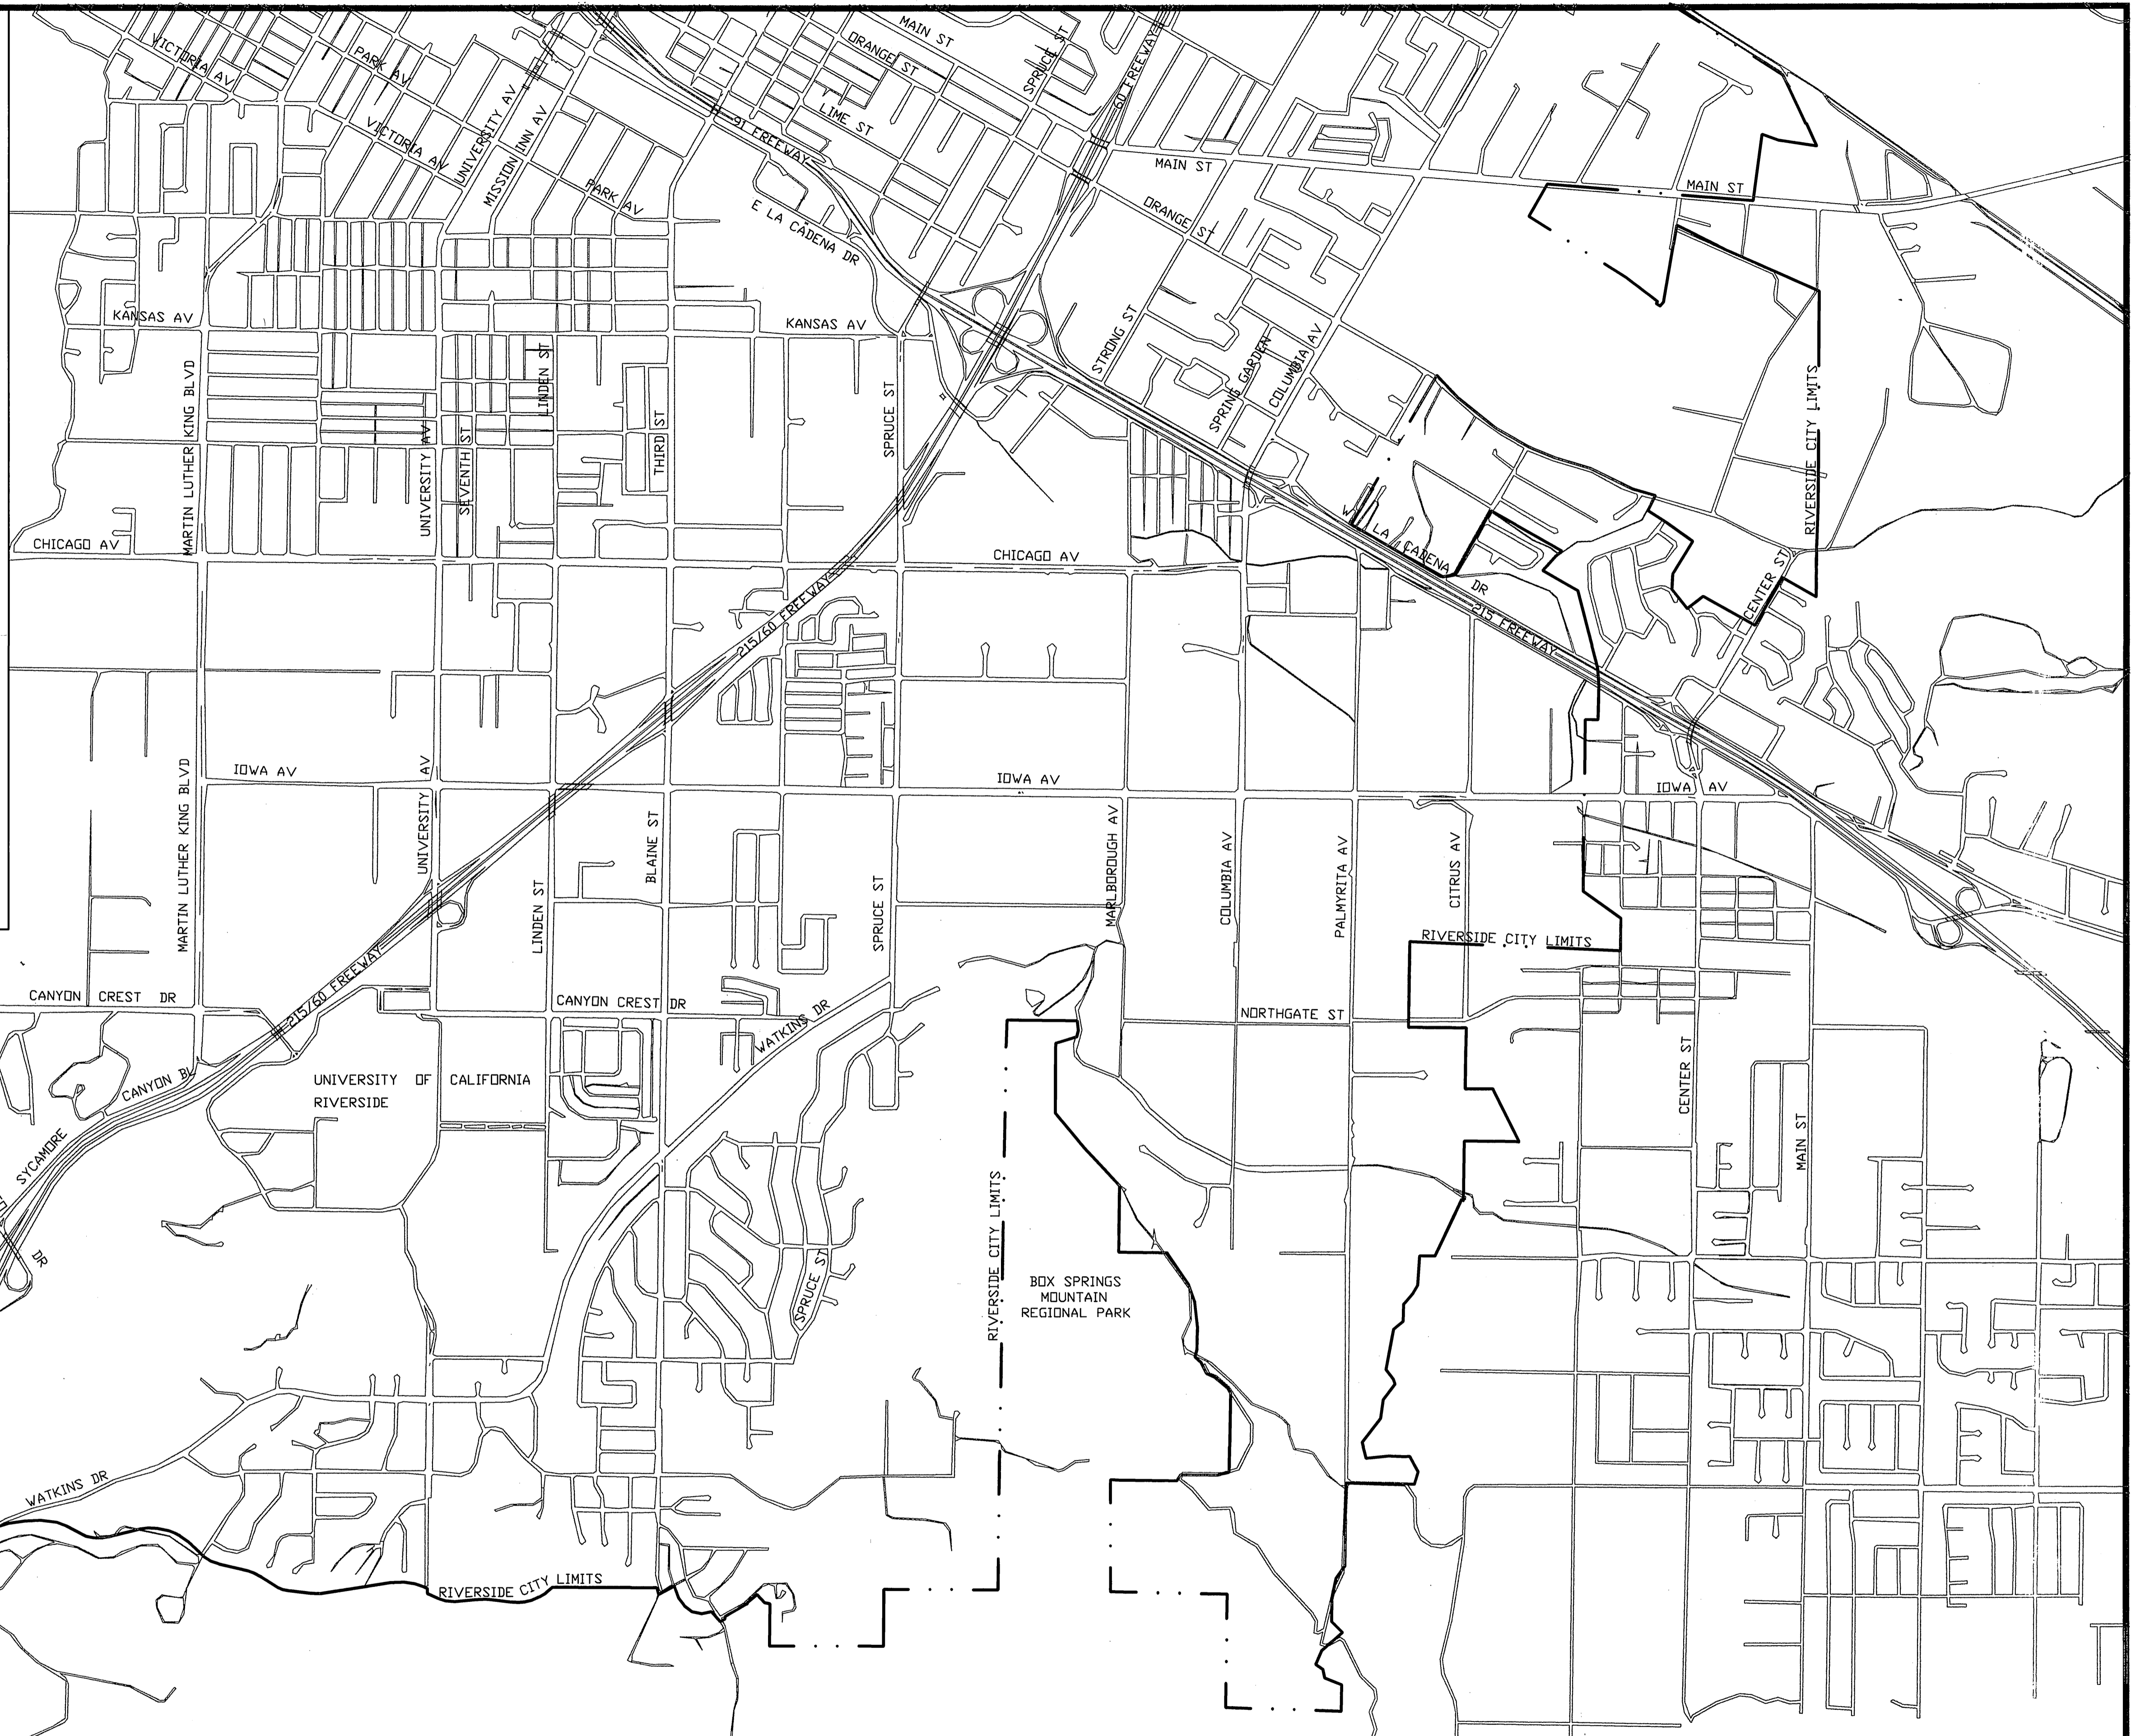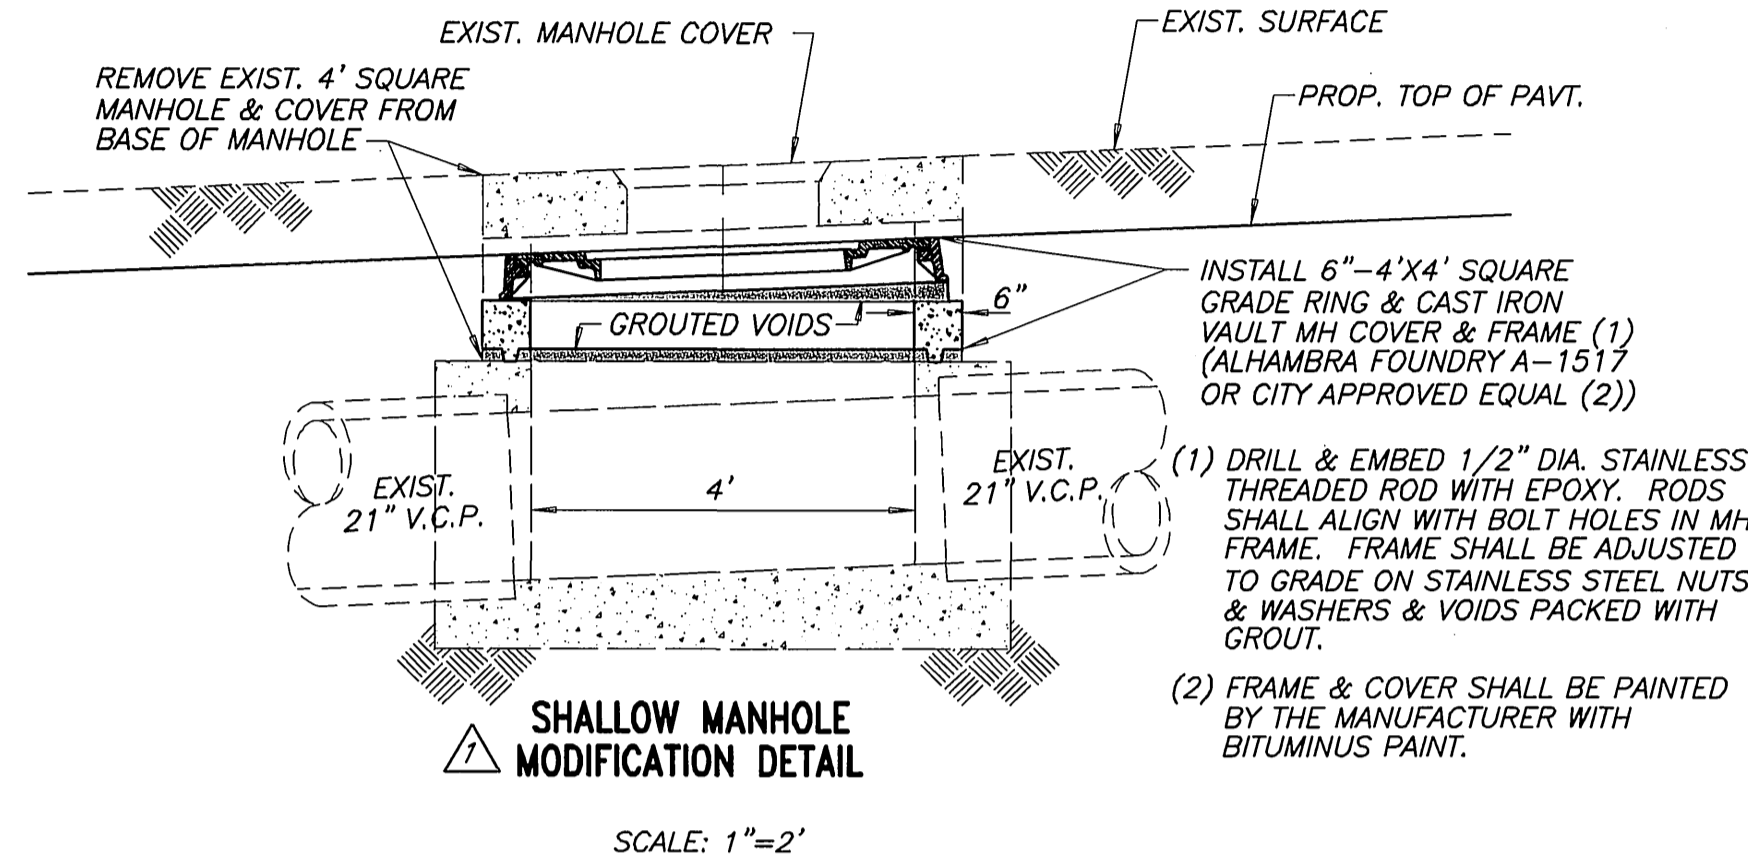

NOTE: MANHOLE ADJUSTMENTS ARE NECESSARY DUE TO CALTRANS' PROJECT TO WIDEN THE SR 91, SR 60 & I215 FREEWAYS.

ENGINEER IN RESPONSIBLE CHARGE
Lauren F. Caldwell
 LAUREN F. CALDWELL
 R.C.E. No. 39441 expires 12/31/2007
 DATE 5/14/2008

ADDED SHEET 2 WHICH INCLUDES PROJECT SITE #6 & SHALLOW MANHOLE MODIFICATION DETAIL. DELETED ONE MH FROM PROJECT SITE # 5 ON SHEET 1.

DESIGNED BY	SK	DRAWN BY	SK	CHECKED BY	
MARK		REVISIONS		APPR.	DATE

**CITY OF RIVERSIDE, CALIFORNIA
PUBLIC WORKS DEPARTMENT**

APPROVED BY	BY	DATE	APPROVED BY	BY	DATE
PRINCIPAL ENGINEER	<i>[Signature]</i>	5/14/08	CITY ENGINEER	<i>[Signature]</i>	5/14/08
CONTRACT ADMINISTRATOR					
SEWER DIVISION					
PLANNING DIVISION					
PUBLIC DEPARTMENT					

ADJUST SEWER MANHOLES AT VARIOUS LOCATIONS

SCALE: 1" = 400'

ACT. NOS. 97823203-4420109
 97823203-4420109
 97823203-4420109
 97823203-4420109
 97823203-4420109

S-1888
 SHEET 2 OF 2
 FILE NO.