


PROFILE
 SURVEYED
 NOTE BOOK PLOTTED, GRADES CHECKED
 NO. 21111/3 STRUCTURE NOMINATION SHEET
 BY H.M.
 DATE 7-2-59

SCALE: HOR. 1"=50'
 VERT. 1"=5'

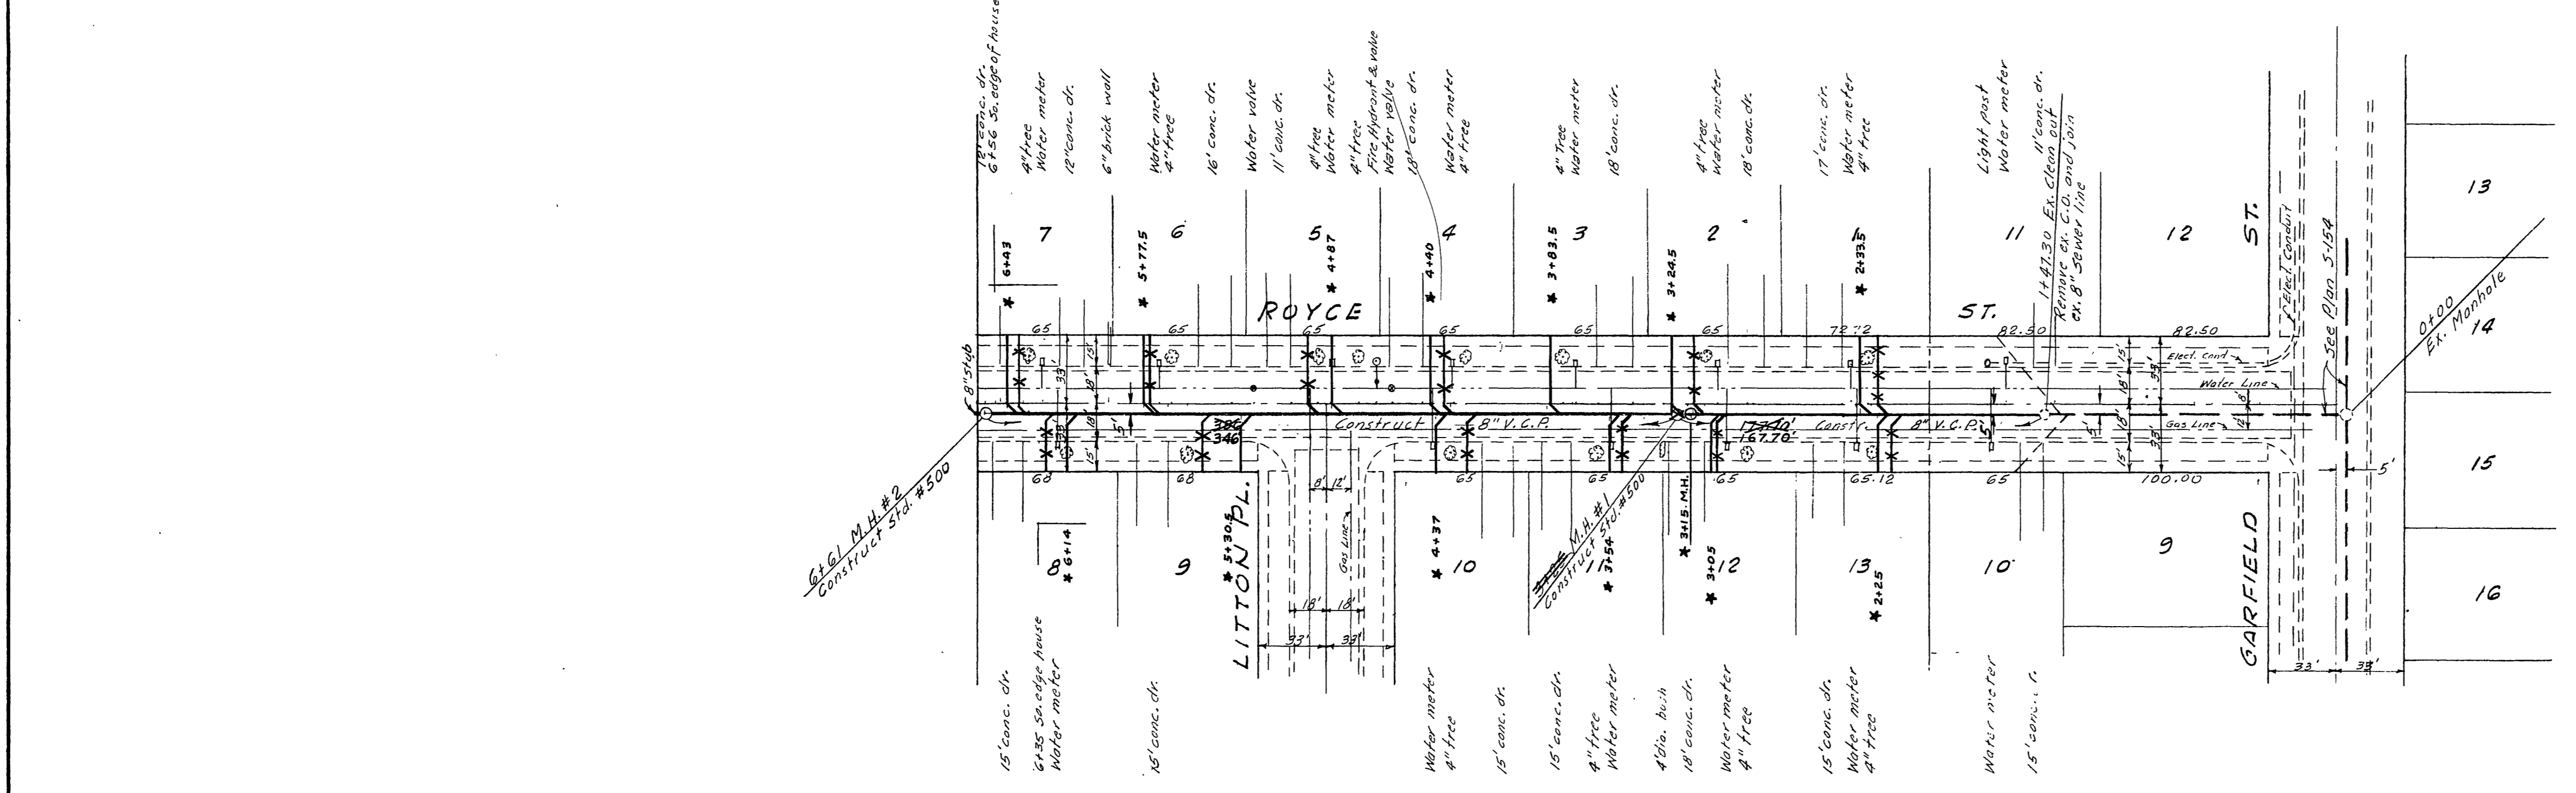

SCALE: 1"=50'

PLAN
 SURVEYED
 NOTE BOOK PLOTTED, ALIGNMENT CHECKED, RT. OF WAY CHECKED
 NO. 21111/3
 BY H.M.
 DATE 7-2-59

QUANTITY ESTIMATE

8" Vitrified Clay Pipe	1011 lin. ft.
4" Vitrified Clay Pipe	830 lin. ft.
8" x 4" Wyes	25
Std. #500 Manholes	4
Std. #560 Cleanout	1



BENCH MARK
 Top of Fire Hydrant Southwest corner Litton & Monroe.
 Elev. 769.85. FB 1911A 3/76.

GENERAL NOTES:
 House Connection Wyes shall be field located.
 Construction shall be in accordance with Specifications of the City of Riverside, Department of Public Works.

NOTE:
 It shall be the responsibility of the Contractor to clear the right of way to the edge of the pipe trench with the proper depth and width as indicated on the drawings and to provide extra pipe for the City.

★ AS BULIT 2/11/60 B.LOW

REVISIONS		CITY OF RIVERSIDE CALIFORNIA DEPARTMENT OF PUBLIC WORKS	
MARK	DATE	DESCRIPTION	
			HOLLY PARK SANITARY SEWER DISTRICT ROYCE STREET
DESIGNED BY	H.M.	CHECKED BY	APPROVED BY
DRAWN BY	H.M.	<i>E. N. Wall</i> RE 4876	<i>D. Mantel</i> DIRECTOR OF PUBLIC WORKS
RECOMMENDED BY	<i>A. P. Thal</i> ASSISTANT CITY ENGINEER	DATE	5-192 Sept. 29, 1959 SHEET 1 OF 2

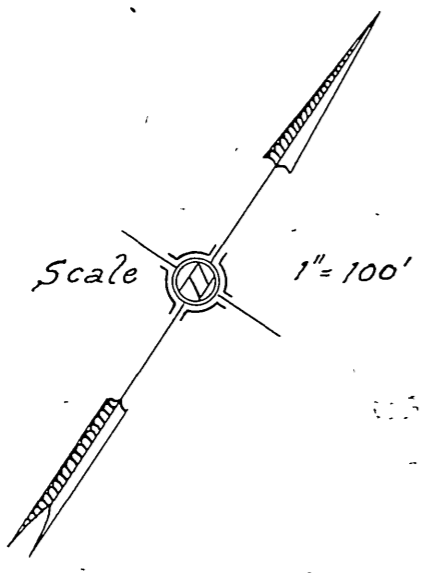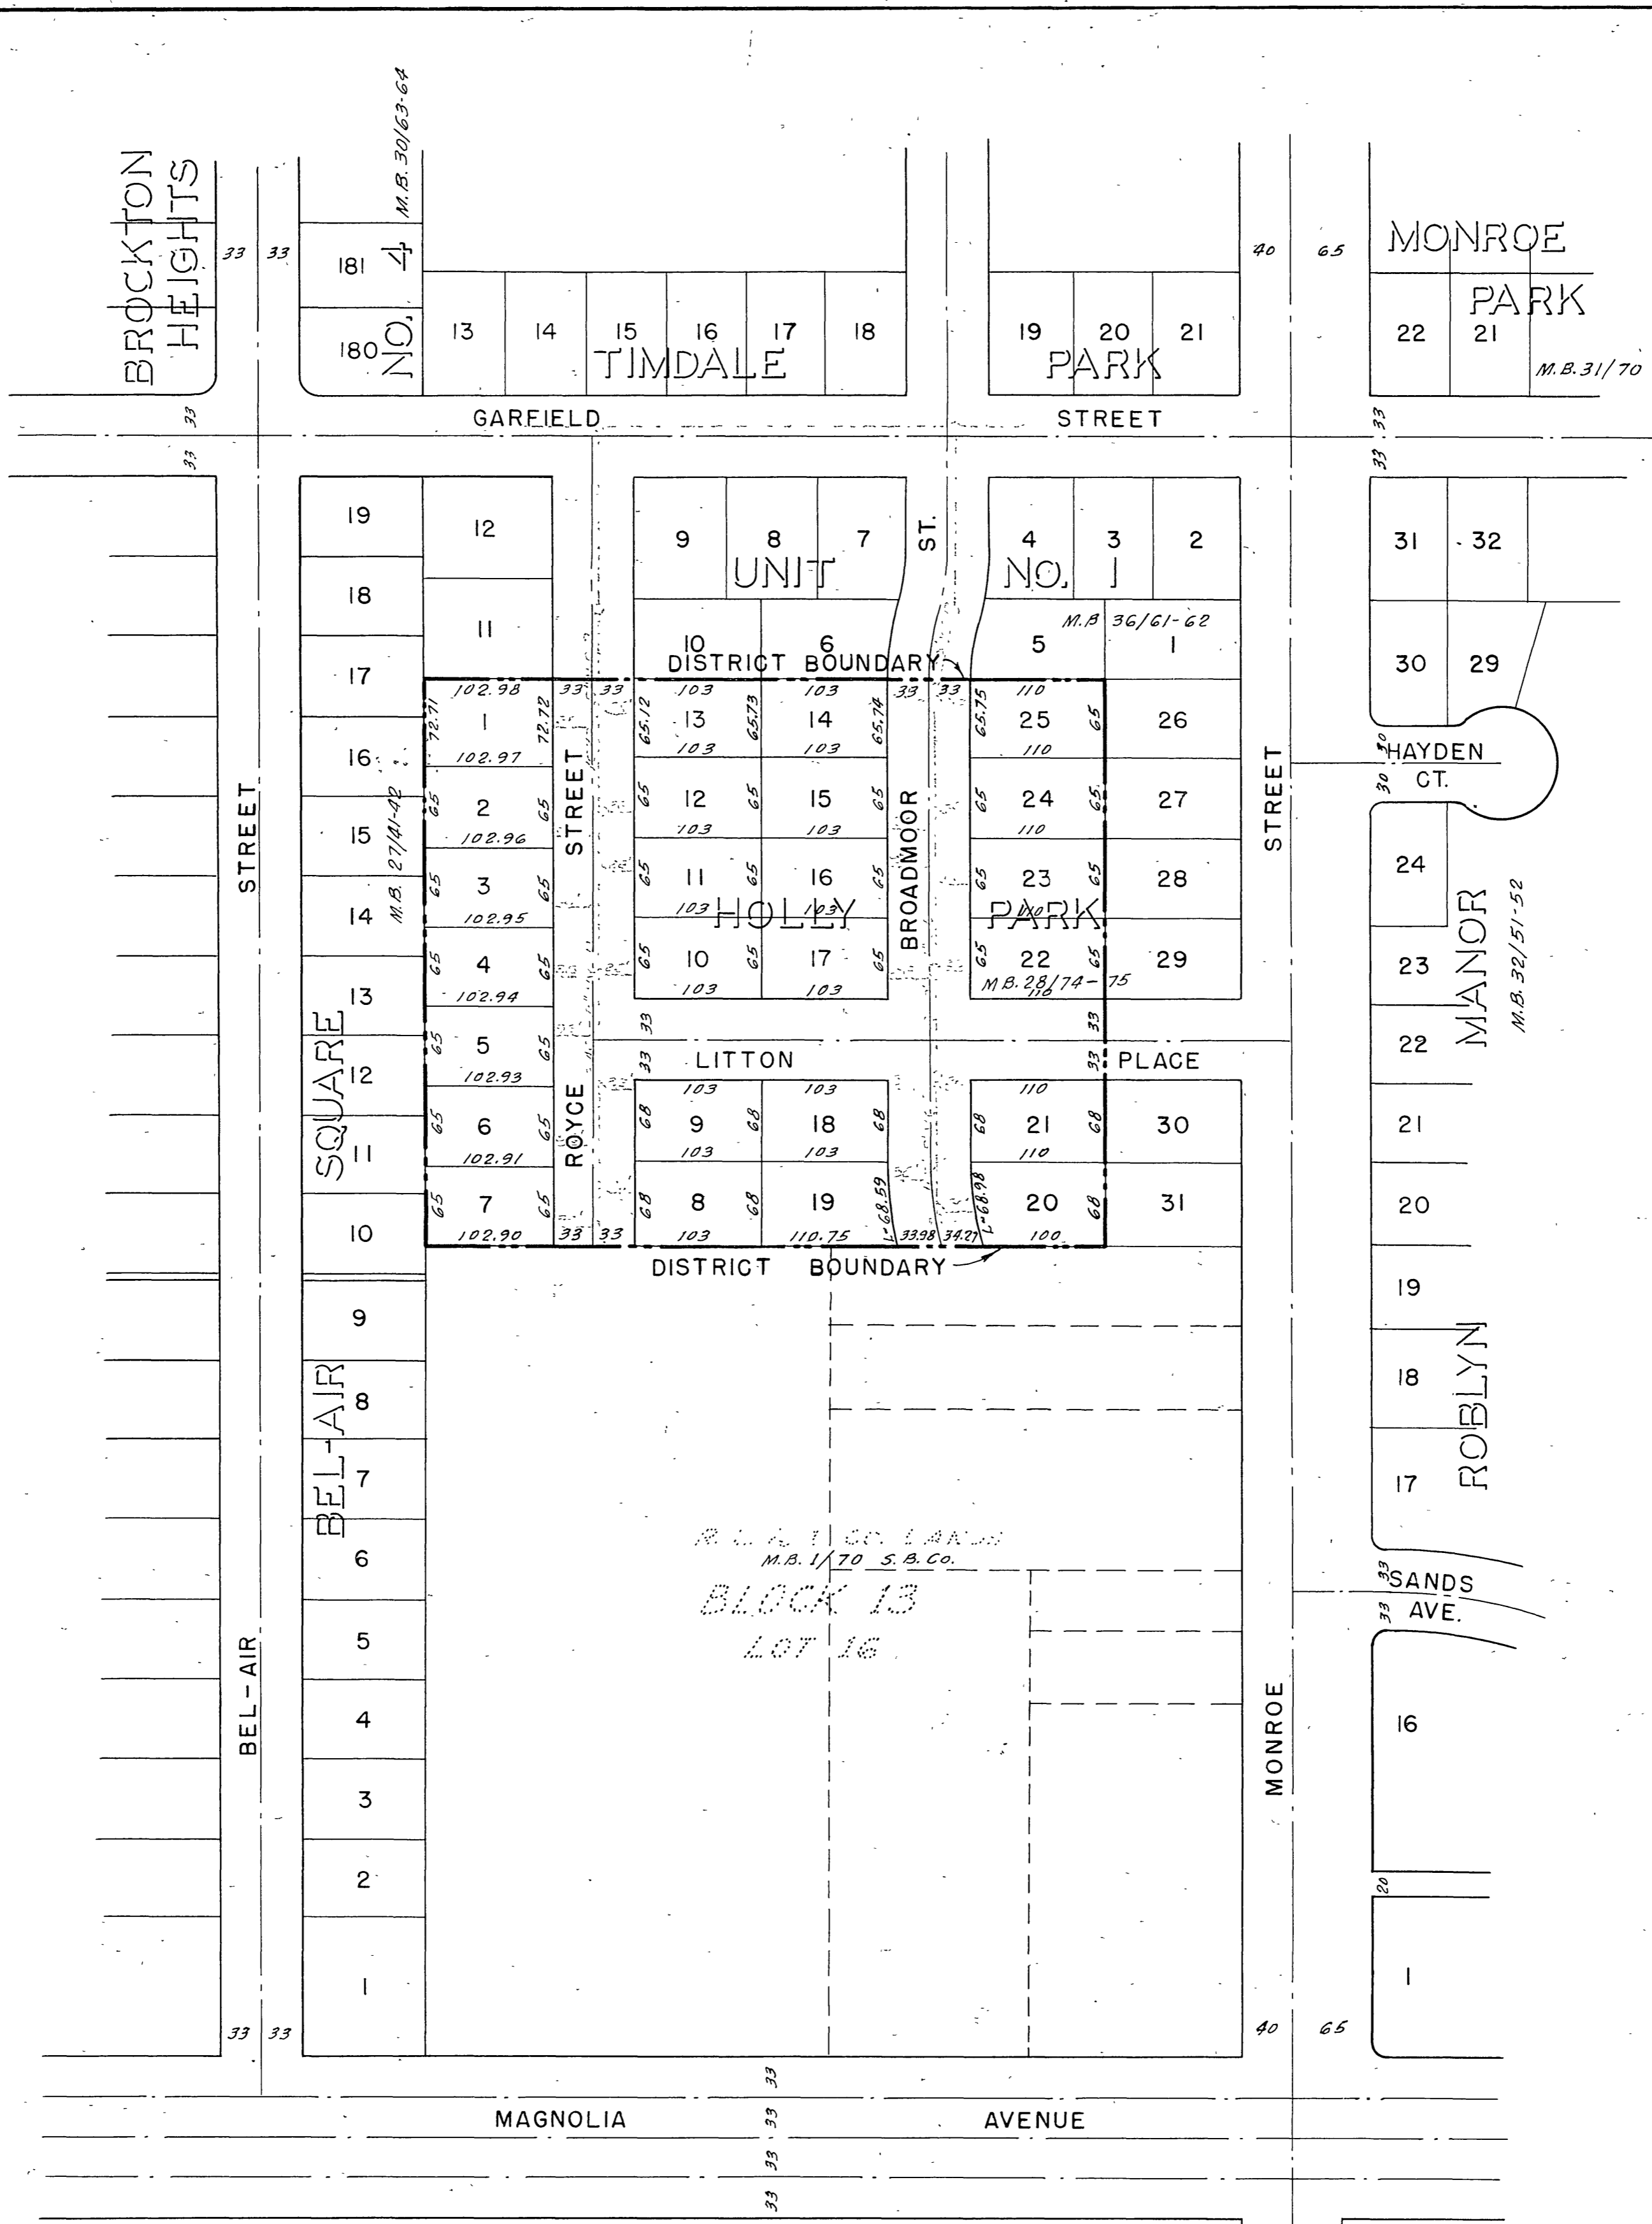

REVISIONS			CITY OF RIVERSIDE CALIFORNIA DEPARTMENT OF PUBLIC WORKS		
MARK	DATE	DESCRIPTION			
			HOLLY PARK SANITARY SEWER DISTRICT		
DESIGNED BY	H. L. M.	CHECKED BY			APPROVED BY
DRAWN BY	H. L. M.	<i>Ernest N. Wells</i> RE 9876			DIRECTOR OF PUBLIC WORKS
RECOMMENDED BY	ASSISTANT CITY ENGINEER		DATE	S-192 SHEET 2 OF 2	