


B.M. ELEV. 963.20 P.K. IN W'LY END OF
NW. CURB RETURN PRINCE ALBERT
DRIVE & OTTAWA AVE.

F.B. R/1-7

SCALES: 1" = 50' HORIZ.
1" = 5' VERT.

Notes:
1. Bearings on this Sheet are based on Victoria Estates Sub.
2. Exact location of wyes to be determined in field.
3. All construction to be in accordance with City of Riverside
Standard Specification NR 460

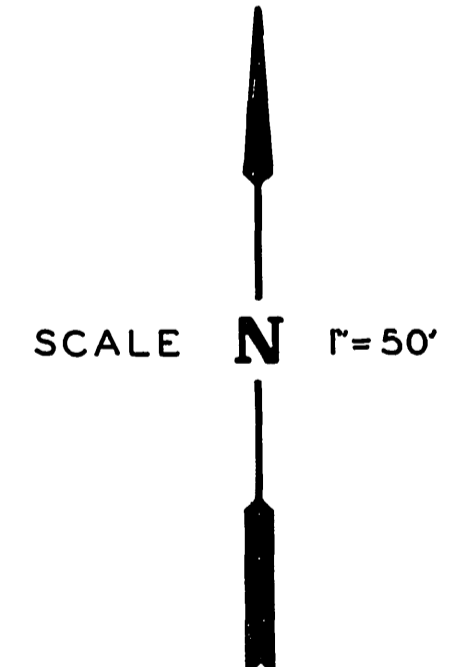

**PROPOSED SEWER
REALIGNMENT**
TRACT 21961
J.N. BEELER AND ASSOCIATES
INDEXED P.R.

CITY OF RIVERSIDE
DEPARTMENT OF PUBLIC WORKS
PRINCE ALBERT SEWER
OTTAWA AVE. TO CHICAGO AVENUE
AND SOUTH STREET


- 7-12-60 Added Barricades, 4, Bell
- 7-25-60 Spoken Boyer Property, 2
- 9-2-60 Changed to comply with spec, 2
- 11-17-60 SEWER REALIGNMENT & ADDITION, 1
- 1-14-60 "M.H.'S 1, 2, F 3, 10, 11, 12, 999, 1000

CITY OF RIVERSIDE
WATER DEPARTMENT
BY: *Carl Wengert* 3/4/58
DATE

NOTE: It shall be the responsibility of the Contractor to clear the right of way in accordance with the provisions of the law as it affects each utility including irrigation lines and appurtenances and at no extra cost to the City.

B.L. KLP
P.M.
A.M. School

S-195
1 2
July 5, 1960

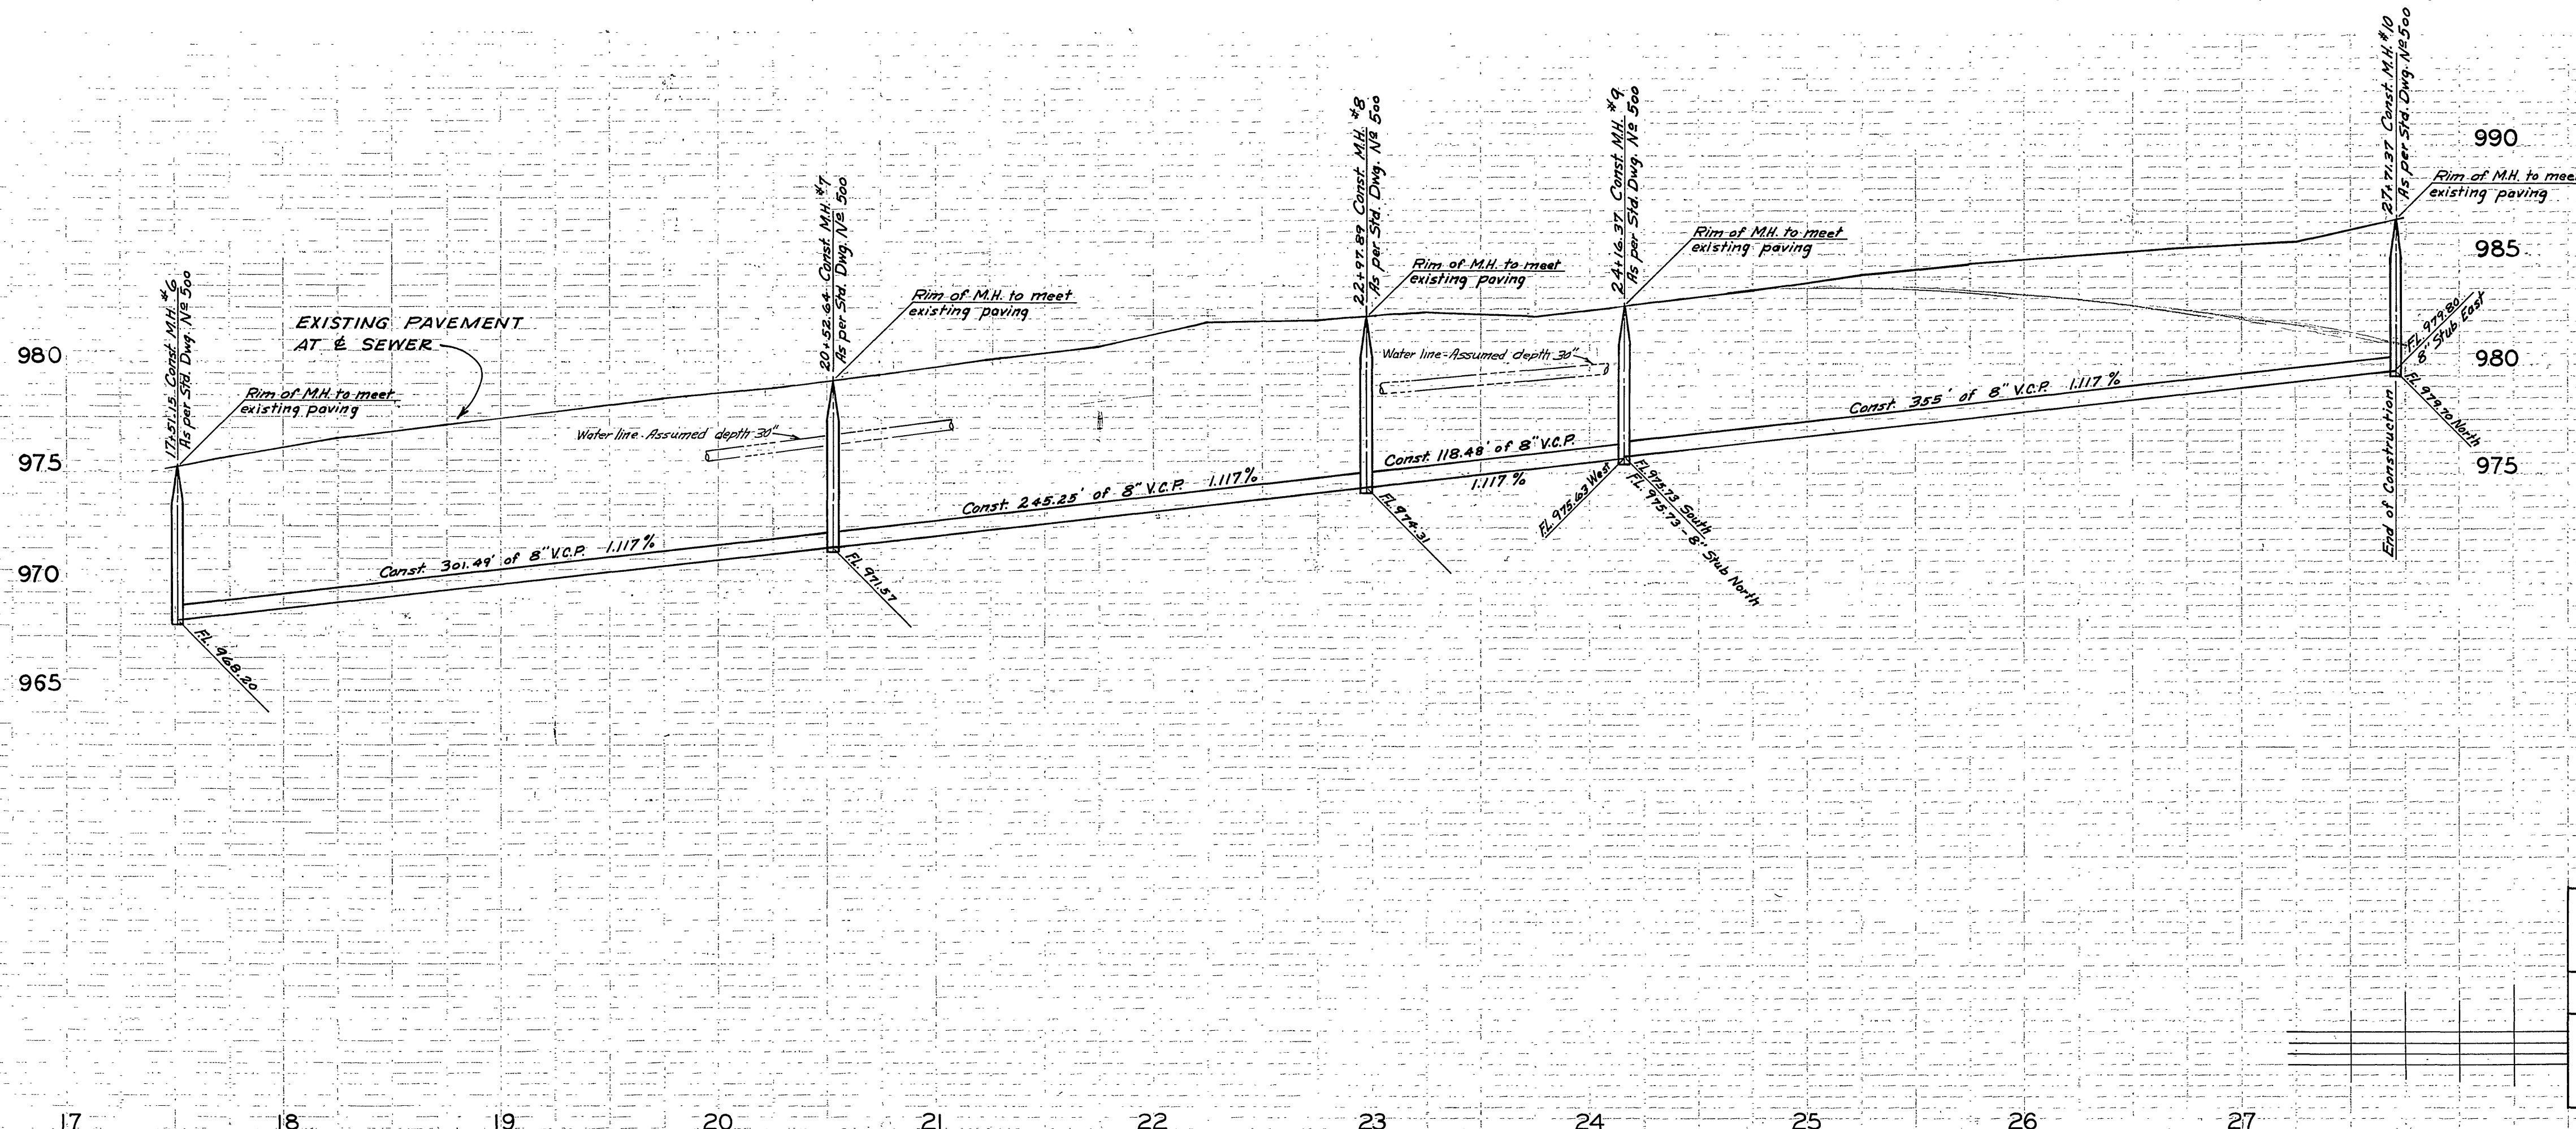


B.M. ELEV. 963.20 P.K. IN W'LY END OF
C.R. NW CORNER OF PRINCE ALBERT
DRIVE & OTTAWA AVE.

F.B. R/1-7

SCALES : 1" = 50' HORIZ.
1" = 5' VERT.

Notes:
1. Bearings on this Sheet are based on Sunset Heights Sub.
2. Exact location of wyes to be determined in field.
3. All construction to be in accordance with City of Riverside
Standard Specifications No. 460.

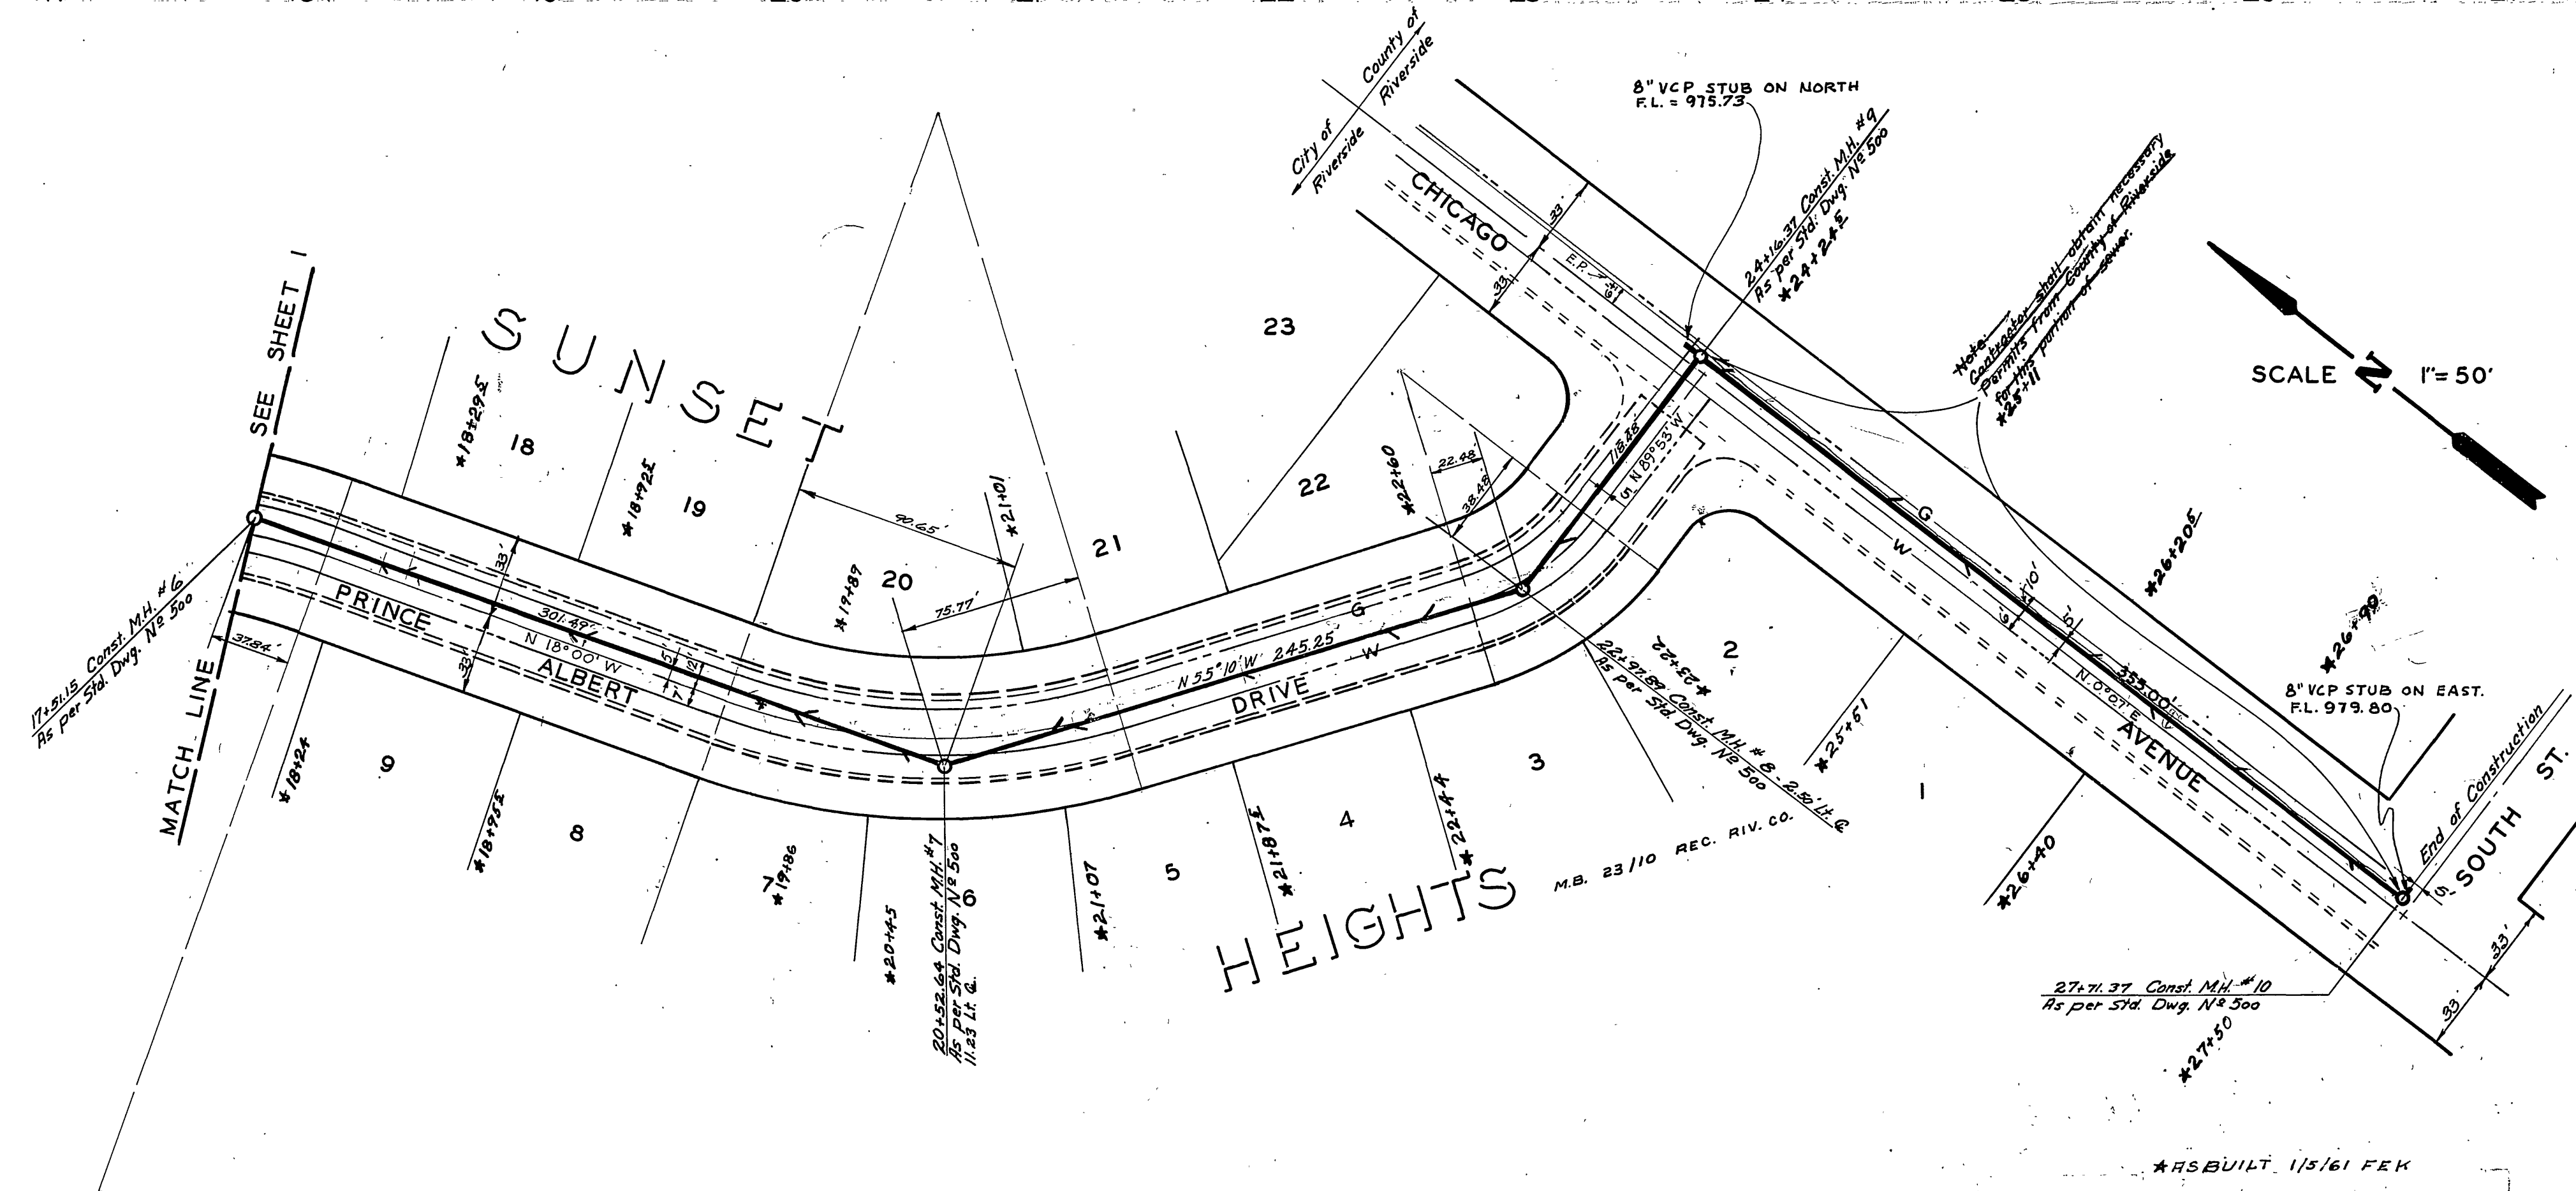

CITY OF RIVERSIDE CALIFORNIA
DEPARTMENT OF PUBLIC WORKS

PRINCE ALBERT SEWER

OTTAWA AVE. TO CHICAGO AVENUE
& SOUTH ST.

NOTE: It shall be the responsibility of the Contractor to clear the right-of-way in accordance with the provisions of the law as it affects each utility including irrigation lines and appurtenances and of no cost to the City.

BL. KLP
R.M.
C.A. Jhal
J. Martinez
July 5, 1940

S-195
2 2