

CONSTRUCT WYES ONLY FOR LOTS 2-7, & LOTS 54-46

CONSTRUCT STUB FOR FUTURE CONNECTION.

FUTURE CONSTRUCTION ON CAMPUS VIEW, STATION 5+05.15 TO 14+03.30

BENCH MARK
 Spike in Transformer Pole #6971 75' North of intersection
 Watkins & Valencia. Elev. 1146.48 F.B. 301/28

REVISION	
MARK	DESCRIPTION
*	9/10/62 As built. RK

ALBERT A. WEBB ASSOCIATES
 CIVIL ENGINEERS RIVERSIDE, CALIFORNIA
 APPROVED *[Signature]* DATE 5/13/60

CITY OF RIVERSIDE, CALIFORNIA
 DEPARTMENT OF PUBLIC WORKS



SEWER PLAN & PROFILE
 CAMPUS VIEW DRIVE
 TOWN & COUNTRY ESTATES #5
 UNIT NO. 1

DATE April 27, 60 SCALE Horiz. 1"=50'
 DRAWN S.D. V.O. 59-231 Vert. 1"=10'
 CHECKED F.B. 301

APPROVED BY *[Signature]* NO. S-231
 DIRECTOR OF PUBLIC WORKS DATE 8-17-62 SHEET 3 OF 3

PROFILE	SURVEYED	BY	DATE
NOTE BOOK	PLOTTED		
NO.	ALIGNMENT CHECKED		
	STRUCTURE NOTING CHECKED		

PLAN	SURVEYED	BY	DATE
NOTE BOOK	ALIGNMENT CHECKED		
NO.	RT. OF WAY CHECKED		

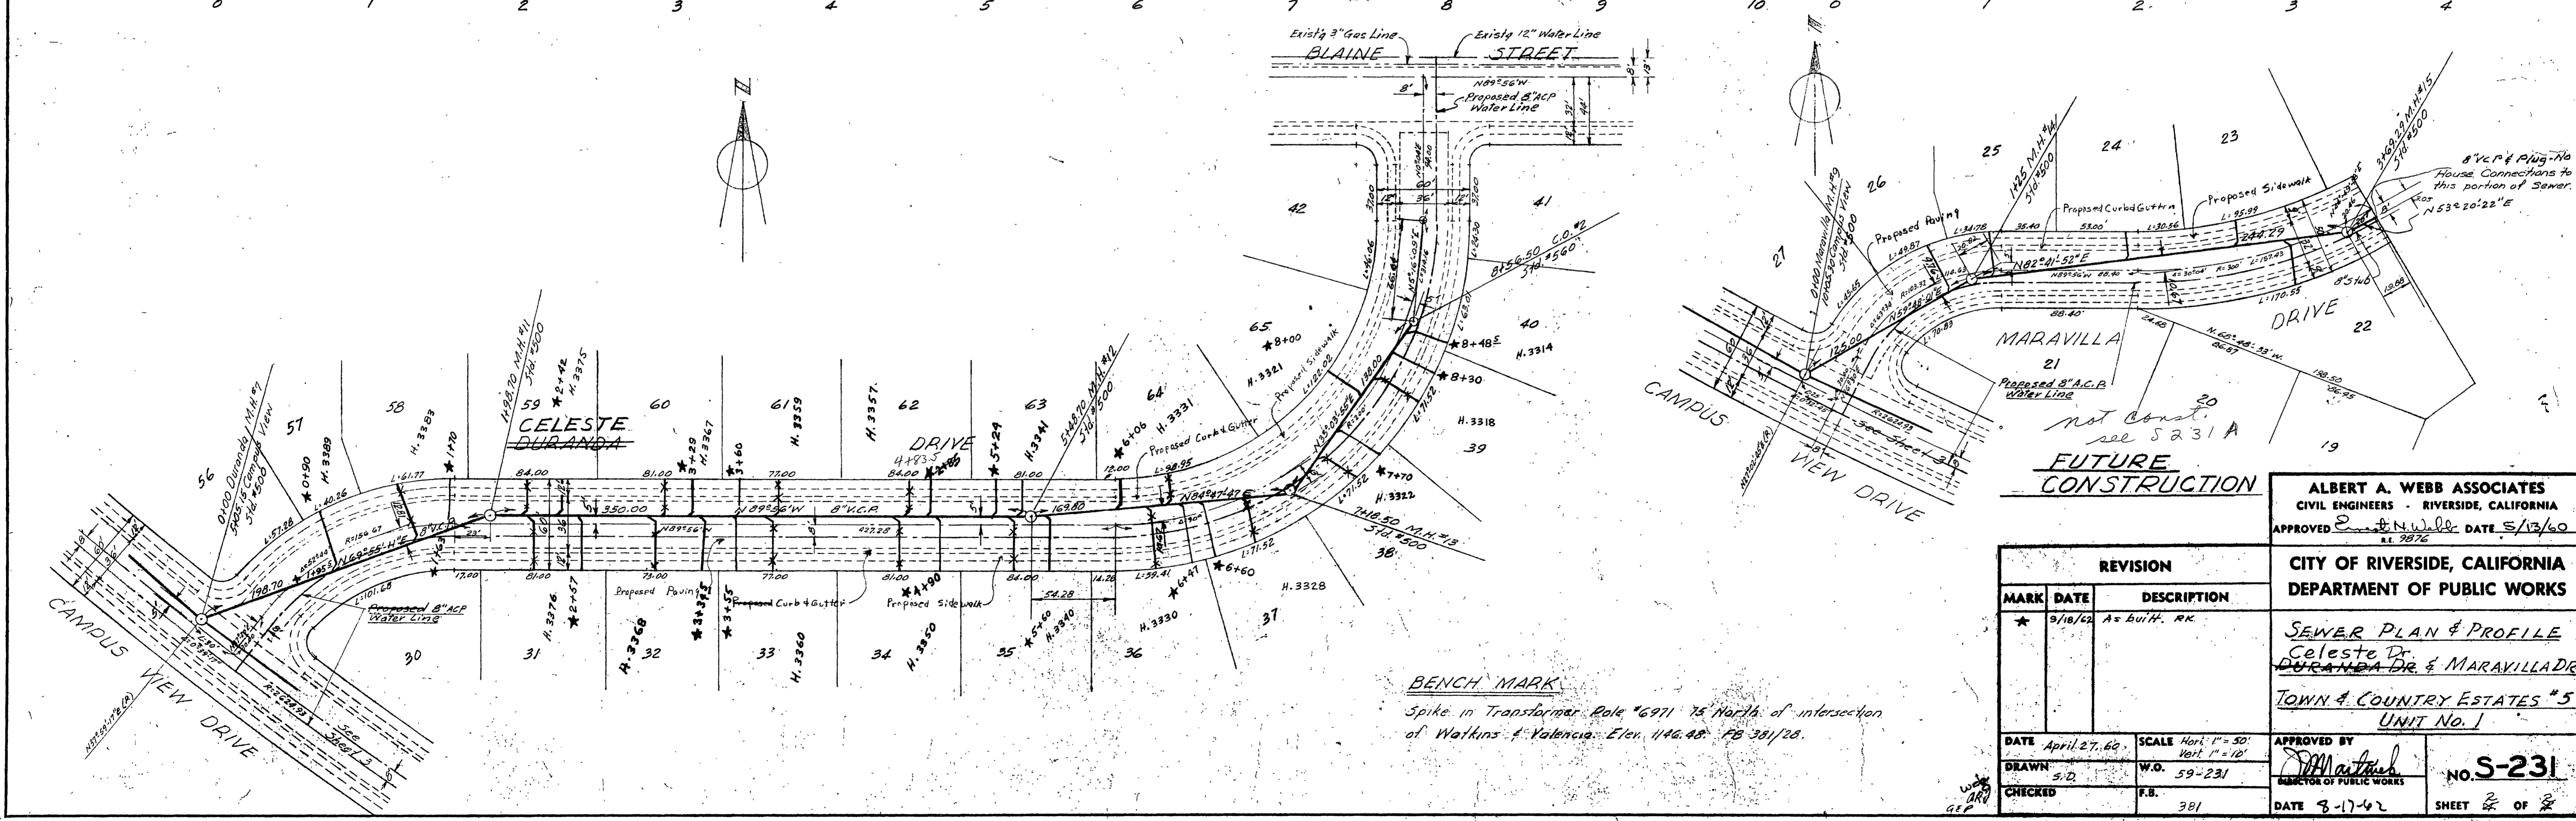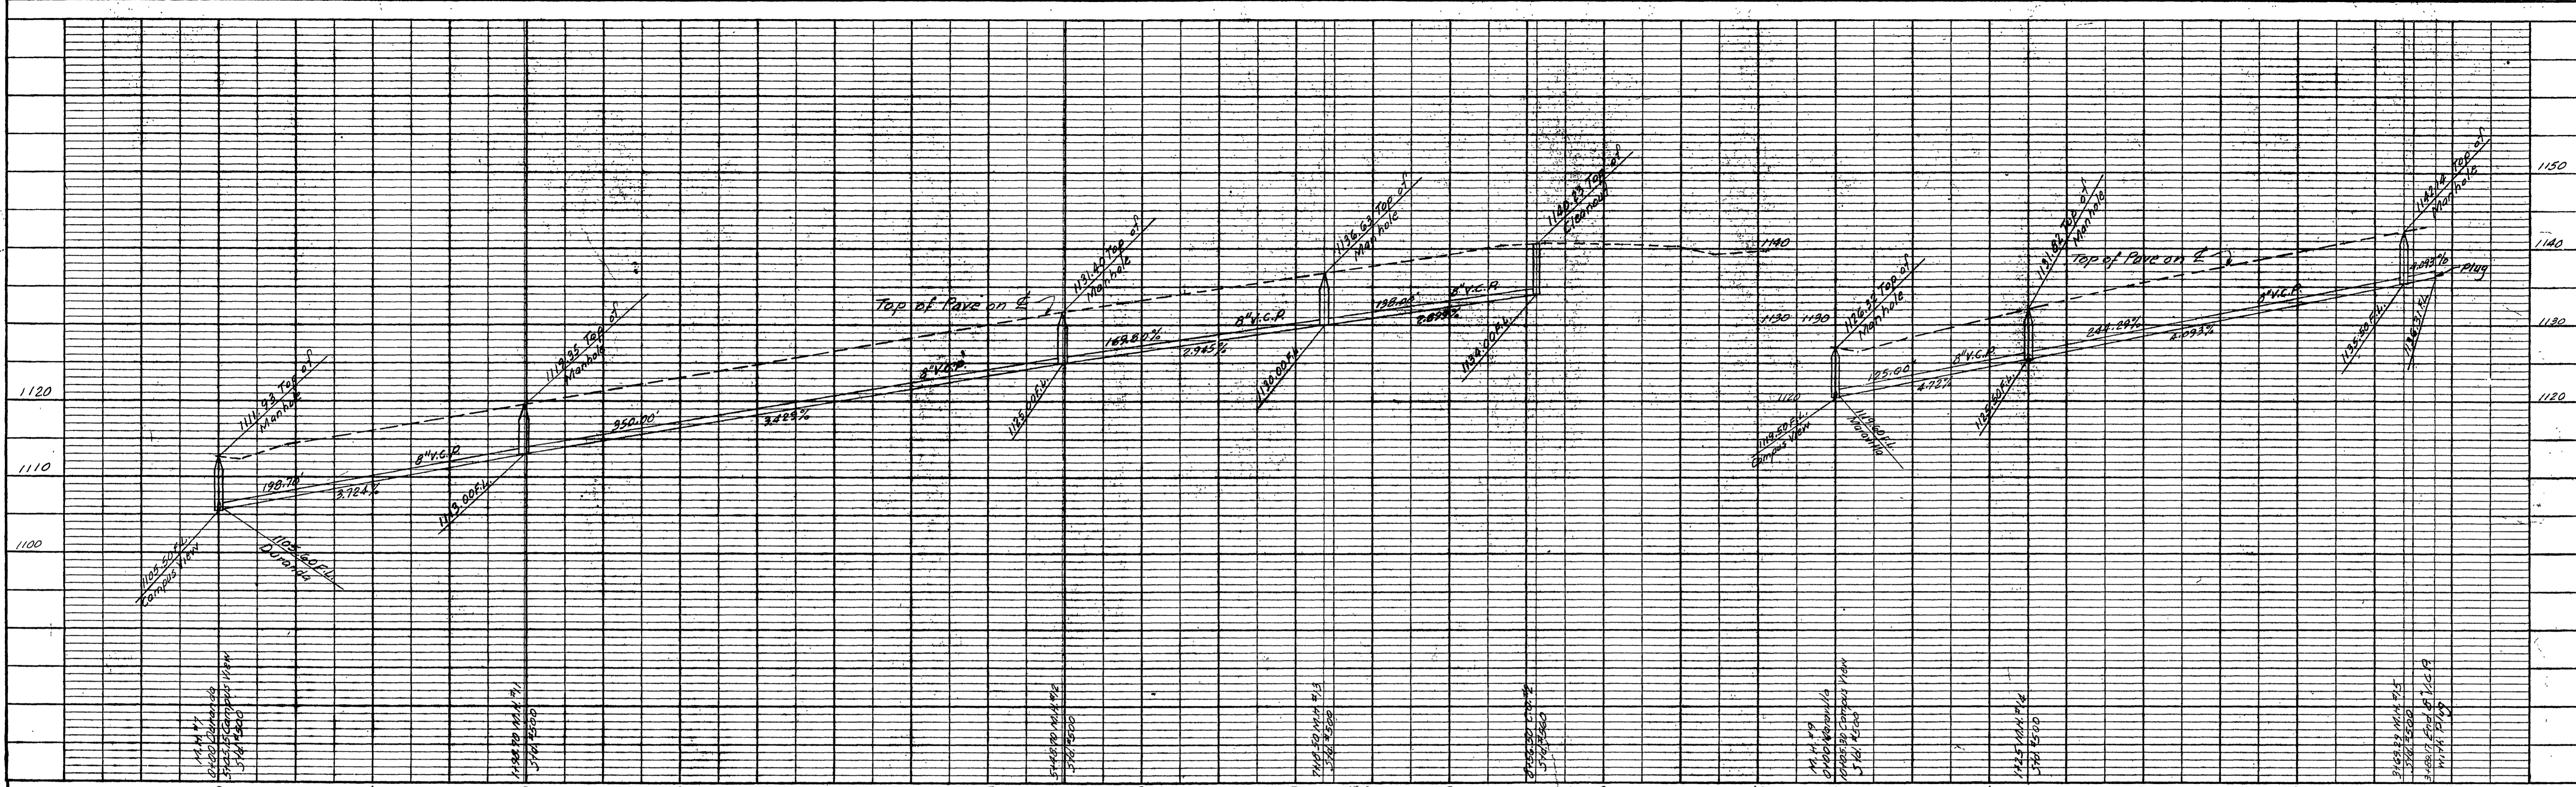

PROFILE	SUBMITTED	BY	DATE
NOTE BOOK	FLORIAN CHECKED		
NO.	B. M. NOTED		
	STRUCTURE NOTATIONS CHKD.		

PLAN	SUBMITTED	BY	DATE
NOTE BOOK	FLORIAN CHECKED		
NO.	B. M. NOTED		
	STRUCTURE NOTATIONS CHKD.		

REVISION MARK DATE DESCRIPTION * 9/10/62 As built. RK		ALBERT A. WEBB ASSOCIATES CIVIL ENGINEERS - RIVERSIDE, CALIFORNIA APPROVED <i>E. N. Webb</i> DATE 5/13/60 RE 2876
DATE April 27, 60 SCALE Horiz. 1" = 50' DRAWN S.D. W.O. 59-231 Vert. 1" = 10' CHECKED F.B. 381		
CITY OF RIVERSIDE, CALIFORNIA DEPARTMENT OF PUBLIC WORKS		APPROVED BY <i>E. N. Webb</i> DIRECTOR OF PUBLIC WORKS DATE 3-17-62
SEWER PLAN & PROFILE Celeste Dr. DURANDA DR & MARAVILLA DR TOWN & COUNTRY ESTATES # 5 UNIT No. 1		
NO. S-231		SHEET 2 OF 2