


PROFILE	
SUBMITTED	BY
NOTED	DATE
GRADES CHECKED	3-28-64
NO. 15146	3-28-64
STRUCTURE NO. 15146	

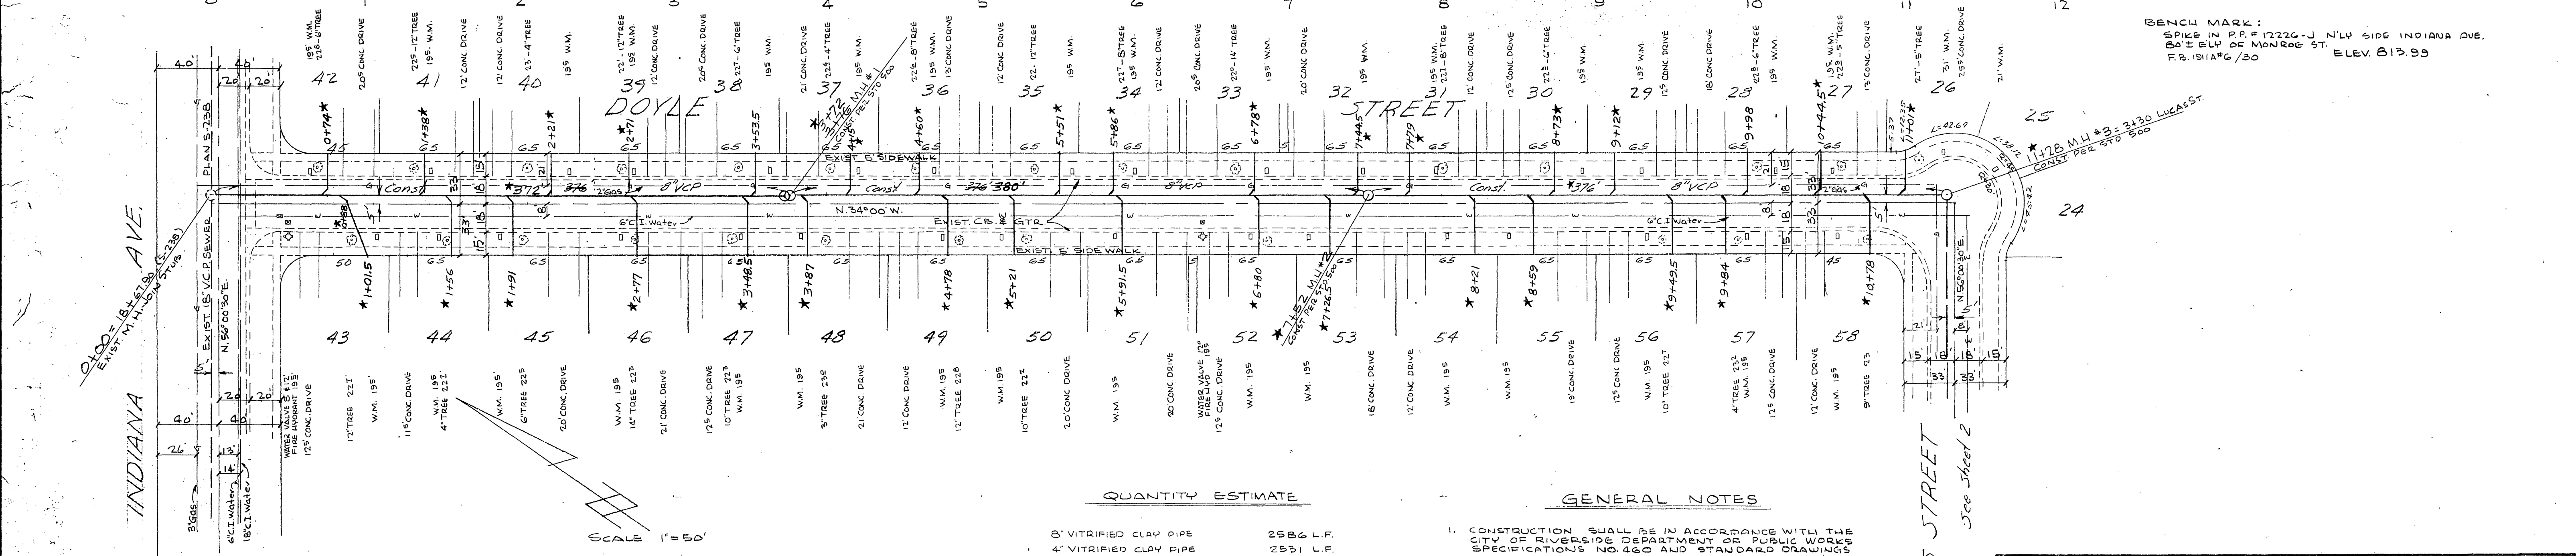

PLAN	
SUBMITTED	BY
NOTED	DATE
ALIGNMENT CHECKED	3-28-64
BY OF W.M. CHECKED	

QUANTITY ESTIMATE


5" VITRIFIED CLAY PIPE	2586 L.F.
4" VITRIFIED CLAY PIPE	2531 L.F.
8" x 4" WINGS	74 EA.
MANHOLES, STD. 500	4 EA.
PAVING REPLACEMENT	10,700 S.F.

- GENERAL NOTES
- CONSTRUCTION SHALL BE IN ACCORDANCE WITH THE CITY OF RIVERSIDE DEPARTMENT OF PUBLIC WORKS SPECIFICATIONS NO. 466 AND STANDARD DRAWINGS.
  - ALL HOUSE CONNECTIONS SHALL BE LOCATED IN THE FIELD.
  - ALL LATERALS TO BE CONSTRUCTED IN ACCORDANCE WITH STD. DRAWING NO. 542.
  - MANHOLE FRAMES AND COVERS TO BE SET TO EXISTING PAVEMENT GRADE.


REVISIONS			CITY OF RIVERSIDE CALIFORNIA DEPARTMENT OF PUBLIC WORKS
MARK	DATE	DESCRIPTION	
			<b>VANCE-DOYLE SANITARY SEWER DISTRICT</b>
			<b>DOYLE STREET</b>
DESIGNED BY	CHKD BY	APPROVED BY	S-283
DRAWN BY <i>drv</i>	<i>R.E. Miller</i>	<i>[Signature]</i>	
RECOMMENDED BY <i>[Signature]</i>	DATE <i>June 2, 1964</i>	DIRECTOR OF PUBLIC WORKS	
ASSISTANT CITY ENGINEER			SHEET 1 OF 2

\* = "As Built", 1/12/62 H. Ball



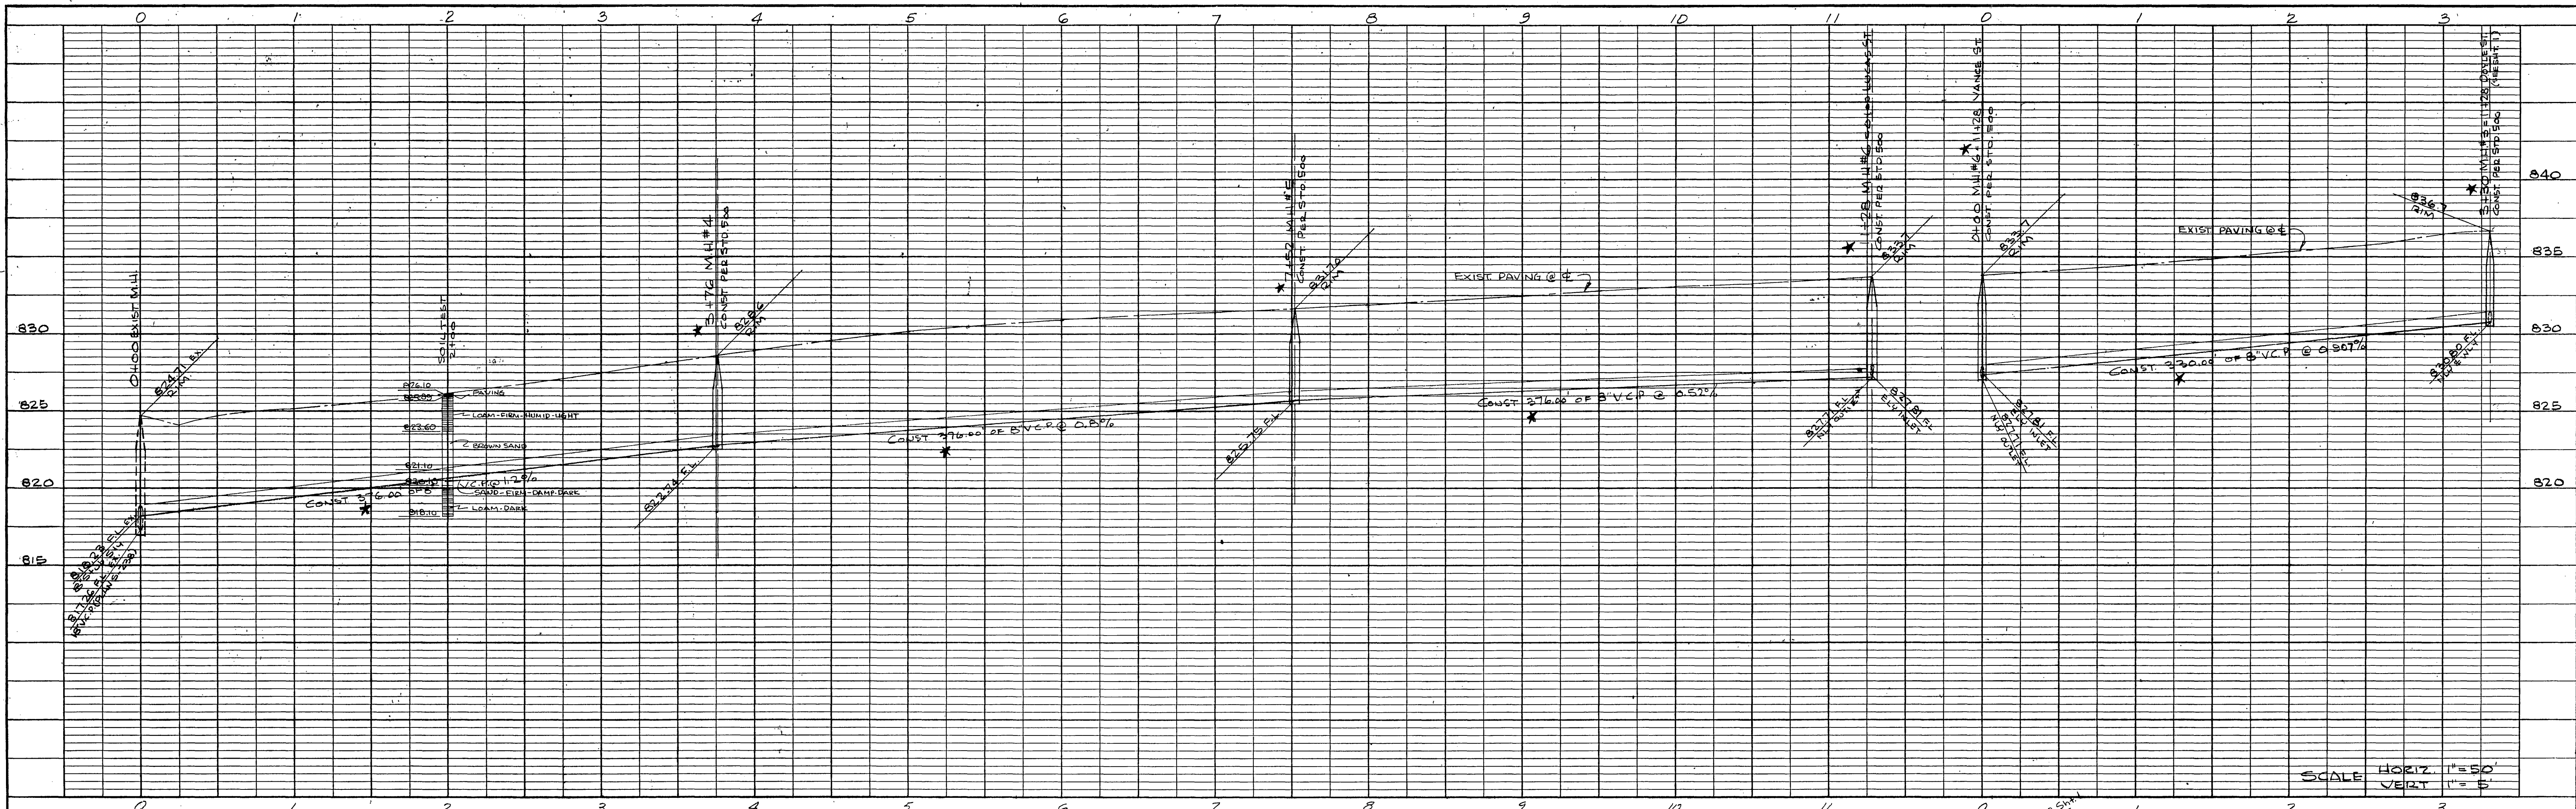

<b>PROFILE</b>		BY	DATE
STARTED	PLOTTED		3-29-54
NOTE BOOK GRADES CHECKED	BY	dlc	
NO. 27166	RT. OF WAY CHECKED	dlc	3-29-54
27166	ALIGNMENT CHECKED		
27166	RT. OF WAY CHECKED		

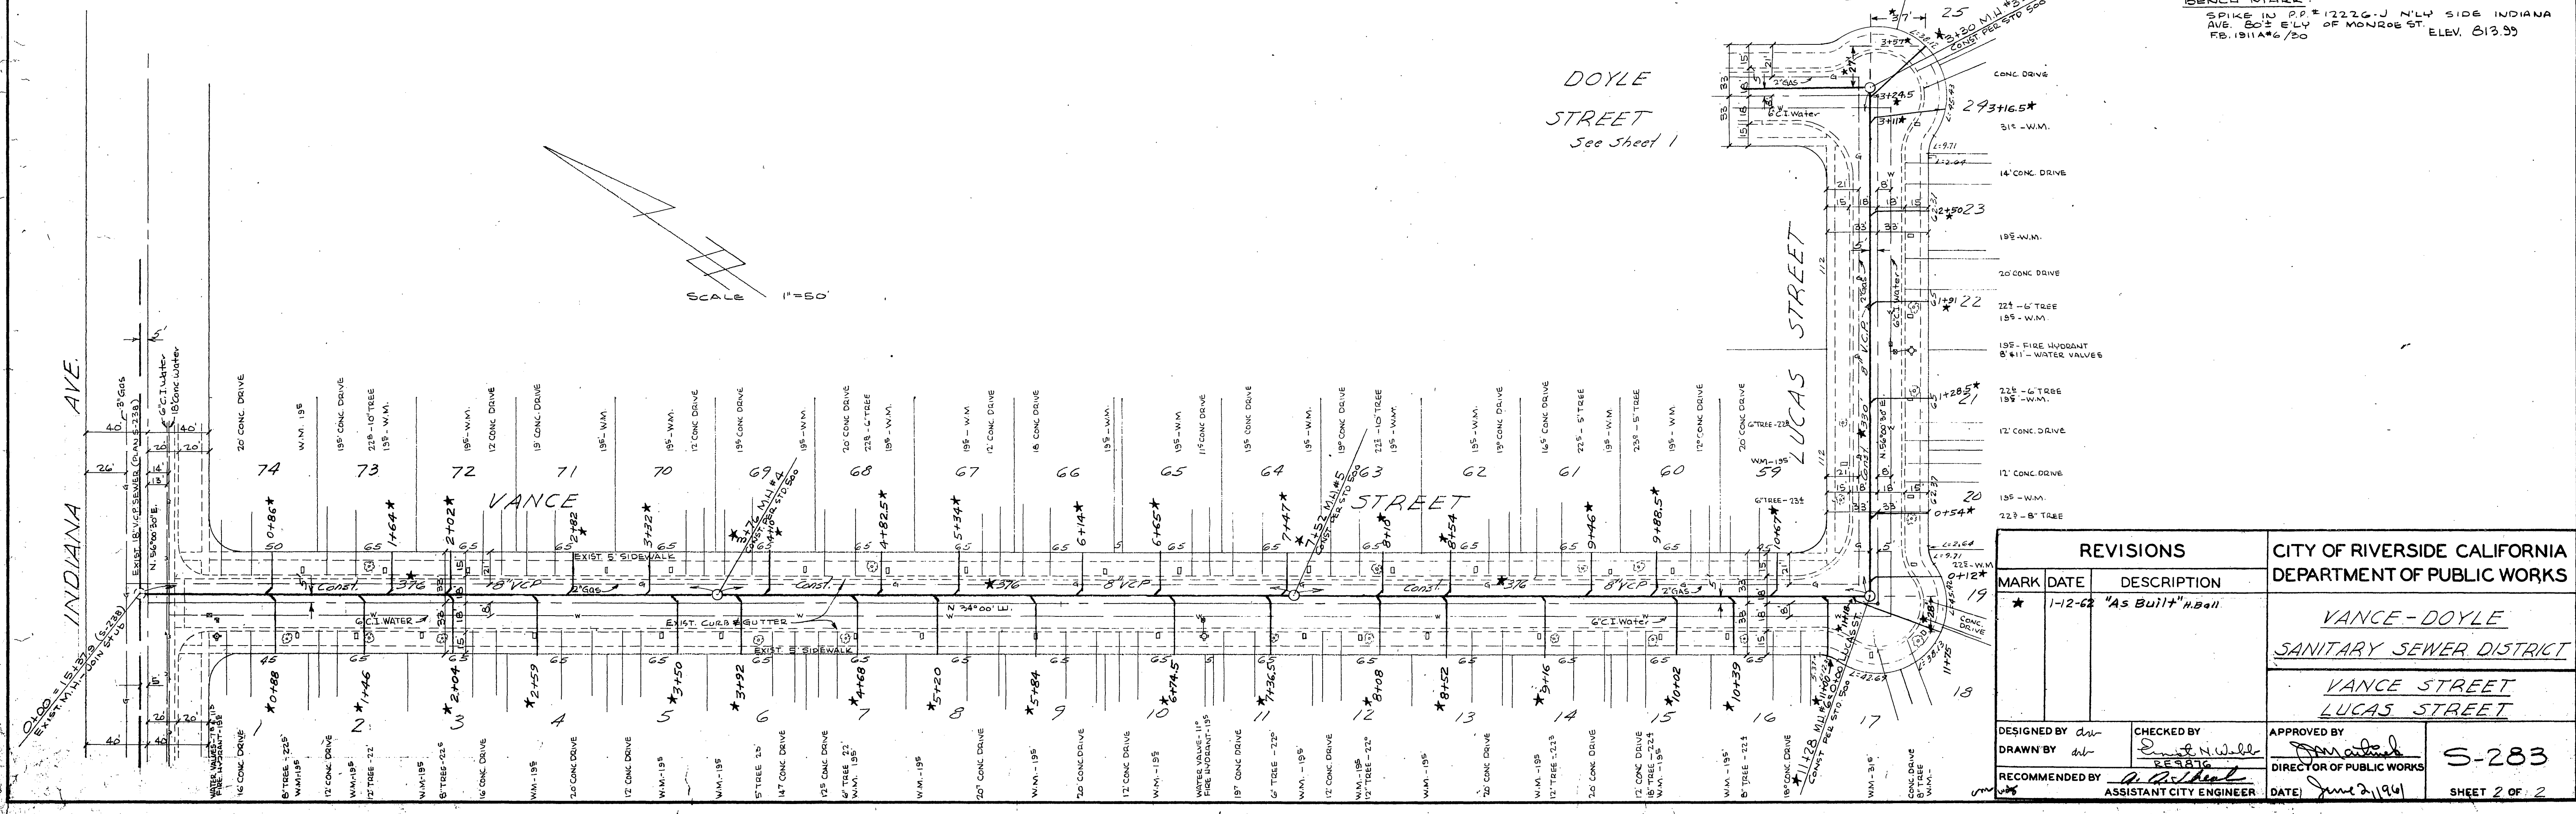

BENCH MARK:  
 SPIKE IN P.P. #12226 J NLY SIDE INDIANA  
 AVE. 80' ELY OF MONROE ST.  
 FB. 1811A @ 70 ELEV. 813.99

<b>PLAN</b>		BY	DATE
STARTED	PLOTTED		3-29-54
NOTE BOOK GRADES CHECKED	BY	dlc	
NO. 27166	RT. OF WAY CHECKED	dlc	3-29-54
27166	ALIGNMENT CHECKED		
27166	RT. OF WAY CHECKED		

<b>REVISIONS</b>		<b>CITY OF RIVERSIDE CALIFORNIA DEPARTMENT OF PUBLIC WORKS</b>	
MARK	DATE	DESCRIPTION	
*	1-12-62	"As Built" H.B. 11	
		VANCE - DOYLE SANITARY SEWER DISTRICT	
		VANCE STREET LUCAS STREET	
DESIGNED BY	CHECKED BY	APPROVED BY	<b>S-283</b>
DRAWN BY		DIRECTOR OF PUBLIC WORKS	
RECOMMENDED BY	ASSISTANT CITY ENGINEER	DATE: June 2, 1954	