

GENERAL NOTES:

- CONSTRUCTION SHALL BE IN ACCORDANCE WITH THE CITY OF RIVERSIDE DEPARTMENT OF PUBLIC WORKS, STANDARD DRAWINGS, STANDARD DRAWING NO. 10 AND THE STANDARD SPECIFICATIONS FOR PUBLIC WORKS CONSTRUCTION, CURRENT EDITION.
- THE PRIVATE ENGINEER SIGNING THESE PLANS IS RESPONSIBLE FOR ASSURING THE ACCURACY AND ACCEPTABILITY OF THE WORK HEREON. IN THE EVENT OF DISCREPANCIES ARISING DURING CONSTRUCTION, THE PRIVATE ENGINEER SHALL BE RESPONSIBLE FOR DETERMINING AN ACCEPTABLE SOLUTION AND REVISING THE PLANS FOR APPROVAL BY THE CITY.
- ALL FLAGGED ELEVATIONS SHALL BE STAKED IN THE FIELD BY THE PRIVATE ENGINEER.
- ANY TRAFFIC CONTROL STRIPING OBLITERATED AND/OR BARELY WORN DURING CONSTRUCTION SHALL BE RESTORED BY THE CONTRACTOR WITHIN FIVE DAYS AFTER NOTIFICATION FROM THE CITY INSPECTORS.
- THE CONTRACTOR SHALL CALL IN A LOCATION REQUEST TO UNDERGROUND SERVICE ALERT (U.S.A.) PHONE NO. 1-800-485-4809, TWO WORKING DAYS BEFORE BEGINNING CONSTRUCTION. NO CONSTRUCTION SHALL BE PERMITTED BY THE PUBLIC WORKS DEPARTMENT INVOLVING EXCAVATION FOR UNDERGROUND FACILITIES UNLESS THE APPLICANT HAS BEEN PROVIDED AN INQUIRY IDENTIFICATION NUMBER BY U.S.A.
- CONTRACTOR IS TO VERIFY EXISTING SEWER ELEVATION PRIOR TO CONSTRUCTION.
- A PLUG SHALL BE INSTALLED AND WILL REMAIN IN PLACE WHERE THE NEW SEWER CONNECTS WITH THE EXISTING SEWER, UNTIL THE NEW SEWER IS ACCEPTED BY THE CITY.
- THE SEWER CONTRACTOR SHALL ADJUST MANHOLES TO FINAL GRADE AFTER PAVING IS COMPLETED.

BENCH MARK IS A CITY BENCH MARK WHICH IS A LEAD & TACK ON THE S.E. CORNER OF A CONCRETE WALKER BOX AT THE S.W. CORNER OF RUBIDOUX & GRAND AVES. ELEV. = 802.64

Contractor shall uncover existing 15" sewer as directed by the Engineer, so that vertical & horizontal positions may be verified prior to any construction.

SCALE: 1" = 40'

REVISIONS		
MARK	DATE	DESCRIPTION
*	12-3-66	AS BUILT REC.
*	3-2-92	EXTENSION TO TR. 23391 PRIVATE SEWER.
△	4-6-92	CONNECTION TO TR. 23391 PRIVATE SEWER LATERAL.

J. F. DAVIDSON - CIVIL ENGINEER
 R.E. NO. 862
 RIVERSIDE, CALIFORNIA
 APPROVED BY: *[Signature]* DATE: 7/6/61

CITY OF RIVERSIDE, CALIFORNIA
DEPARTMENT OF PUBLIC WORKS

SEWER PLAN & PROFILE
TRACT 2203
SEWER EXTENSION

HORIZ. SCALE: 1" = 40' VERT. SCALE: 1" = 4'


DESIGNED BY: *[Signature]* CHECKED BY: *[Signature]*
 DRAWN BY: *[Signature]* APPROVED BY: *[Signature]*

NO. S-286

- Notes:**
- All wires are to be located in the field as directed by Engineer.
 - All Manholes to be City of Riverside Standard No. 500 unless otherwise noted on Plan. Maximum vertical spacing of steps all manholes shall be 18" Maximum. Spacing of steps per Standard Drawing No. 422.
 - Pipe shall be bedded Per Case II, Standard Drawing No. 422.
 - This plan adopted from Plan No. S-285.
 - Distance & location of underground pipes & structures are shown from available records, but City does not assume any responsibility for accuracy or error. Contractor shall verify locations of all underground pipes & structures.

UNDERGROUND SERVICE ALERT
 CALL (800) 478-4166
 2 WORKING DAYS

G.V.N. ENGINEERING, INC.
 601 S. PINE CANYON RD., SUITE 27
 WALNUT, CA 91781
 (714) 214-0550

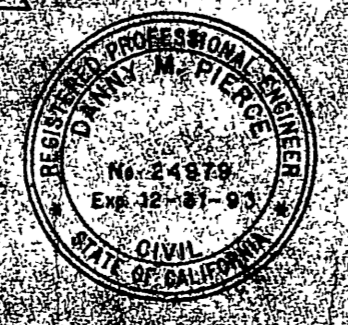

CITY OF RIVERSIDE WATER DEPT.
[Signature]
 7-16-92

