
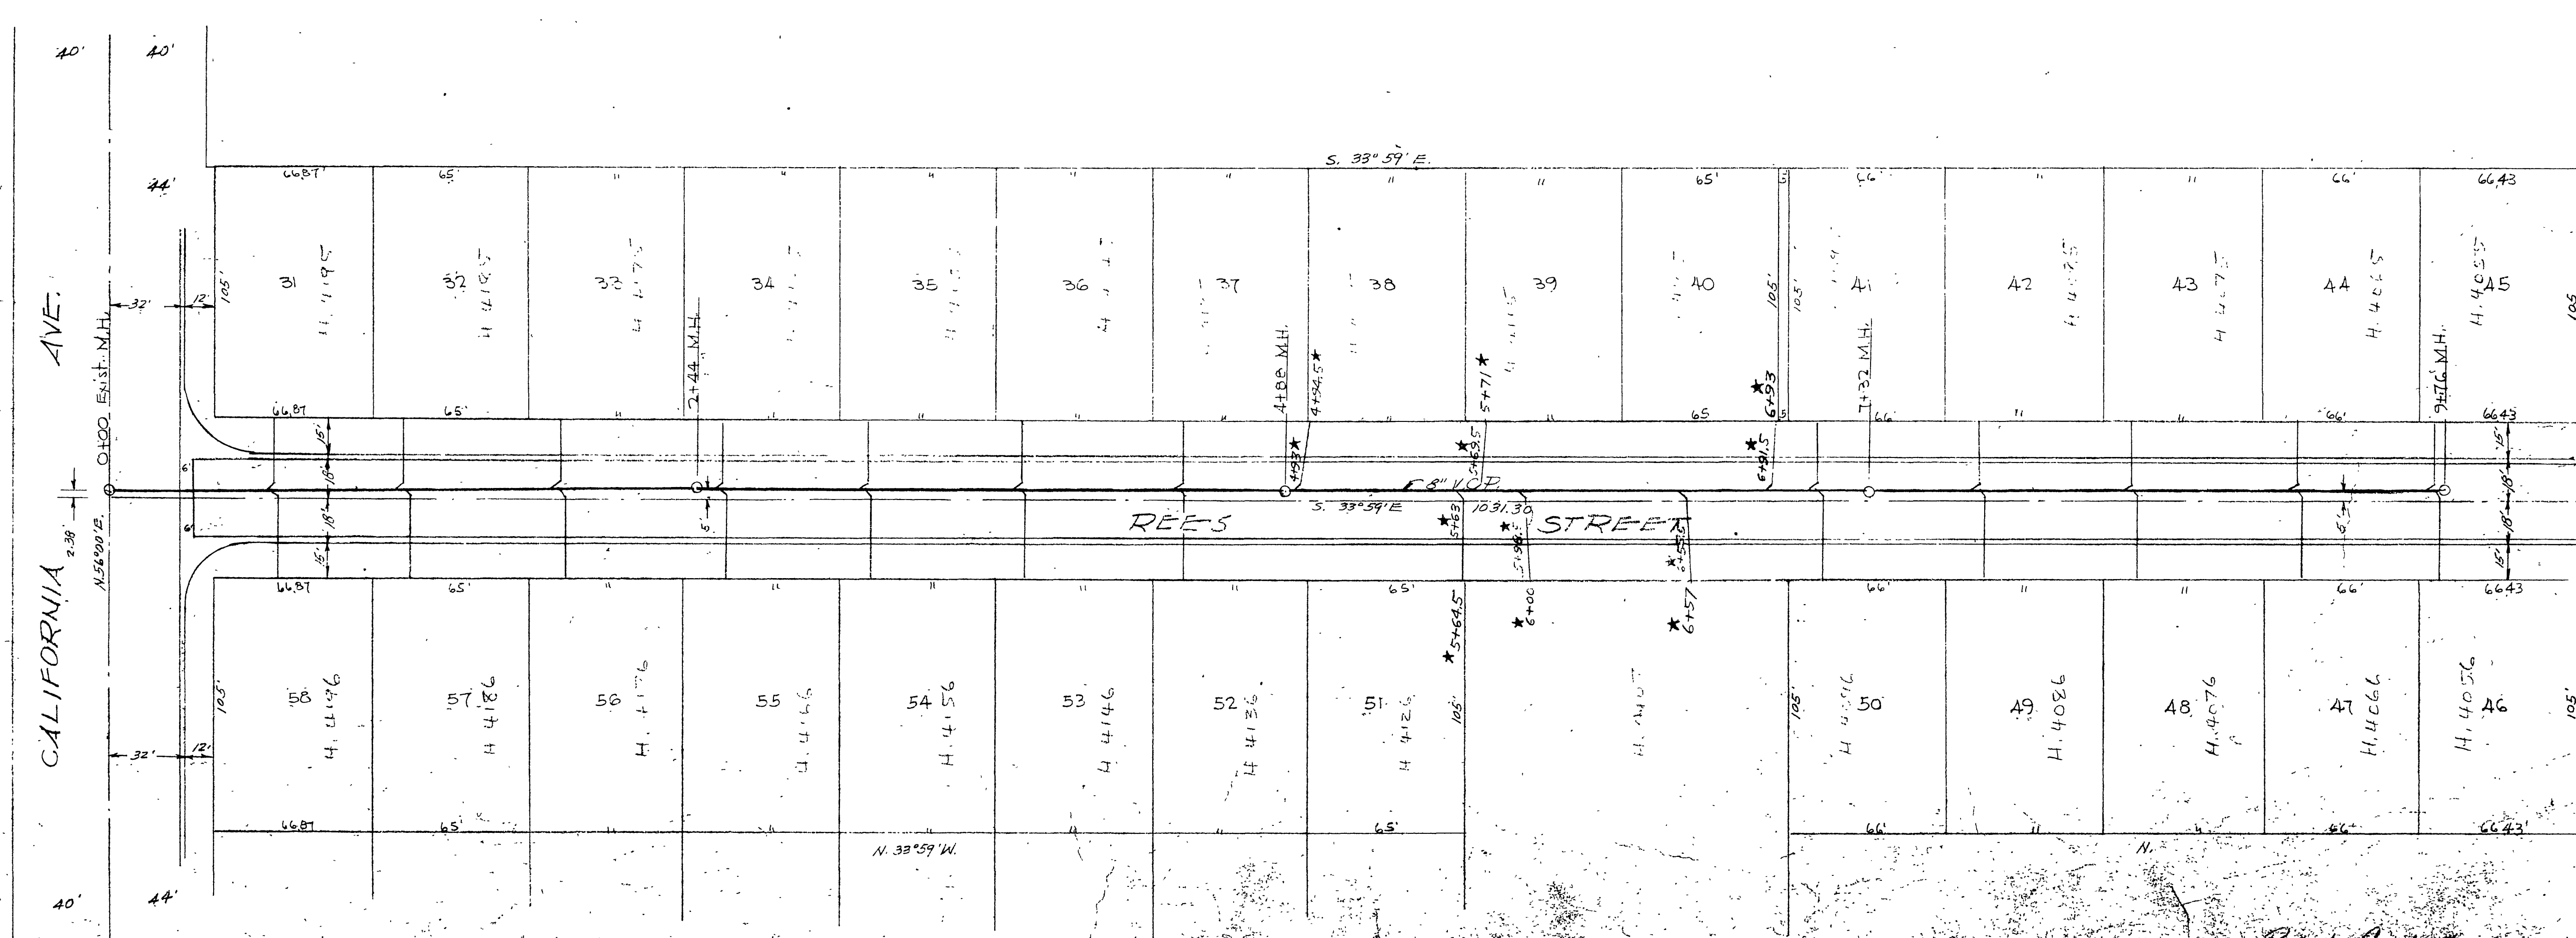


MADE IN U.S.A.
СРЕДСТВЕННИ БУБЕР СО.
СРЕДСТВЕННИ БУБЕР СО.

MADE IN U.S.A.
СРЕДСТВЕННИ БУБЕР СО.
СРЕДСТВЕННИ БУБЕР СО.

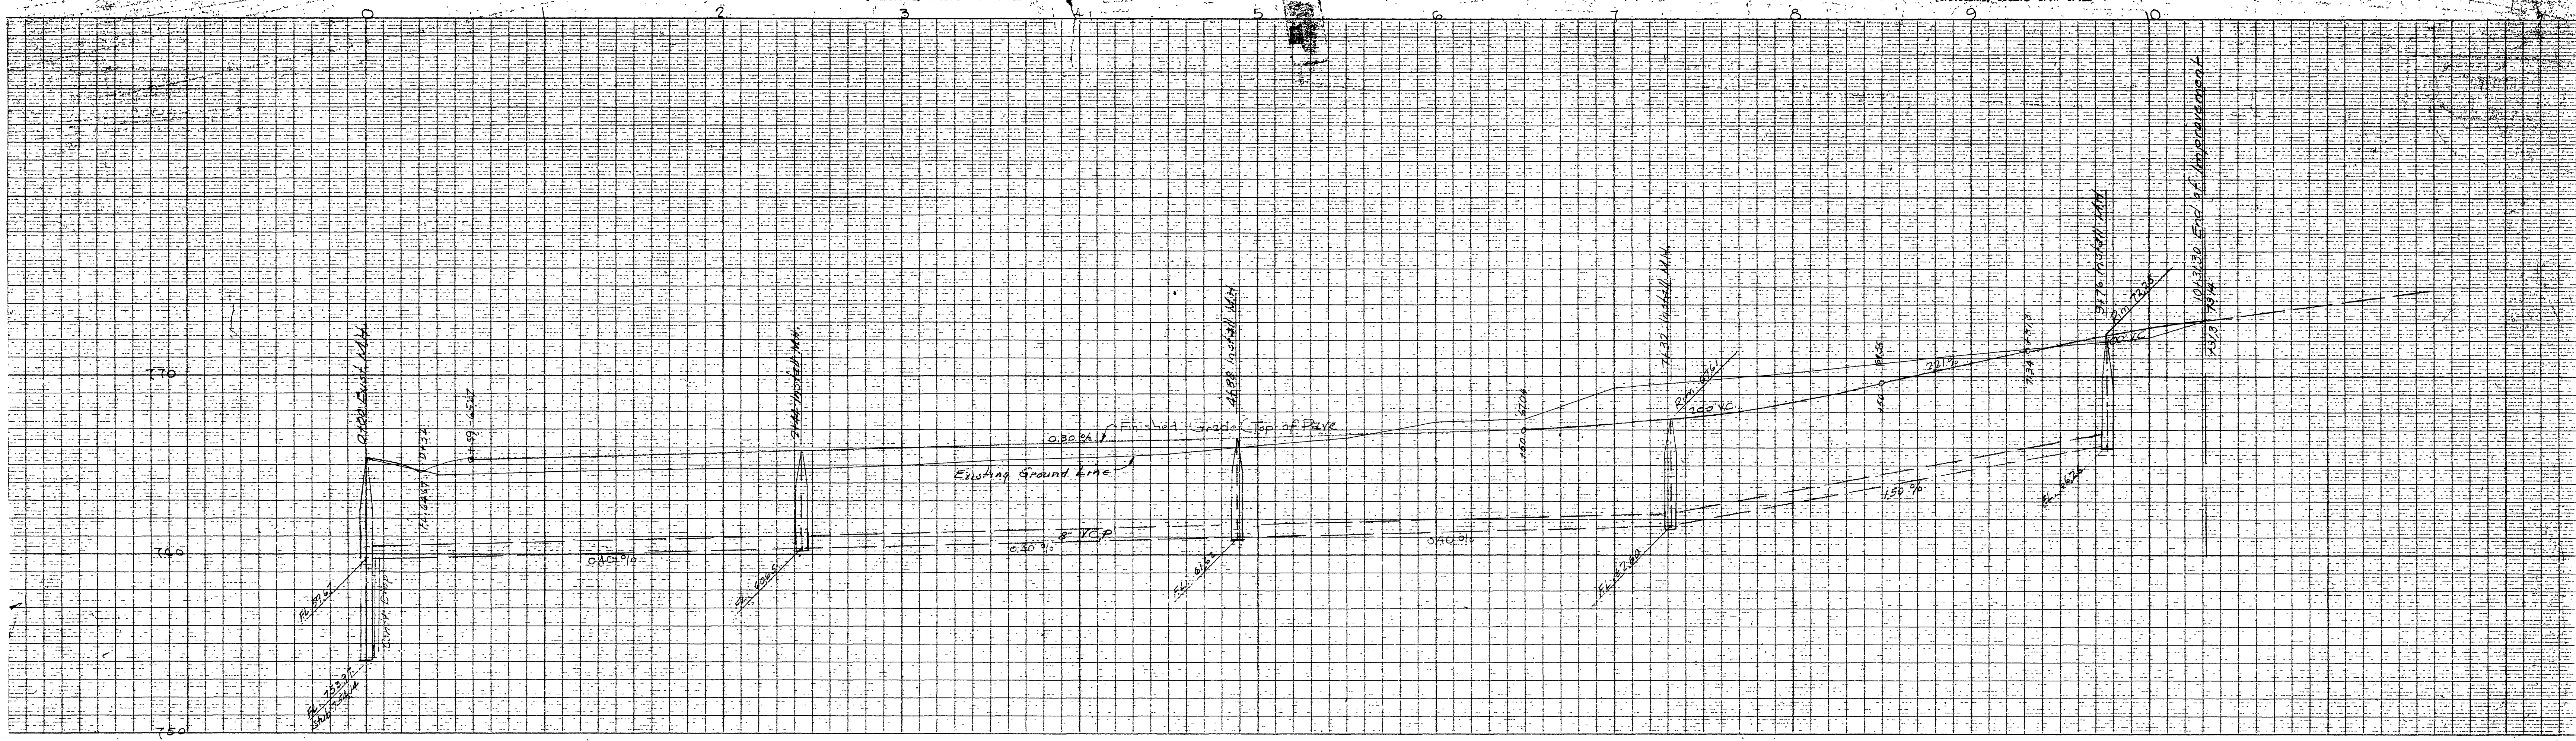

Rees Street # 16

Located by Sewer crew 9/3/59

PREPARED BY Donald J. McKee
2446 7th Street
Riverside, Calif.

APPROVED
Donald J. McKee
DATE

CITY OF RIVERSIDE, CALIFORNIA
DEPARTMENT OF PUBLIC WORKS

PLAN & PROFILE
CALIFORNIA MAJOR
UNIT NO. 2
REES STREET

APPROVED BY
Donald J. McKee