


PROFILE	DATE	BY
SURVEYED		
PLANNED		
NOTED		
STRUCTURE		

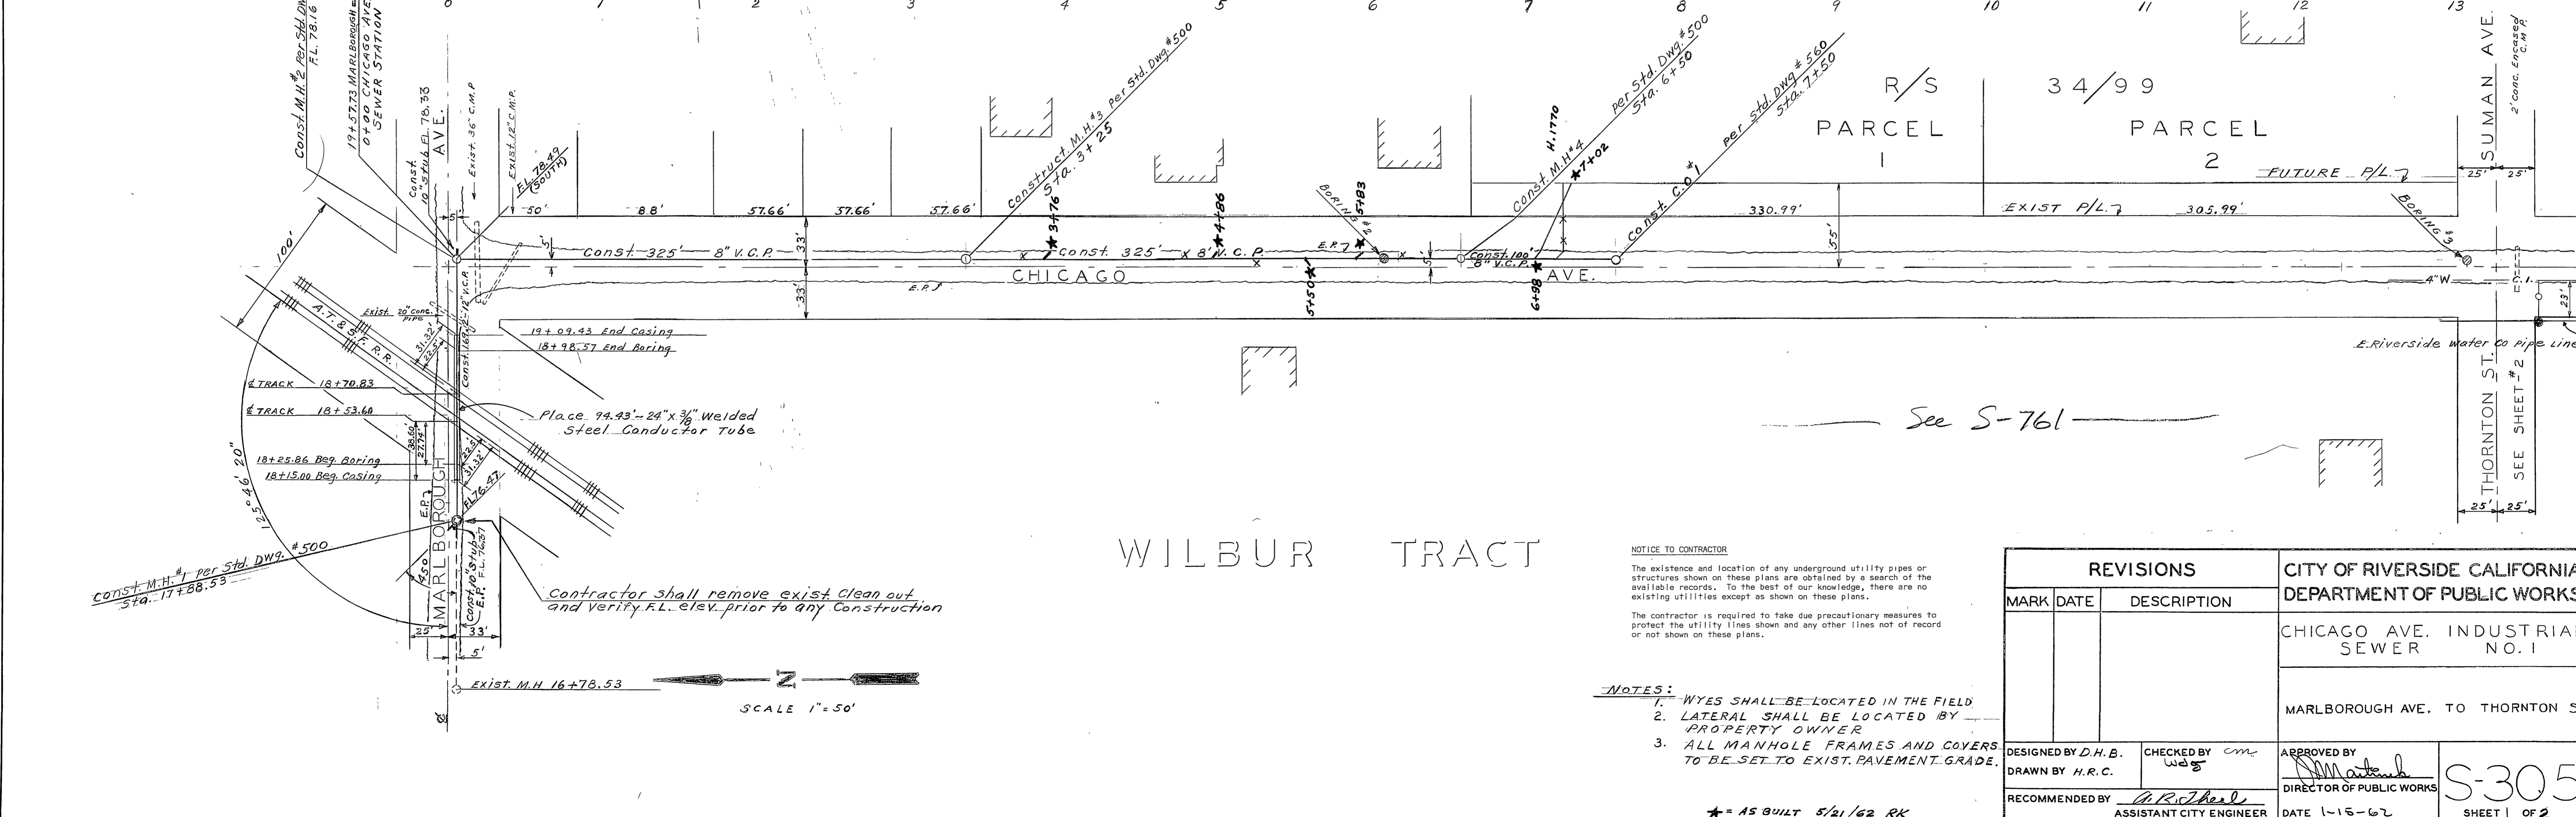

PLAN	DATE	BY
SURVEYED		
PLANNED		
NOTED		
STRUCTURE		

NOTICE TO CONTRACTOR
The existence and location of any underground utility pipes or structures shown on these plans are obtained by a search of the available records. To the best of our knowledge, there are no existing utilities except as shown on these plans.
The contractor is required to take due precautionary measures to protect the utility lines shown and any other lines not of record or not shown on these plans.

- NOTES:**
1. WYES SHALL BE LOCATED IN THE FIELD
 2. LATERAL SHALL BE LOCATED BY PROPERTY OWNER
 3. ALL MANHOLE FRAMES AND COVERS TO BE SET TO EXIST. PAVEMENT GRADE.

* = AS BUILT 5/21/62 RK

REVISIONS		CITY OF RIVERSIDE CALIFORNIA DEPARTMENT OF PUBLIC WORKS
MARK	DATE	
		CHICAGO AVE. INDUSTRIAL SEWER NO. 1
		MARLBOROUGH AVE. TO THORNTON ST.
DESIGNED BY D.H.B.	CHECKED BY <i>cm</i>	APPROVED BY <i>[Signature]</i>
DRAWN BY H.R.C.	WES	DIRECTOR OF PUBLIC WORKS
RECOMMENDED BY <i>[Signature]</i>	ASSISTANT CITY ENGINEER	DATE 1-15-62
		S-305
		SHEET 1 OF 2