


PLAN
 SURVISED
 PLOTTED
 ALIGNMENT CHECKED
 RT. OF WAY CHECKED
 NO. _____ DATE _____

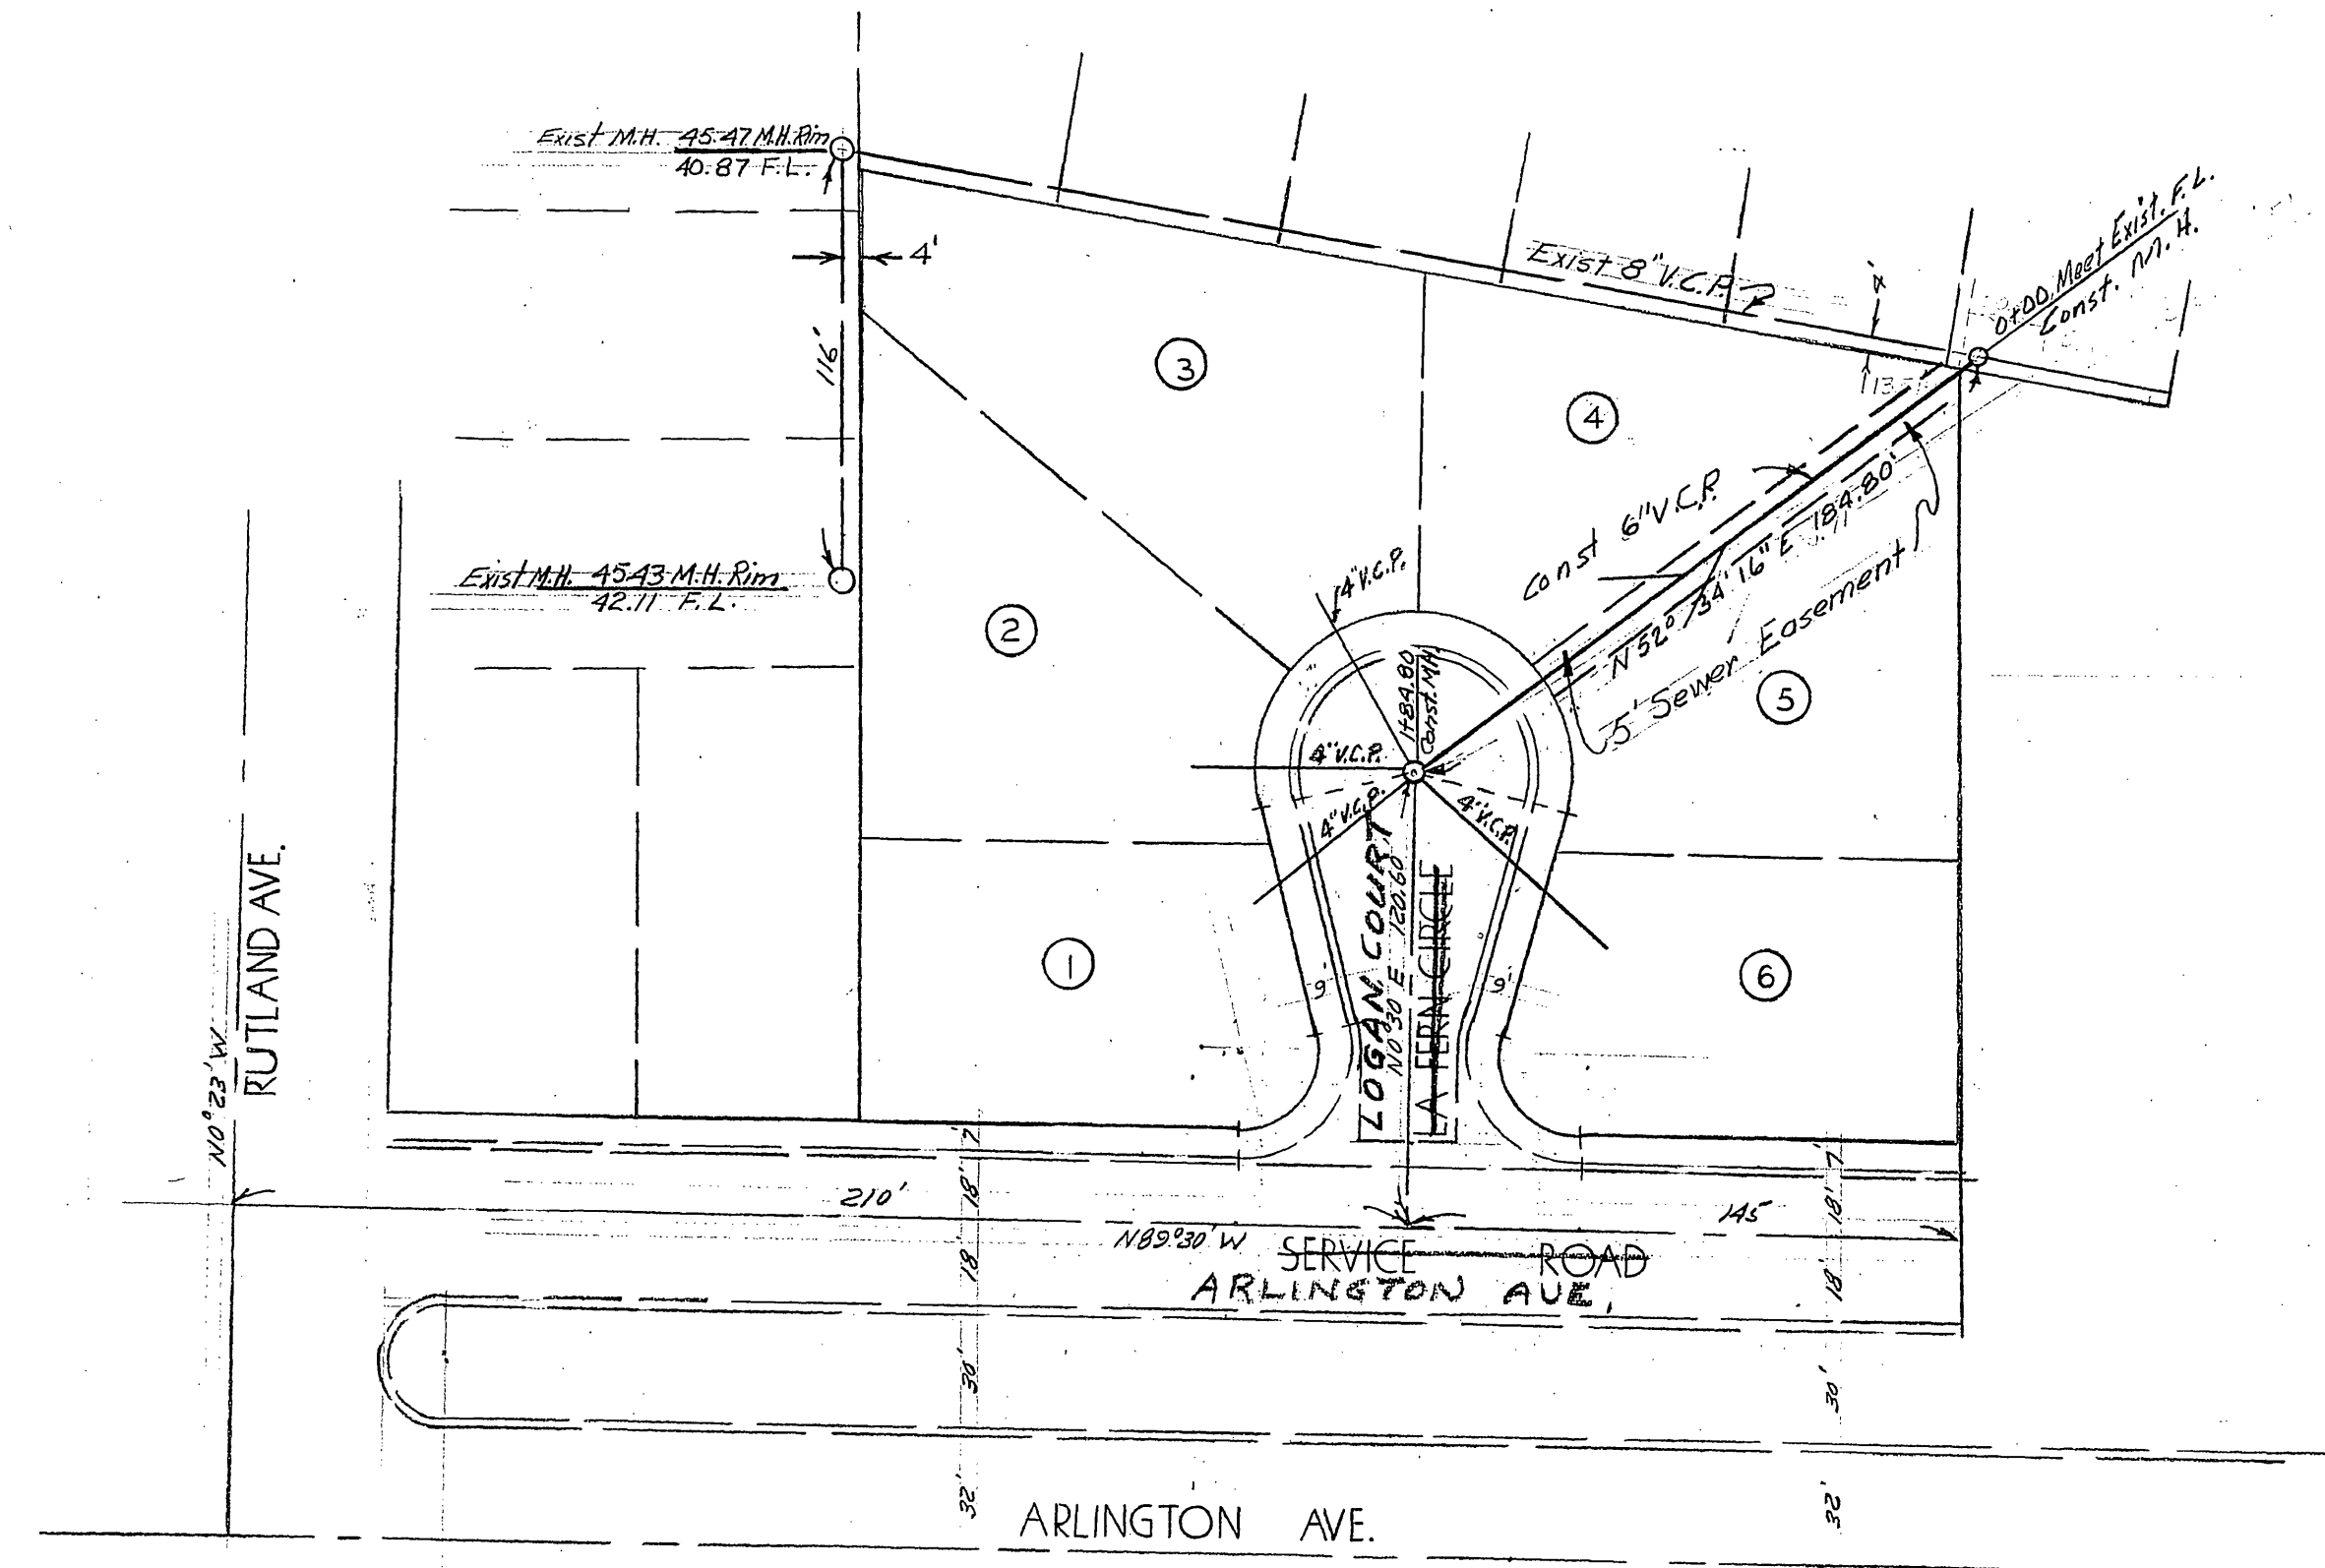


Note: Contractor may alter location of wyes to better meet house connections.

SEWER PLAN & PROFILE
 HAMPSHIRE SUBDIVISION

RIVERSIDE ENGINEERING CO.
 RIVERSIDE, CALIFORNIA
 FOR **DOWN'S DEVELOPMENT COMPANY**
 HAMPSHIRE SUBDIVISION
 DRAWN BY: J.C.P. CHECKED BY: _____ SCALE: 1"=50'
 DATE: 5-3-57 REVISED: _____
 George O. Crawley CIVIL ENGINEER NO. 9455
 JOB NO. 4886 SHEET 1 OF 1

APPROVED *L.E. Lewis Rd*

PROFILE
 SURVISED
 PLOTTED
 GRADES CHECKED
 STRUCTURE NOTATIONS CHKD.
 NO. _____ DATE _____

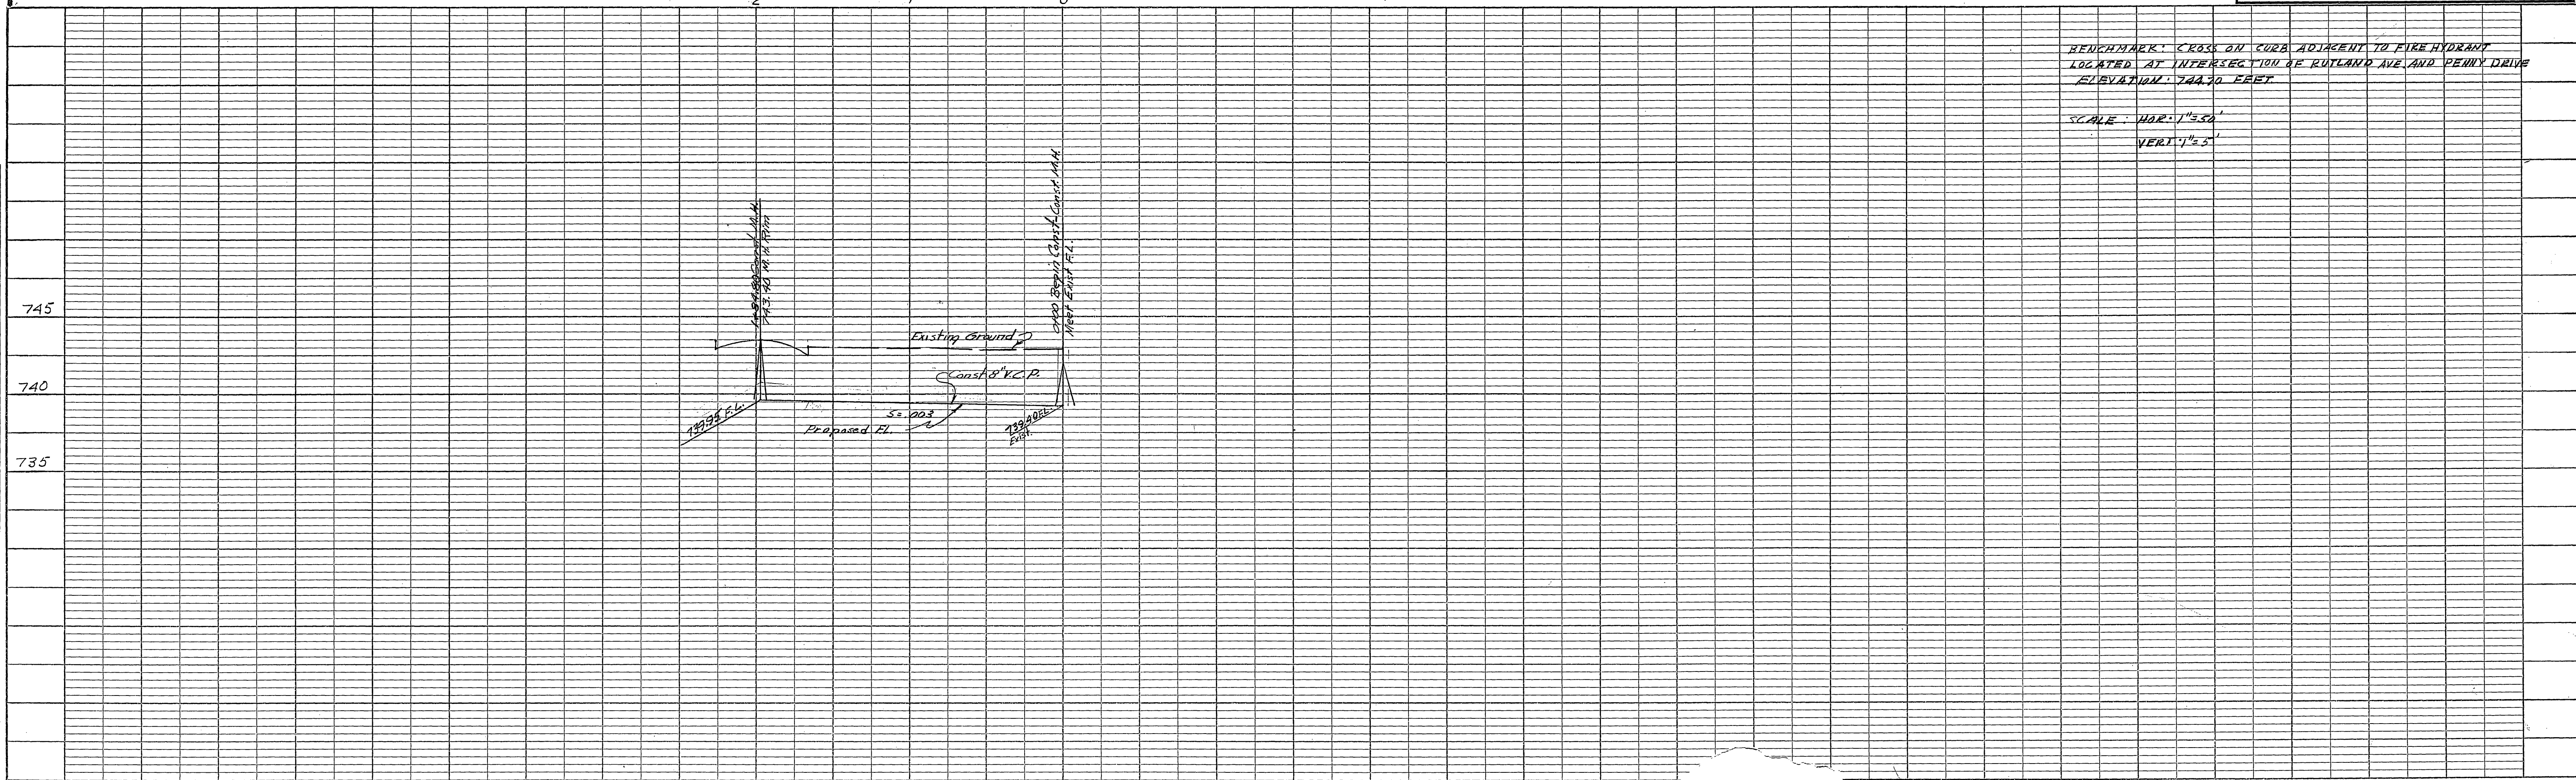

BENCHMARK: CROSS ON CURB ADJACENT TO FIRE HYDRANT
 LOCATED AT INTERSECTION OF RUTLAND AVE AND PENNY DRIVE
 ELEVATION: 744.70 FEET
 SCALE: HOR. 1"=50'
 VERT. 1"=5'