


PLAN
 SURVISED
 PLOTTED
 ALIGNMENT CHECKED
 RT. OF WAY CHECKED
 NO. _____
 DATE _____
 BY _____


PROFILE
 SURVISED
 PLOTTED
 GRADES CHECKED
 STRUCTURE LOCATIONS CHECKED
 NO. _____
 DATE _____
 BY _____

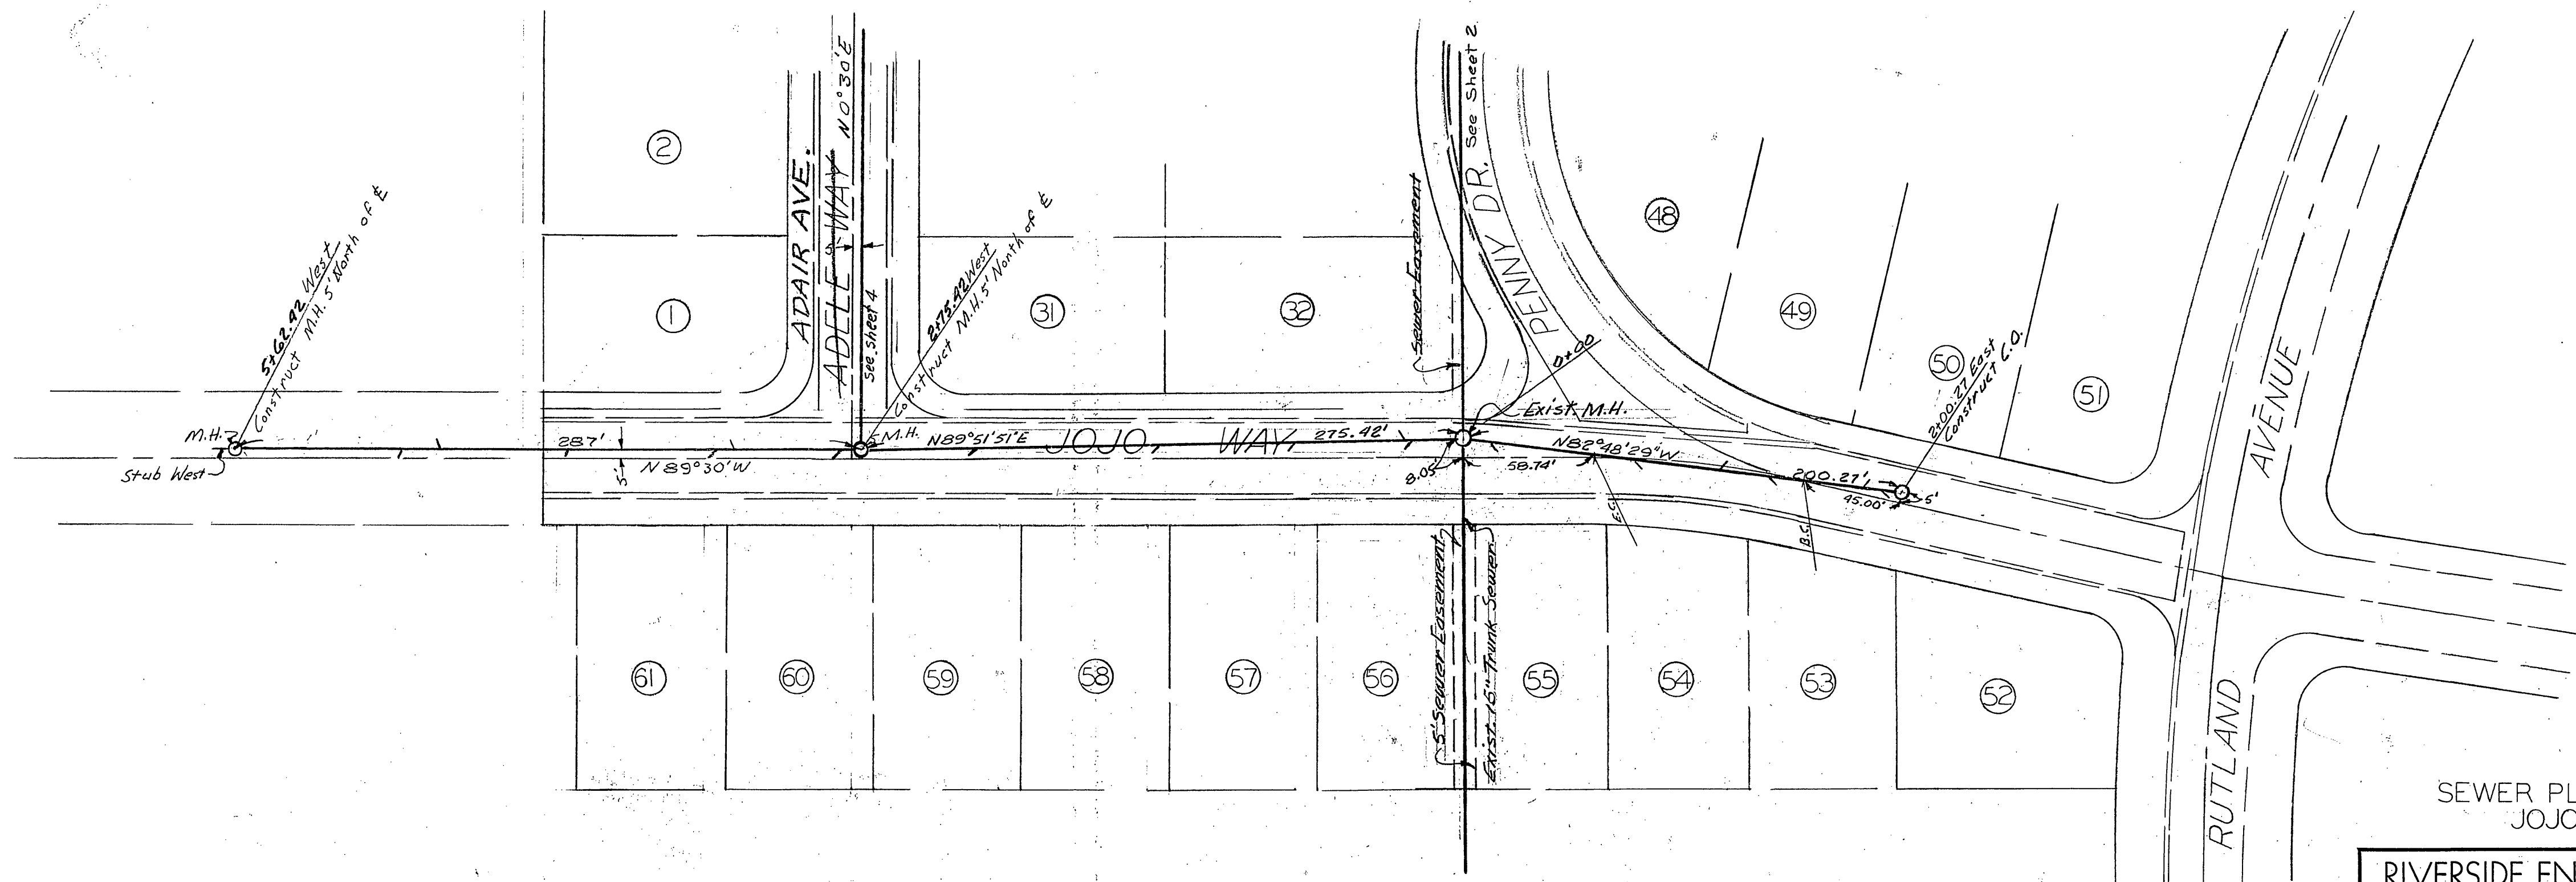

DATE 1-8-57
 APPROVED Sewer Lines
 RIVERSIDE COUNTY HEALTH DEPARTMENT
 BY M. B. Hawkins, R.S.

RIVERSIDE ENGINEERING CO.
 RIVERSIDE, CALIFORNIA
 FOR THE HALE COMPANY
 MODEL SUBDIVISION UNIT 1
 DRAWN BY G.M. CHECKED BY _____ SCALE 1/8"=1'-0"
 DATE 1-7-57 REVISED 3-8-57
 George O. Crowley CIVIL ENGINEER #4466
 JOB NO. 1490-1798 SHEET 1 OF 5

West 6 5 4 3 2 1 0 1 2 East

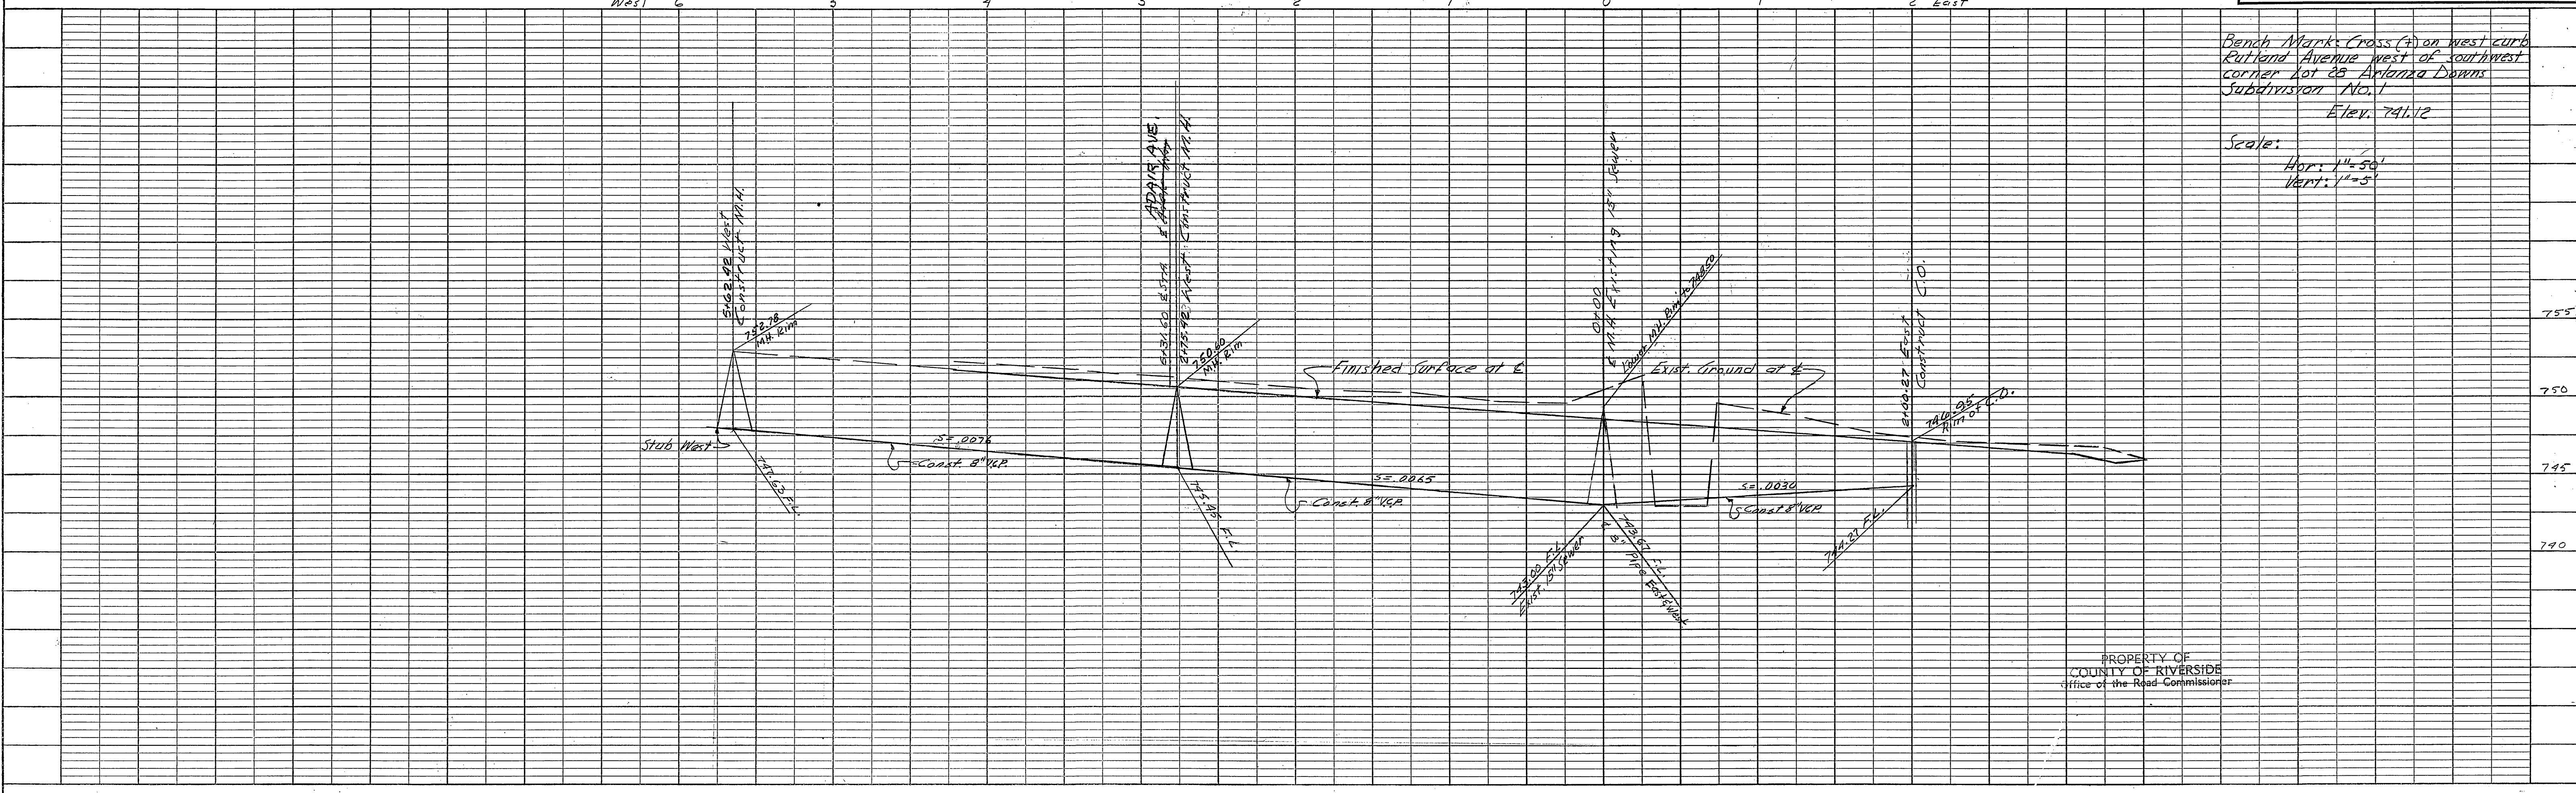


Bench Marks Cross (A) on west curb
 Rutland Avenue west of southwest
 corner lot 45 Arlanza Downs
 Subdivision No. 1
 Elev. 741.12
 Scale:
 Hor: 1"=50'
 Vert: 1"=5'

PROPERTY OF
 COUNTY OF RIVERSIDE
 Office of the Road Commissioner

PLAN
 SURVEYED
 PLOTTED
 ALIGNMENT CHECKED
 RT. OF WAY CHECKED
 NO.

PROFILE
 SURVEYED
 PLOTTED
 GRADES CHECKED
 B.M.S. NOTED
 STRUCTURE NOTATIONS CHECKED
 NO.

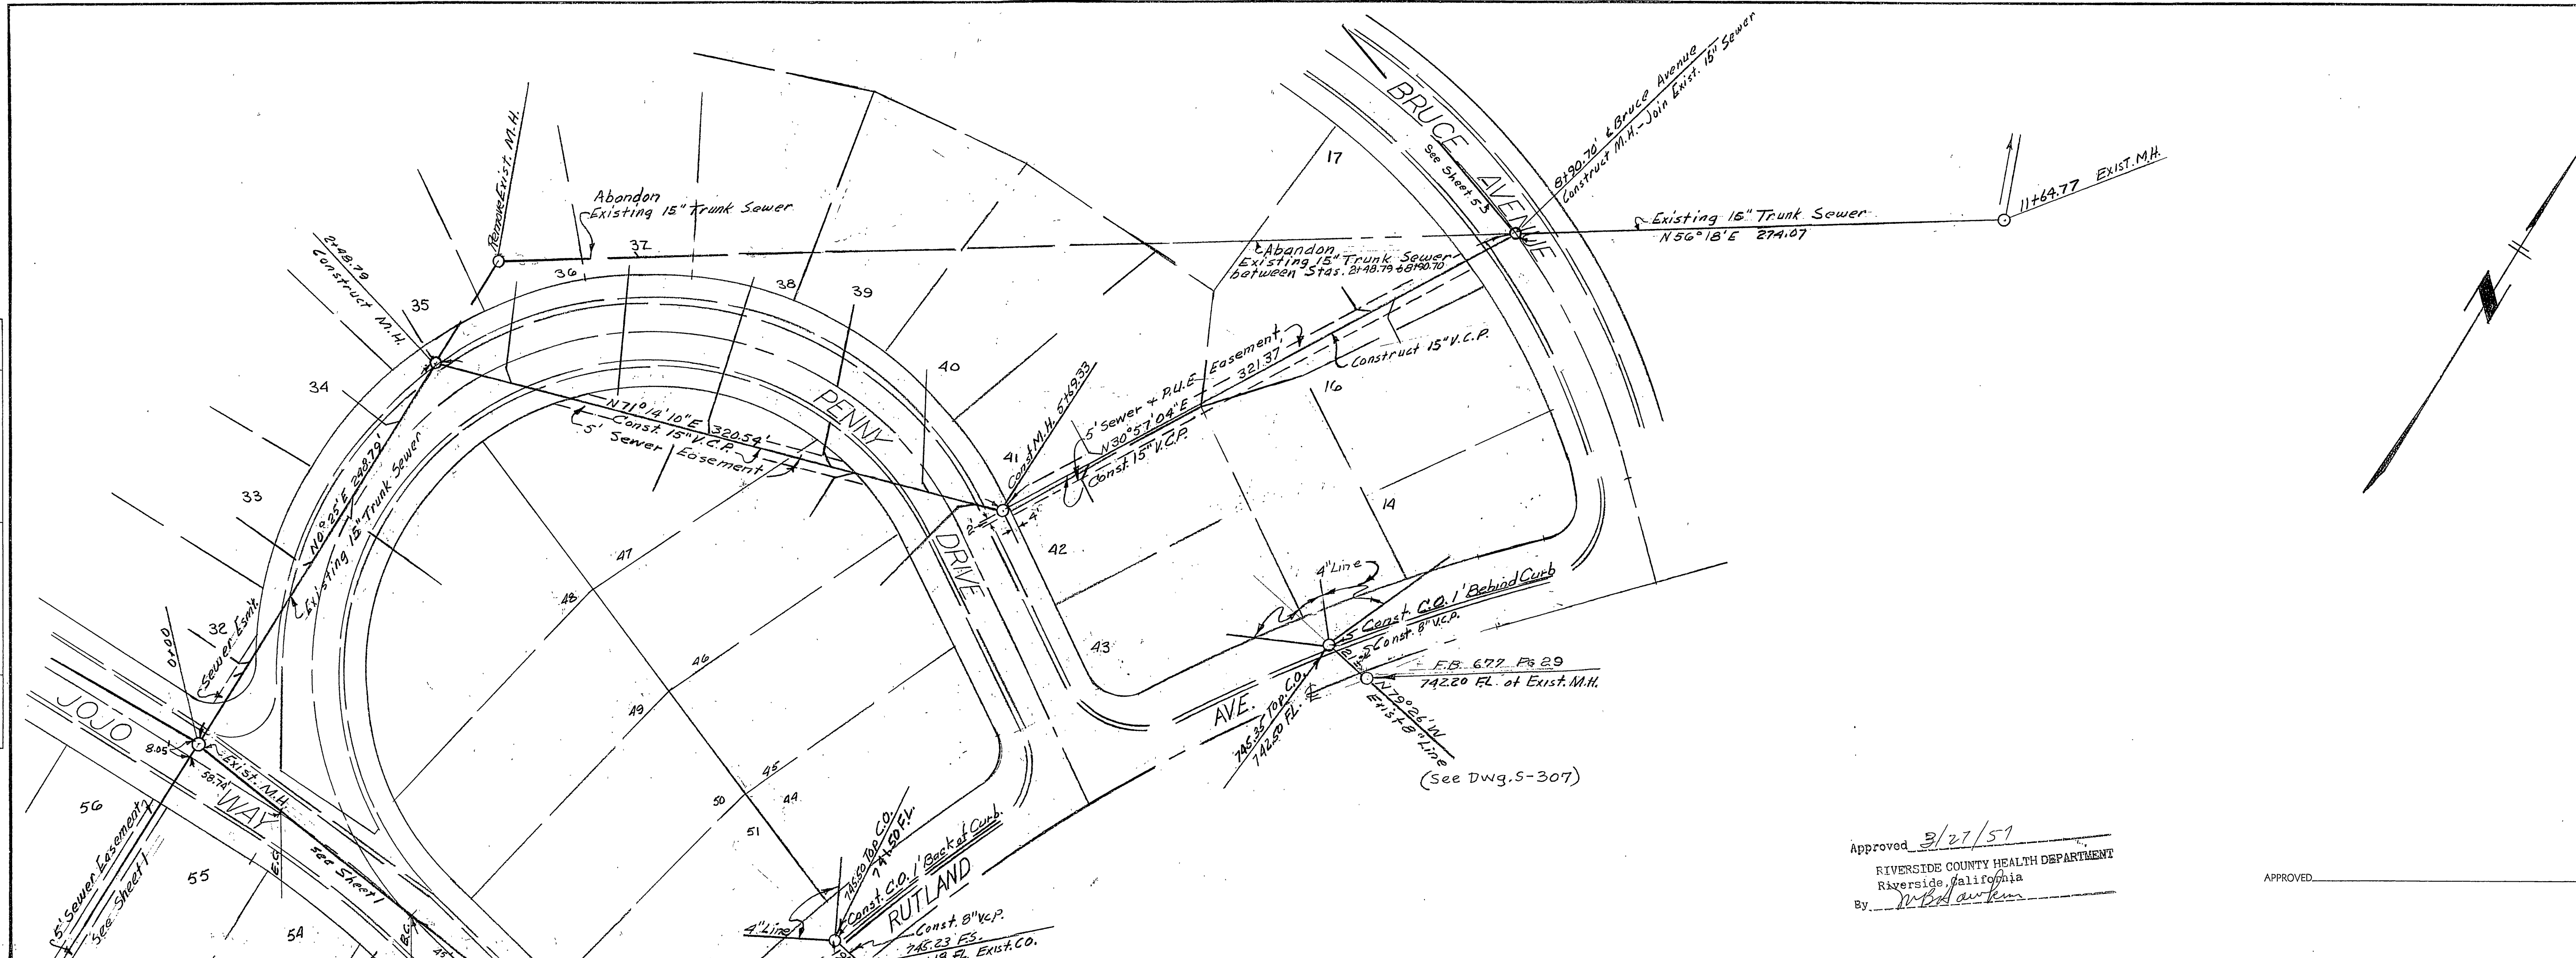


SEWER PLAN & PROFILE
 EXISTING LINE & RELOCATIONS

RIVERSIDE ENGINEERING CO.
 RIVERSIDE, CALIFORNIA
 FOR THE HALE COMPANY
 MODEL SUBDIVISION UNIT I
 DRAWN BY G.N. CHECKED BY SCALE 1"=50'
 DATE 1-7-57 REVISED 3-8-57
 George O. Crowley CIVIL ENGINEER NO. 9455
 JOB NO. 1722 SHEET 2 OF 5

Approved 3/27/57
 RIVERSIDE COUNTY HEALTH DEPARTMENT
 Riverside, California
 By W. B. ...

APPROVED


Bench Mark: Cross (A) on west curb
 Rutland Avenue west at southeast
 corner lot 25 - Alpanza Downs
 Subdivision No. 1
 Elev. 741.12
 Scale:
 Hor: 1"=30'
 Vert: 1"=5'

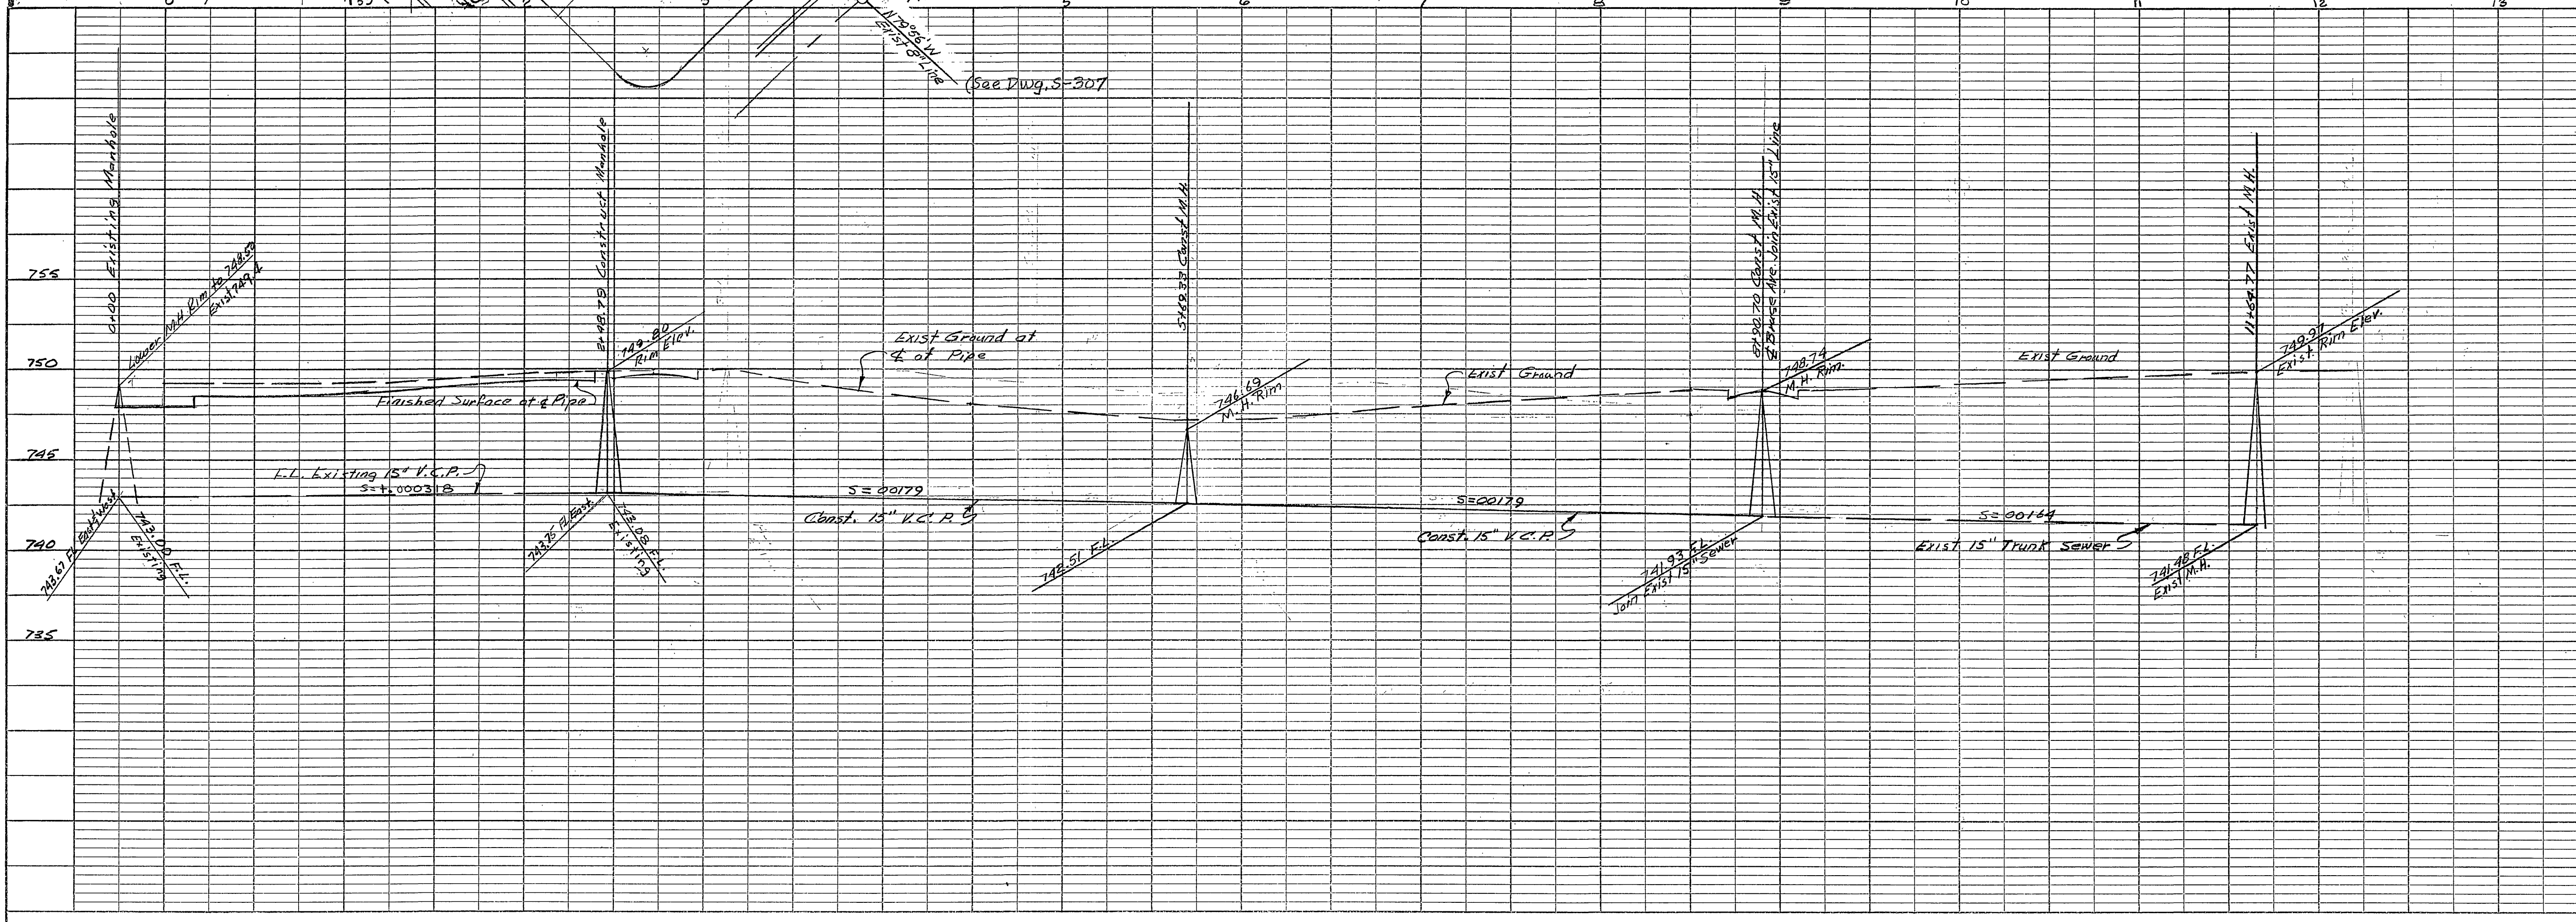

PENNY EASEMENT
S-312
 SH. 2 OF 5


PLAN
 SURVEYED
 NOTE BOOK
 NO.

PROFILE
 SURVEYED
 NOTE BOOK
 NO.

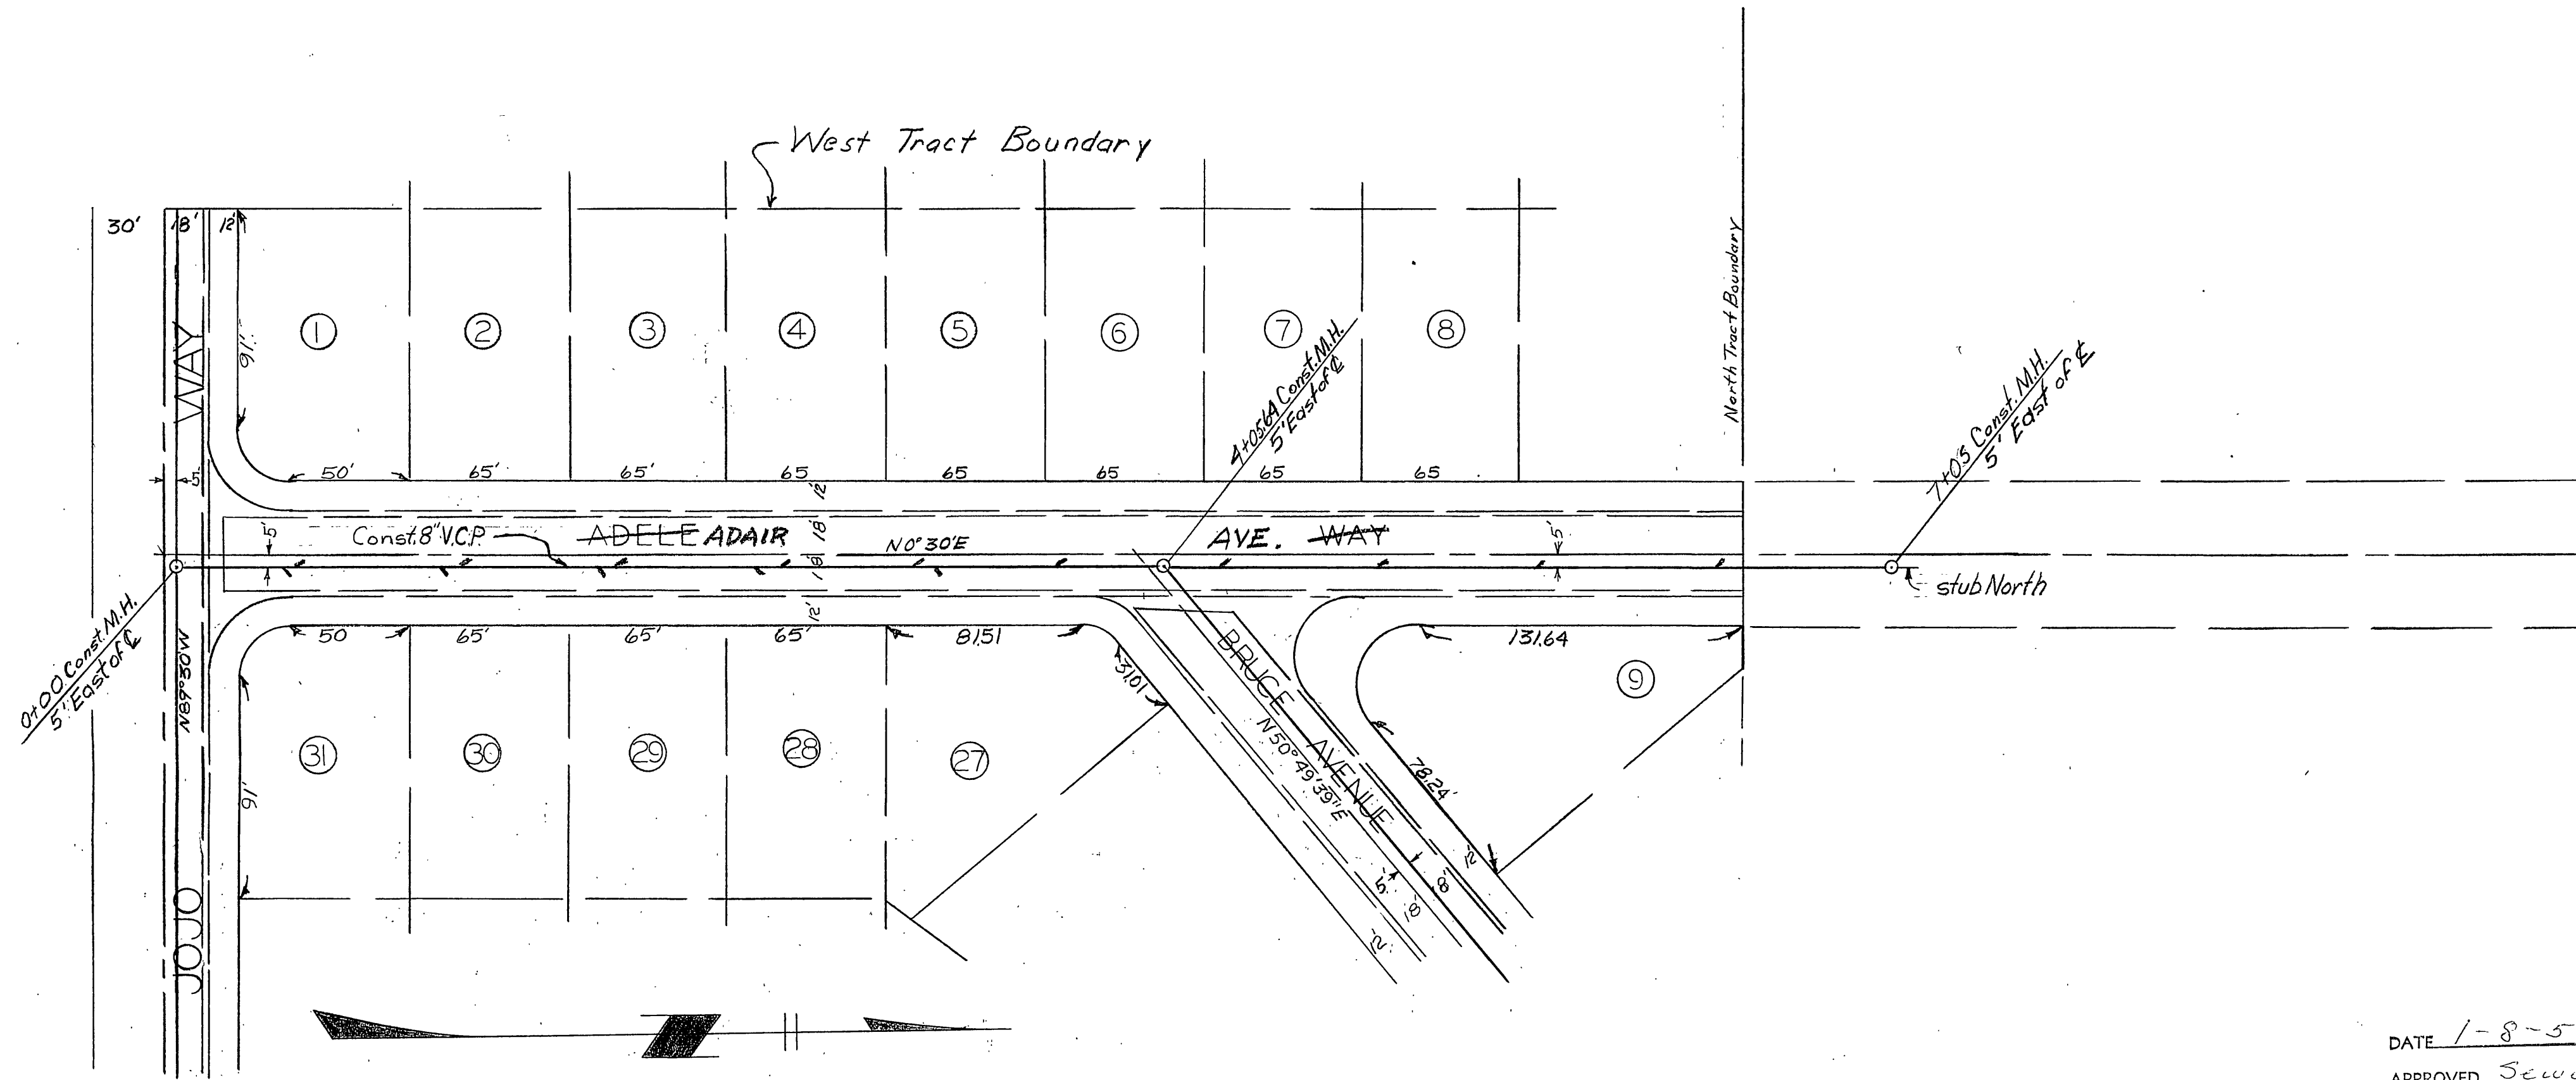

DATE 1-8-57
 APPROVED Sewer lines
 RIVERSIDE COUNTY HEALTH DEPARTMENT
 BY M. B. Hawkins, R.S.

SEWER PLAN & PROFILE
 ADAIR AVE. - ADELE WAY
 RIVERSIDE ENGINEERING CO.
 RIVERSIDE, CALIFORNIA
 FOR THE HALE COMPANY
 MODEL SUBDIVISION UNIT I
 DRAWN BY GHE CHECKED BY SCALE 1"=50'
 DATE 1-7-57 REVISED
 George O. Crawley CIVIL ENGINEER #1480
 JOB NO. 1490 SHEET 3 OF 5

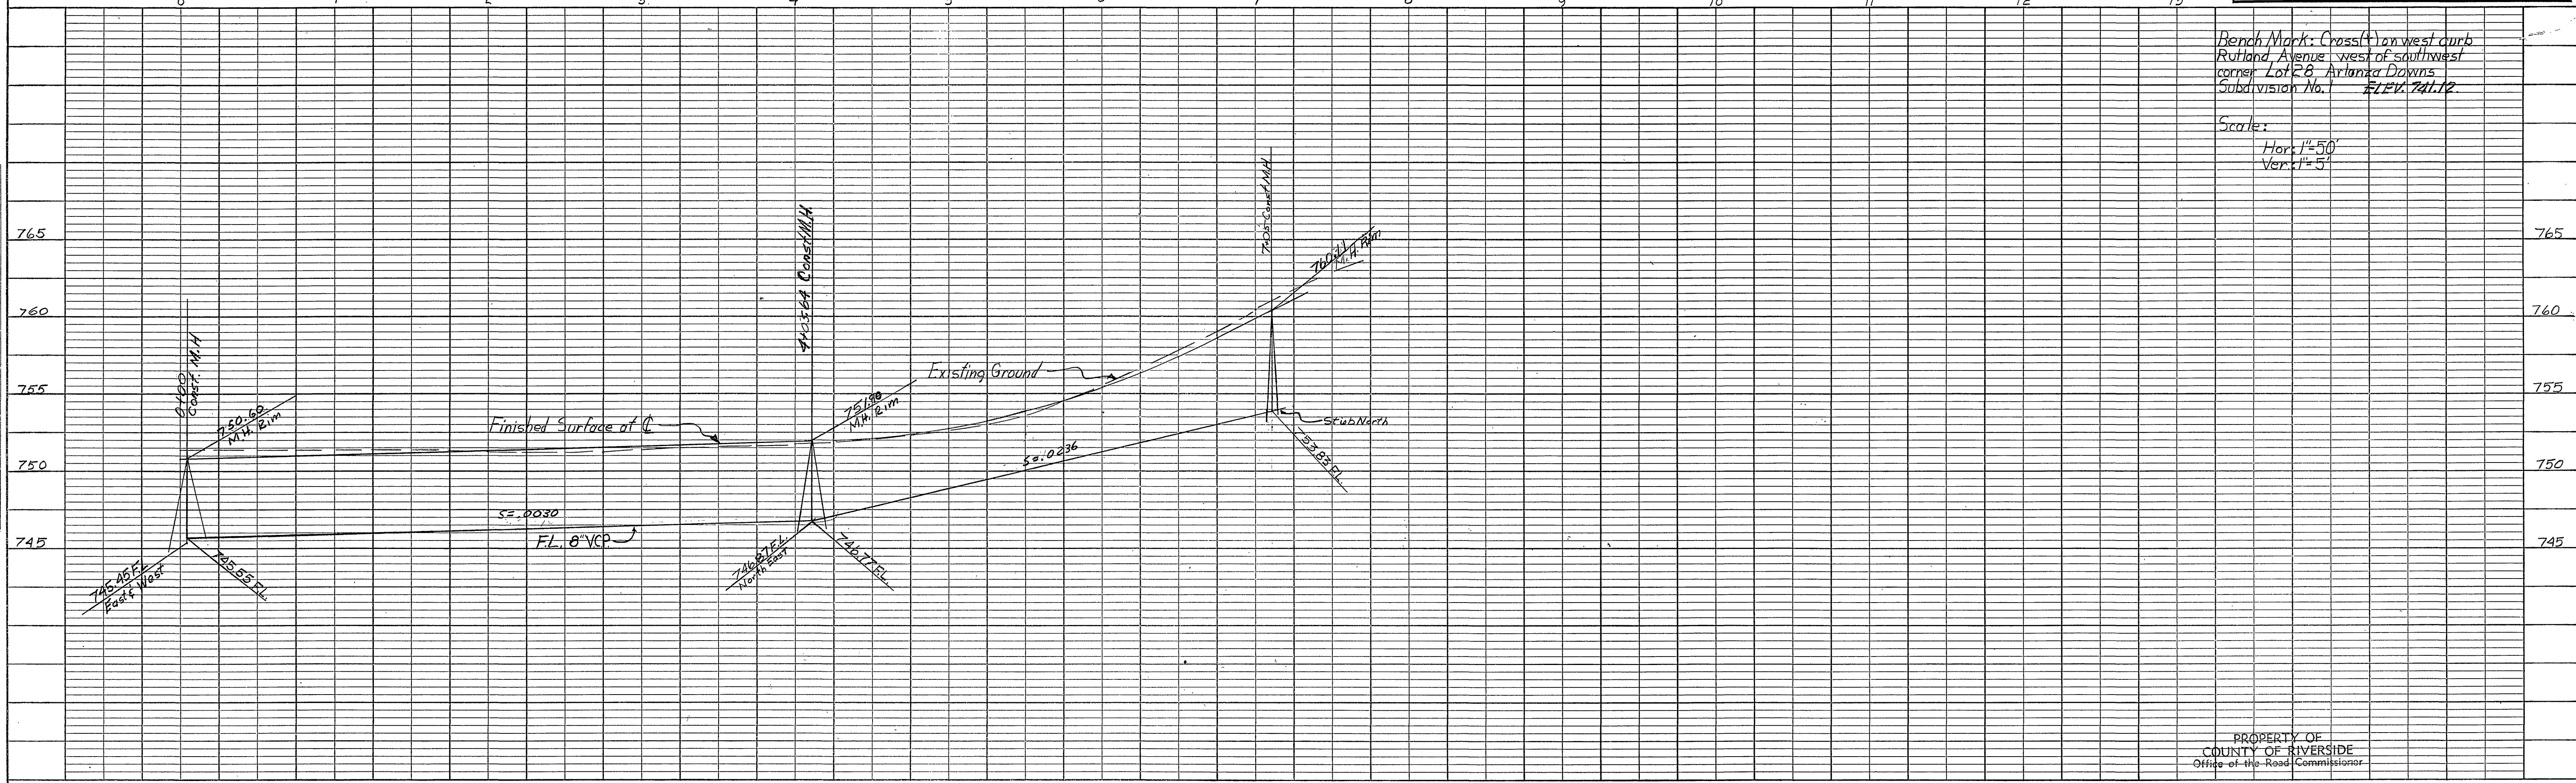


Bench Mark: Cross (+) on west curb
 Rutland Avenue west of southwest
 corner Lot 28, Atlanta Downs
 Subdivision No. 1 ELEV. 741.12

Scale:
 Horz. 1"=50'
 Vert. 1"=5'

PROPERTY OF
 COUNTY OF RIVERSIDE
 Office of the Road Commissioner

PLAN	DATE
SURVISED	BY
PLOTTED	
ALIGNMENT CHECKED	
RT. OF WAY CHECKED	
NO.	

PROFILE	DATE
SURVISED	BY
PLOTTED	
SPACES CHECKED	
STRUCTURE NOTATIONS CH'VD	
NO.	

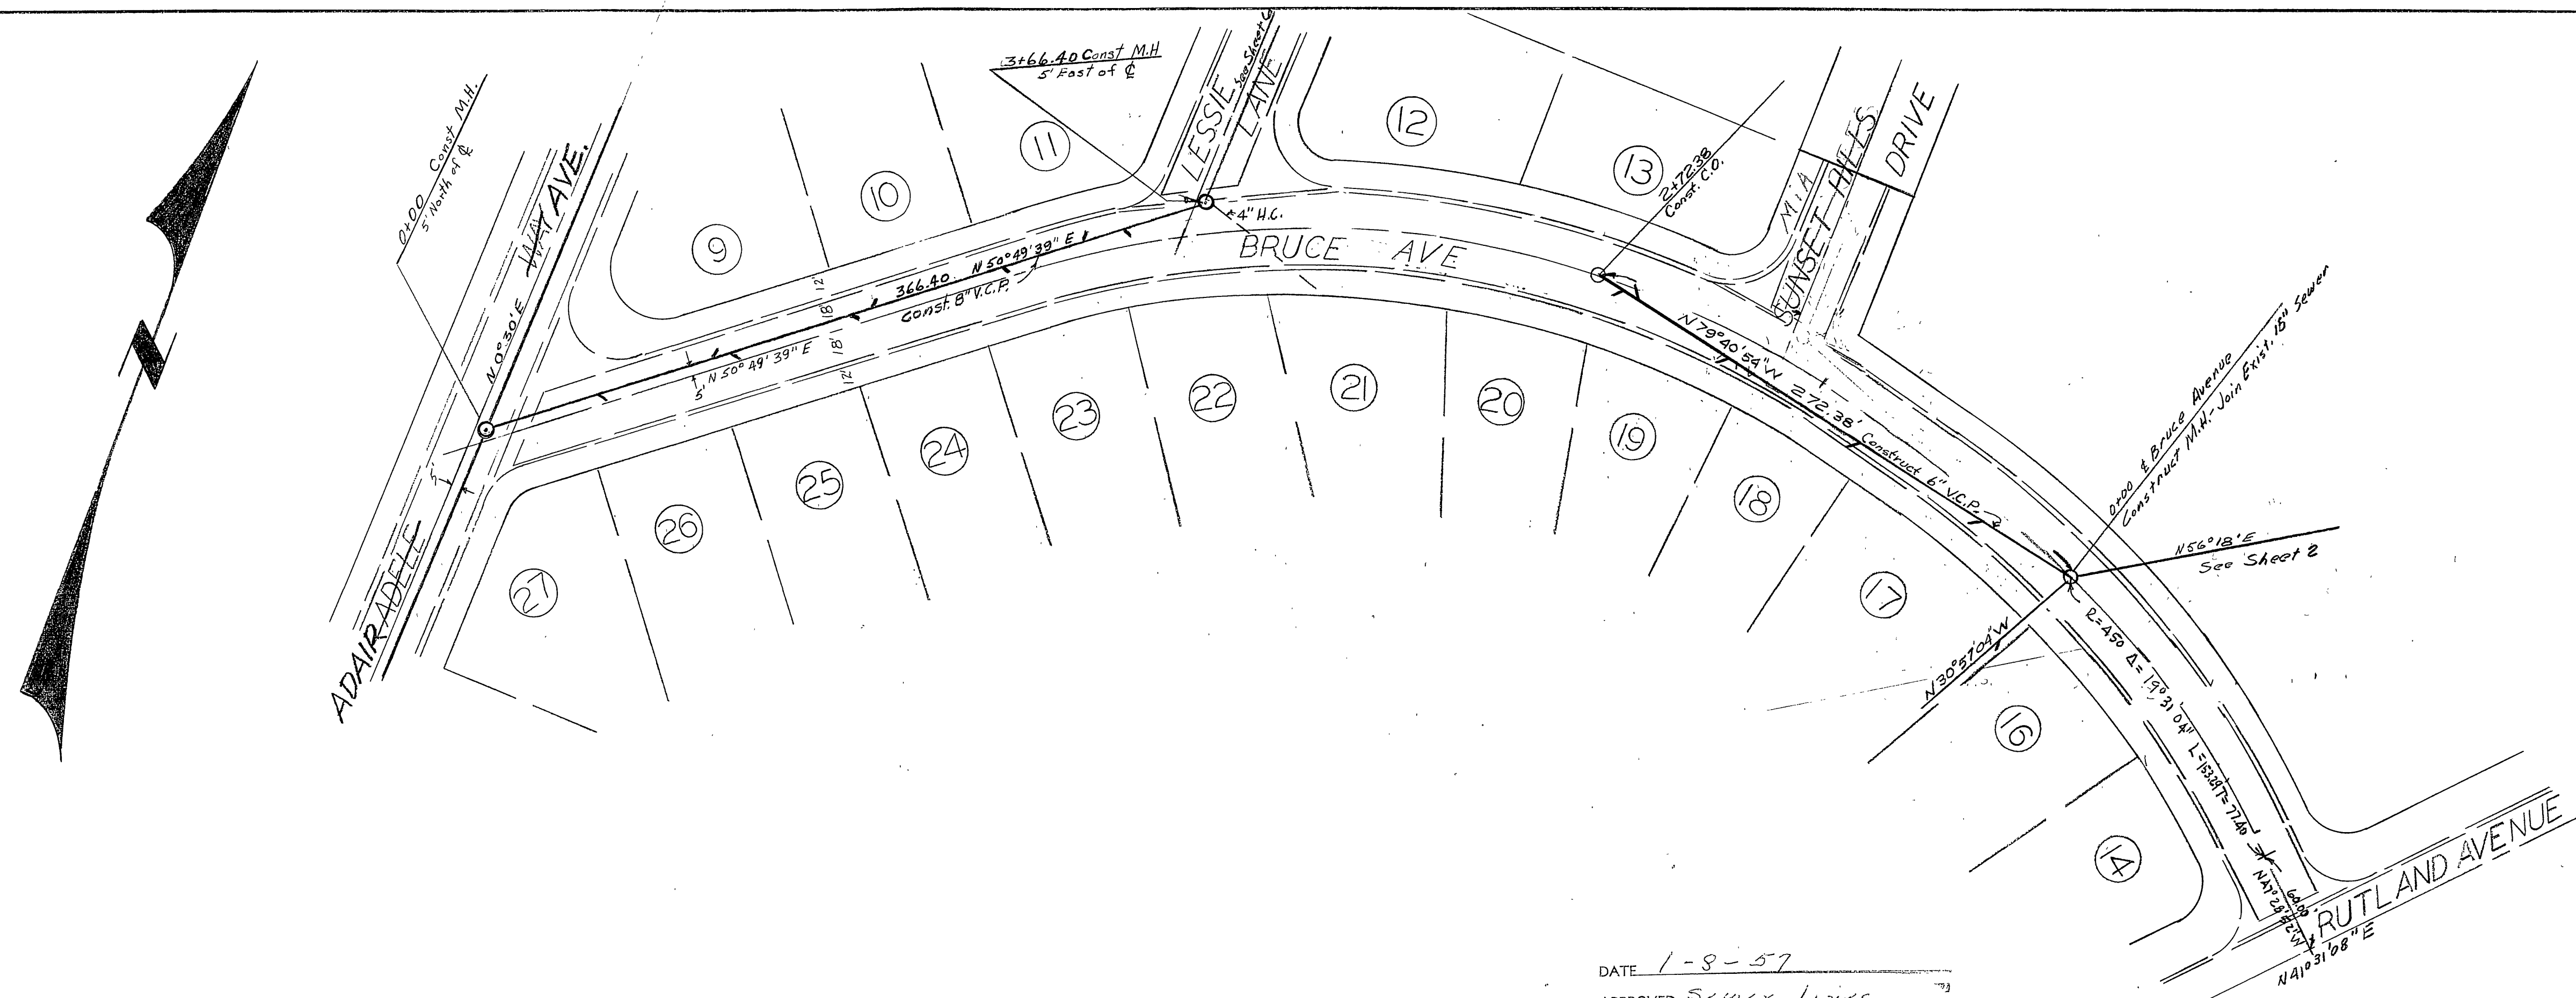


SEWER PLAN & PROFILE
BRUCE AVENUE

RIVERSIDE ENGINEERING CO.
RIVERSIDE, CALIFORNIA
FOR THE HALE COMPANY
MODEL SUBDIVISION UNIT I
DRAWN BY GN CHECKED BY SCALE 1"=50'
DATE 1-7-57 REVISED 3-8-57
George O. Crawley CIVIL ENGINEER NO. 9455
JOB NO. 7798-1798 SHEET 4 OF 5

DATE 1-8-57
APPROVED Sewer Lines
RIVERSIDE COUNTY HEALTH DEPARTMENT
BY M.B. Hawkins, R.S.

APPROVED
RIVERSIDE COUNTY ROAD COMMISSIONER

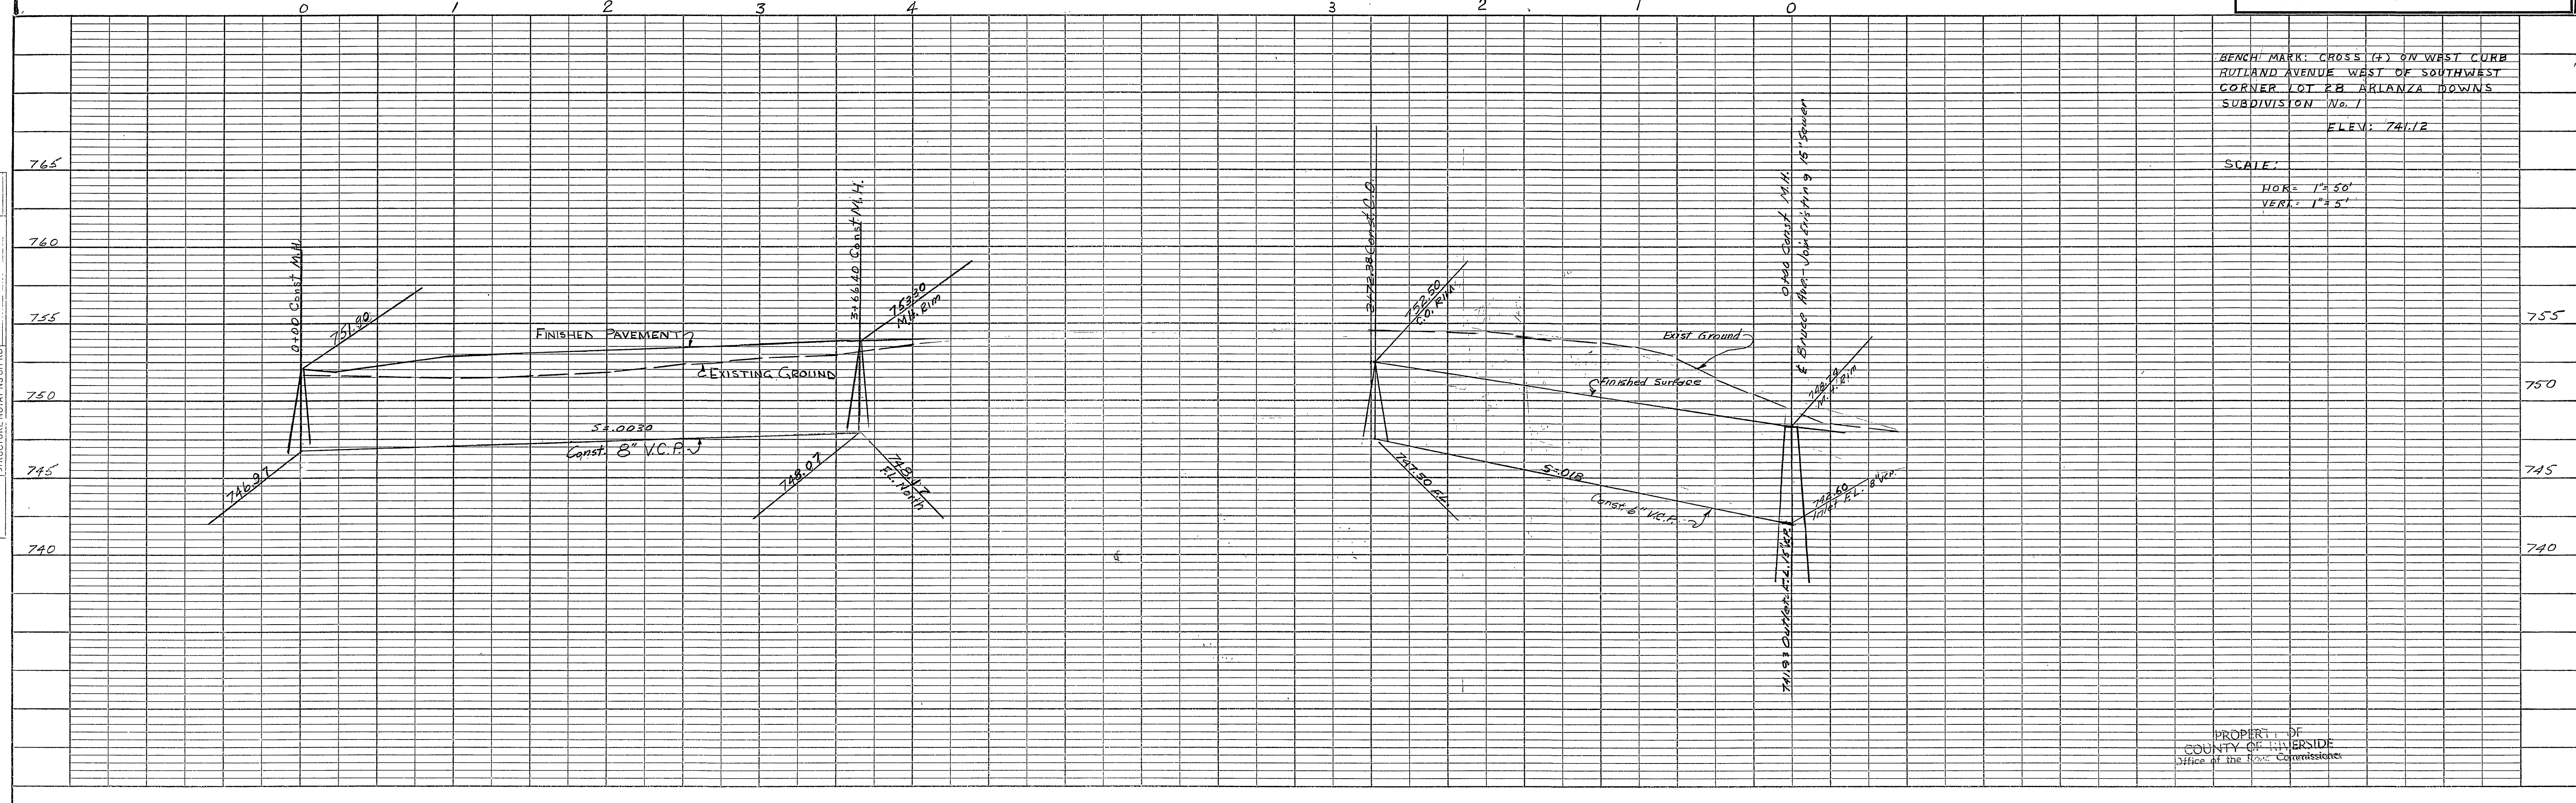


BENCH MARK: CROSS (4) ON WEST CURB
RUTLAND AVENUE WEST OF SOUTHWEST
CORNER LOT 28 ARIZONA DOWNS
SUBDIVISION No. 1
ELEV: 741.12

SCALE:
HOR: 1"=50'
VERT: 1"=5'

PROPERTY OF
COUNTY OF RIVERSIDE
Office of the Road Commissioner

PLAN SURVEYED BY DATE
 PLOTTED BY
 NOTE BOOK NO.
 CHECKED BY
 BY OF WAY CHECKED

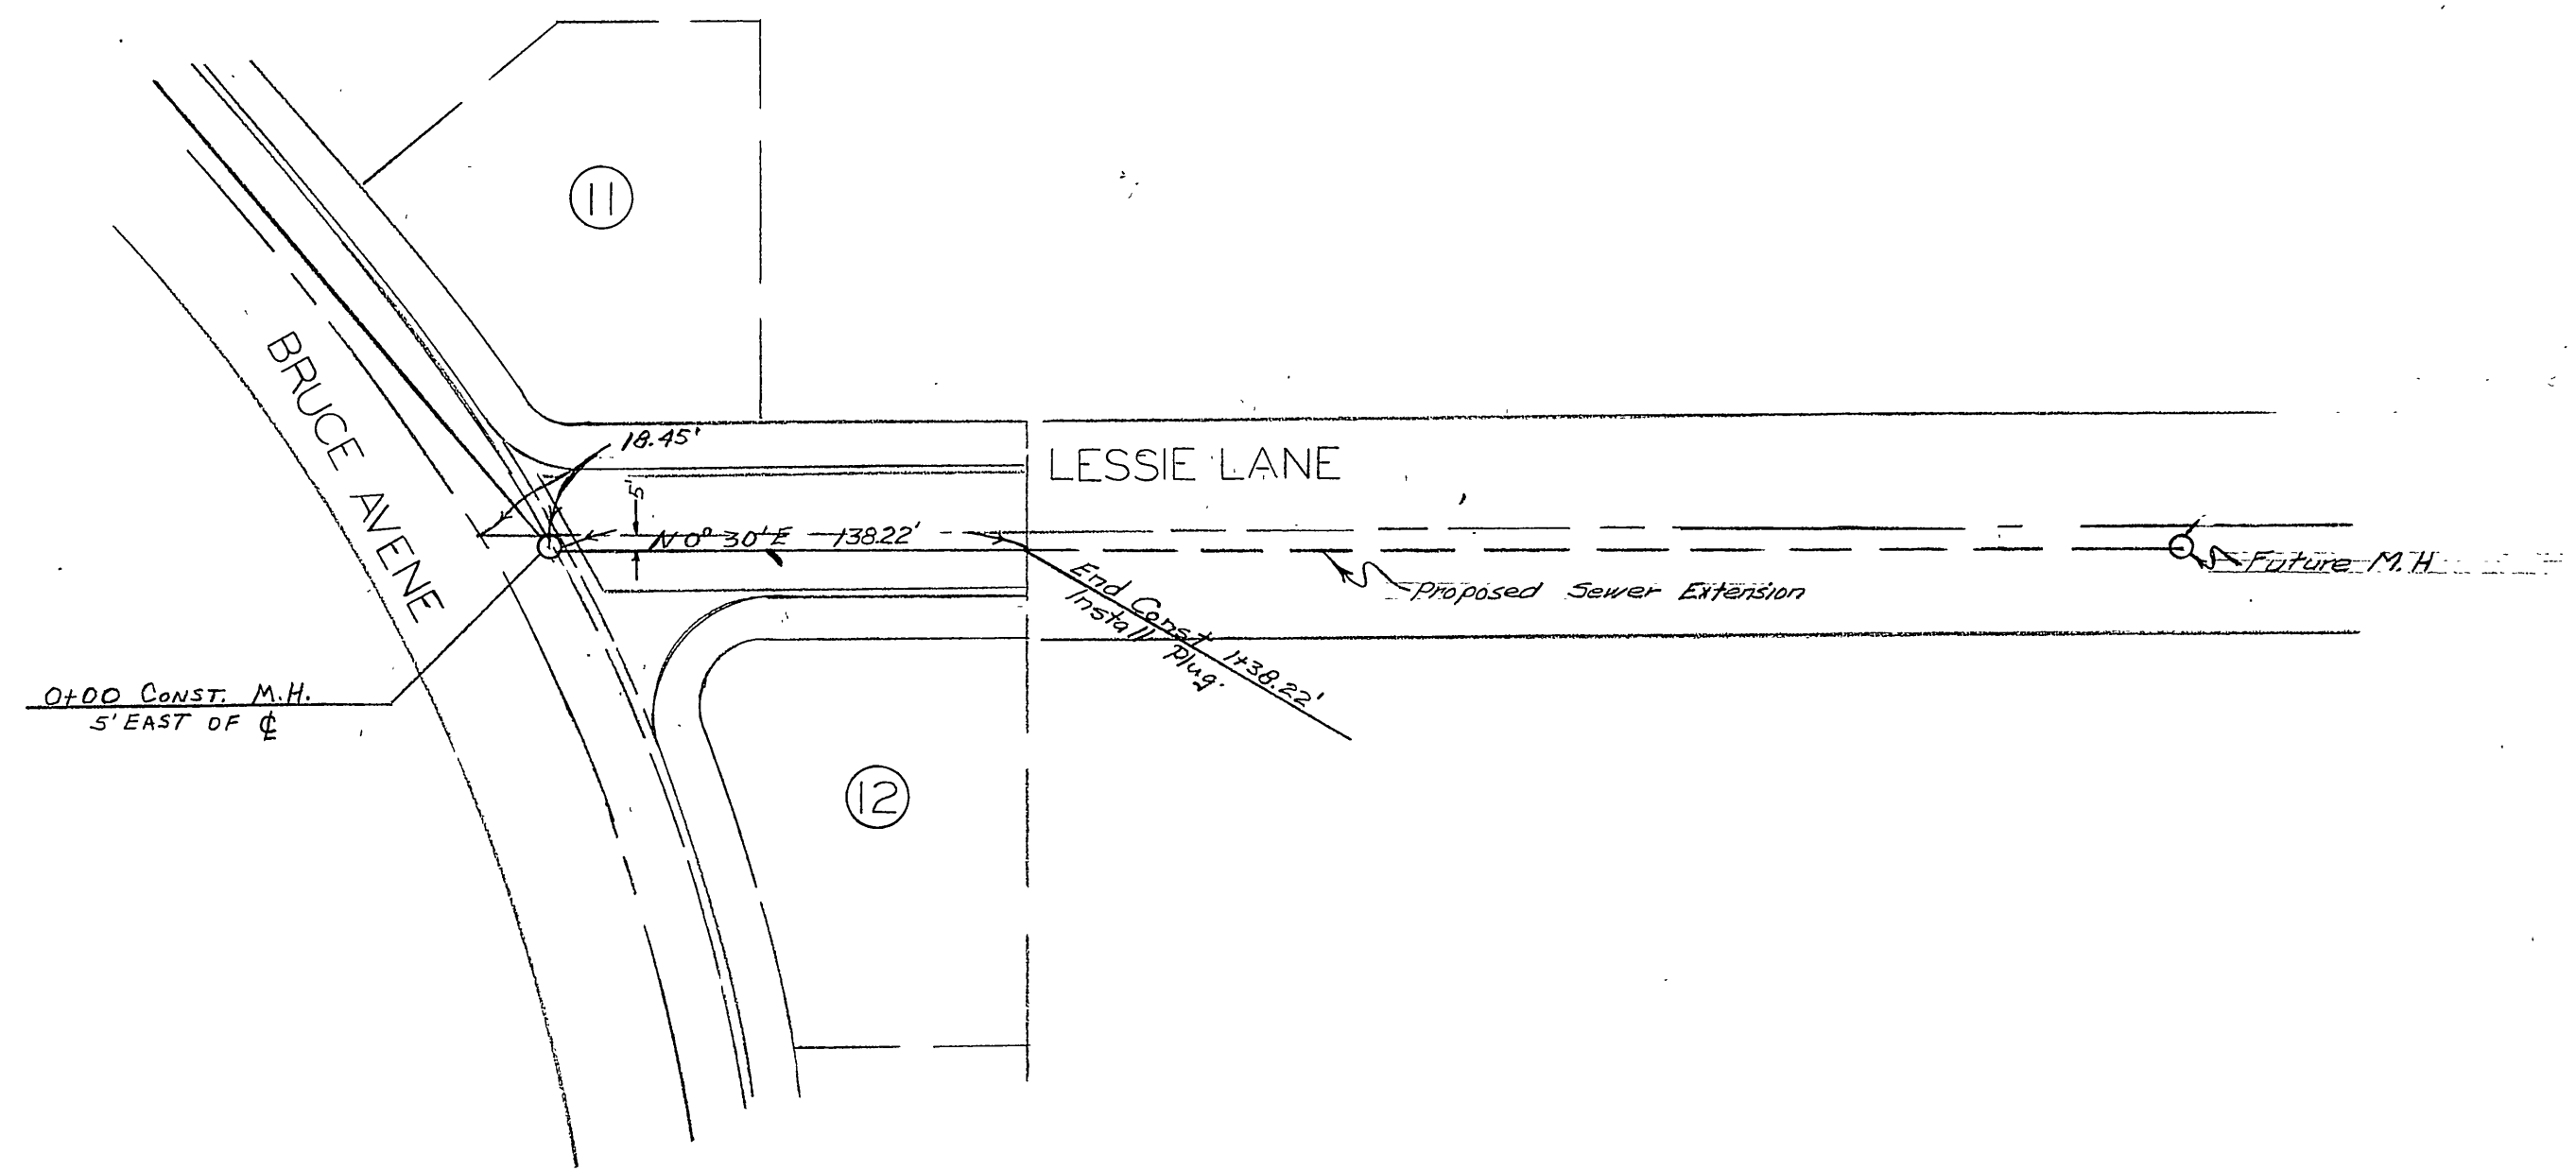


SEWER PLAN & PROFILE
 LESSIE LANE

RIVERSIDE ENGINEERING CO.
 RIVERSIDE, CALIFORNIA
 FOR THE HALE COMPANY
 MODEL SUBDIVISION UNIT 1
 DRAWN BY db CHECKED BY SCALE 1"=50'
 DATE 1-7-57 REVISED
 George O. Crowley CIVIL ENGINEER NO. 9455
 JOB NO. 4907798 SHEET 5 OF 5

DATE 1-8-57
 APPROVED Sewer Line
 RIVERSIDE COUNTY HEALTH DEPARTMENT
 BY M.B. Hawkins P.S.

APPROVED

PROFILE SURVEYED BY DATE
 PLOTTED BY
 NOTE BOOK NO.
 CHECKED BY
 STRUCTURE NOTATIONS CHECKED

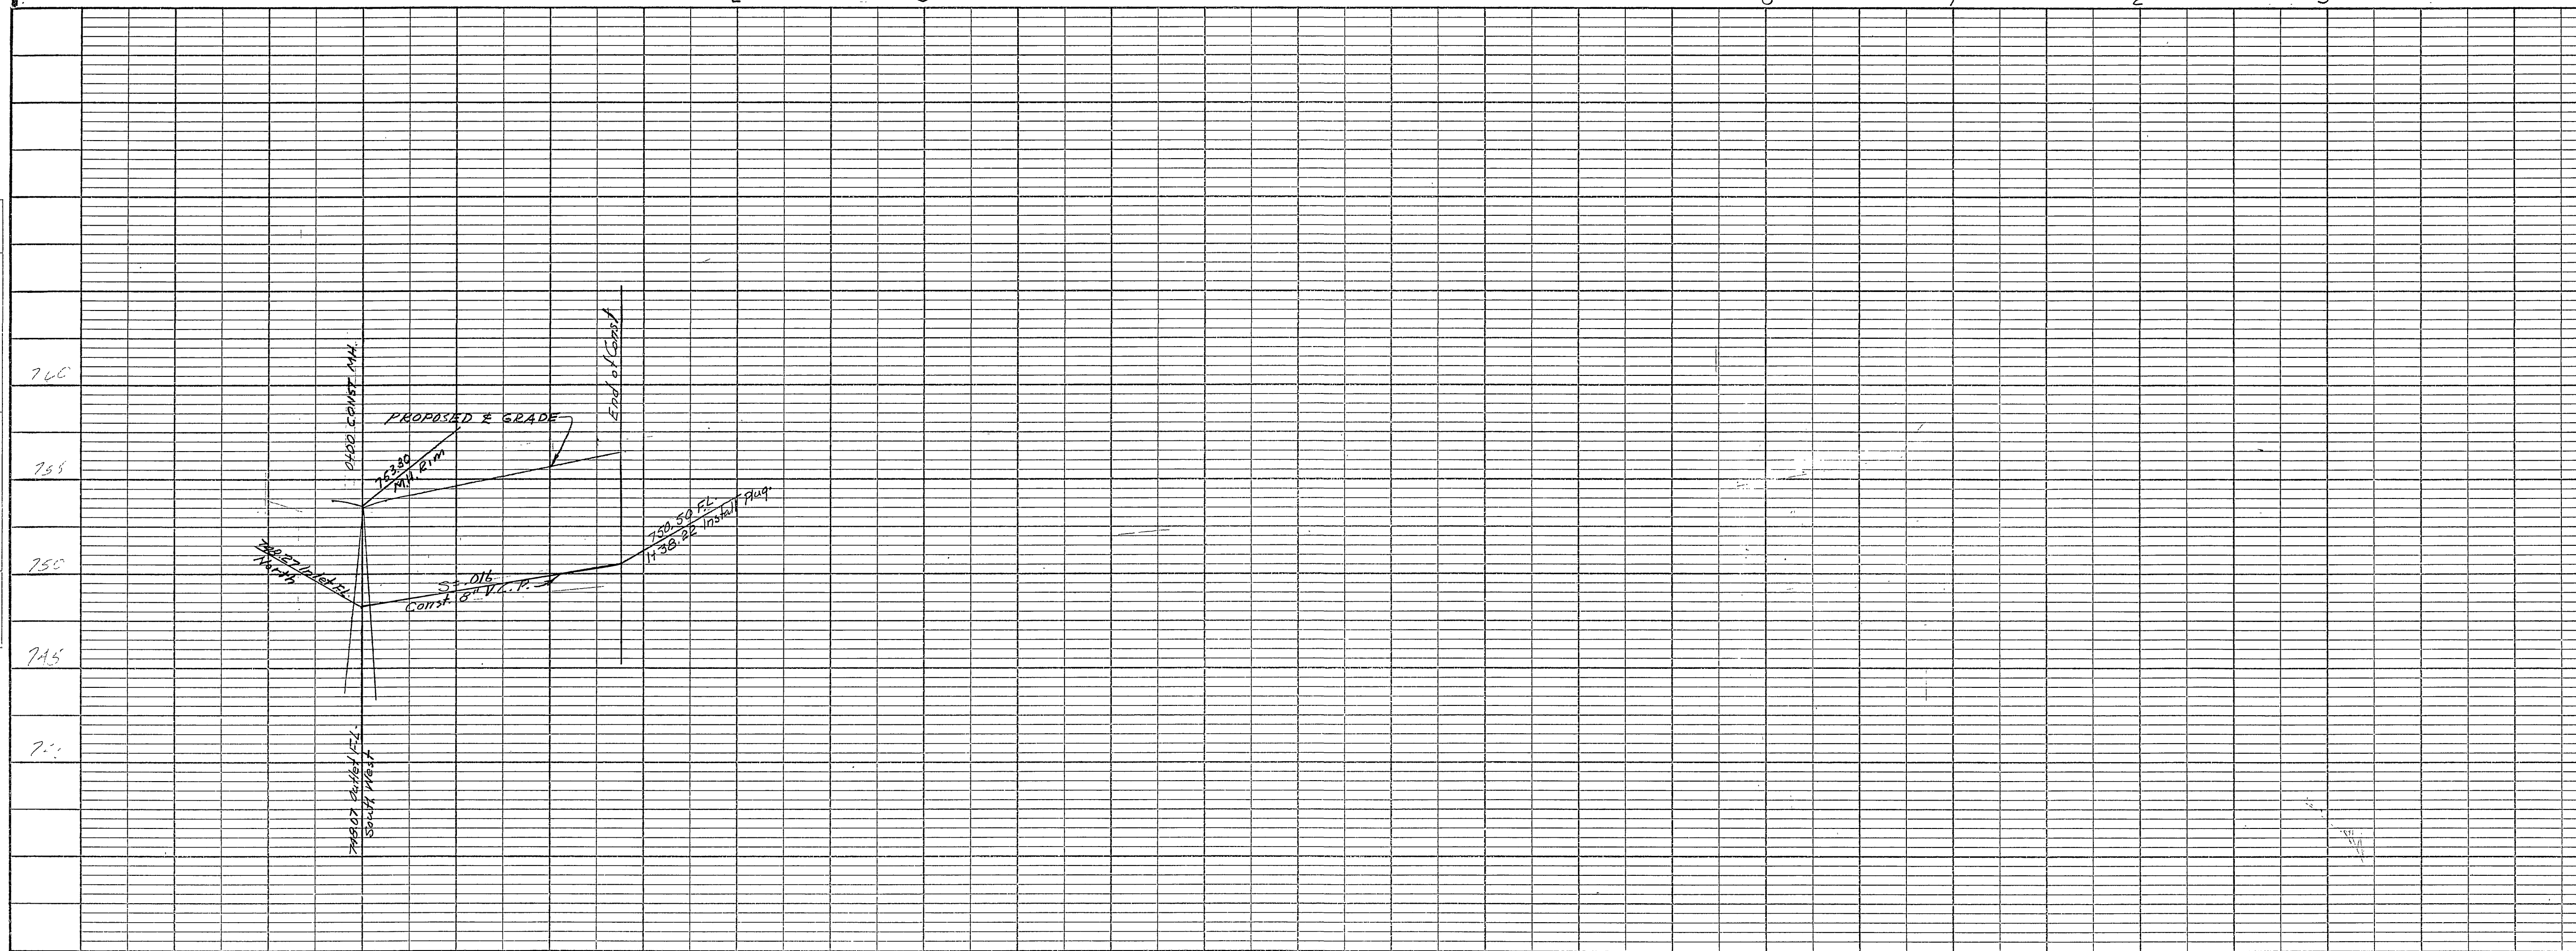

BENCHMARK: CROSSING ON WEST CURB OF PUTLAND AVE. WEST OF SOUTHWEST CORNER OF LOT 28 OF ARLANZA DOWNS SUB. #1 ELEVATION = 741.2 FEET
 SCALE: HOR: 1"=50' VERT: 1"=5'

PROPERTY OF
 COUNTY OF RIVERSIDE
 Office of the Road Commissioner