
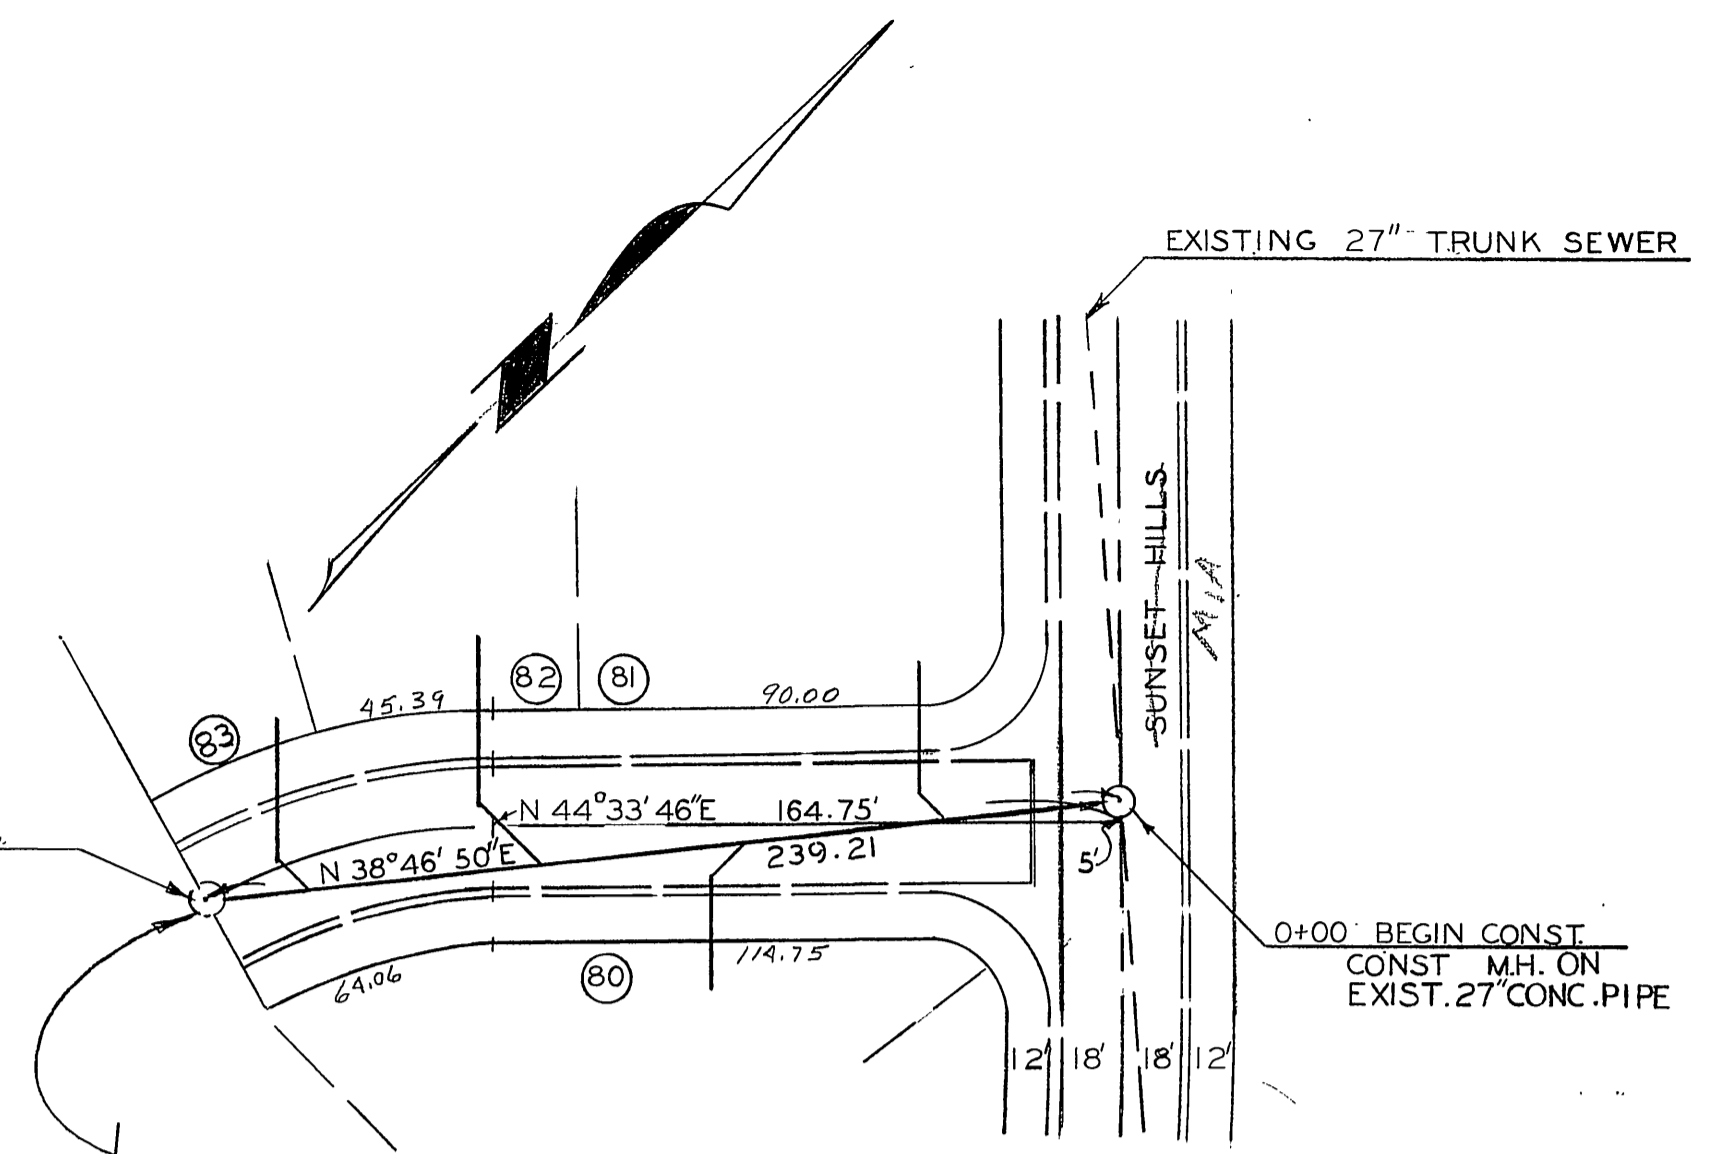
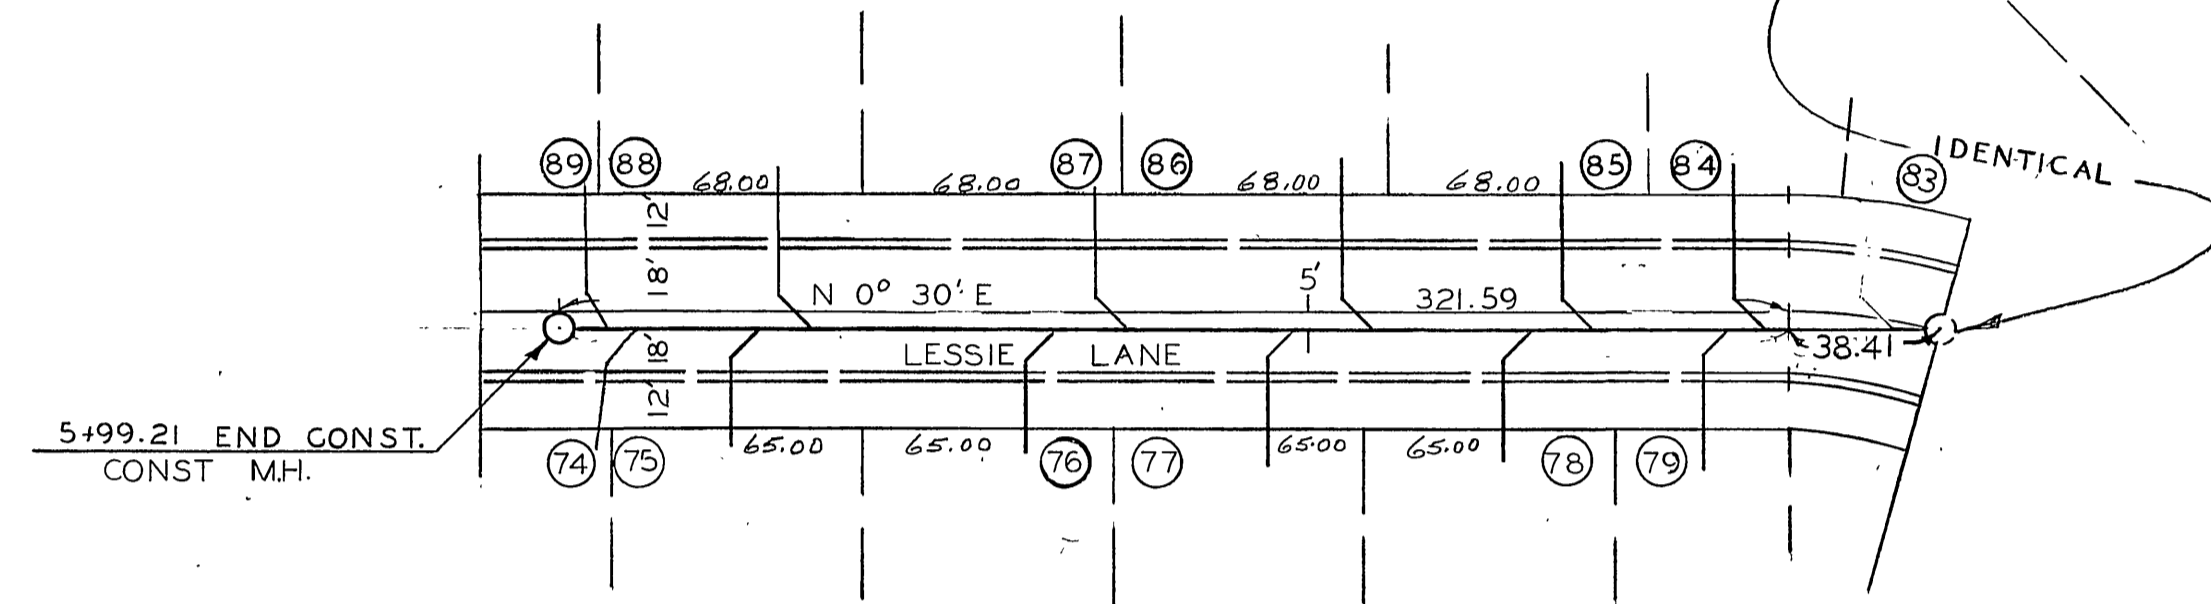


PLAN	DATE
BY	
SURVEYED	
ALIGNED	
CHECKED	
RT. OF WAY	
CHECKED	
NO.	

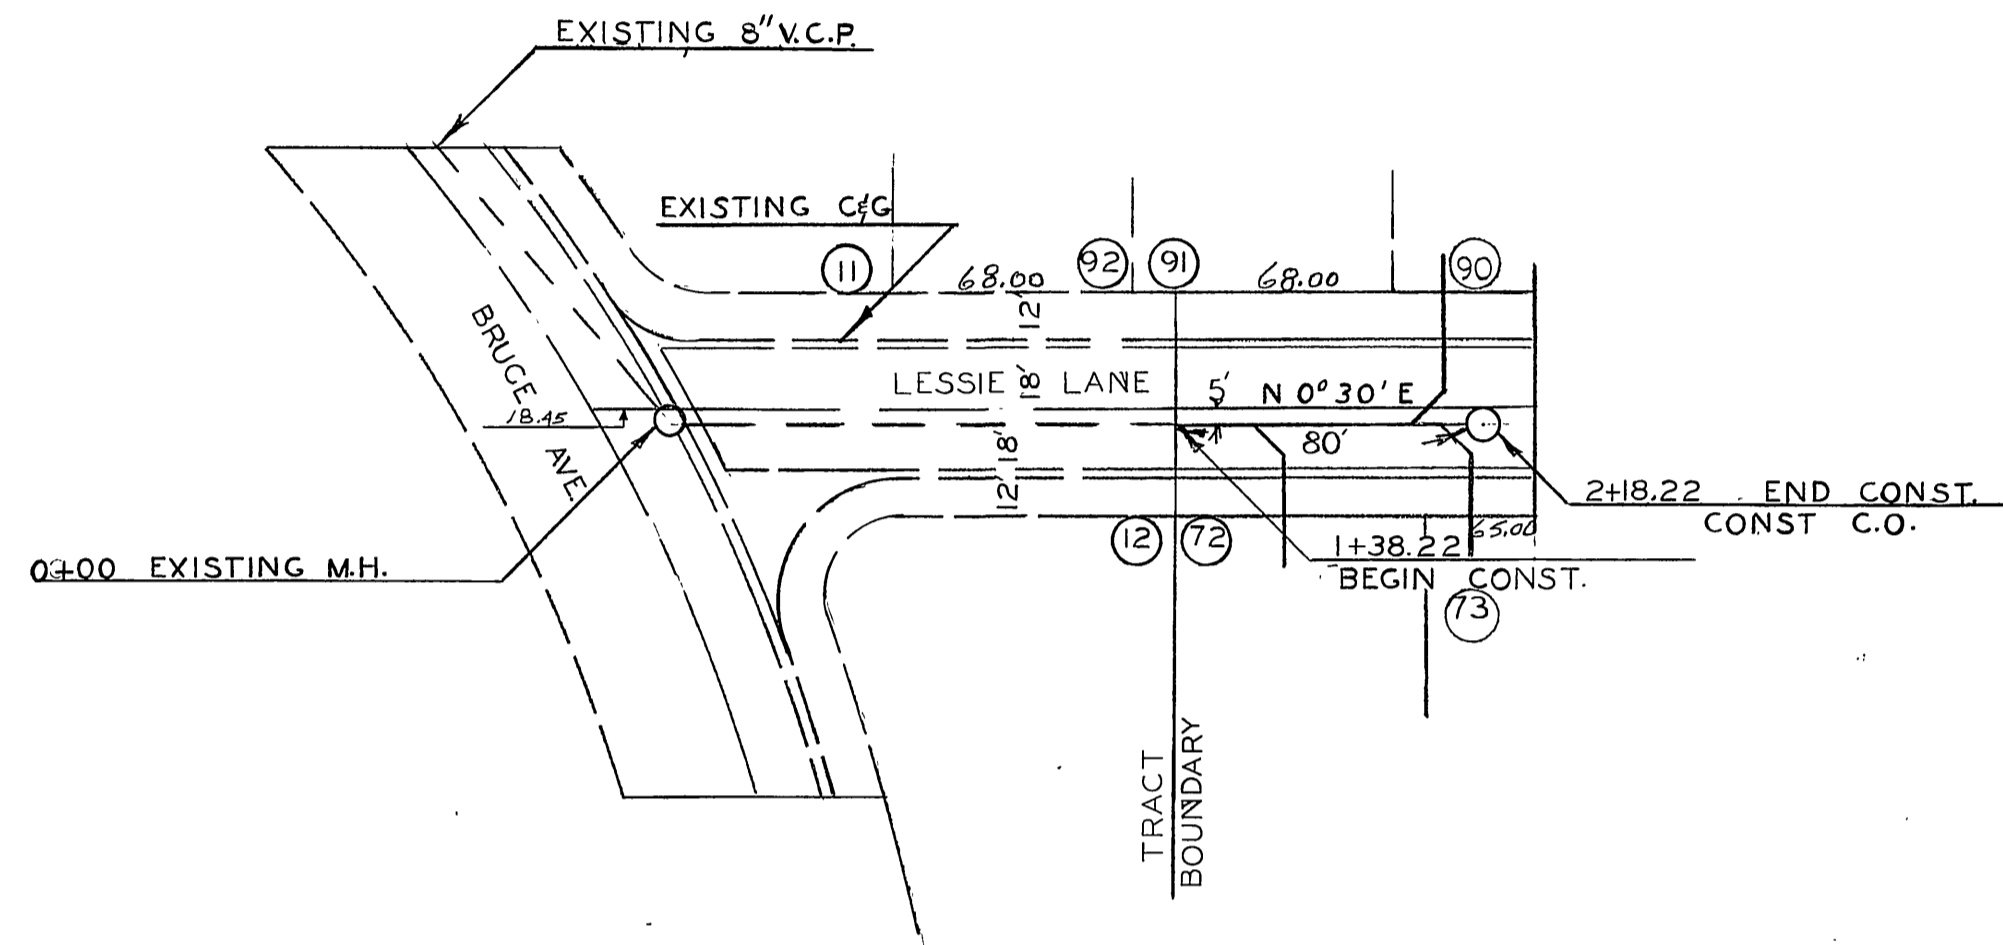


SEWER PLAN & PROFILE
LESSIE LANE

RIVERSIDE ENGINEERING CO.
RIVERSIDE, CALIFORNIA
FOR HALE COMPANY
MODEL SUBDIVISION UNIT 4
DRAWN BY ch CHECKED BY SCALE 1"=50'
DATE NOV 1957 REVISED
George O. Coulter CIVIL ENGINEER NO. 9455
JOB NO. 19.01 SHEET 1 OF 2


APPROVED
DATE 11-18-57
APPROVED
RIVERSIDE COUNTY HEALTH DEPARTMENT
BY J. B. Hawkins R.S.

PROFILE	DATE
BY	
SURVEYED	
GRADES	
CHECKED	
STRUCTURE	
NOTATIONS	
CHECKED	
NO.	

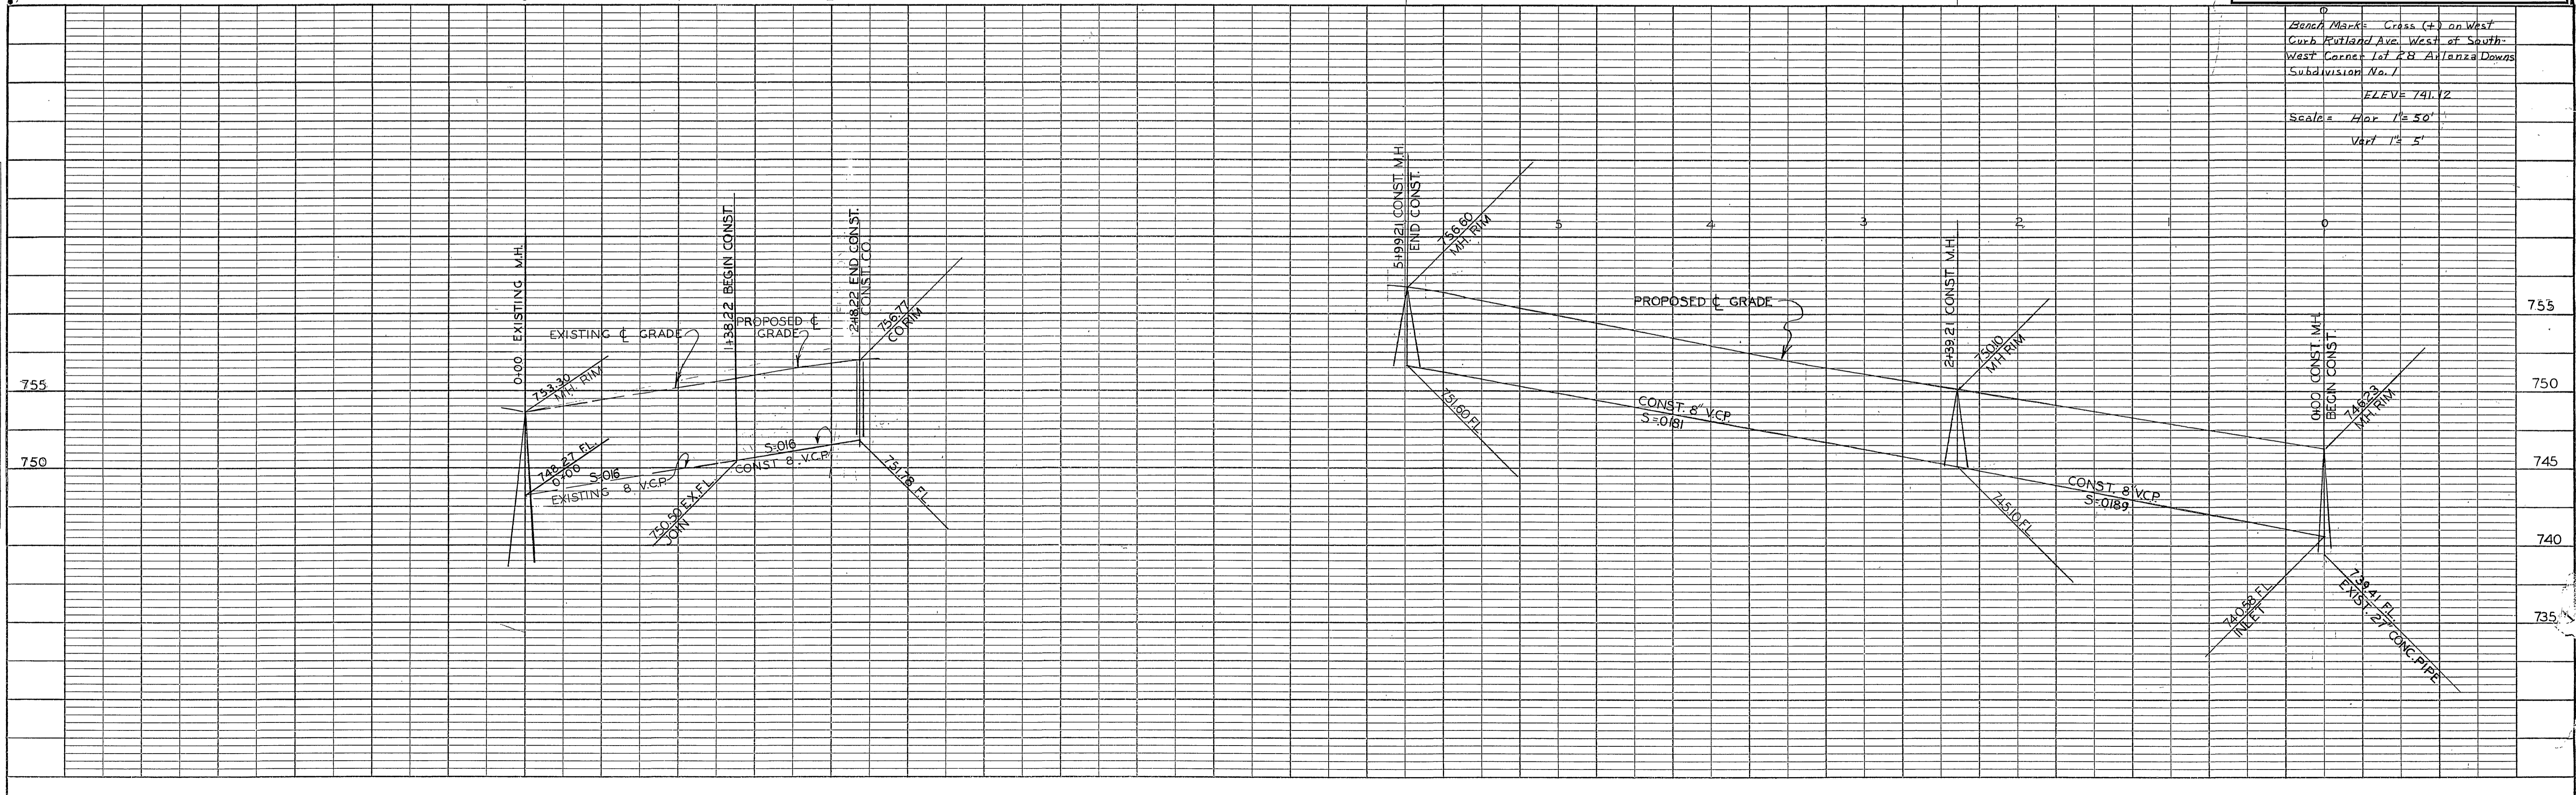

Manch Mark = Cross (x) on West
Curb Rutland Ave. West of South
West Corner Lot 28 Arlanza Downs
Subdivision No. 1
ELEV 741.72
Scale: Hor 1"=50'
Vert 1"=5'

PLAN
 SURVEYED
 PLOTTED
 ALIGNMENT CHECKED
 RT. OF WAY CHECKED
 NO.

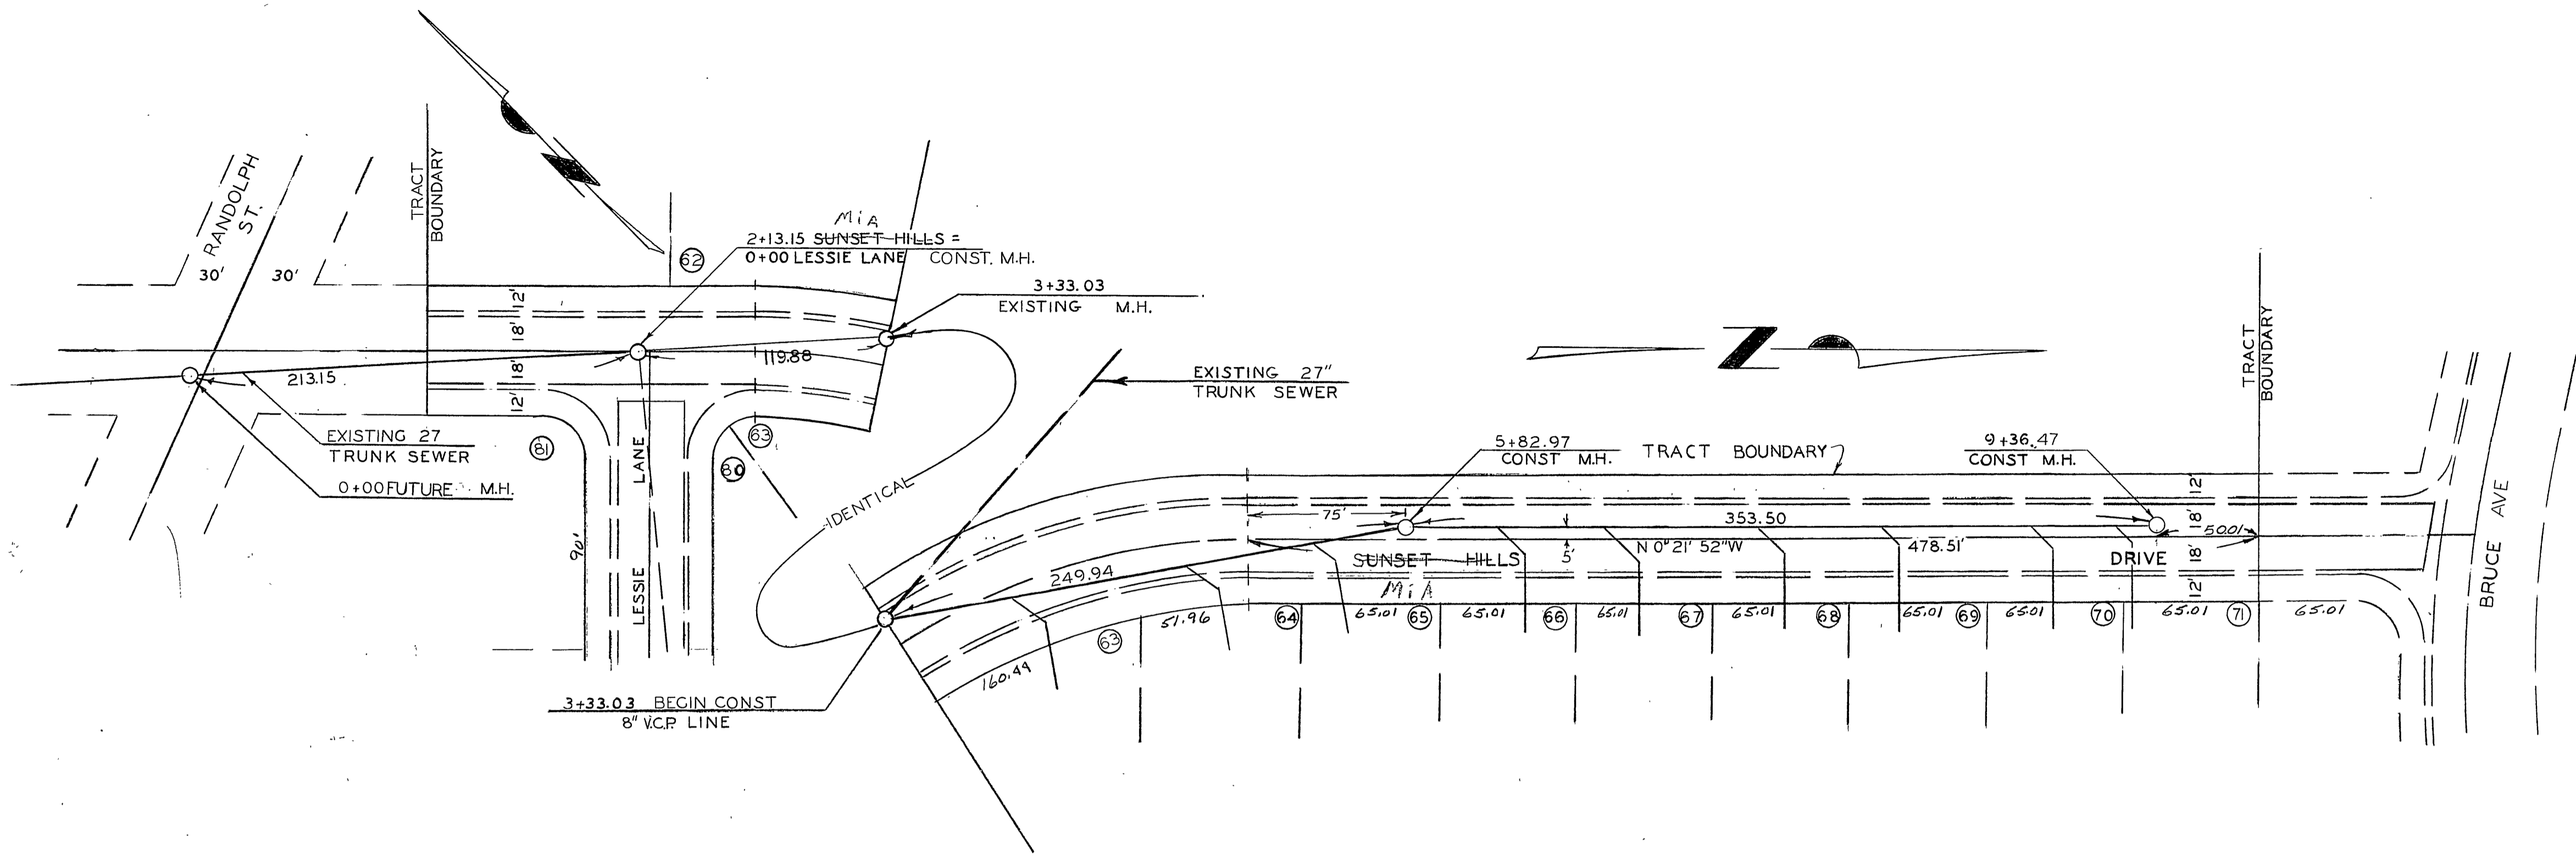


SEWER PLAN & PROFILE
 SUNSET HILLS DRIVE
 MIA

RIVERSIDE ENGINEERING CO.
 RIVERSIDE, CALIFORNIA
 FOR HALE COMPANY
 MODEL SUBDIVISION UNIT 4
 DRAWN BY & CHECKED BY SCALE 1"=50'
 DATE NOV 1957 REVISED
 George O. Crawley CIVIL ENGINEER #2455
 BY Mrs. Hawthorn R.S.
 JOB NO. 1901 SHEET 2 OF 2

DATE 11-19-57
 APPROVED Sewer line layout & velocities
 RIVERSIDE COUNTY HEALTH DEPARTMENT
 BY Mrs. Hawthorn R.S.

PROFILE
 SURVEYED
 PLOTTED
 GRADES CHECKED
 STRUCTURE NOTATIONS CHECKED
 NO.

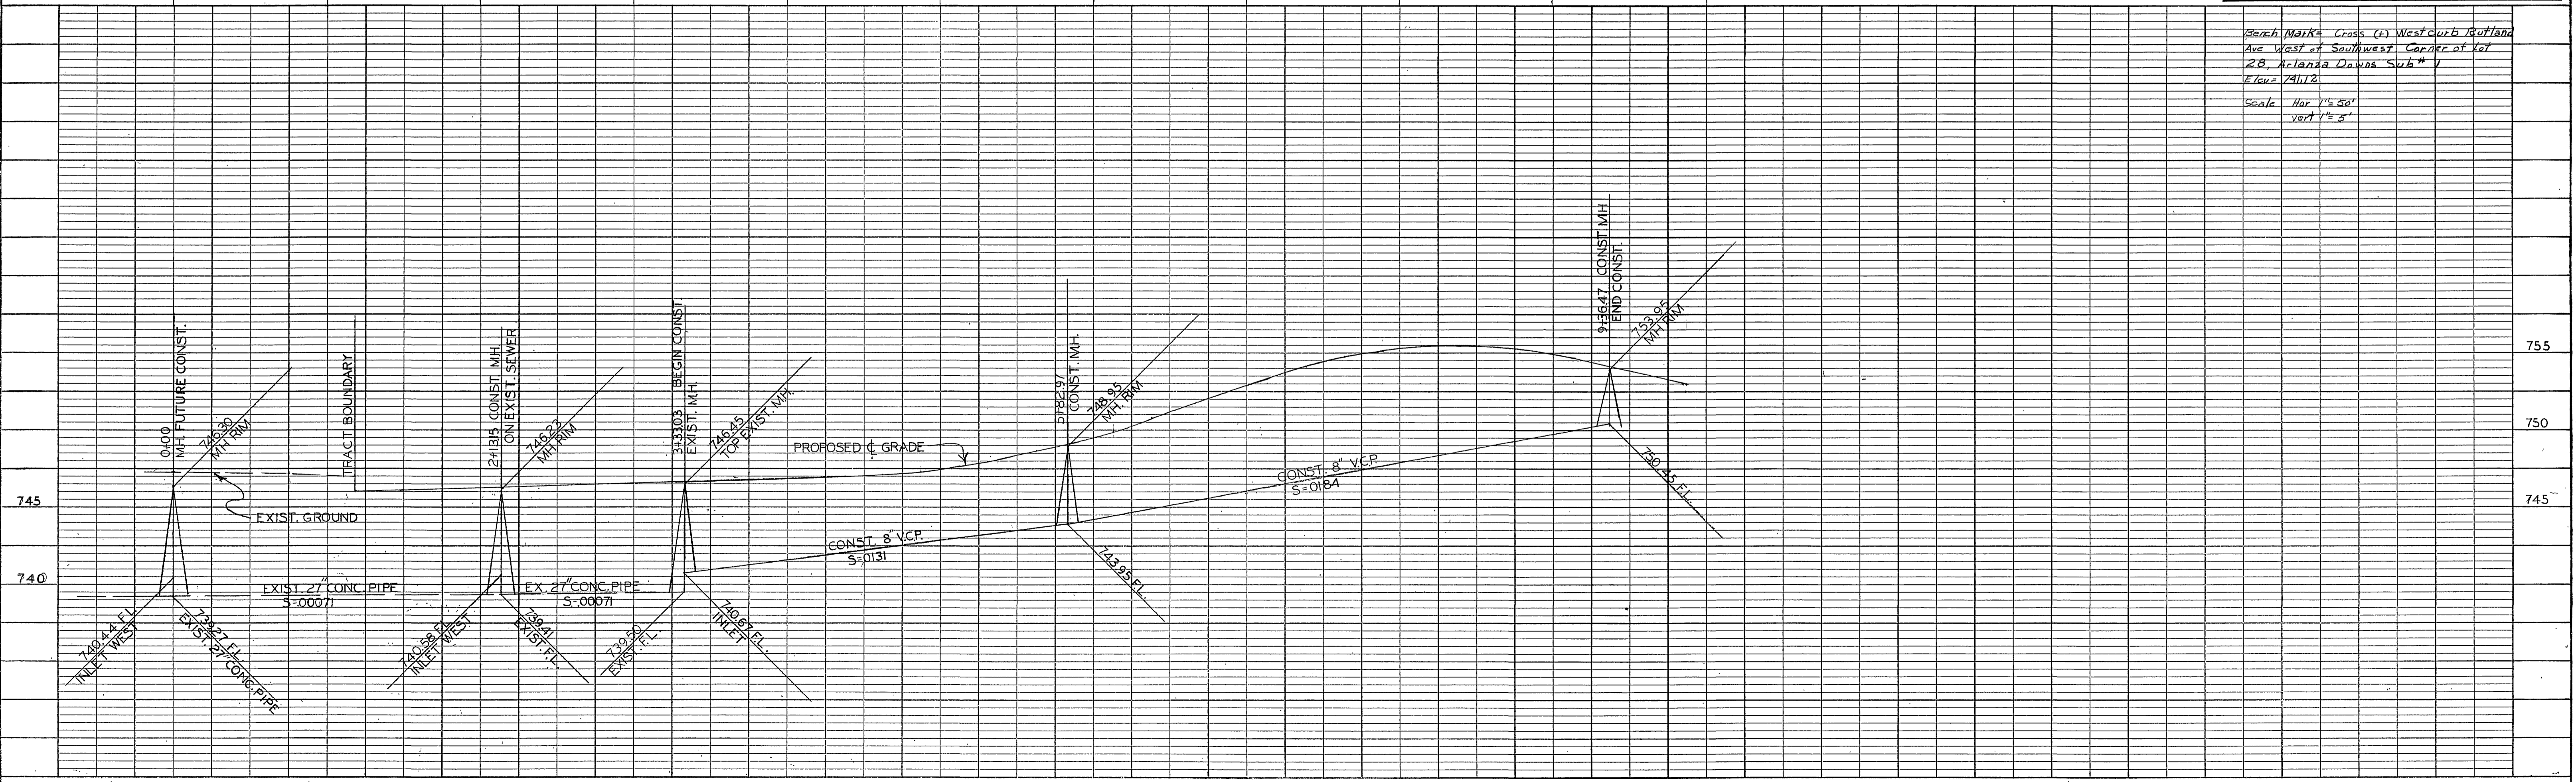

Beach Marks Cross (+) West curb Rutland Ave West of Southwest Corner of Lot 28, Arlanza Downs Sub # 1
 E.lev. 741.12
 Scale Hor 1"=50'
 Vert 1"=5'