


PLAN	DATE
BY	
SURVEYED	
NOTE BOOK	
ALIGNED CHECKED	
RT. OF WAY CHECKED	
NO.	

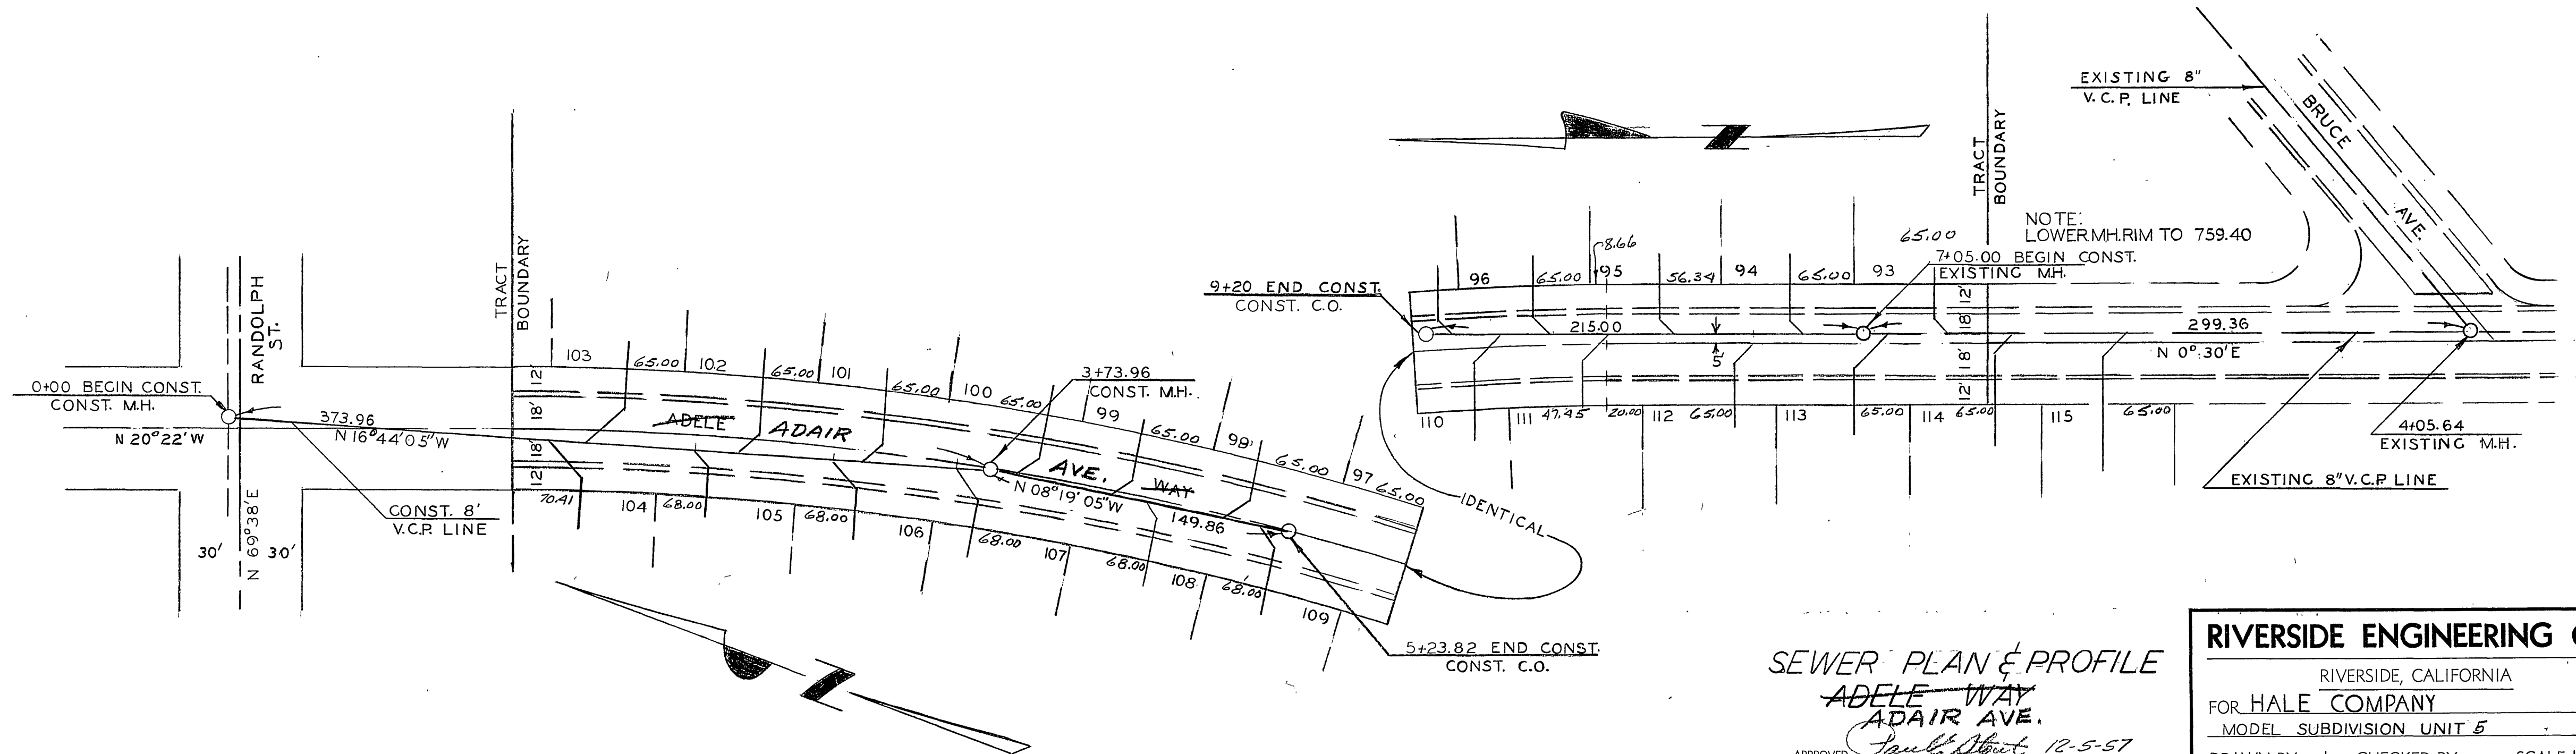


SEWER PLAN & PROFILE
ADELE WAY
ADAIR AVE.

DATE 11-27-57
 APPROVED: *Paul H. Stout* 12-5-57
 by Road Commission
 Riverside County
 APPROVED: *George C. Crawley*
 CIVIL ENGINEER NO. 9455
 RIVERSIDE COUNTY HEALTH DEPARTMENT
 BY: *W. H. ...*

RIVERSIDE ENGINEERING CO.
 RIVERSIDE, CALIFORNIA
 FOR HALE COMPANY
 MODEL SUBDIVISION UNIT 5
 DRAWN BY _____ CHECKED BY _____ SCALE 1" = 50'
 DATE NOV. 12, 1957 REVISED _____
George C. Crawley CIVIL ENGINEER NO. 9455
 JOB NO. 2012 SHEET 1 OF 1

PROFILE	DATE
BY	
SURVEYED	
NOTE BOOK	
GRADES CHECKED	
B. M. & NOTED	
STRUCTURE NOTATIONS CHECKED	
NO.	

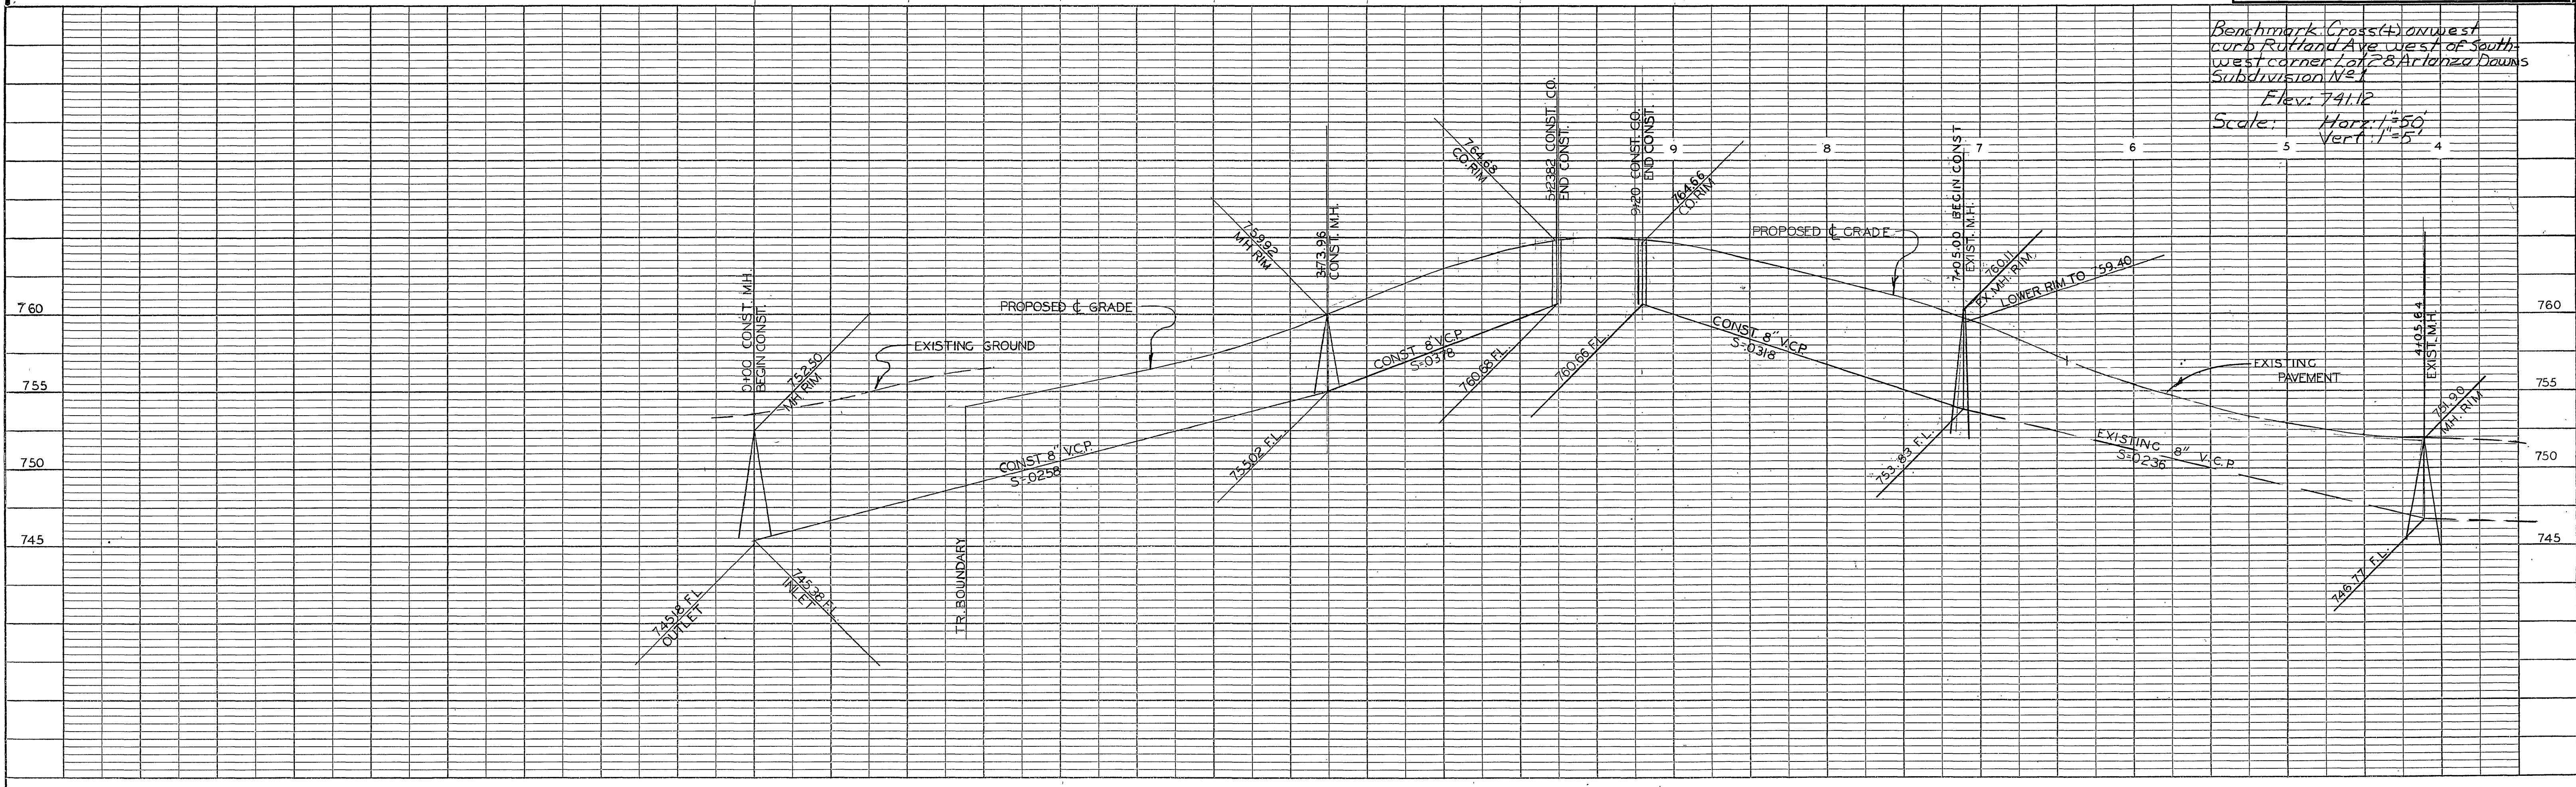

Benchmark Cross-tie on west curb Rutland Ave. west of south west corner Lot 28 Arlanza Downs Subdivision No. 1
 Elev: 741.12
 Scale: Horiz. 1" = 50'
 Vert. 1" = 5'

S-315729-G