



HOR.: 1" = 40'
 VERT.: 1" = 4'

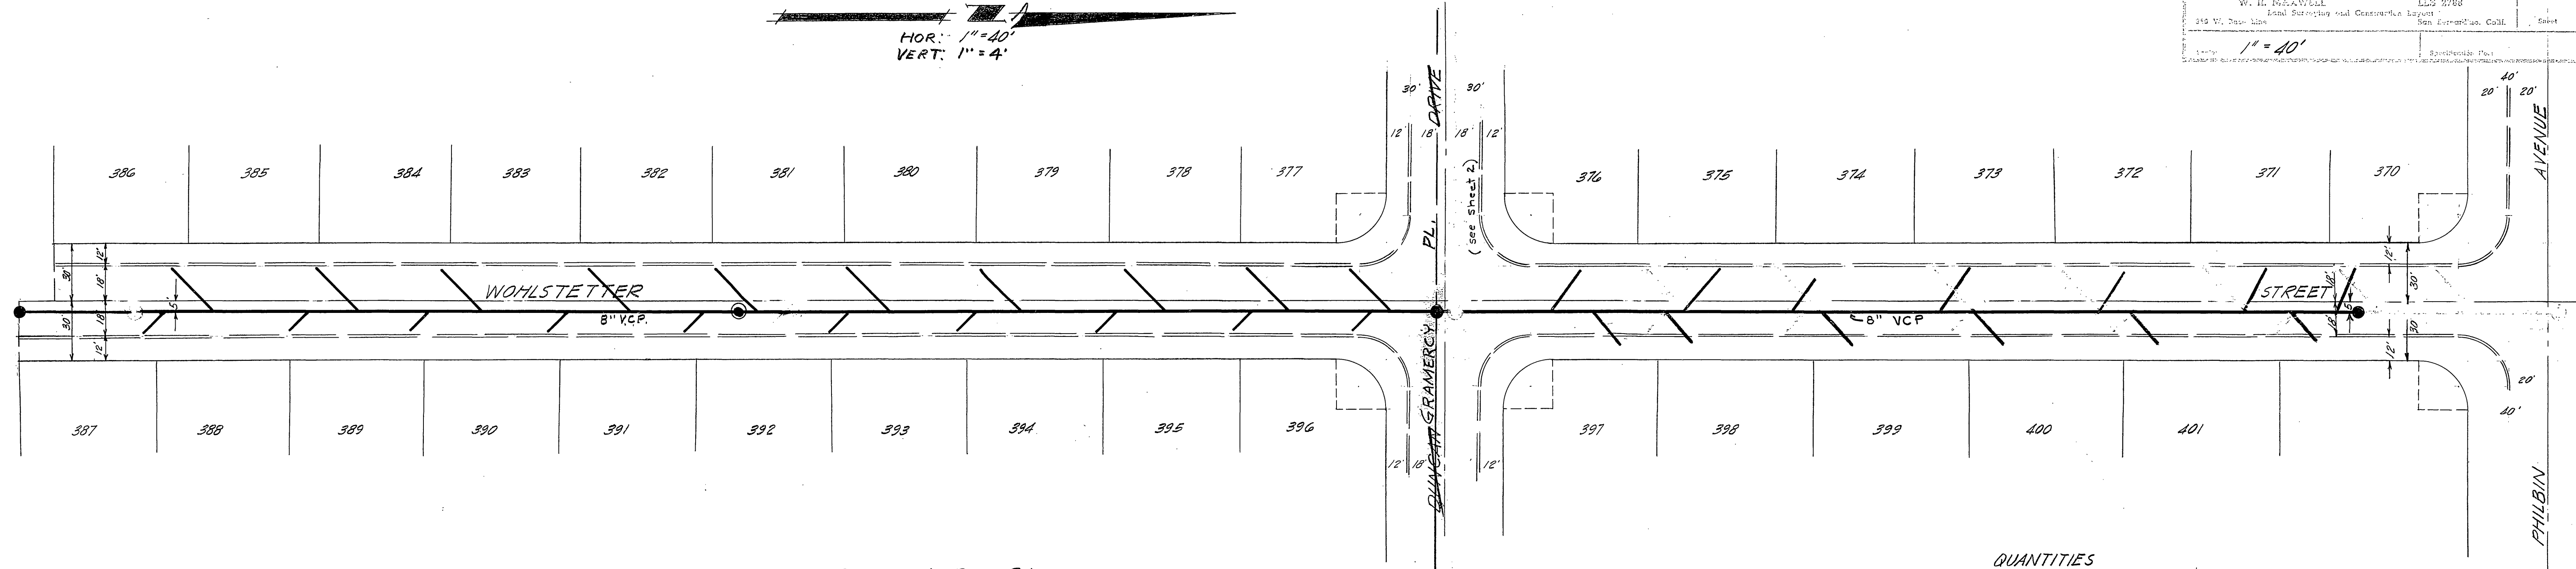


Bench Mark R.R. Spike in Power Pole
 N.E. Corner Philbin & Wohlstetter
 Elevation = 737.91'


QUANTITIES
 1492' Feet 8" V.C.P.
 32 Wyes
 360 Feet 4" V.C.P.
 2 Cleanouts
 3 Manholes

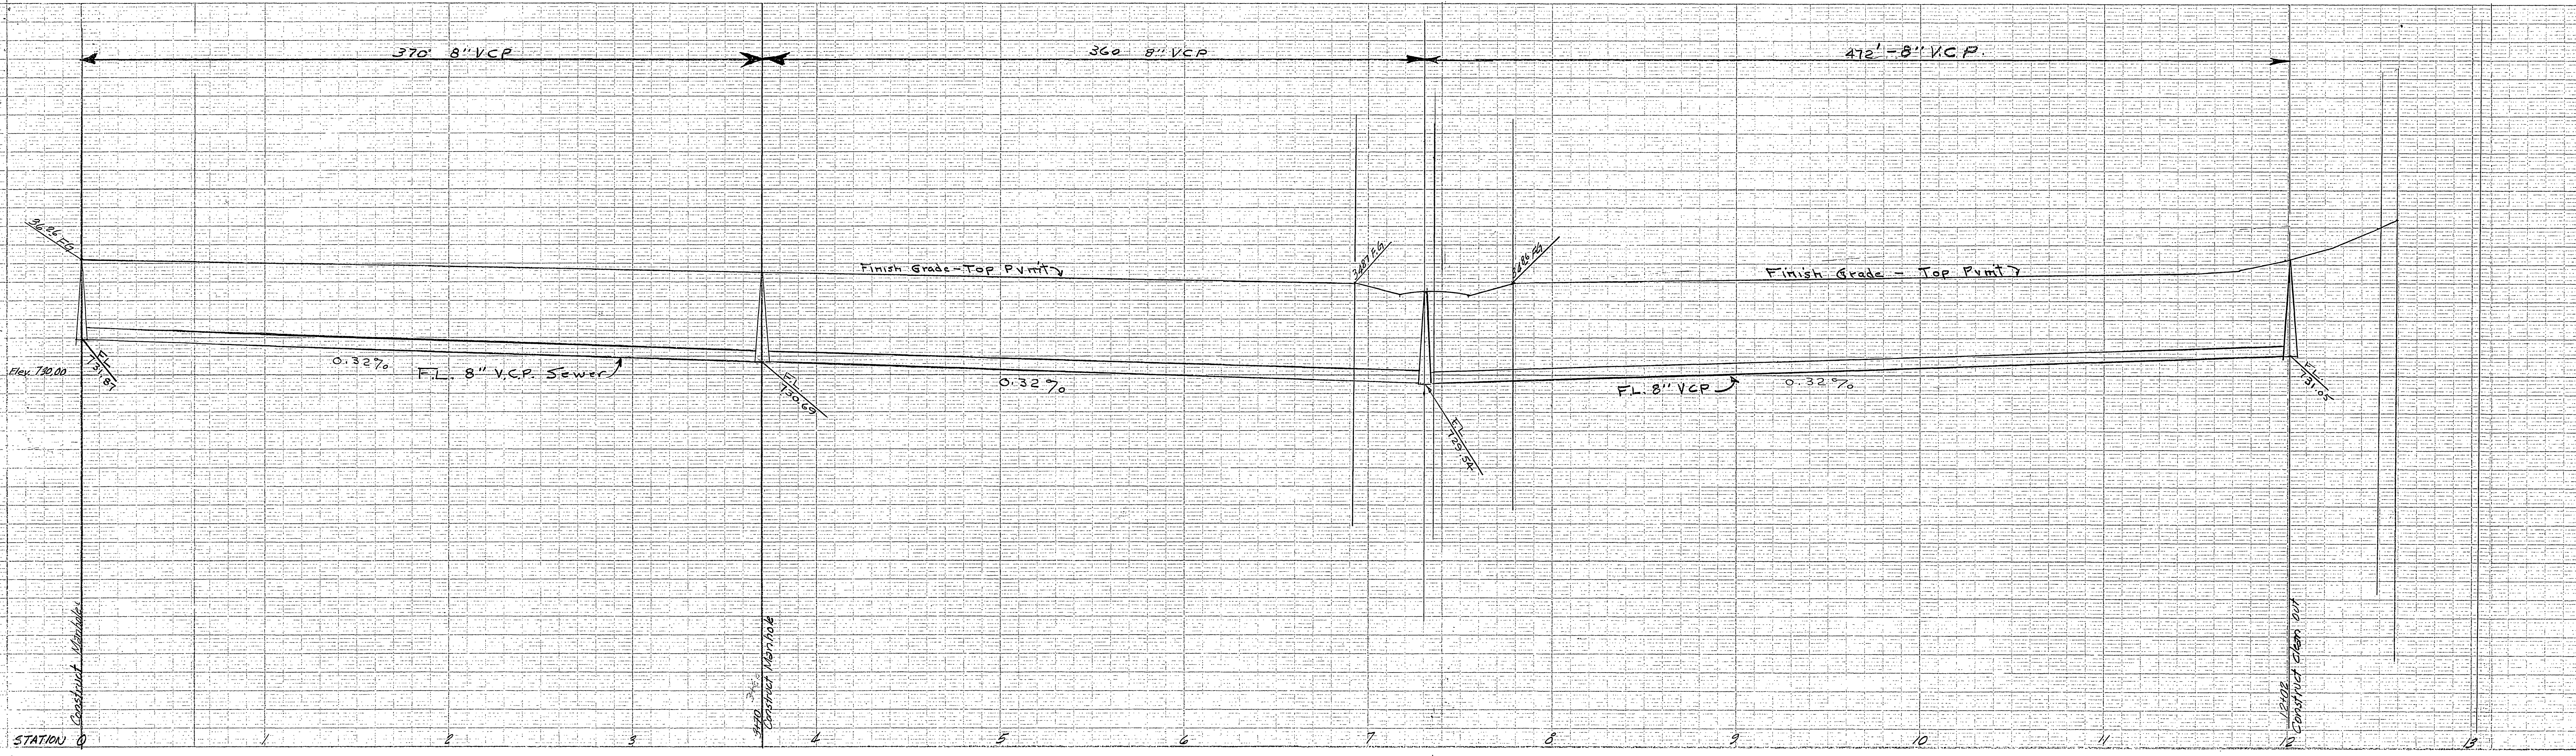

425.01
 PL. @
 PICKET

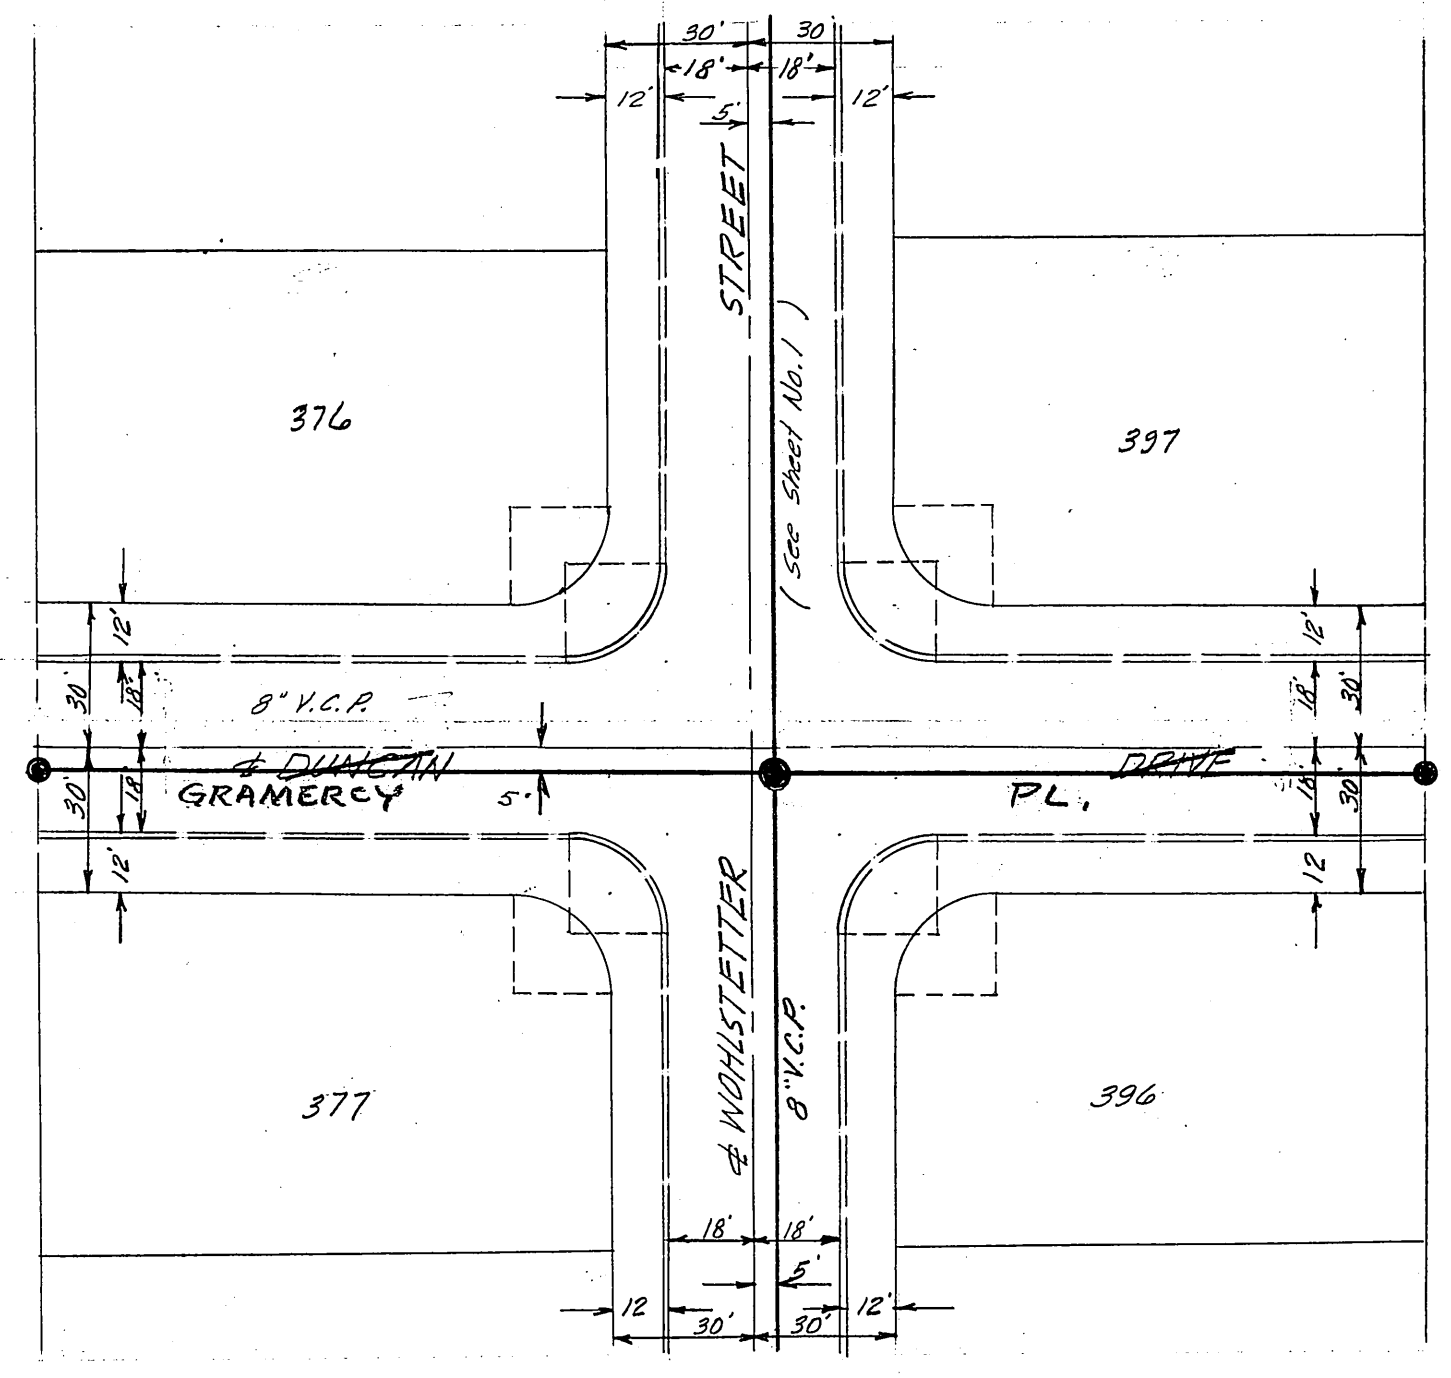

Scale:
 Horiz. 1"=40'
 Vert. 1"=4'

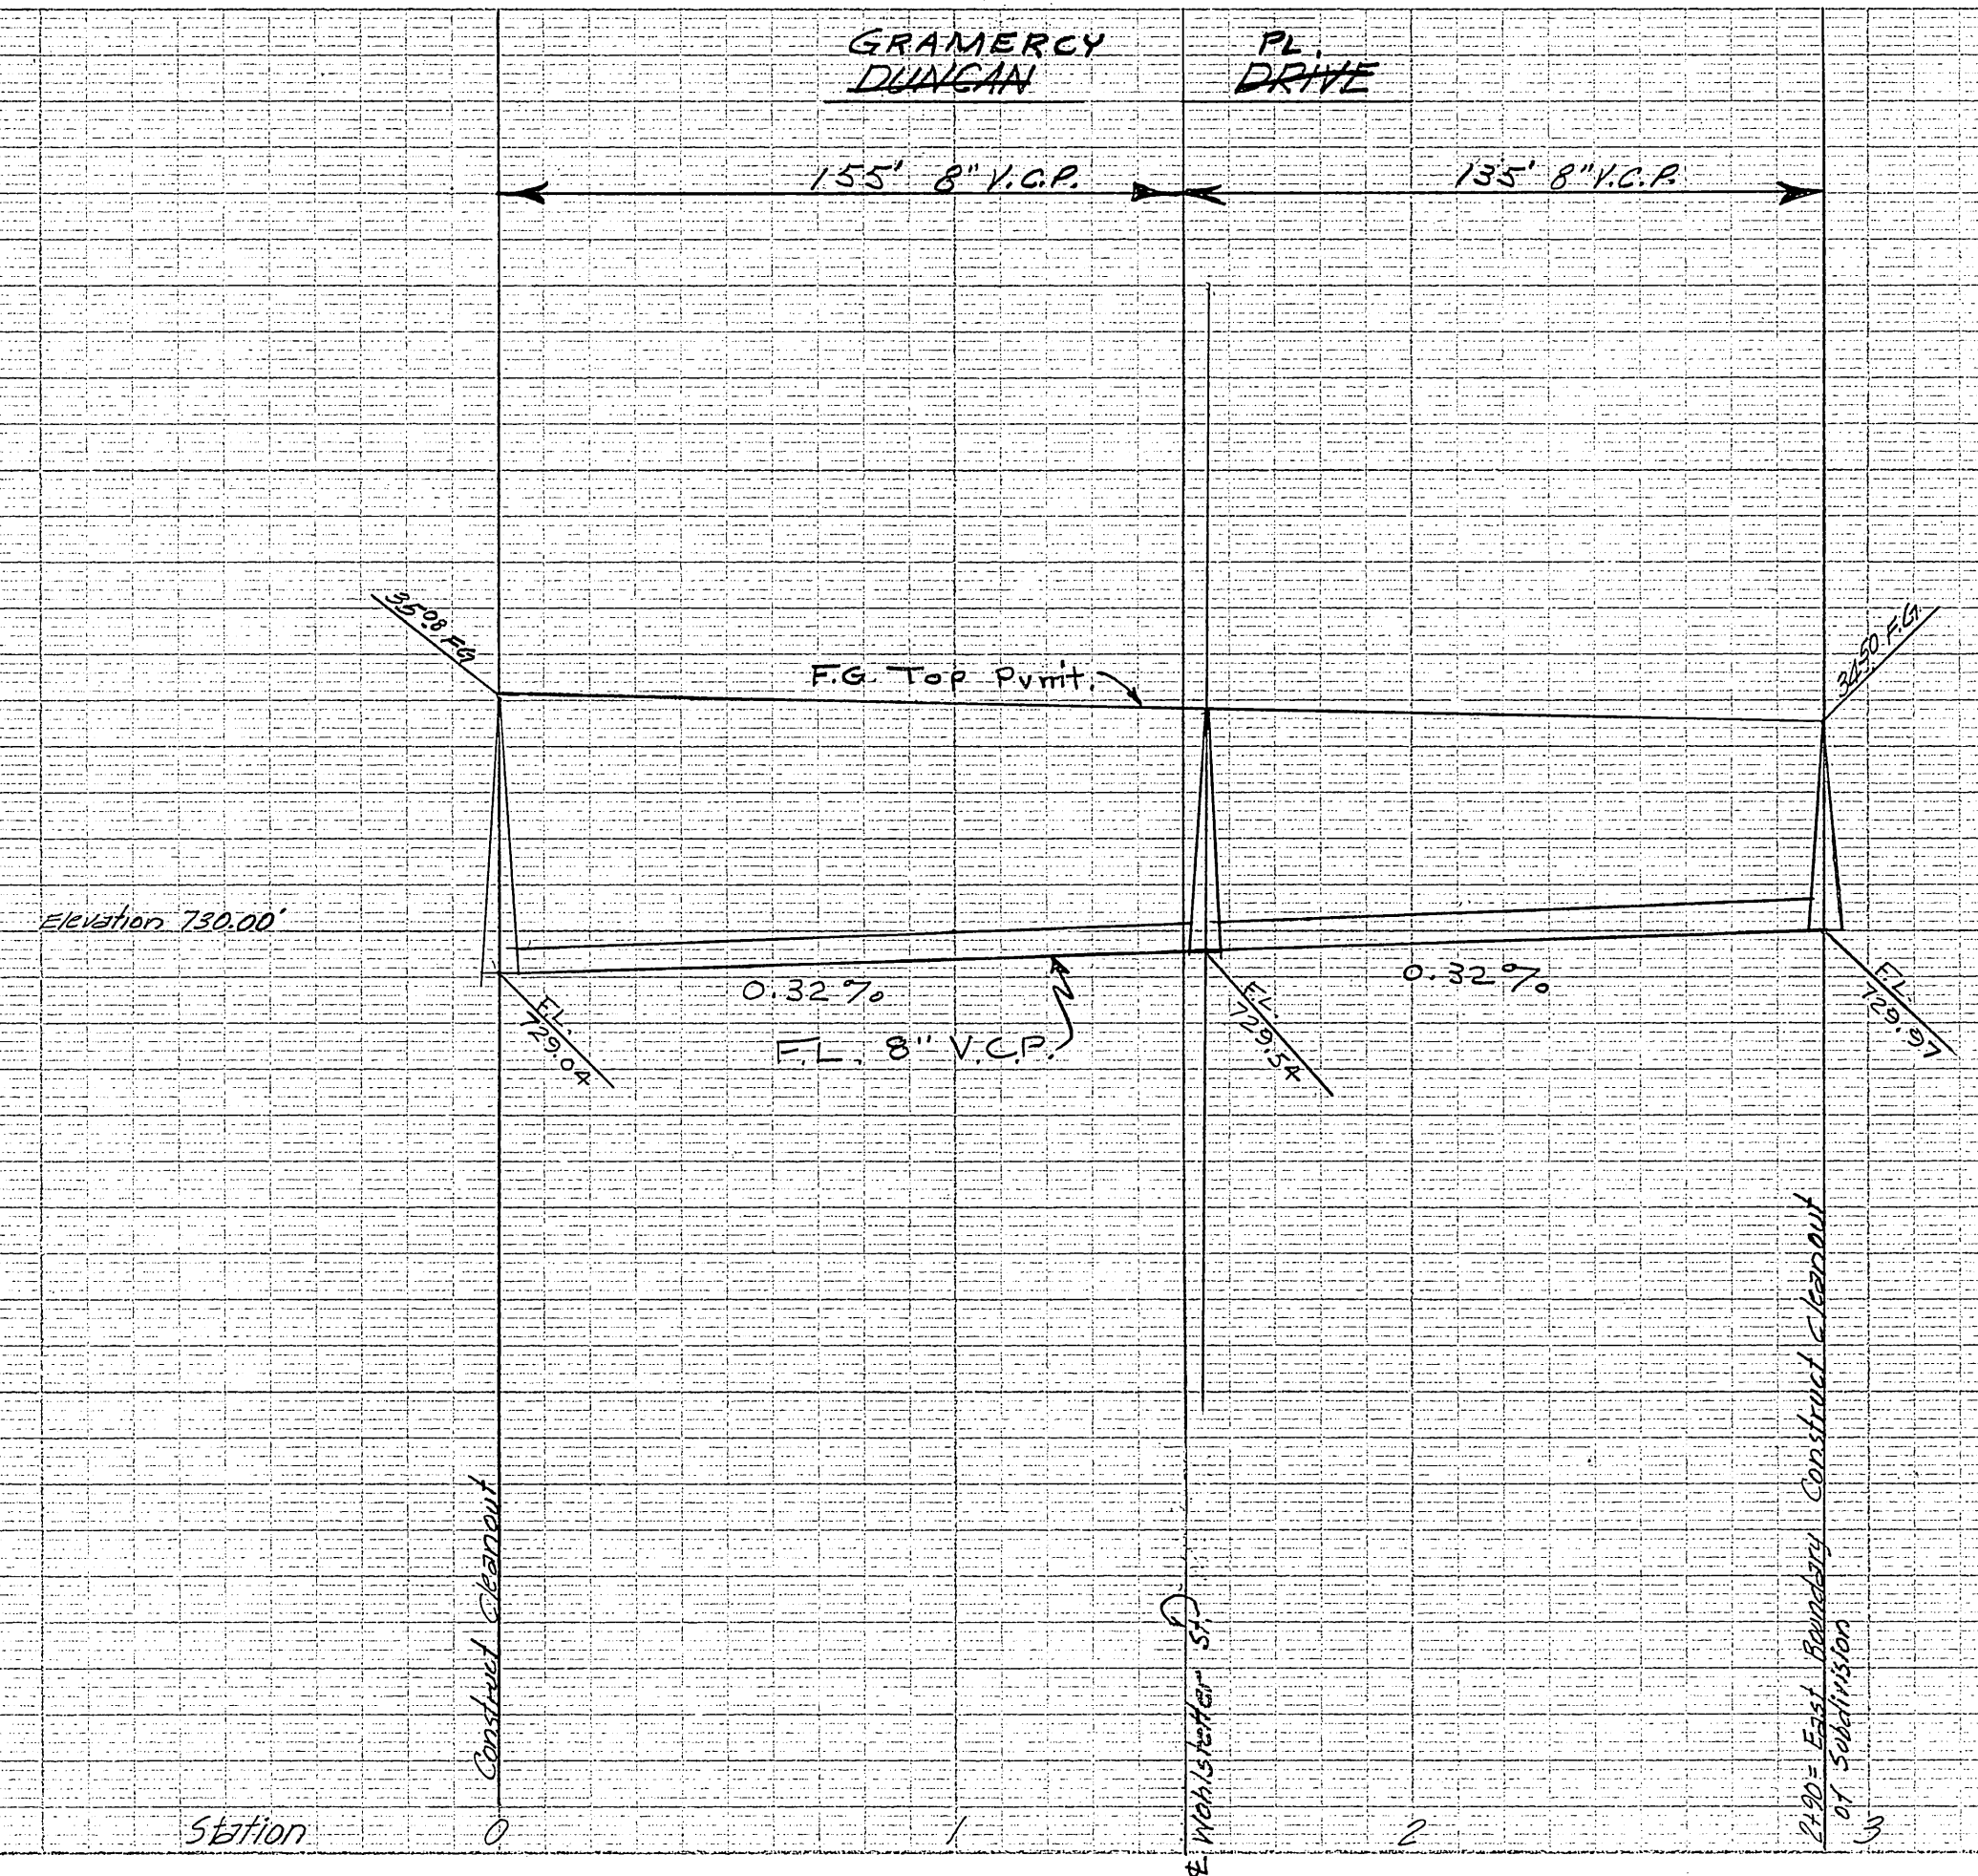

~~R-560~~
 S-318
 730-I
 SH. 2 OF 2