

S.D. #4
SEWER MAP
LARRY'S COPY



SEWER LOCATION MAP

SIERRA DOWNS

TRACT NO. 4

BEING A SUBDIVISION OF LOT 5, BLOCK 37,
LOT 6, BLOCK 38, LOTS 3, 4, 14, 15, 17, 18,
BLOCK 36 AND LOTS 1 AND 2, BLOCK 35,
LA GRANADA TRACT AS RECORDED IN BOOK 12,
PAGES 42 TO 51 OF MAPS, RECORDS OF


PIYERSIDE COUNTY, CALIF.
W. R. MAXWELL, SURVEYOR MARCH 1958
SCALE 1" = 60'

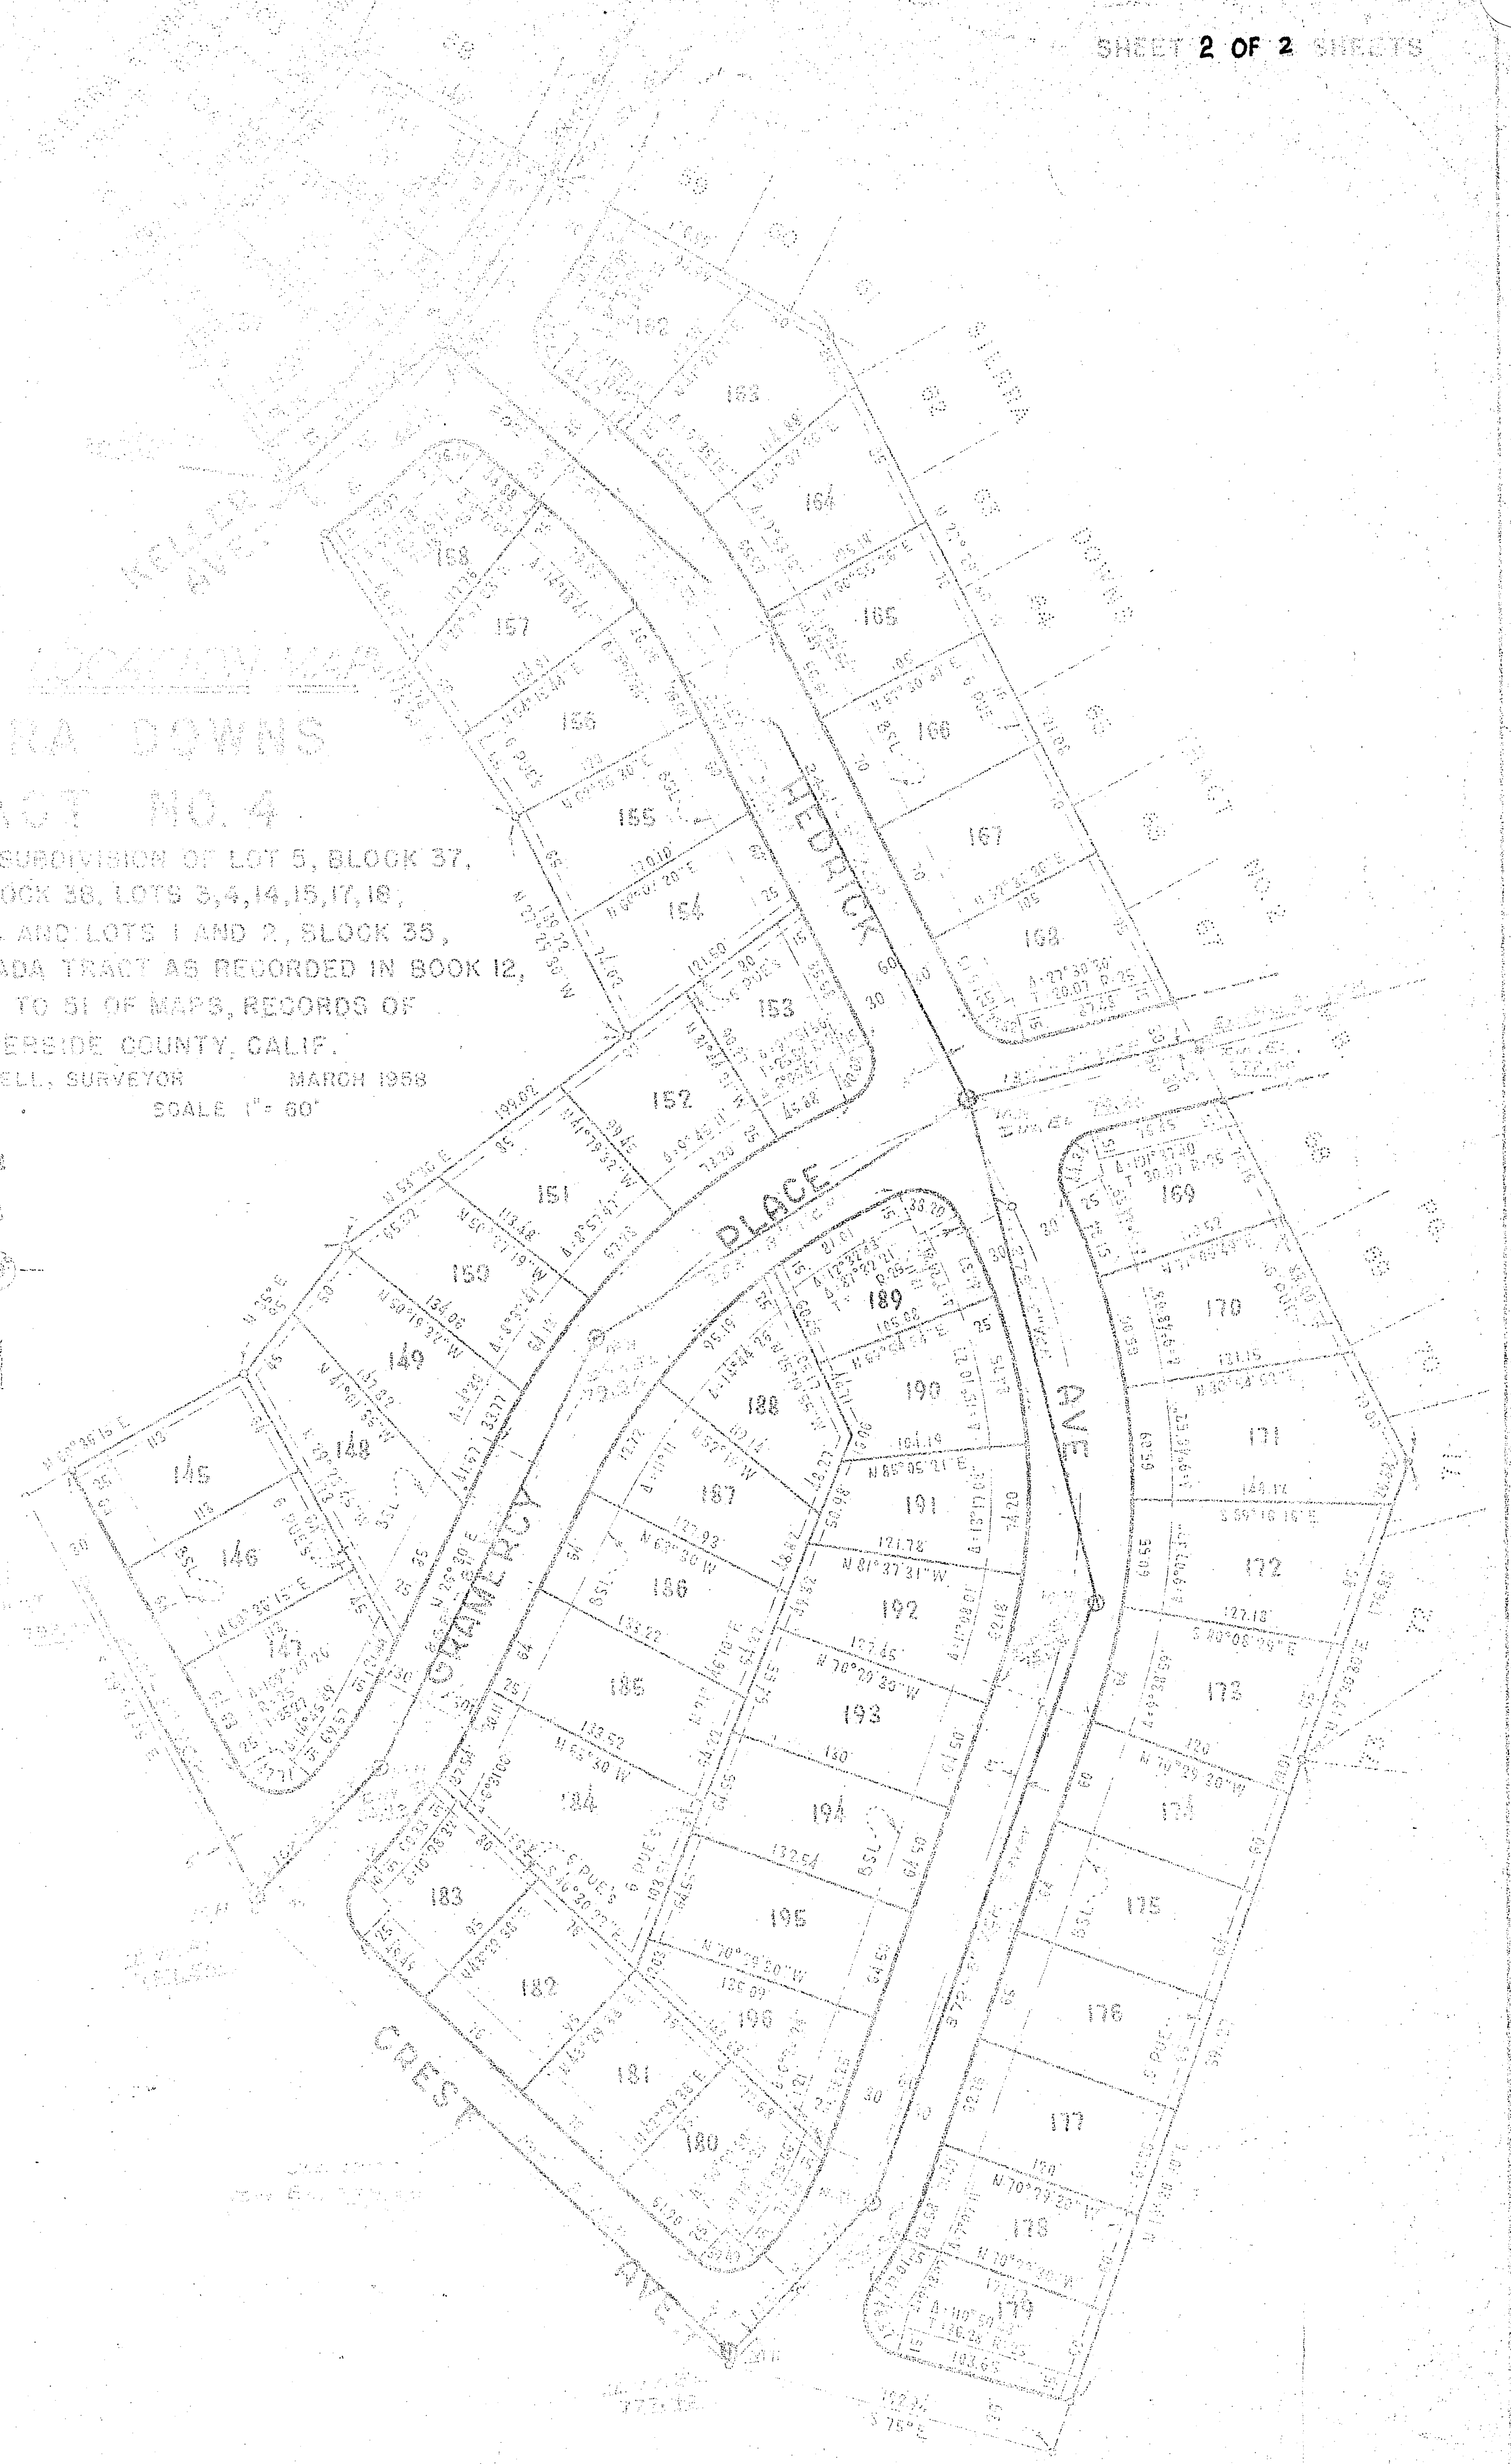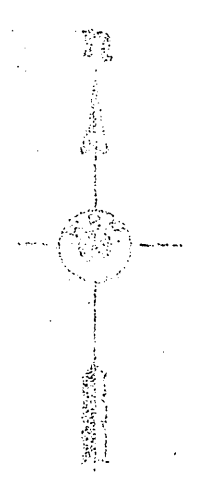

S-330A

~~0447~~

S.D.#4

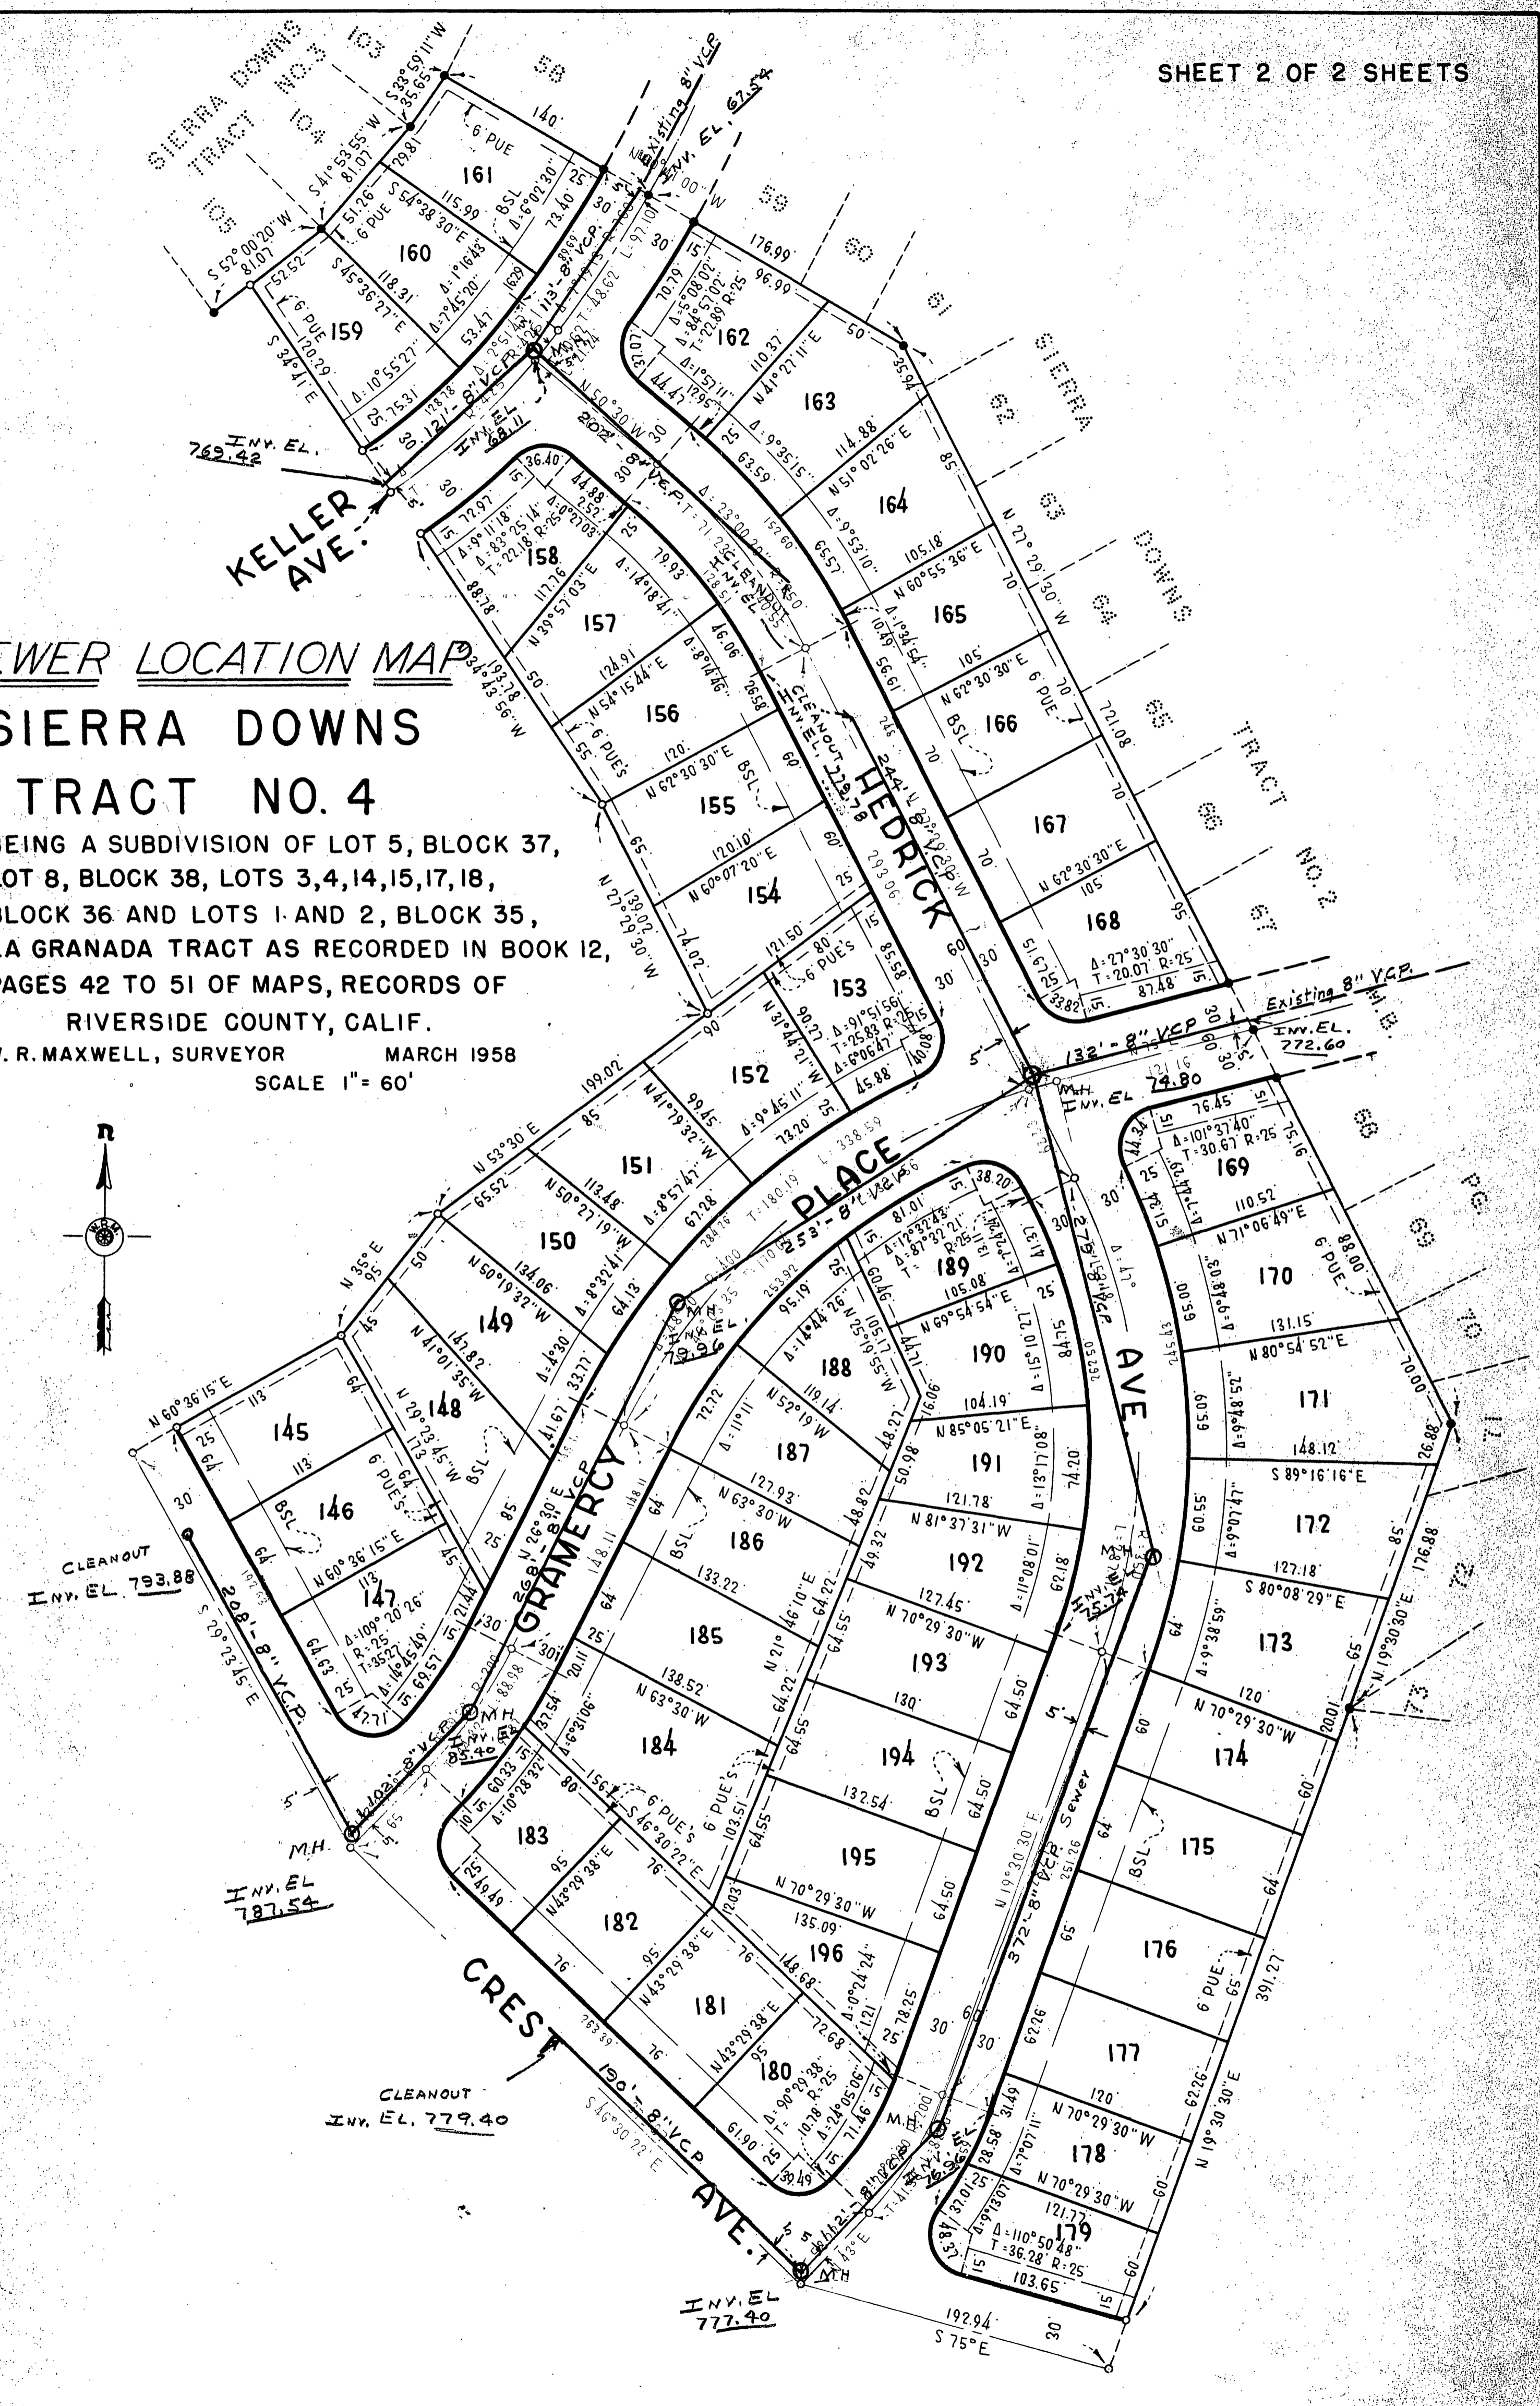


SEWER LOCATION MAP

SIERRA DOWNS TRACT NO. 4

BEING A SUBDIVISION OF LOT 5, BLOCK 37, LOT 8, BLOCK 38, LOTS 3,4,14,15,17,18, BLOCK 36 AND LOTS 1 AND 2, BLOCK 35, LA GRANADA TRACT AS RECORDED IN BOOK 12, PAGES 42 TO 51 OF MAPS, RECORDS OF RIVERSIDE COUNTY, CALIF.

W. R. MAXWELL, SURVEYOR MARCH 1958
SCALE 1" = 60'

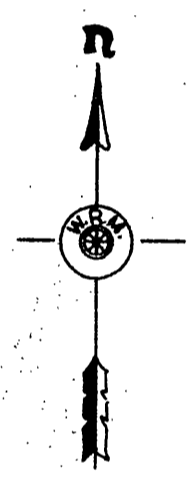

S-330A