


SIERRA FOOTBALL NO. 11
SEWER PLAN & PROFILE
CROWELL ST. - CORWIN LN.

W. K. MAXWELL Lic. Surveyor No. 1242 (California)		L. R. STUBBS Lic. Engineer No. 1242 (California)	
HOR. 1" = 40'		VERT. 1" = 4'	

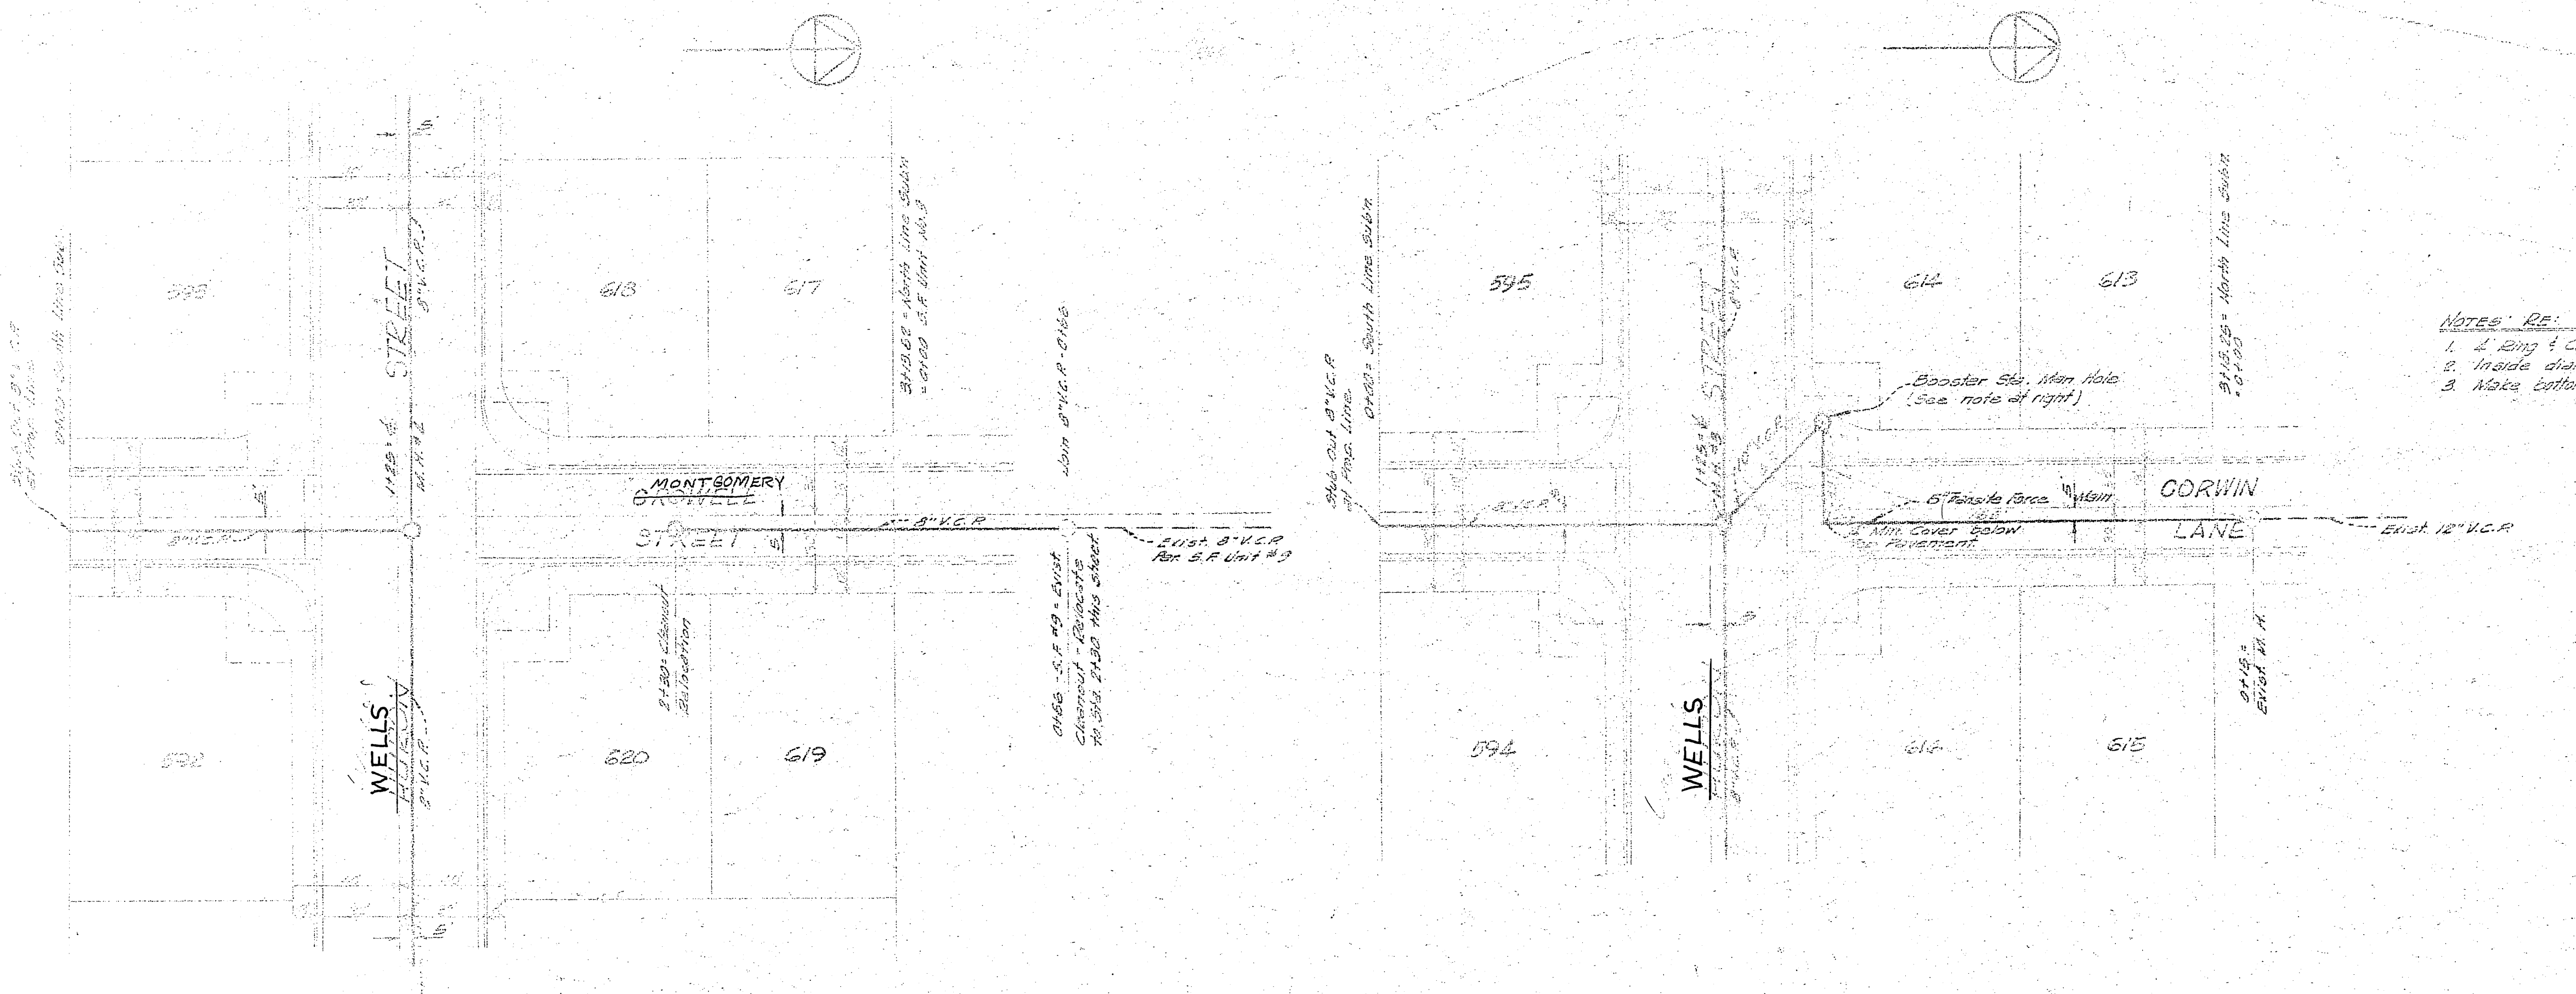

Notes Re: Booster Station Man Hole
 1. 2 Ring & Cover (Alhambra or equal)
 2. Inside diam. of 6"
 3. Make bottom of Man Hole flat

ESTIMATE OF QUANTITIES


1.	8" V.C.P.	- 2,220 L.F.
2.	10" V.C.P.	- 3,750 L.F.
3.	10" V.C.P.	- 245 L.F.
4.	6" Flexible Pipe Manhole	- 245 L.F.
5.	6" Man Holes	
6.	8" Cleanouts	
7.	1 each relocated Cleanout	
8.	1 Booster Station Man Hole	

Note - House laterals to be located in the field.

MONTGOMERY STREET
CROWELL STREET

CORWIN LANE

File No.	SIERRA FOOTHILLS-NO. 11		
Drawn By	SEWER PLAN & PROFILE		
Checked By	GROWELL ST. - GORWIN LN.		
Approval Recommended:	Approved:	Date:	Drawing No.:
W. R. MAXWELL 350 W. Base Line Scale: HOR 1" = 40' VERT 1" = 4'	LLS 2788 Land Surveying and Construction Layout San Bernardino, Calif.		Sheet 1 of 5

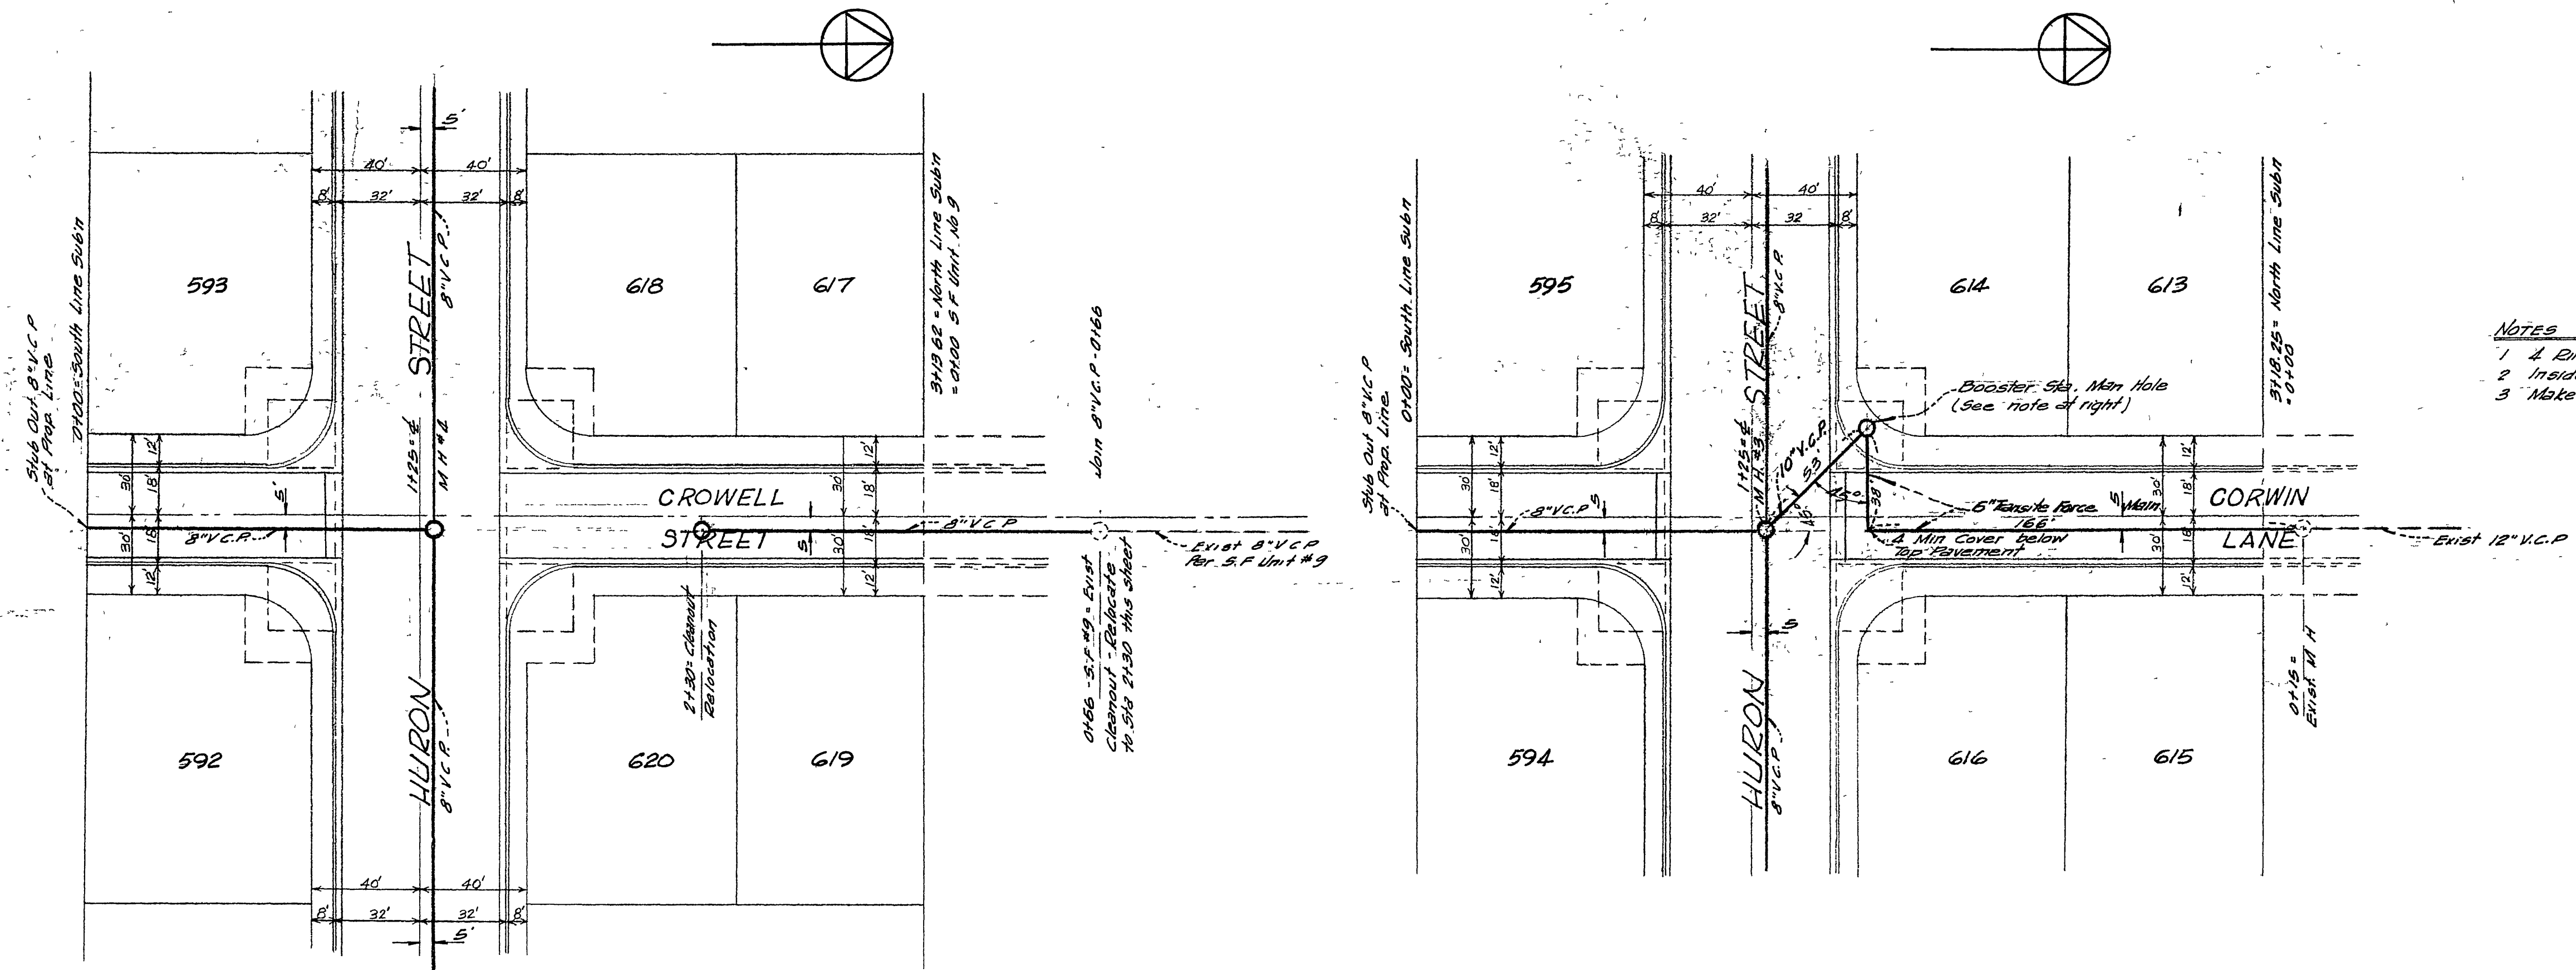


NOTES RE. BOOSTER STATION MAN HOLE
 1. 4' Ring & Cover (Alhambra or equal)
 2. Inside diam of 6"
 3. Make bottom of Man Hole flat.

- ESTIMATE OF QUANTITIES**
- 1. 4" V.C.P. - 2,820 L.F.
 - 2. 8" V.C.P. - 3,759 L.F.
 - 3. 10" V.C.P. - 346 L.F.
 - 4. 6" Transite Force Main - 204 L.F.
 - 5. 8' Man Holes
 - 6. 4 Cleanouts
 - 7. 1 each relocated Cleanout
 - 8. 1 Booster Station Man Hole

Note - House laterals to be located in the field

CROWELL STREET


CORWIN LANE

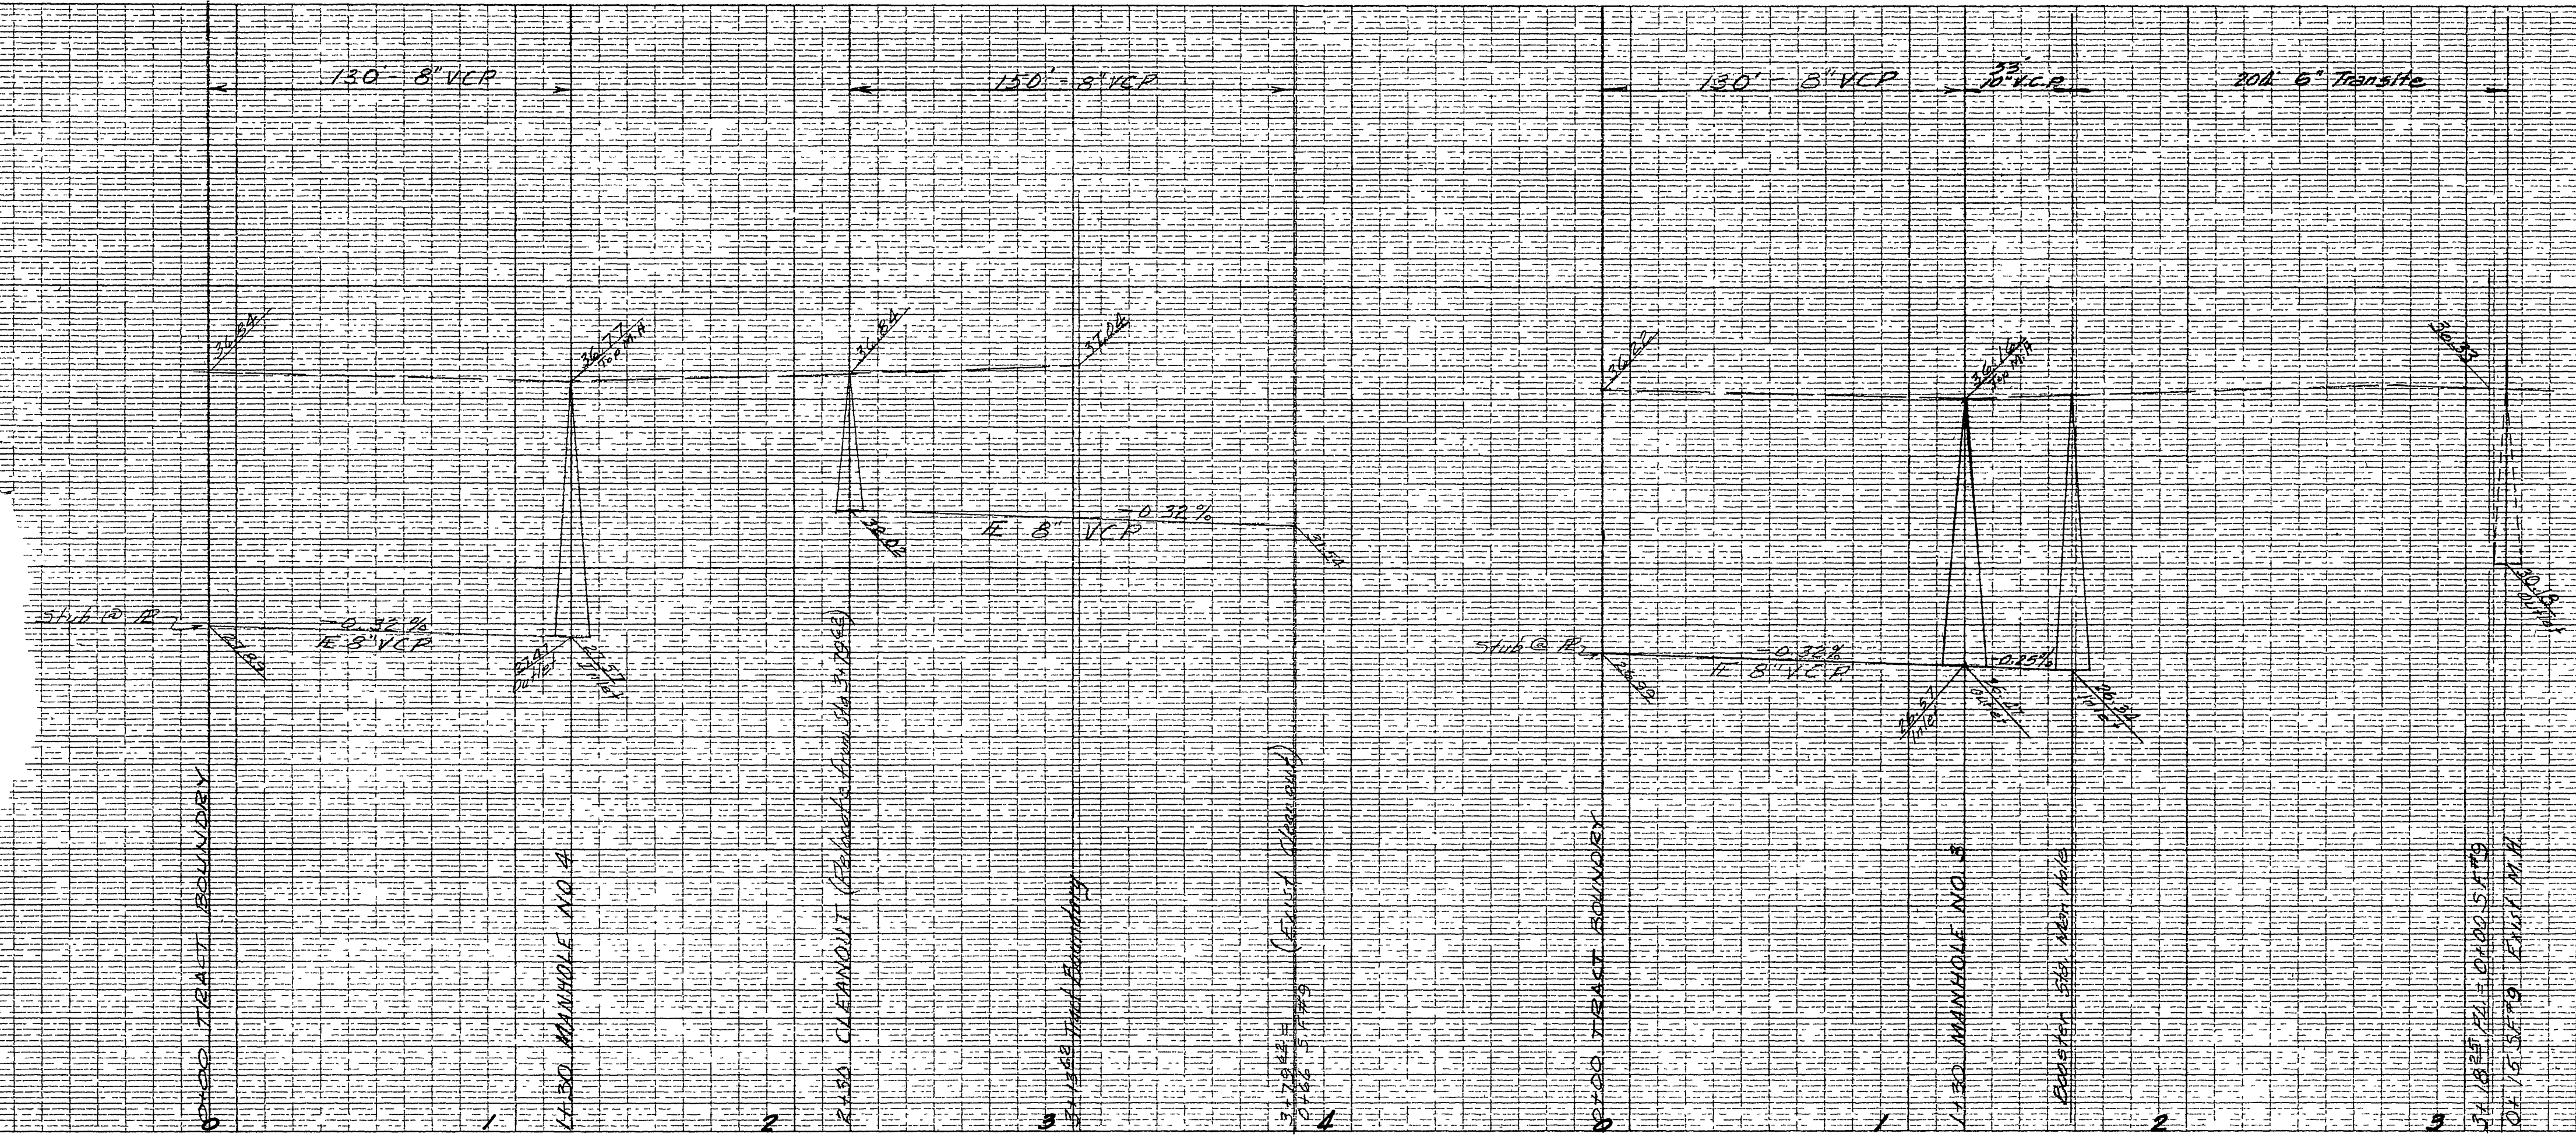


736-K

SERRA FOOTHILLS No. 11
SEWER PLAN & PROFILE
HURON ST.


W. P. HAYWELL
211 W. 7th St. San Francisco, Calif.
NOV. 7 1930
VERT. 1" = 4'

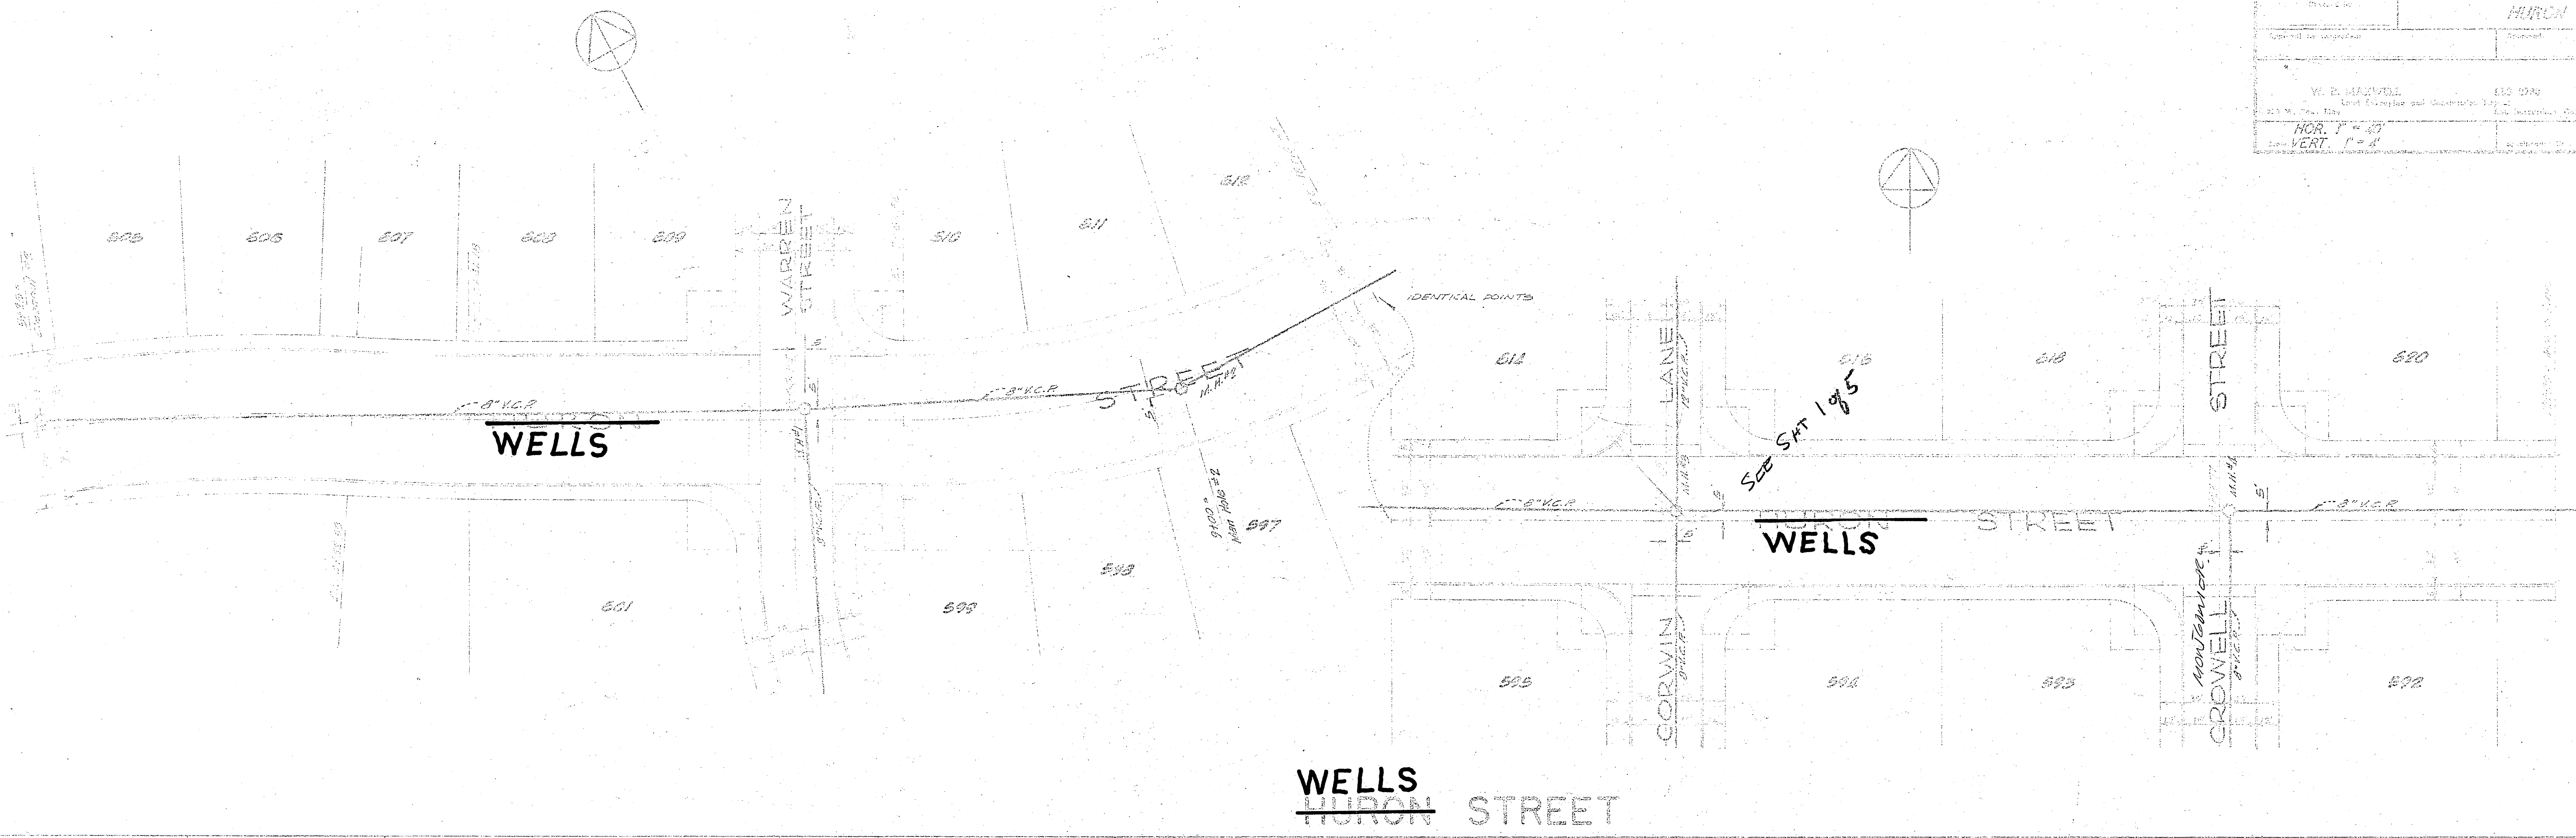


WELLS
HURON STREET

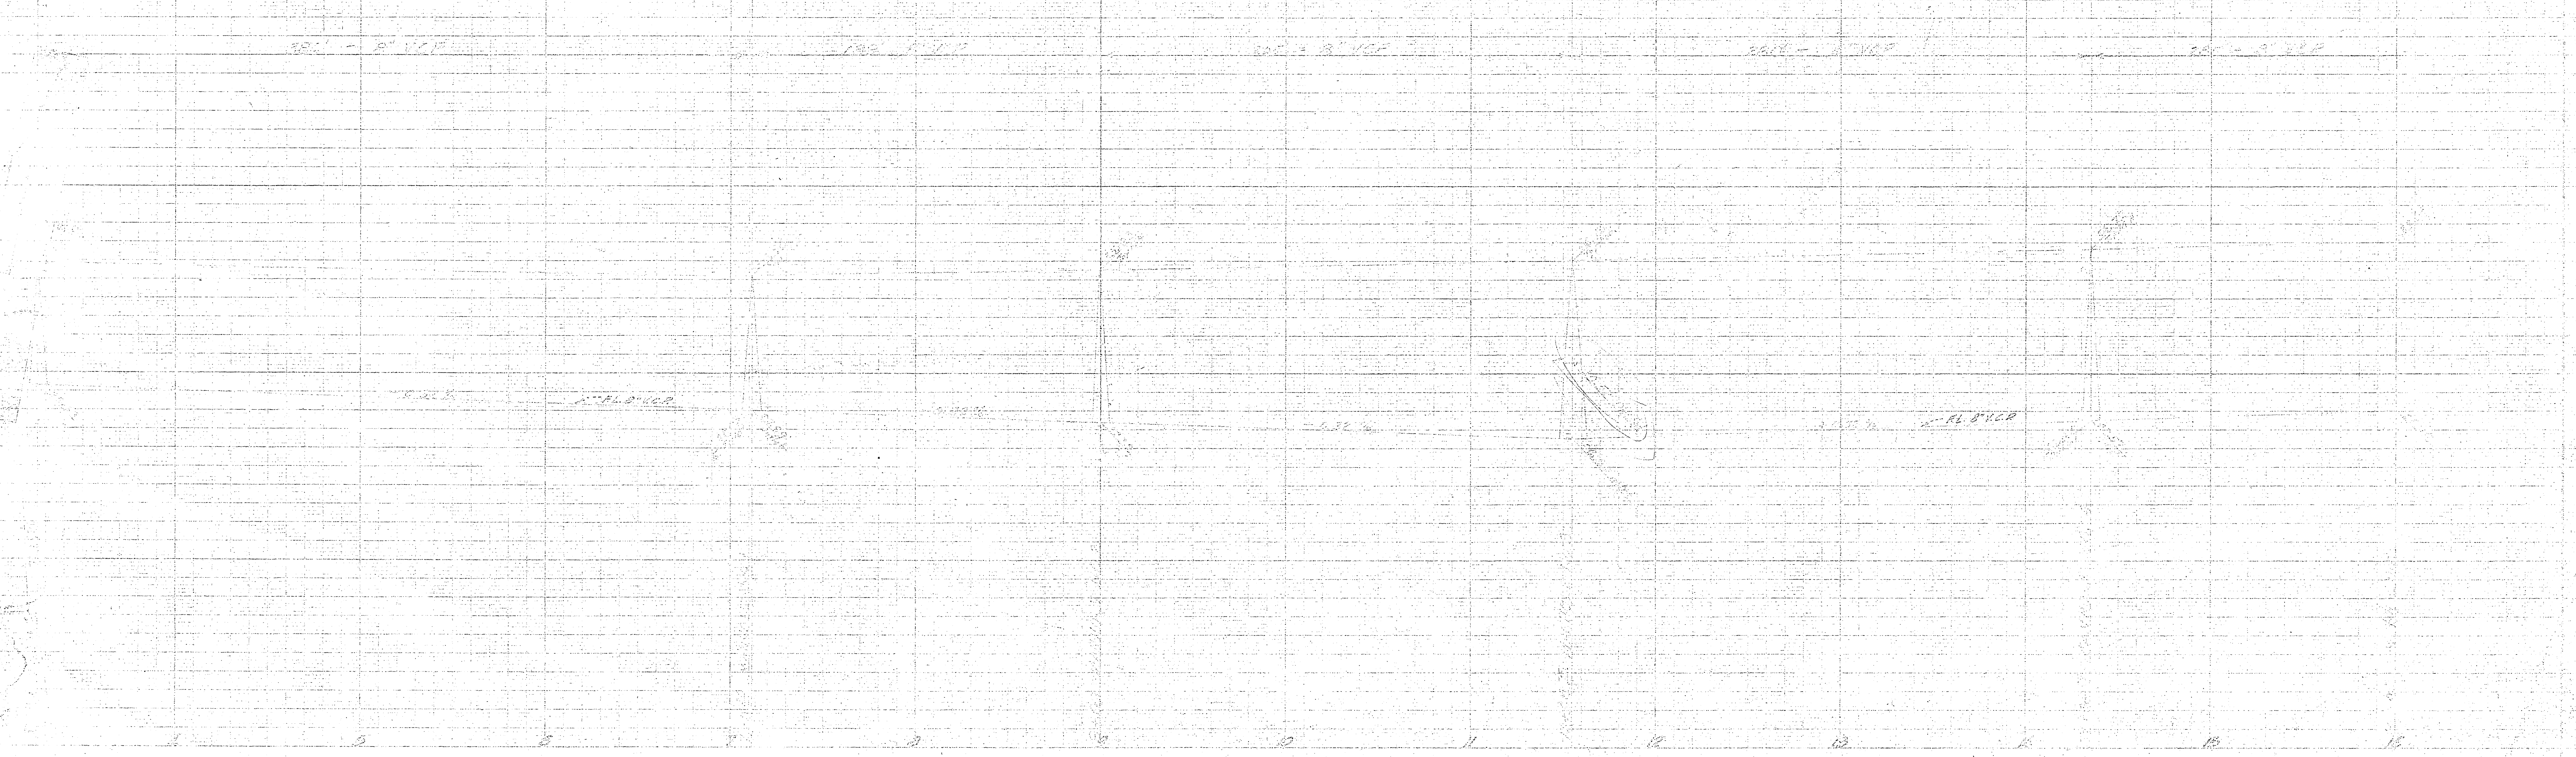

File No.	SIERRA FOOTHILLS NO. 11	
Drawn By	SEWER PLAN & PROFILE	
Checked By	HURON ST.	
Approval Recommended:	Approved:	Date
W. R. MAXWELL 350 W. Rose Lane San Bernardino, Calif.		LLS 2788 Land Surveying and Construction Layout San Bernardino, Calif.
Drawing No.		Sheet 2 of 5
Scale: HOR. 1" = 40' VERT. 1" = 4'		Specification No.

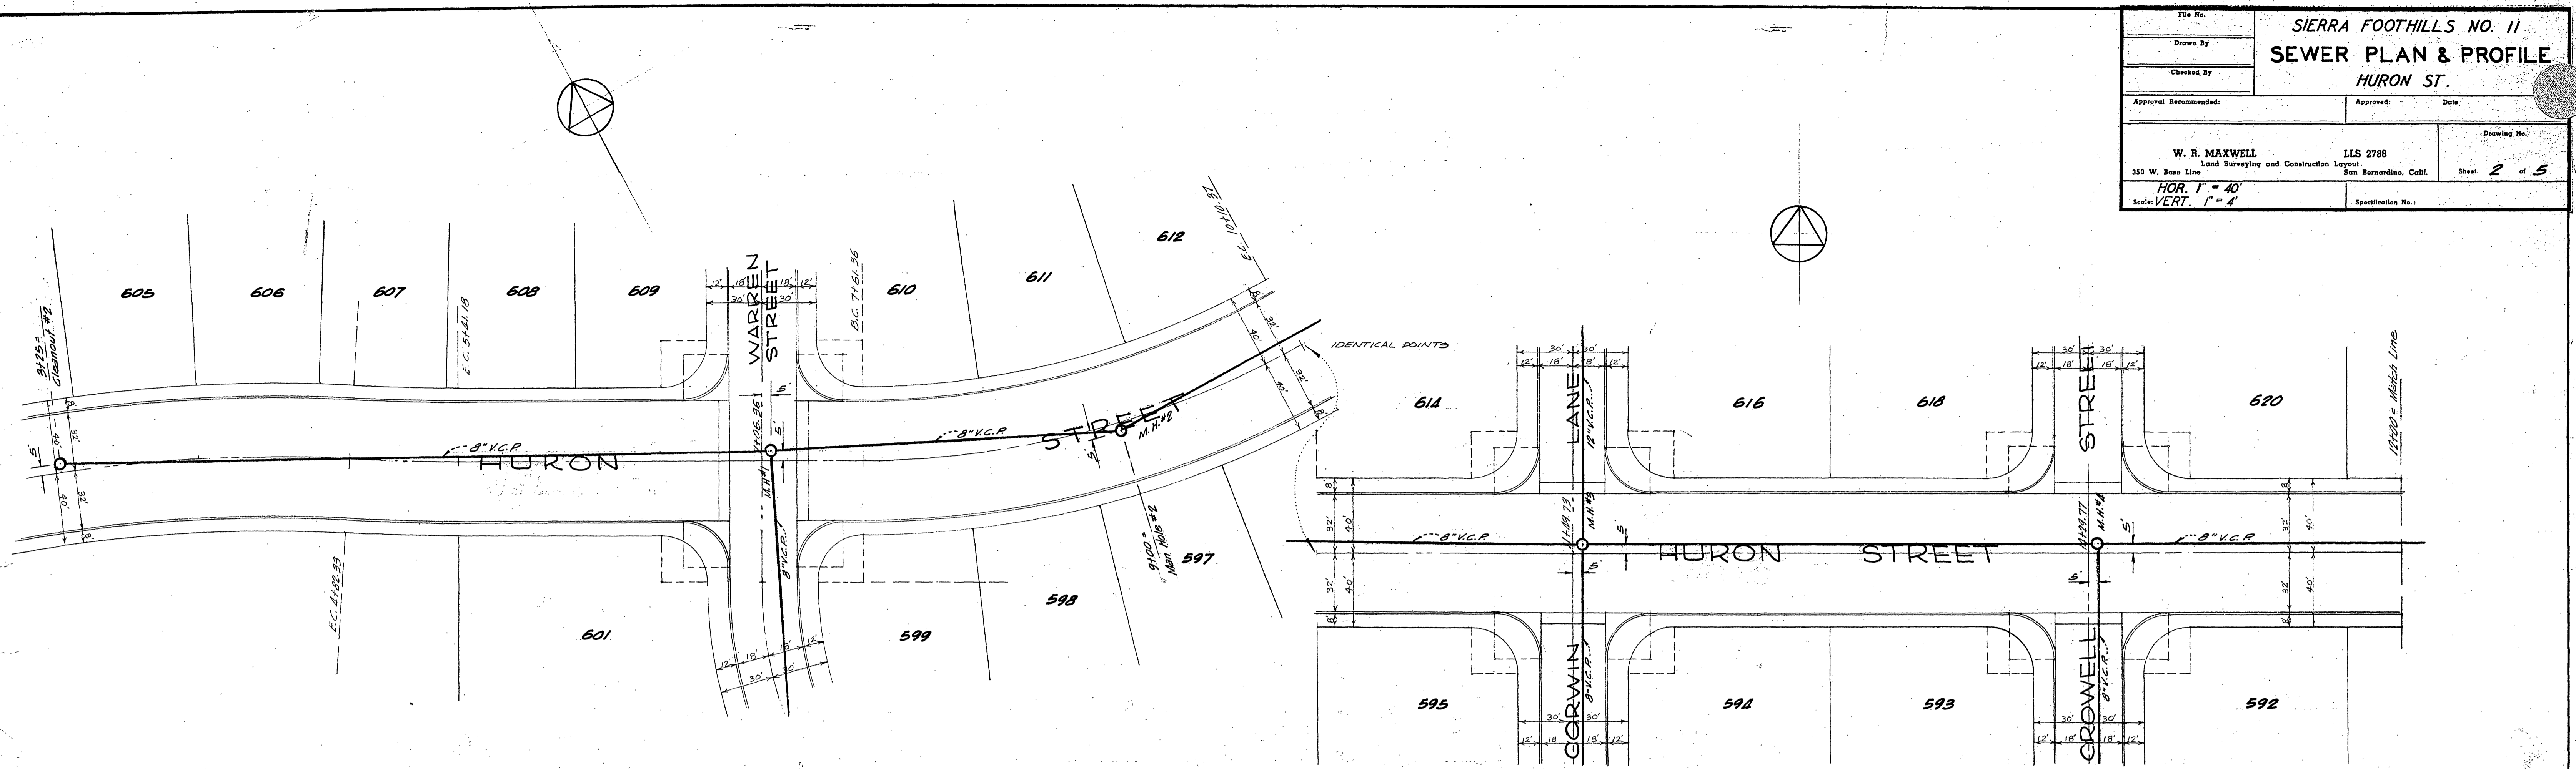

HURON STREET



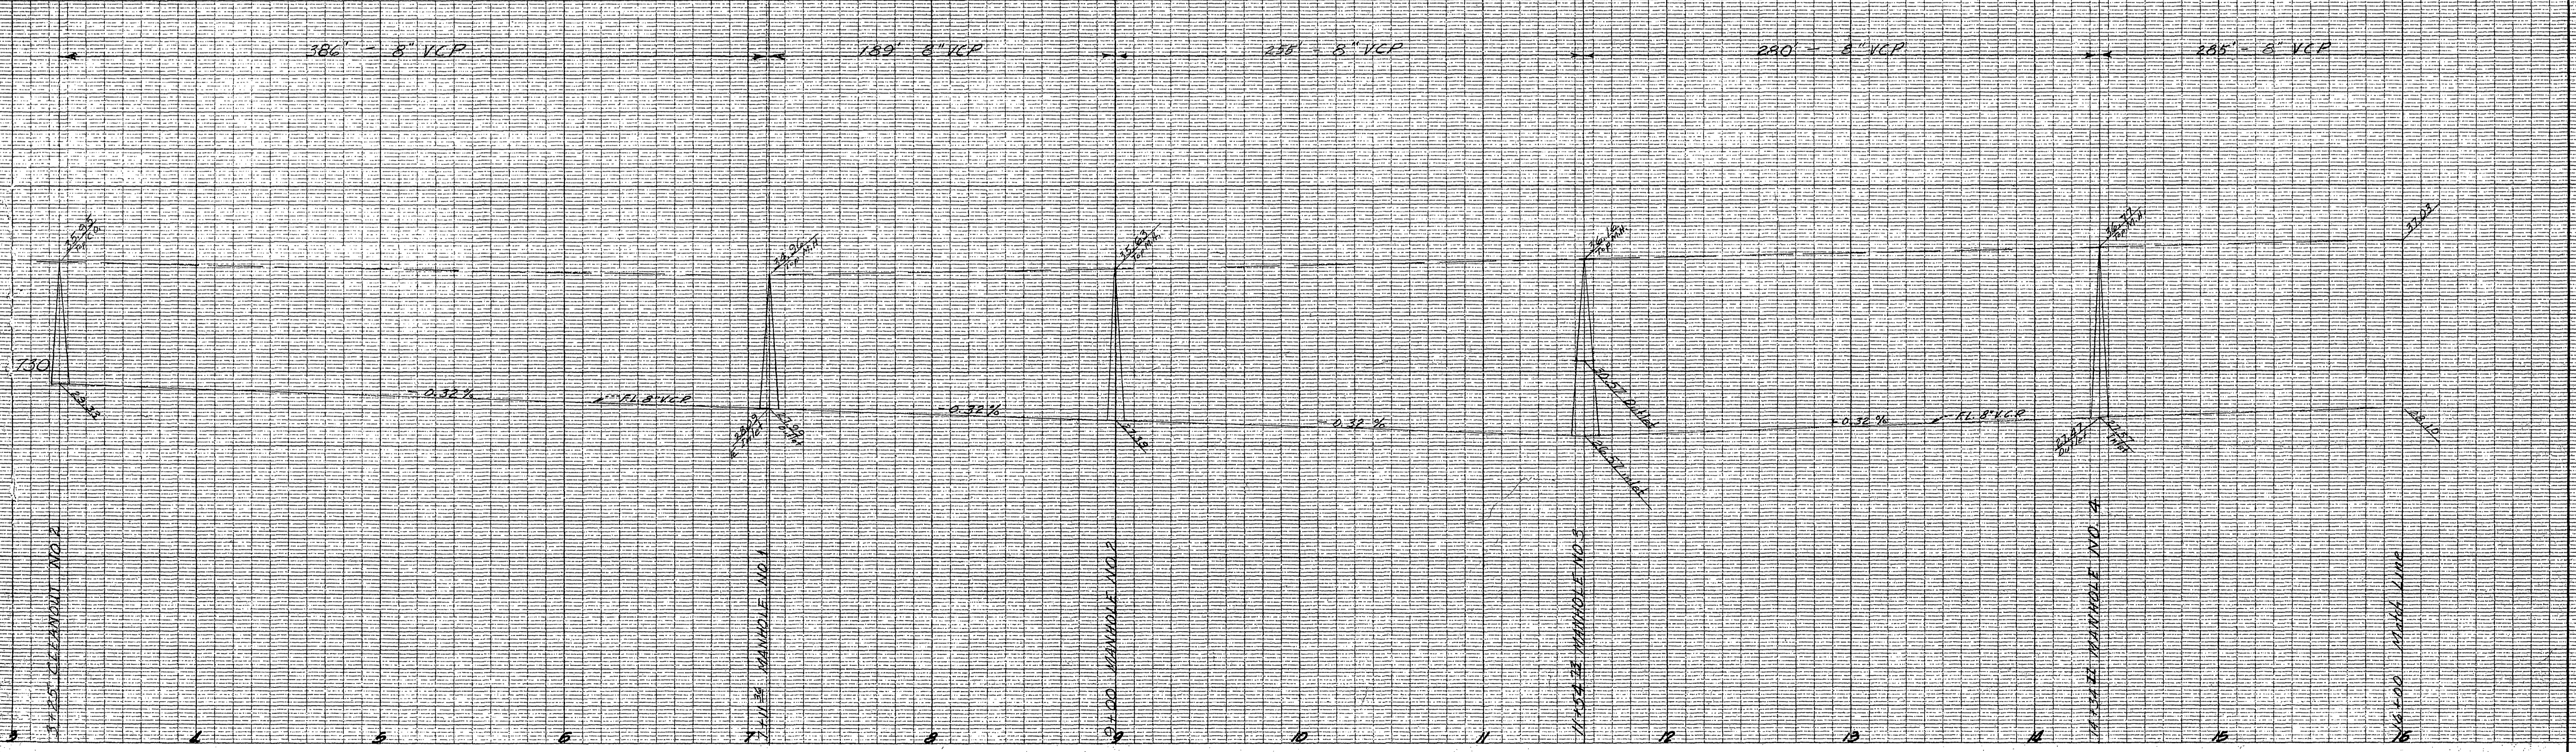


MADE IN U.S.A. CLEARPRINT PAPER CO. CLEARPRINT PAPER CO. CLEARPRINT PAPER CO. CLEARPRINT PAPER CO. CLEARPRINT PAPER CO. CLEARPRINT PAPER CO. CLEARPRINT PAPER CO. CLEARPRINT PAPER CO. CLEARPRINT PAPER CO. CLEARPRINT PAPER CO.

16.5.83




File No.	SIERRA Foothills NO. II		
Drawn By	SEWER PLAN & PROFILE		
Checked By	HURON ST. - WOHLSTETTER ST. - WARREN ST.		
Approval Recommended:	Approved:	Date:	Drawing No.
W. R. MAXWELL Land Surveying and Construction Layout		LIS 2788 San Bernardino, Calif.	Sheet 3 of 5
Scale: HOR. 1" = 40'		Specification No.:	
Scale: VERT. 1" = 4'			

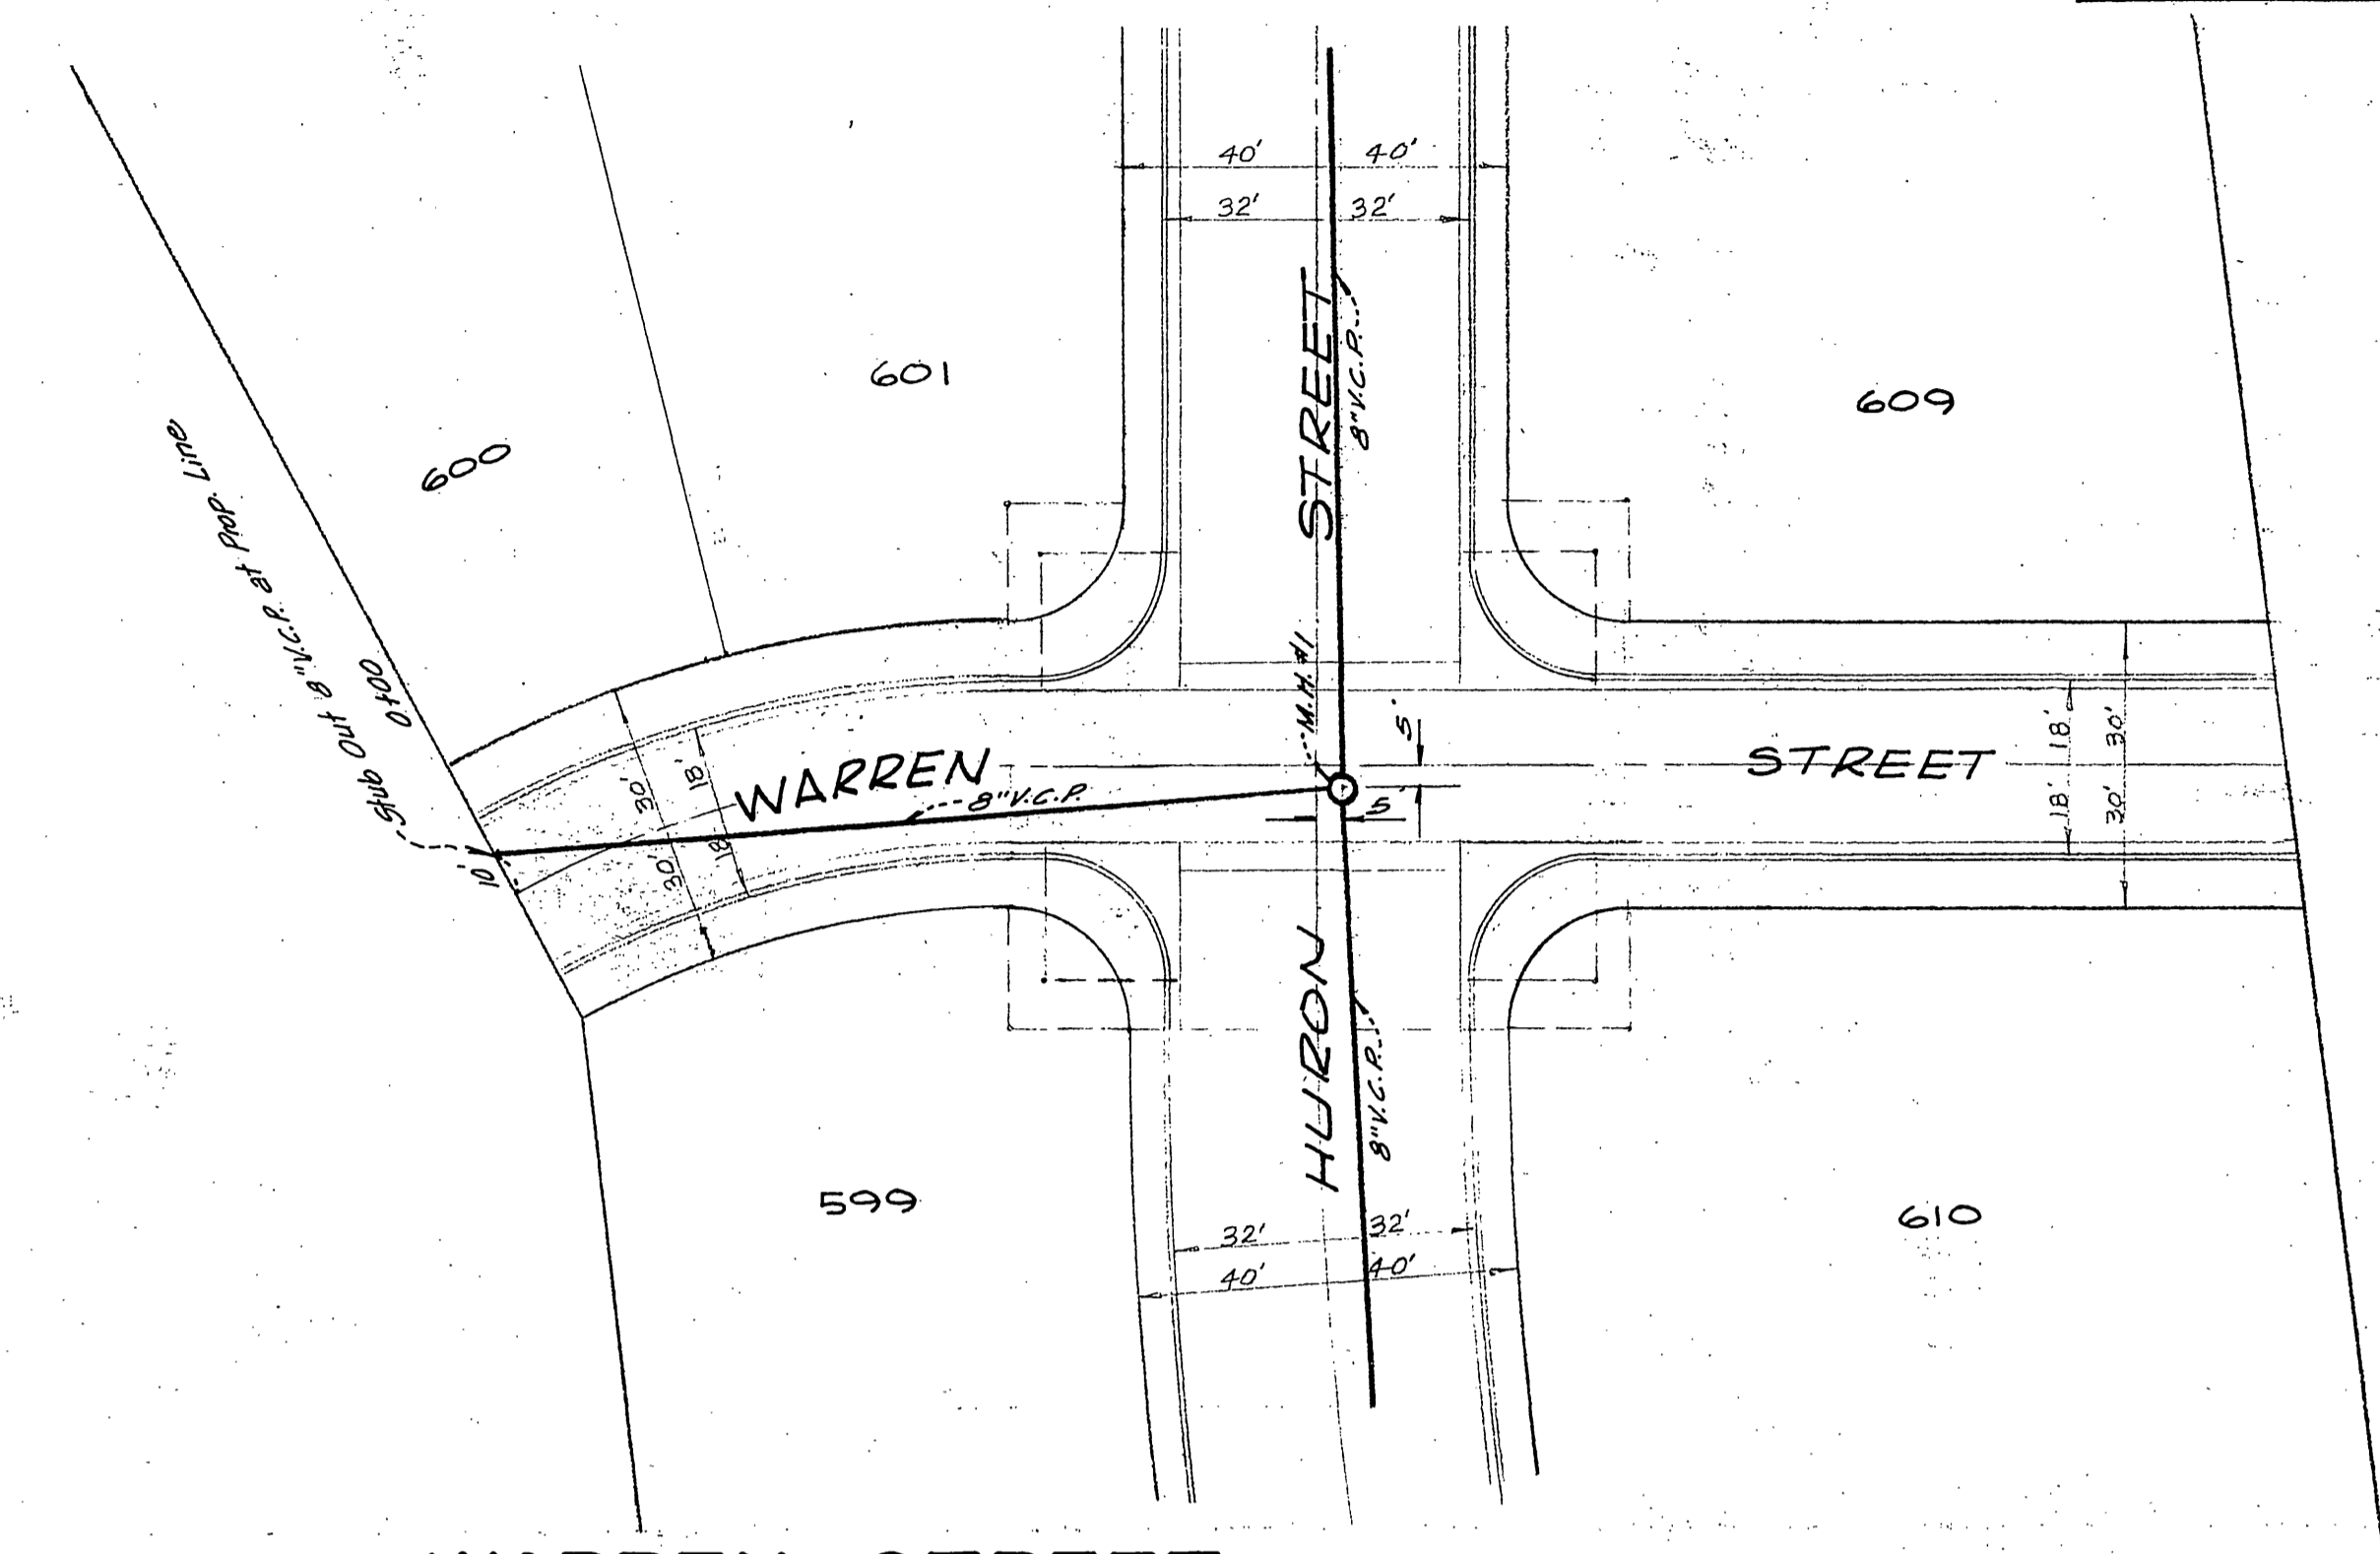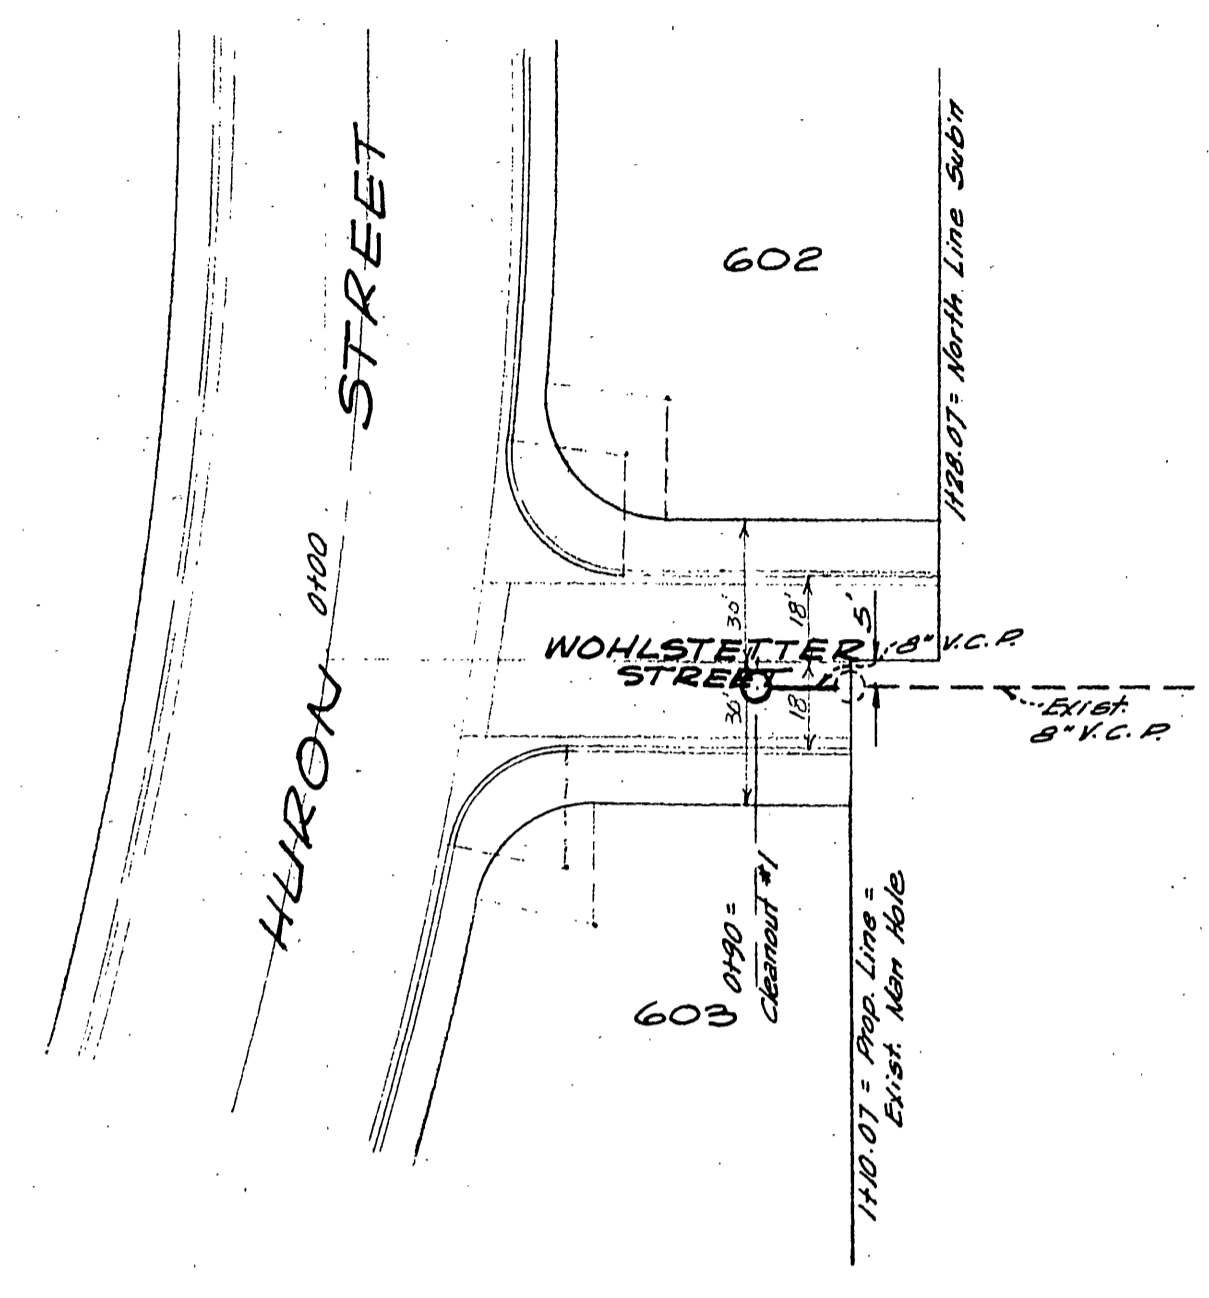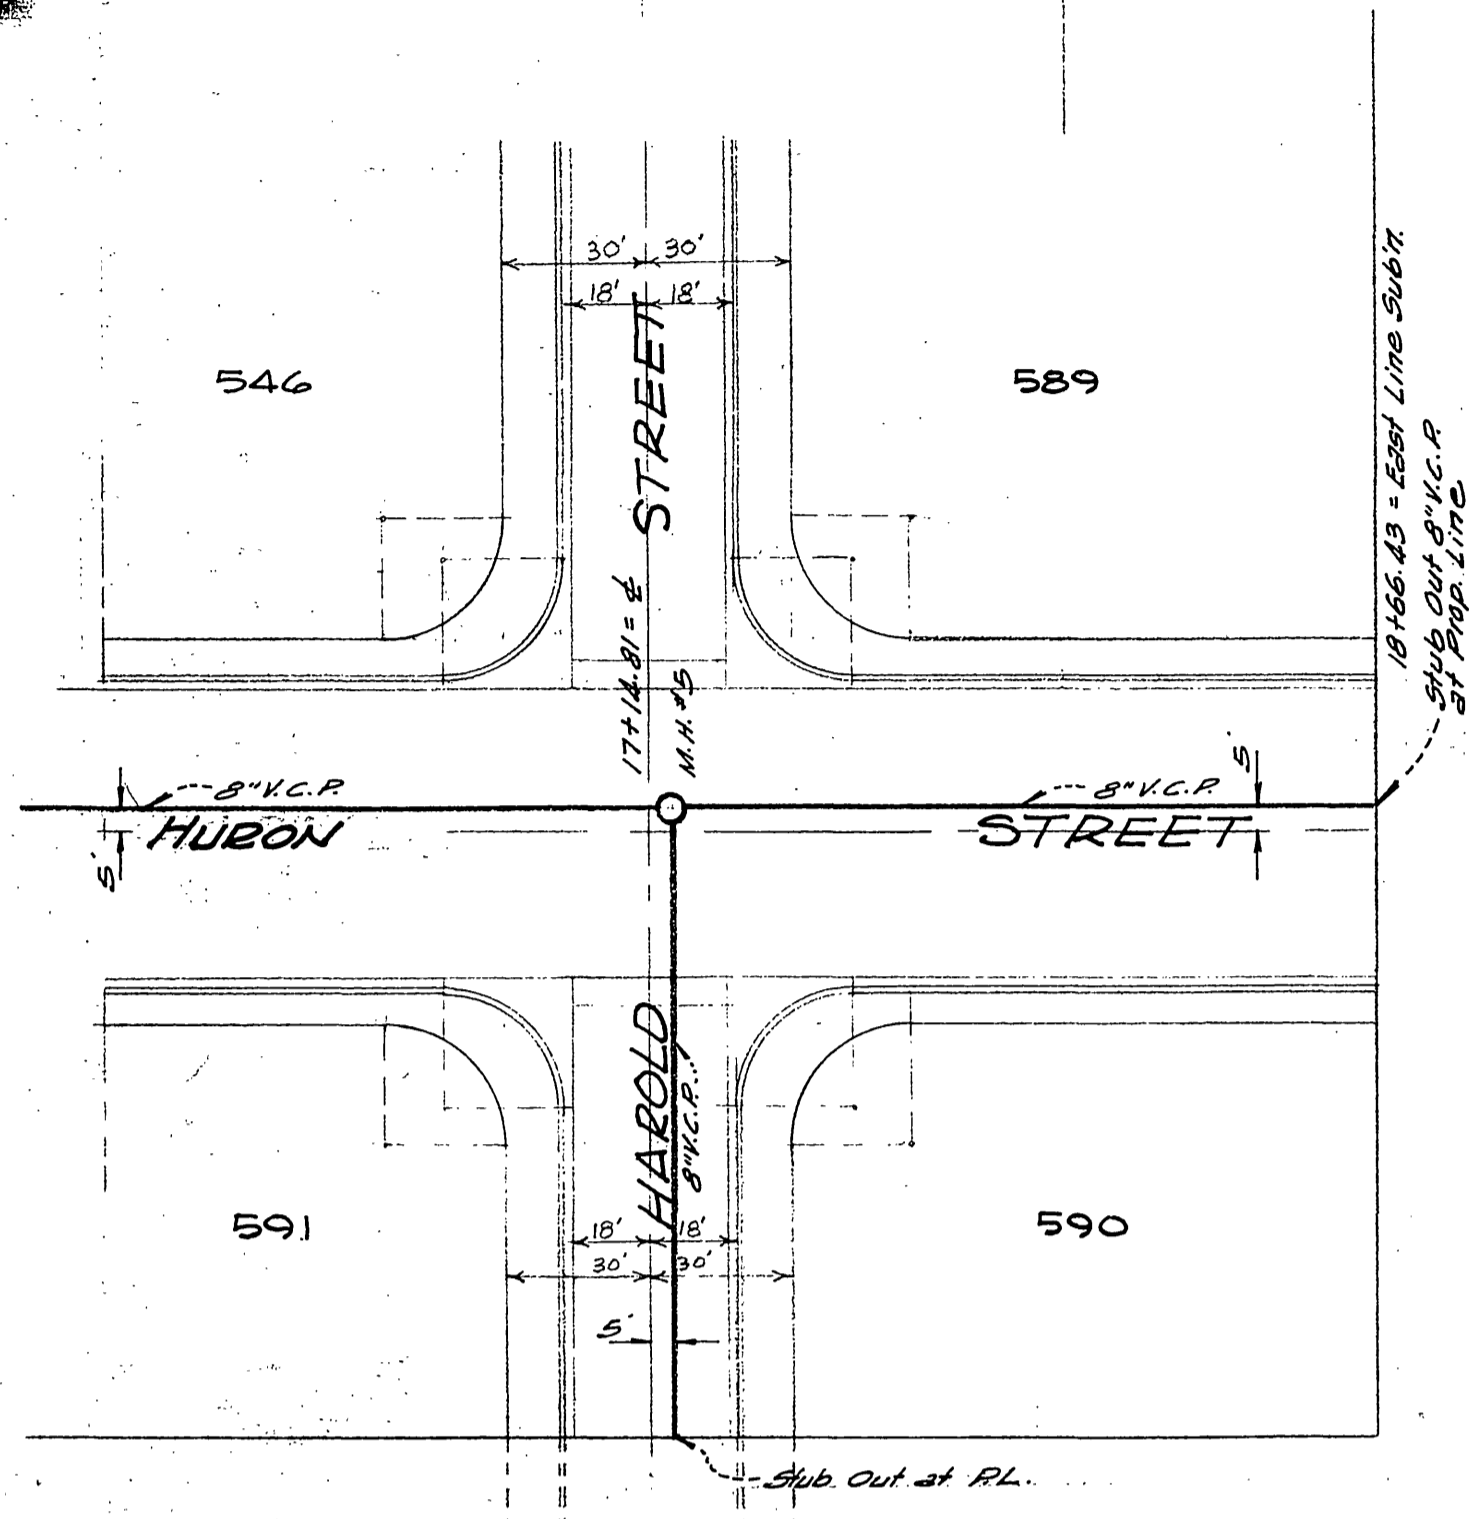

HURON STREET



WOHLSTETTER ST.

WARREN STREET

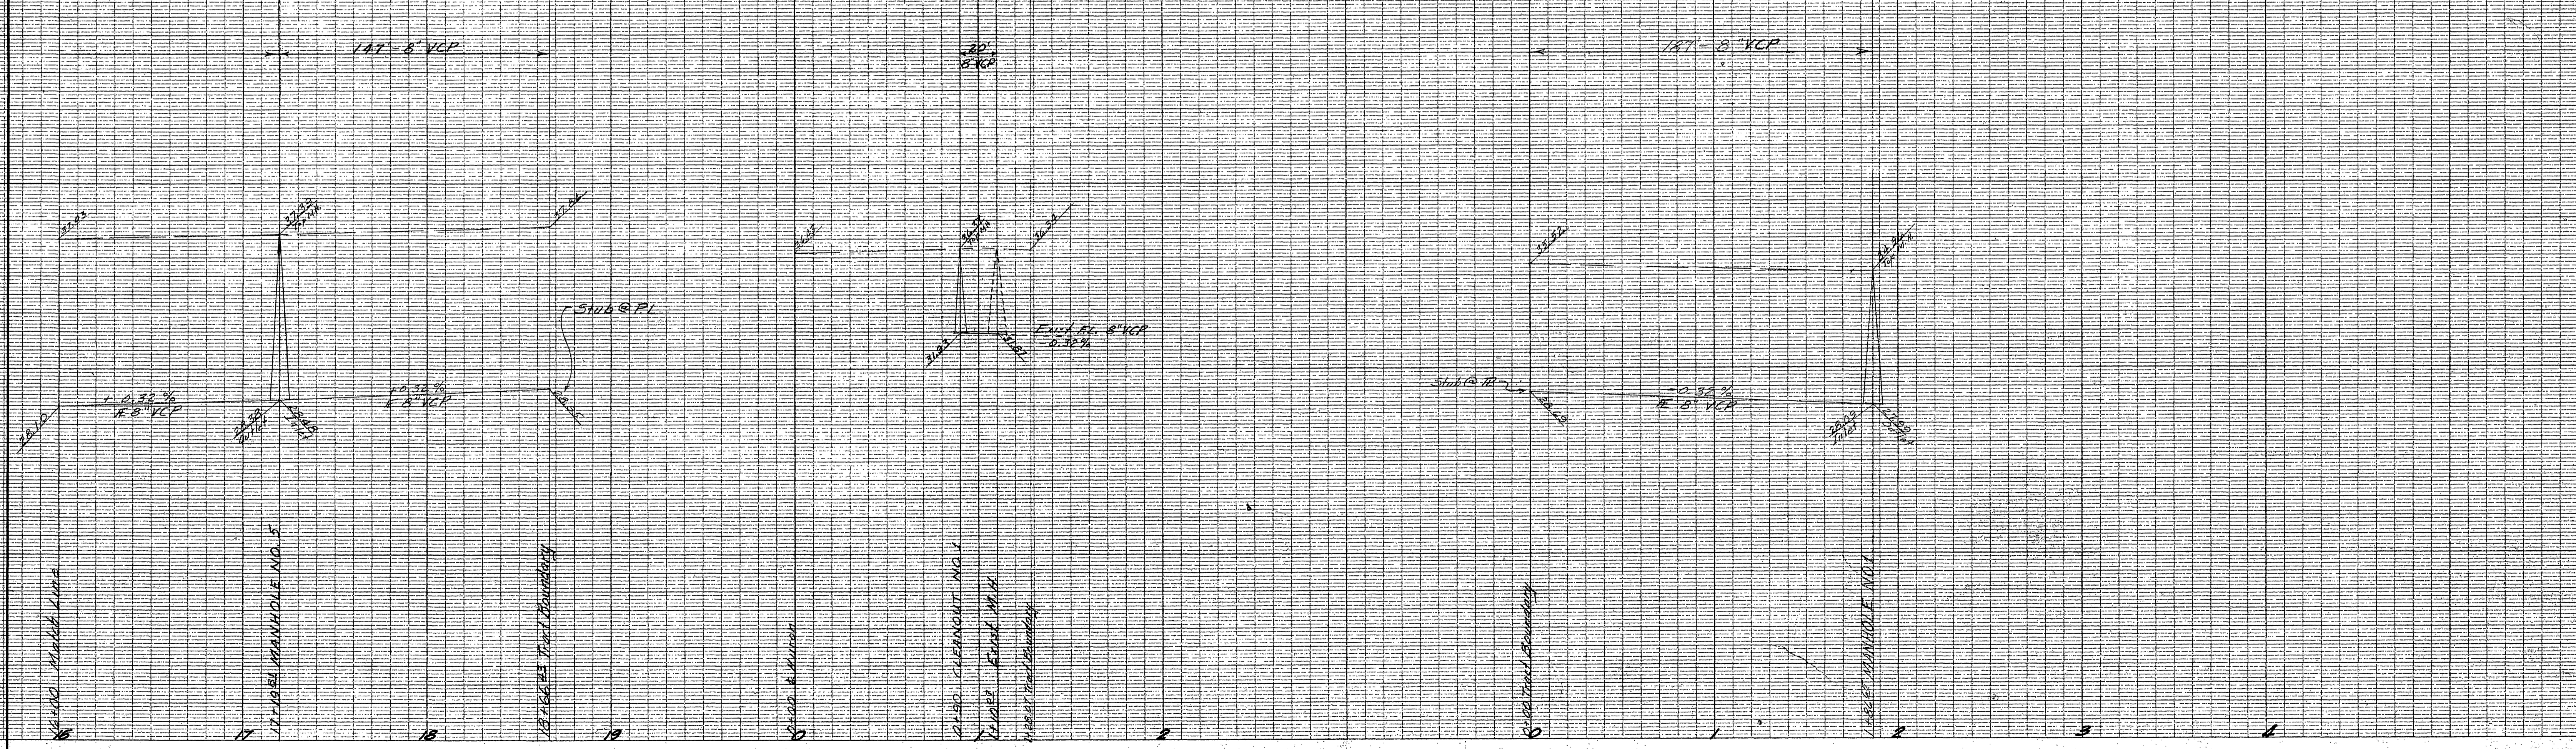


MADE IN U.S.A. CLEARPRINT PAPER CO. CLEARPRINT, PROFILE PAPER, PLATE A

File No.	SIERRA FOOTHILLS NO. 11	
Drawn By	SEWER PLAN & PROFILE	
Checked By	HAROLD ST.	
Approval Recommended:	Approved:	Date:
W. R. MAXWELL		Drawing No.
350 W. Rose Lane Land Surveying and Construction Layout San Bernardino, Calif.		LLS 2788
Scale: HOR. 1" = 30' VERT. 1" = 4'		Sheet 4 of 5
		Specification No.:

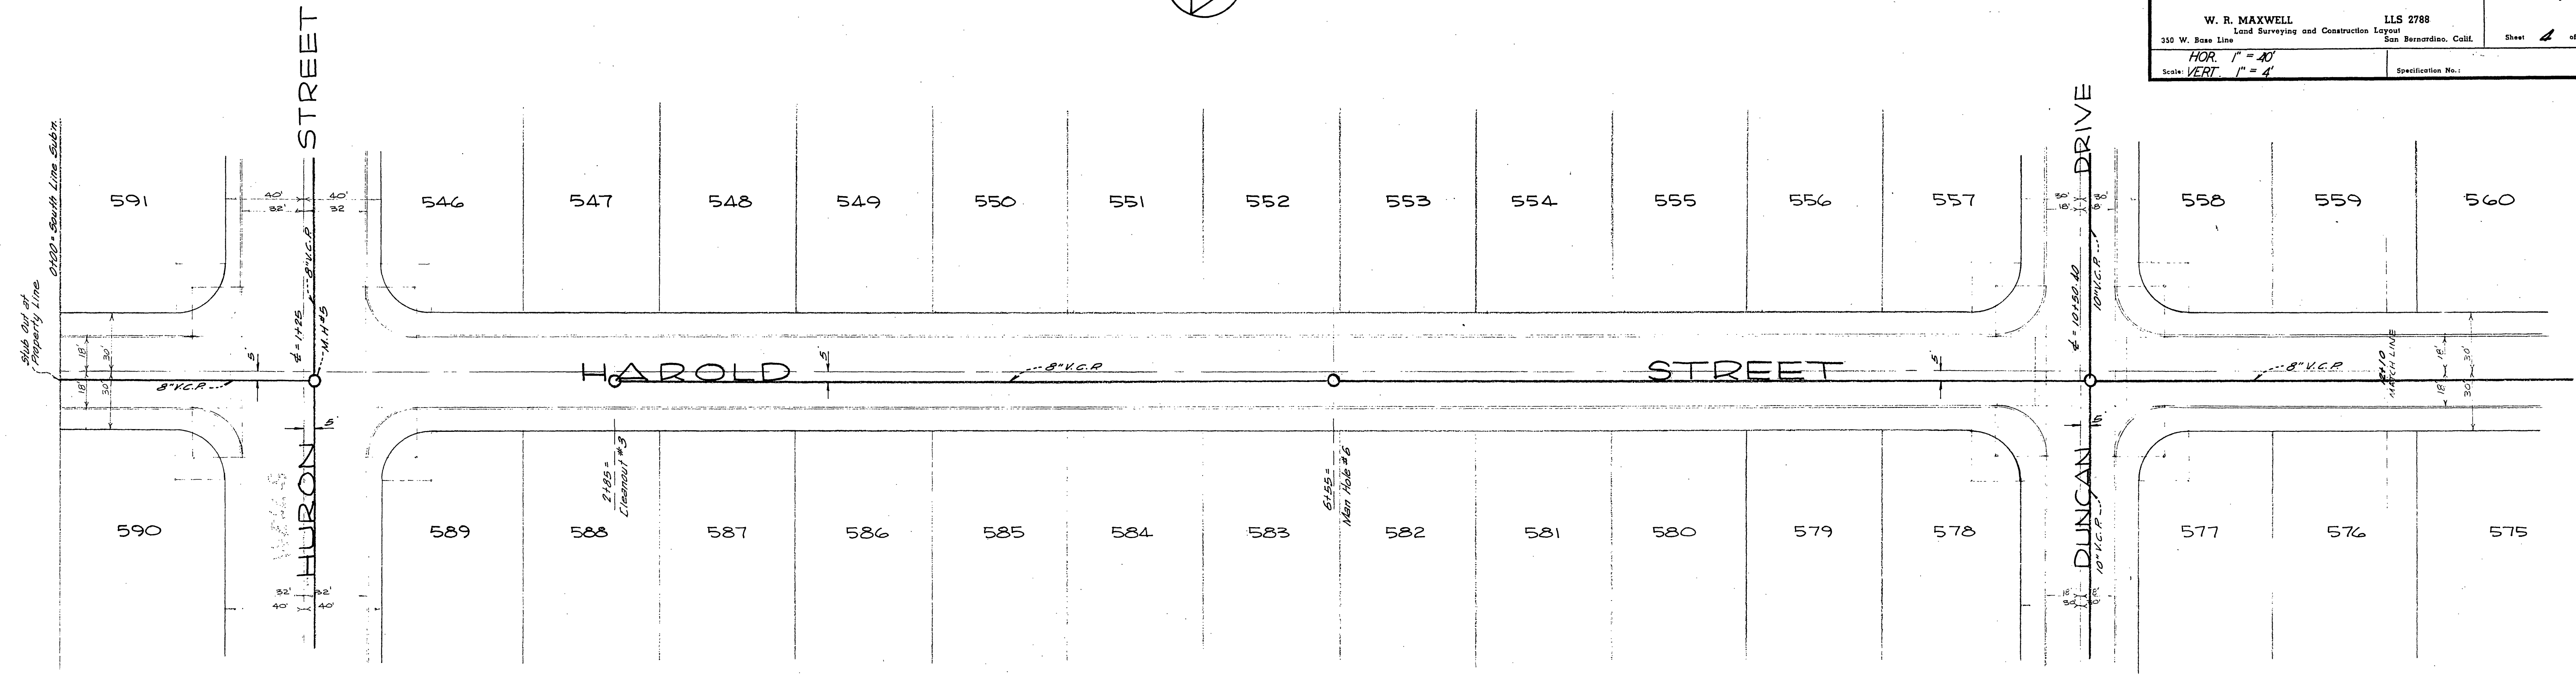
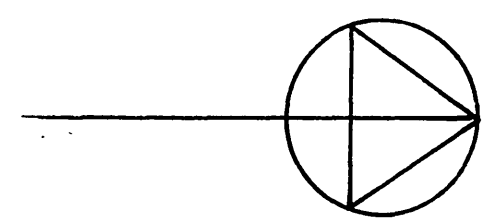


HAROLD STREET

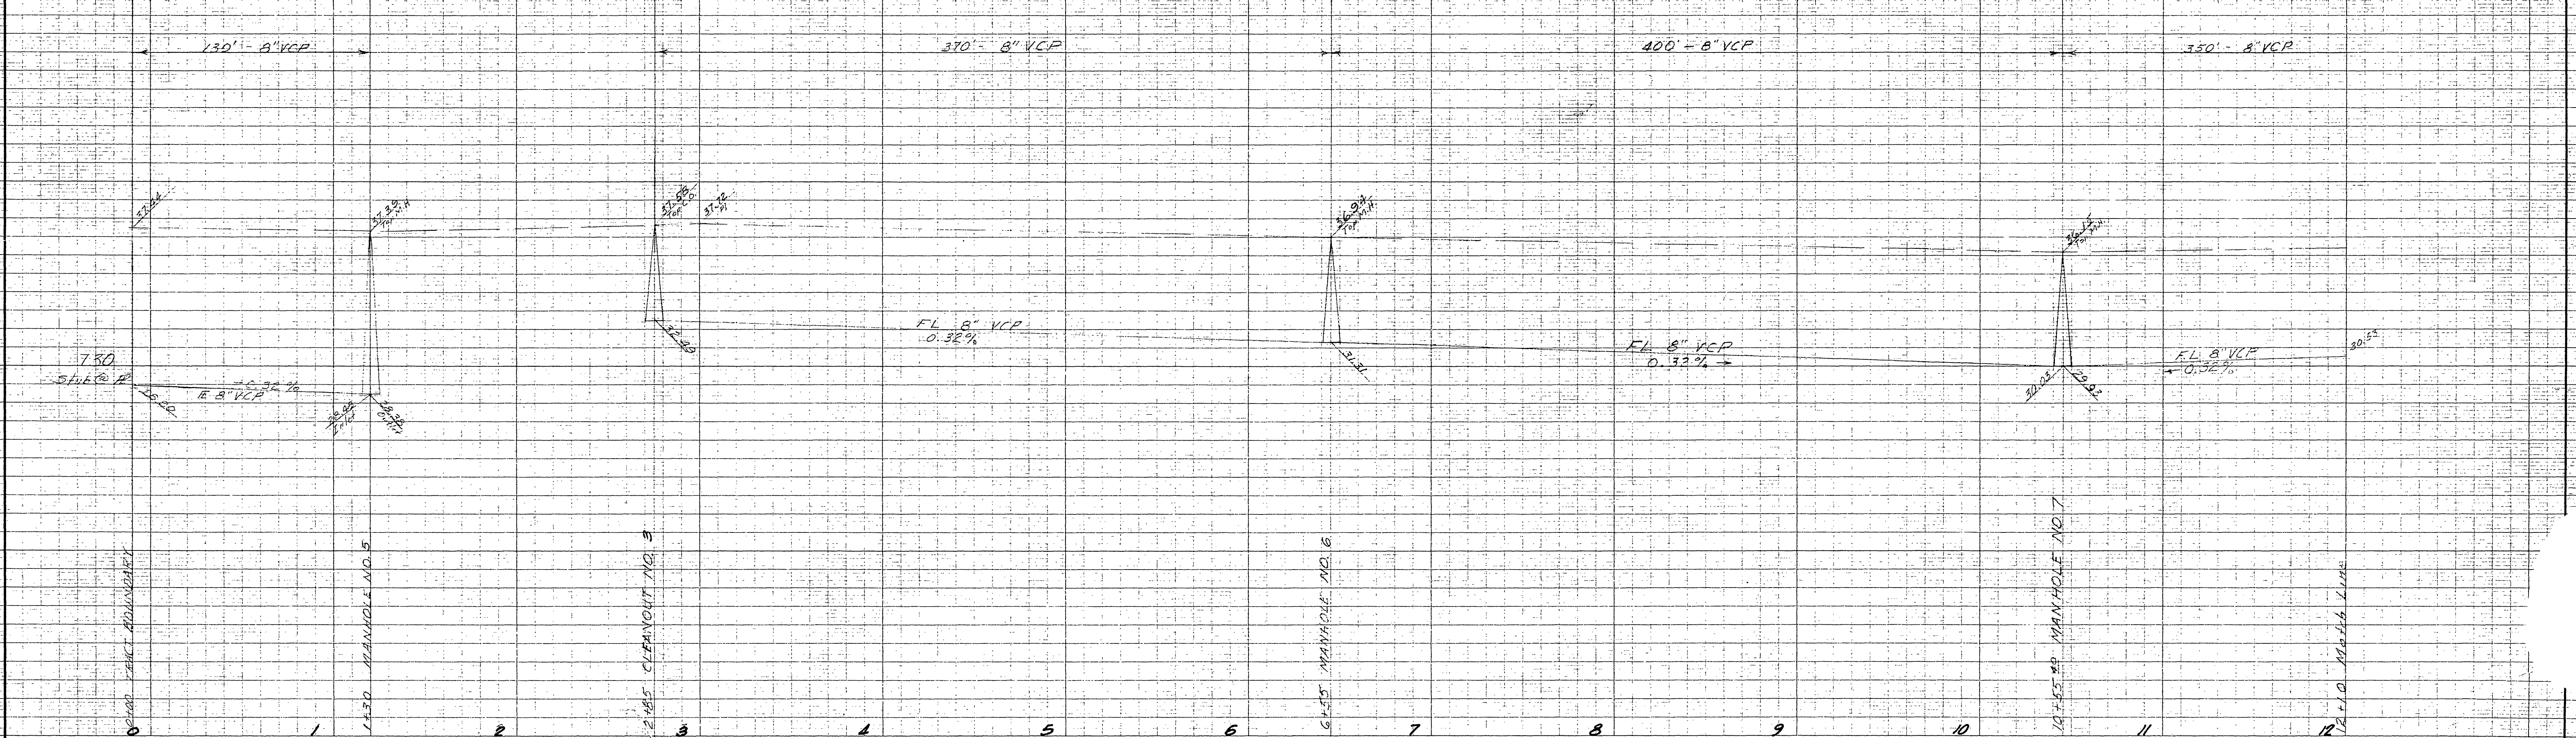


MADE IN U.S.A. CLEARPRINT PAPER CO. CLEARPRINT PAPER CO. CLEARPRINT PAPER CO.

File No.	SIERRA FOOTHILLS NO. 11	
Drawn By	SEWER PLAN & PROFILE	
Checked By	HAROLD ST. & DUNCAN DR.	
Approval Recommended:	Approved:	Date:
W. R. MAXWELL		LLS 2788
310 W. Rose Lane Land Surveying and Construction Layout San Bernardino, Calif.		Drawing No. Sheet 5 of 5
Scale: HOR. 1" = 40' VERT. 1" = 4'		Specification No.:

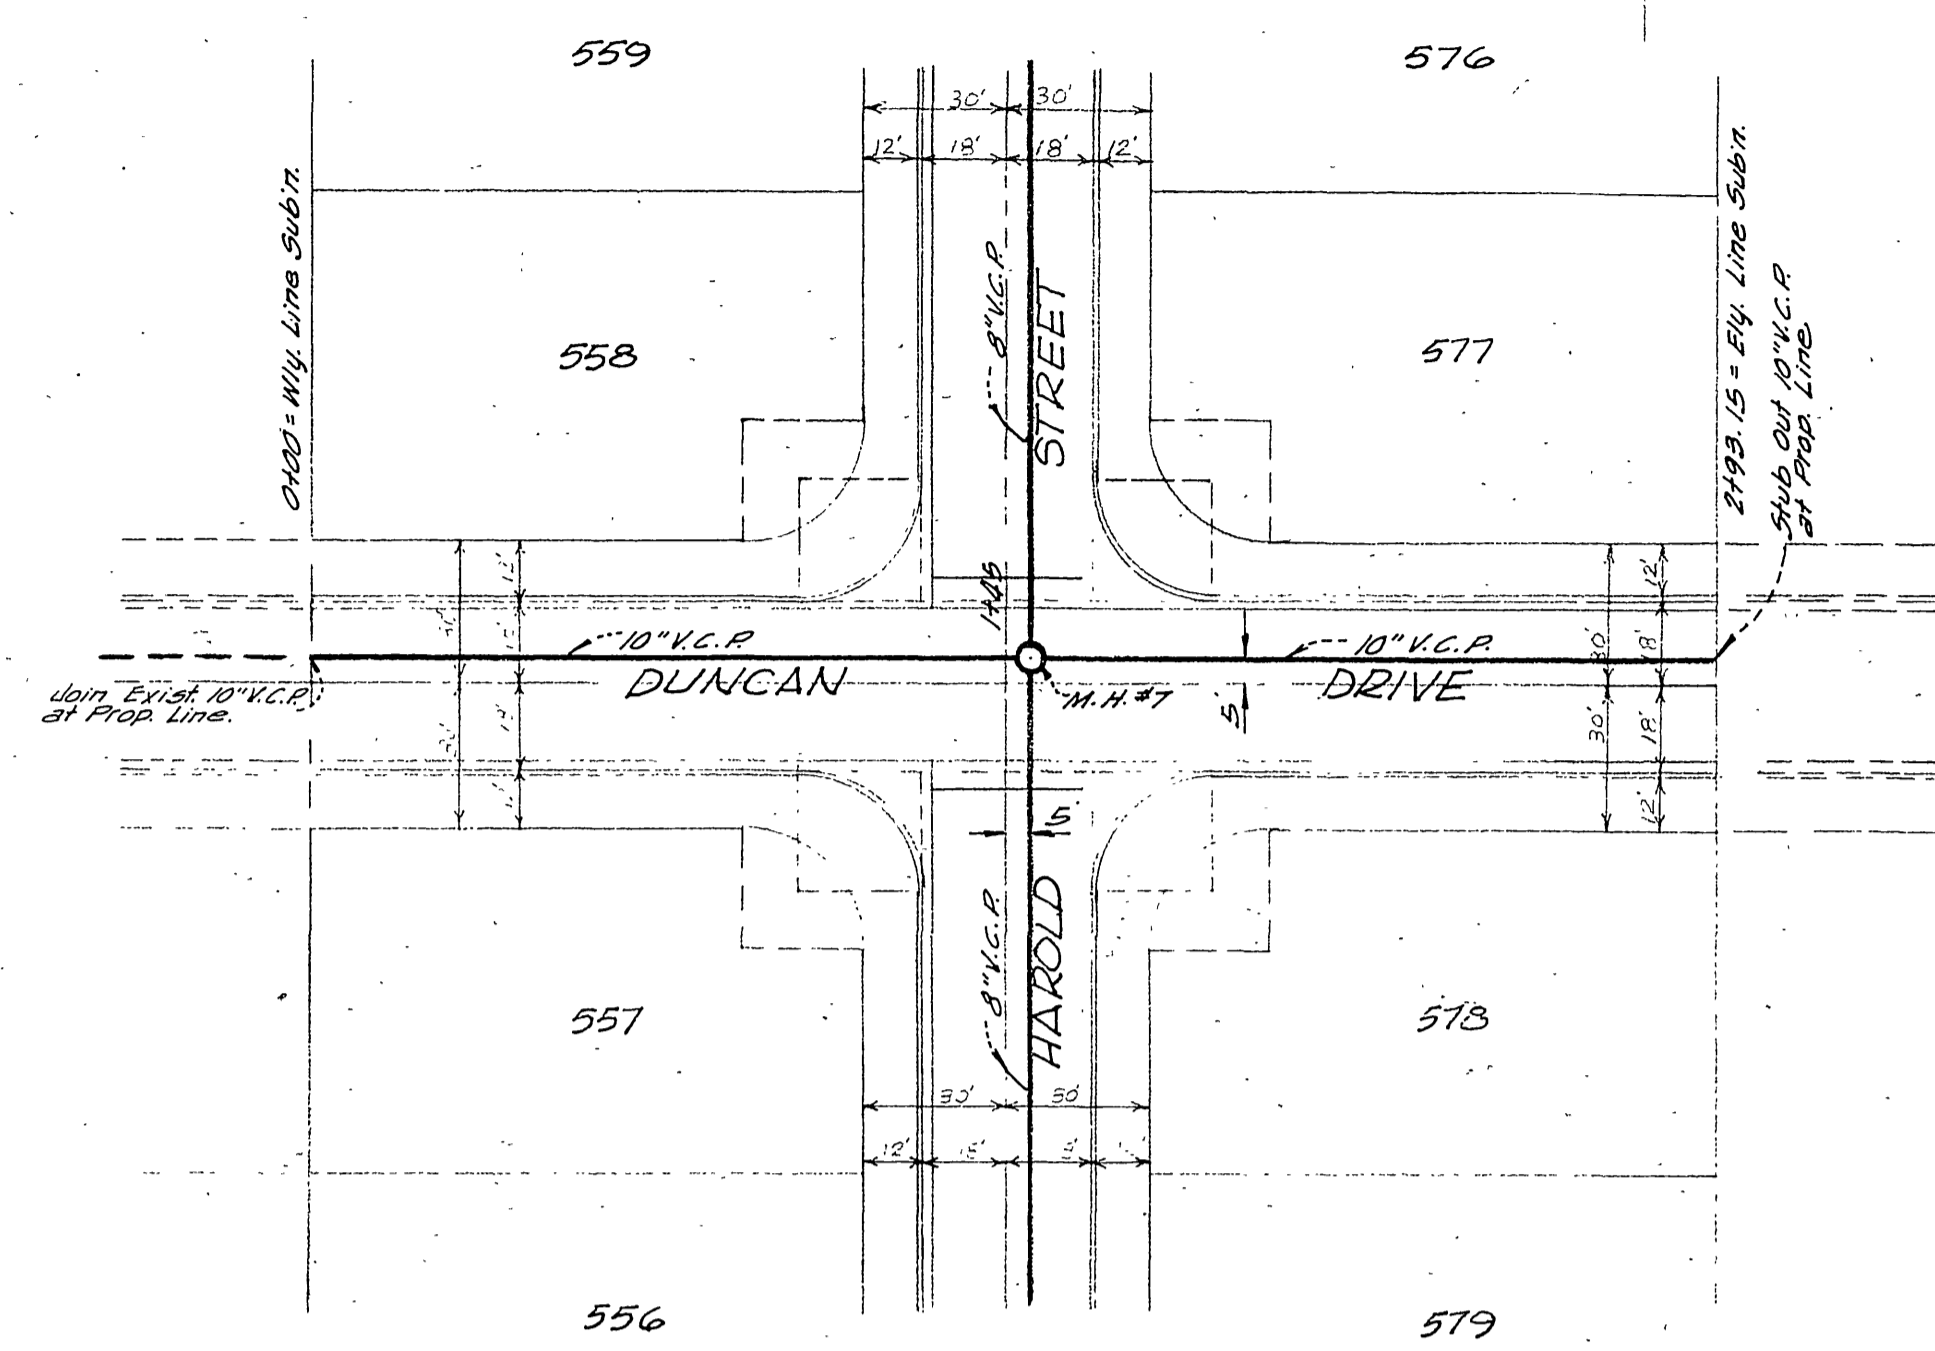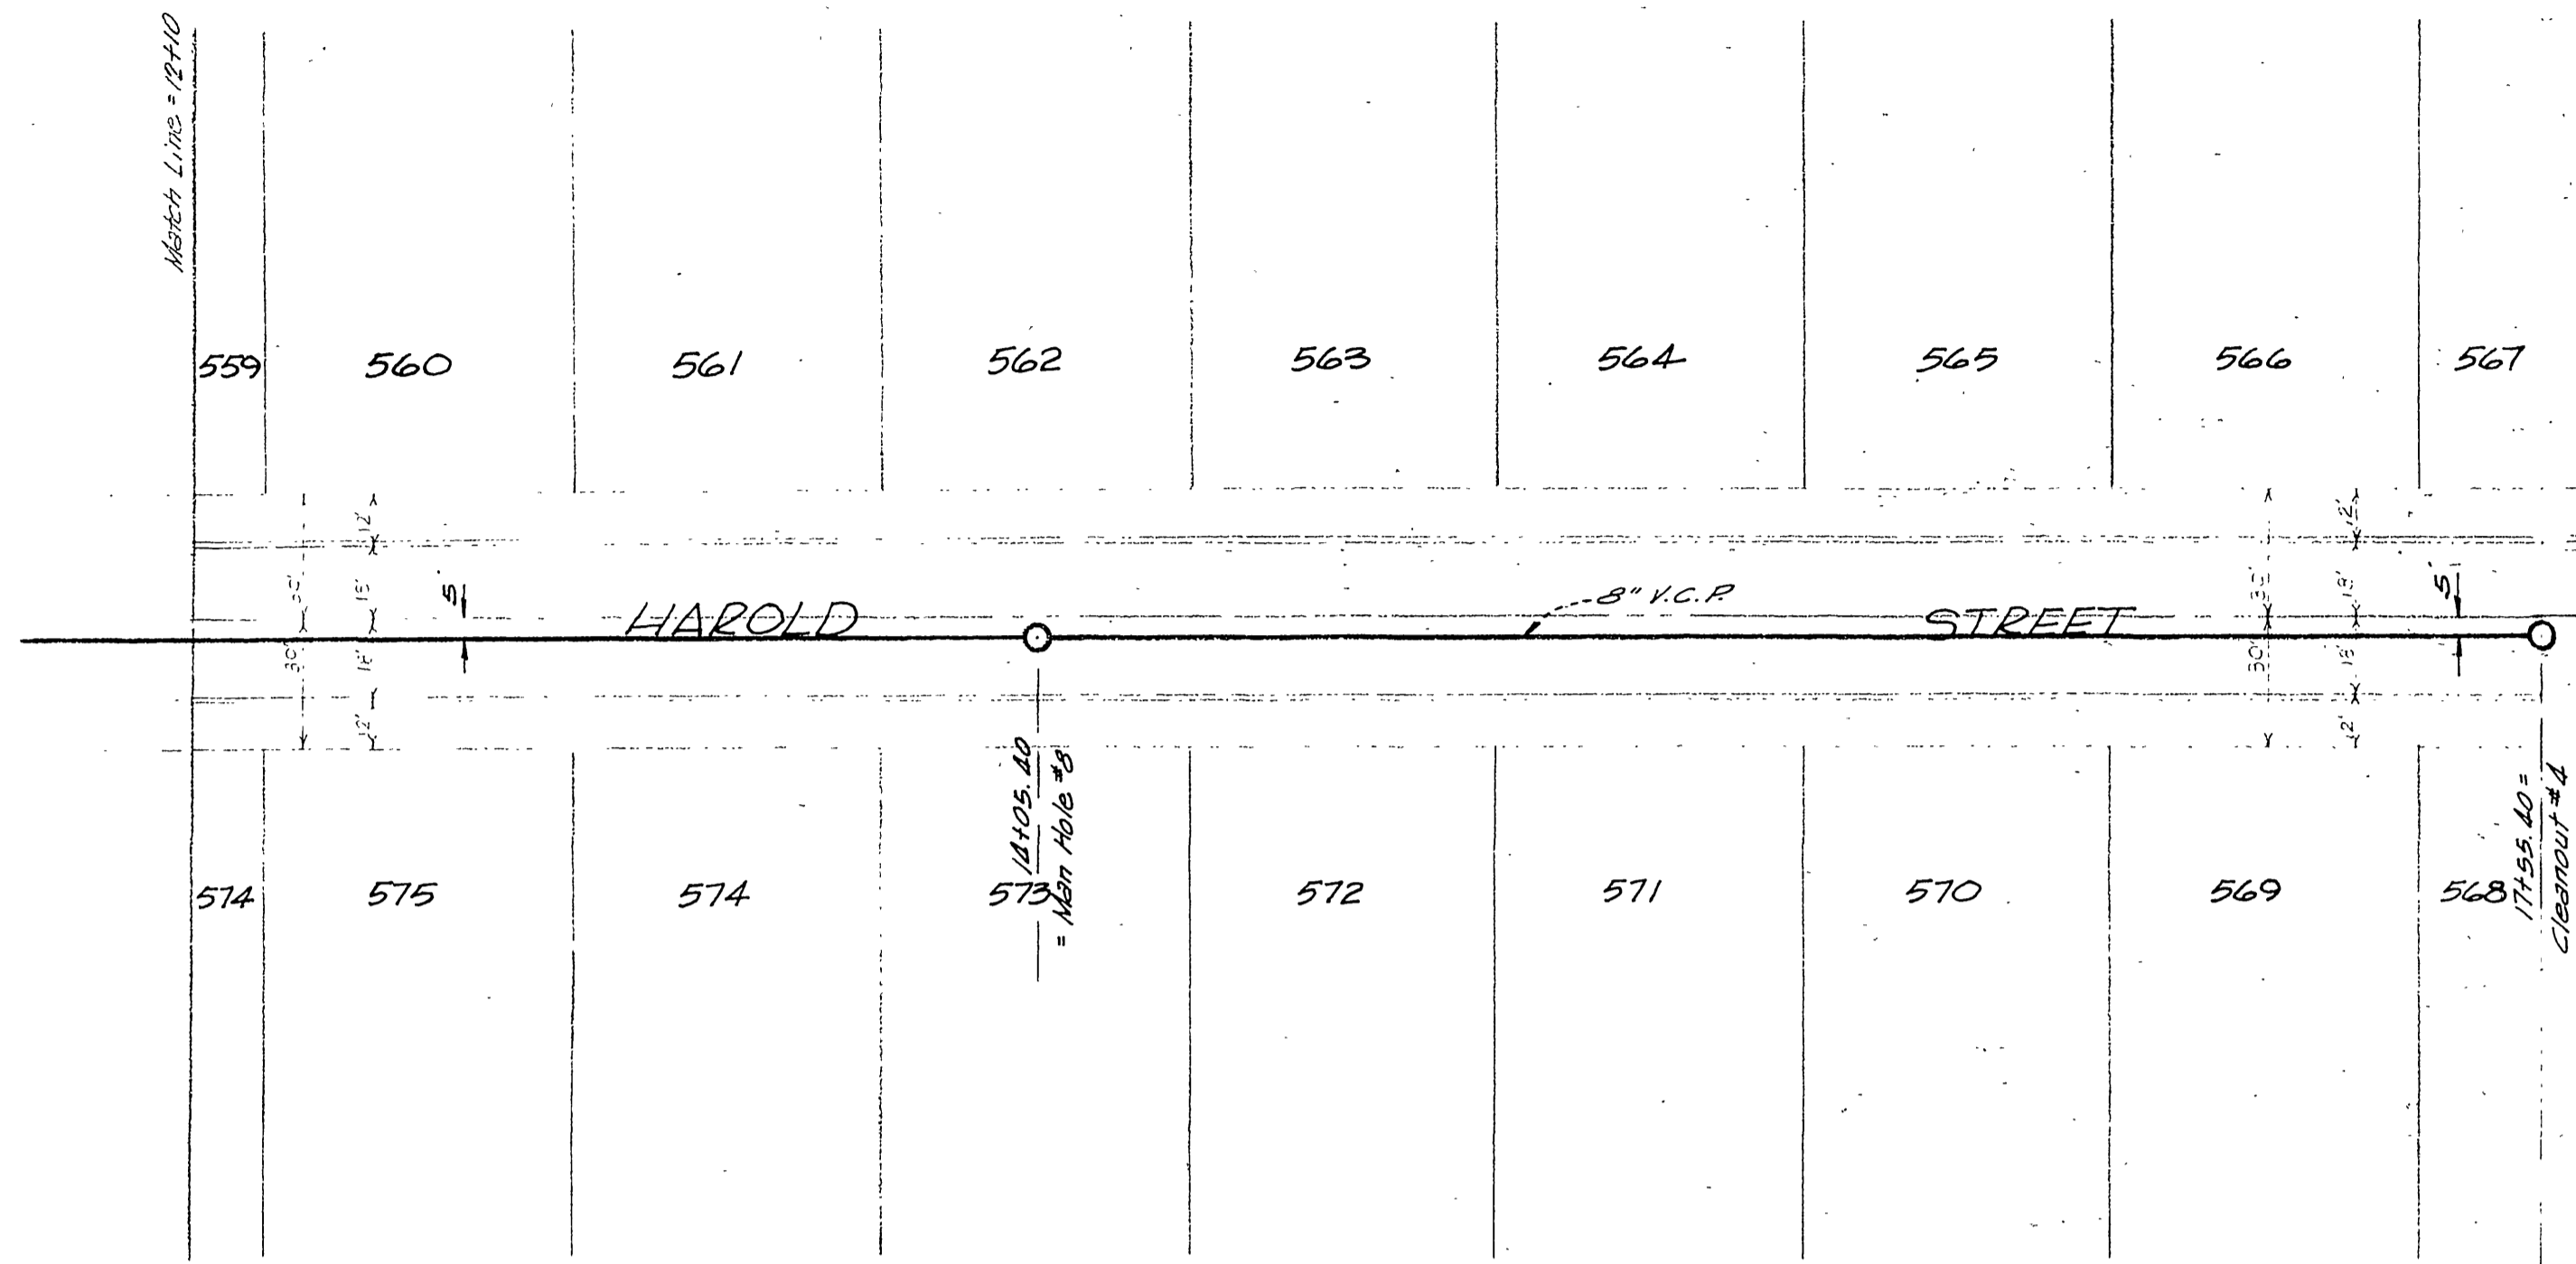

HAROLD STREET

DUNCAN DRIVE

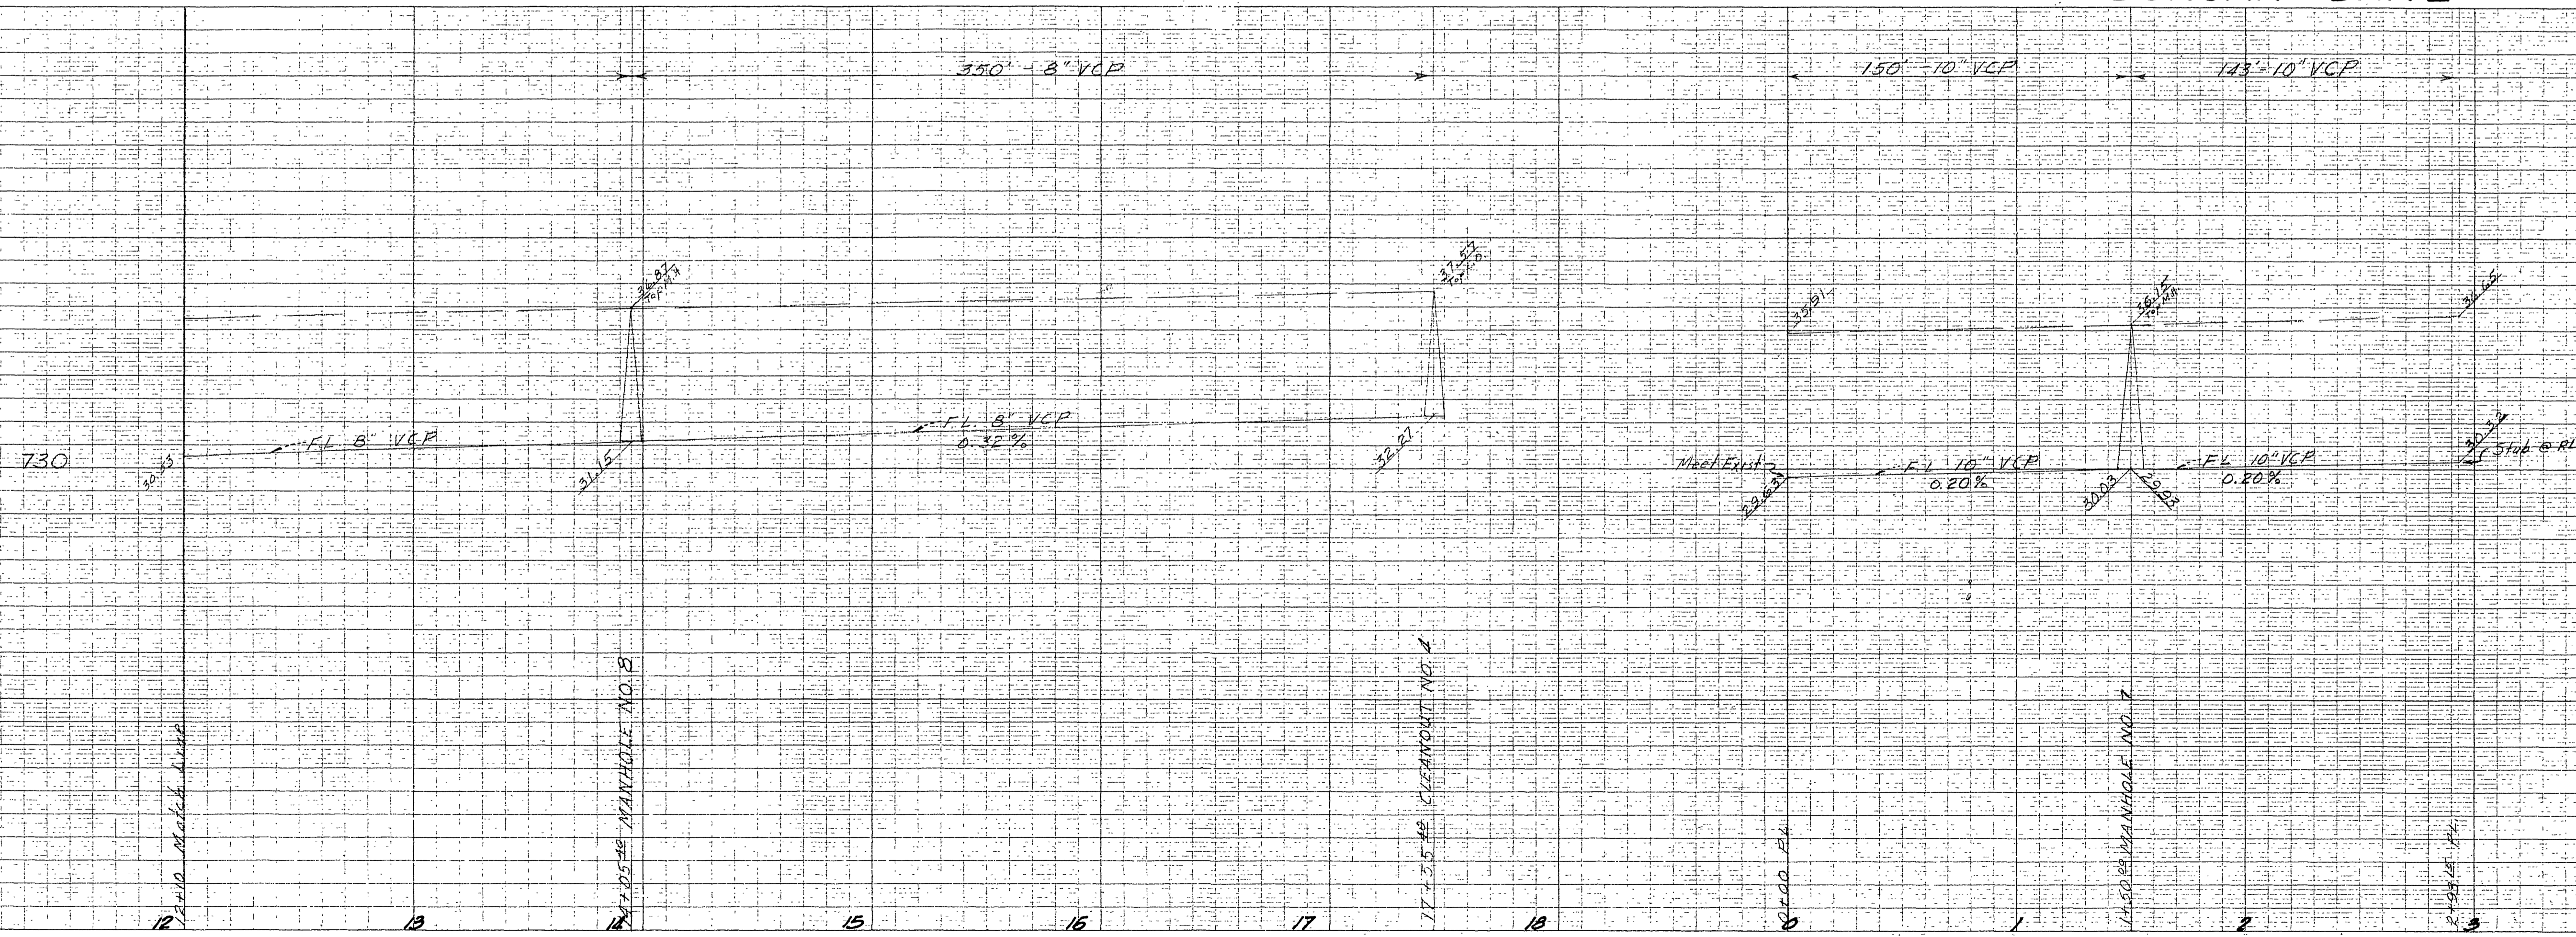

MADE IN U.S.A. CLEARPRINT PAPER CO. CLEARPRINT PROFILE PAPER A. CLEARPRINT PAPER CO. CLEARPRINT PAPER A. MADE IN U.S.A.