

DATE	DESCRIPTION



DWG NO. 101-115-115-115-115-115
 DATE 12-1-75
 SCALE 1" = 40'

NO.	DATE	DESCRIPTION

REVISION	DATE	DESCRIPTION
1	12-1-75	Added 1" Private Sewer Line to 101-115-115-115-115-115
2	12-1-75	Revised Stationing to 101-115-115-115-115-115
3	12-1-75	Added Stationing to 101-115-115-115-115-115
4	12-1-75	Added Stationing to 101-115-115-115-115-115

CITY OF RIVERSIDE, CALIFORNIA
 DEPARTMENT OF PUBLIC WORKS
 TRACT 101-115-115-115-115-115
 S-366
 1 of 1

★ "AS BUILT" 12-7-65 HB.

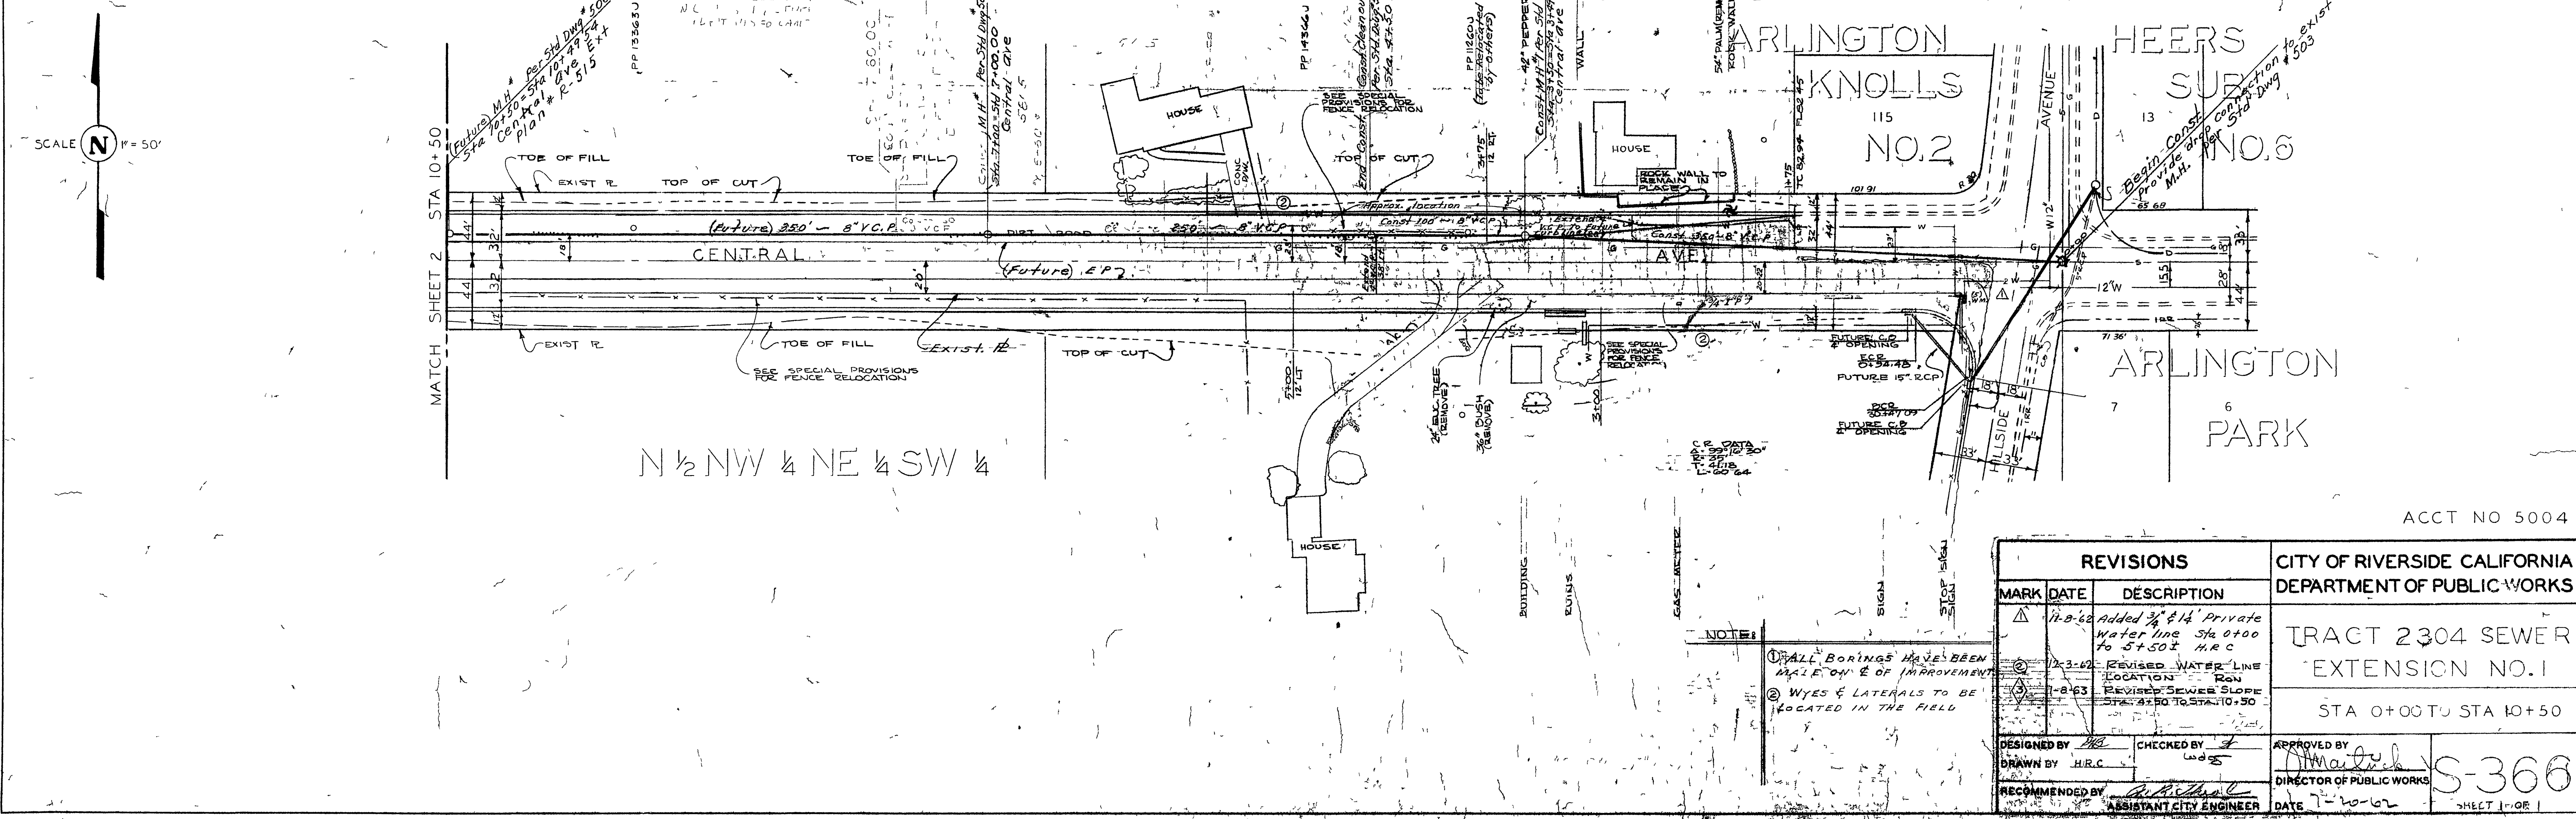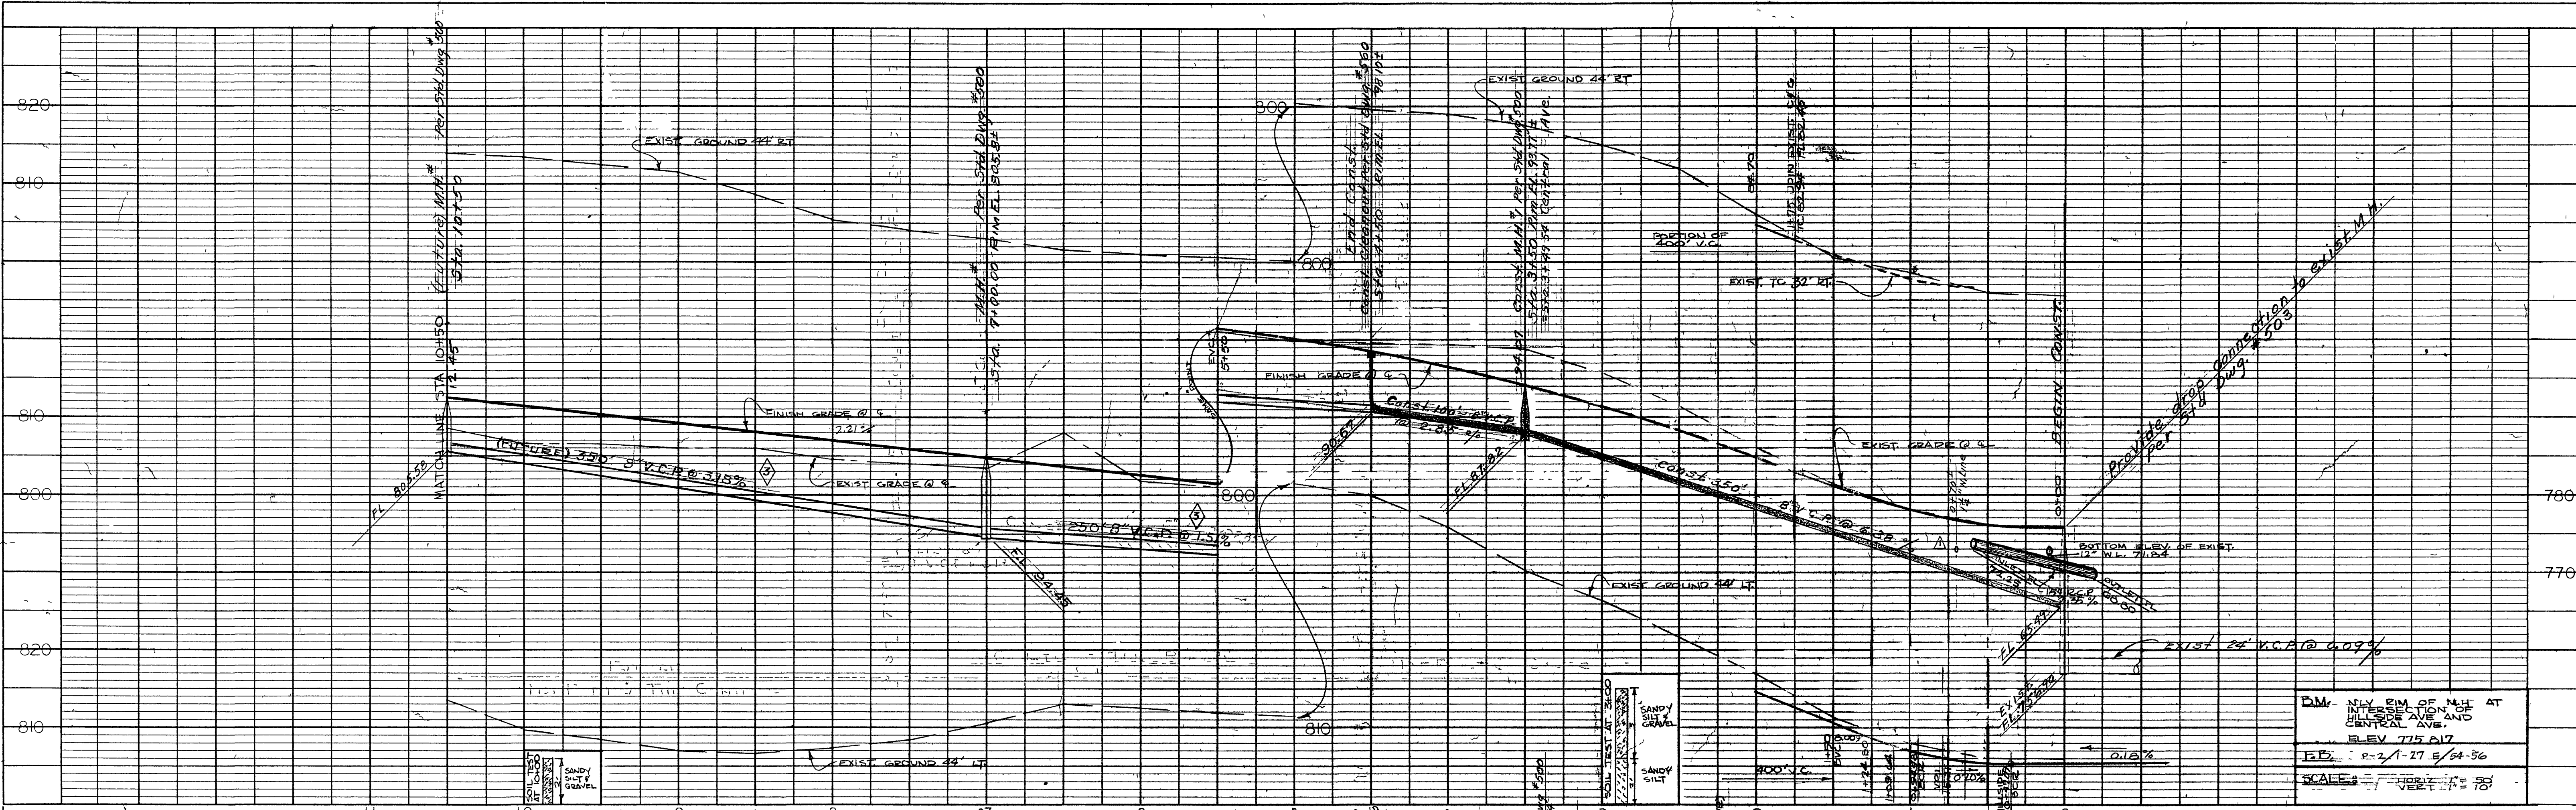

SCALE N 1" = 50'

DM: NLY RIM OF M.H. AT INTERSECTION AND CENTRAL AVE.
ELEV 775.617
P.D. R-2/1-27 E/24-56
SCALE: 1" = 10' HORIZ. 1" = 2' VERT.

REVISIONS		CITY OF RIVERSIDE CALIFORNIA DEPARTMENT OF PUBLIC WORKS	
MARK	DATE	DESCRIPTION	
Δ	11-8-62	Added 3" x 1 1/2" Private Water line Sta 0+00 to 5+50 M.R.C.	TRACT 2304 SEWER EXTENSION NO. 1 STA 0+00 TO STA 10+50
○	12-3-62	REVISED WATER LINE LOCATION TO RAN	
⊙	1-8-63	REVISED SEWER SLOPE STA: 4+50 TO STA: 10+50	
DESIGNED BY [Signature]		CHECKED BY [Signature]	APPROVED BY [Signature]
DRAWN BY H.R.C.			DIRECTOR OF PUBLIC WORKS
RECOMMENDED BY [Signature]		DATE 10-62	S-366 SHEET 1 OF 1

PROFILE	NO.	DATE
SUMMER		
PLOTTED		
GRADES CHECKED		
BY: [Signature]		

PLAN	NO.	DATE
SUMMER		
PLOTTED		
ALIGNMENT CHECKED		
BY: [Signature]		