


BM ELEV. 800.55 - STEEL BAR IN
CONG. ON L. CRESTMORE AVE. AT
B.C. 16+63.52 - SEE P.B. 565/18
F.B. X-2743
SCALE: HOR. 1"=50'
VERT. 1"=5'

PROFILE	SUBMITTED	BY	DATE
NOTE BOOK NO.	PLOTTED		
	GRADES CHECKED		
	STRUCTURE NOTATIONS CHKD.		

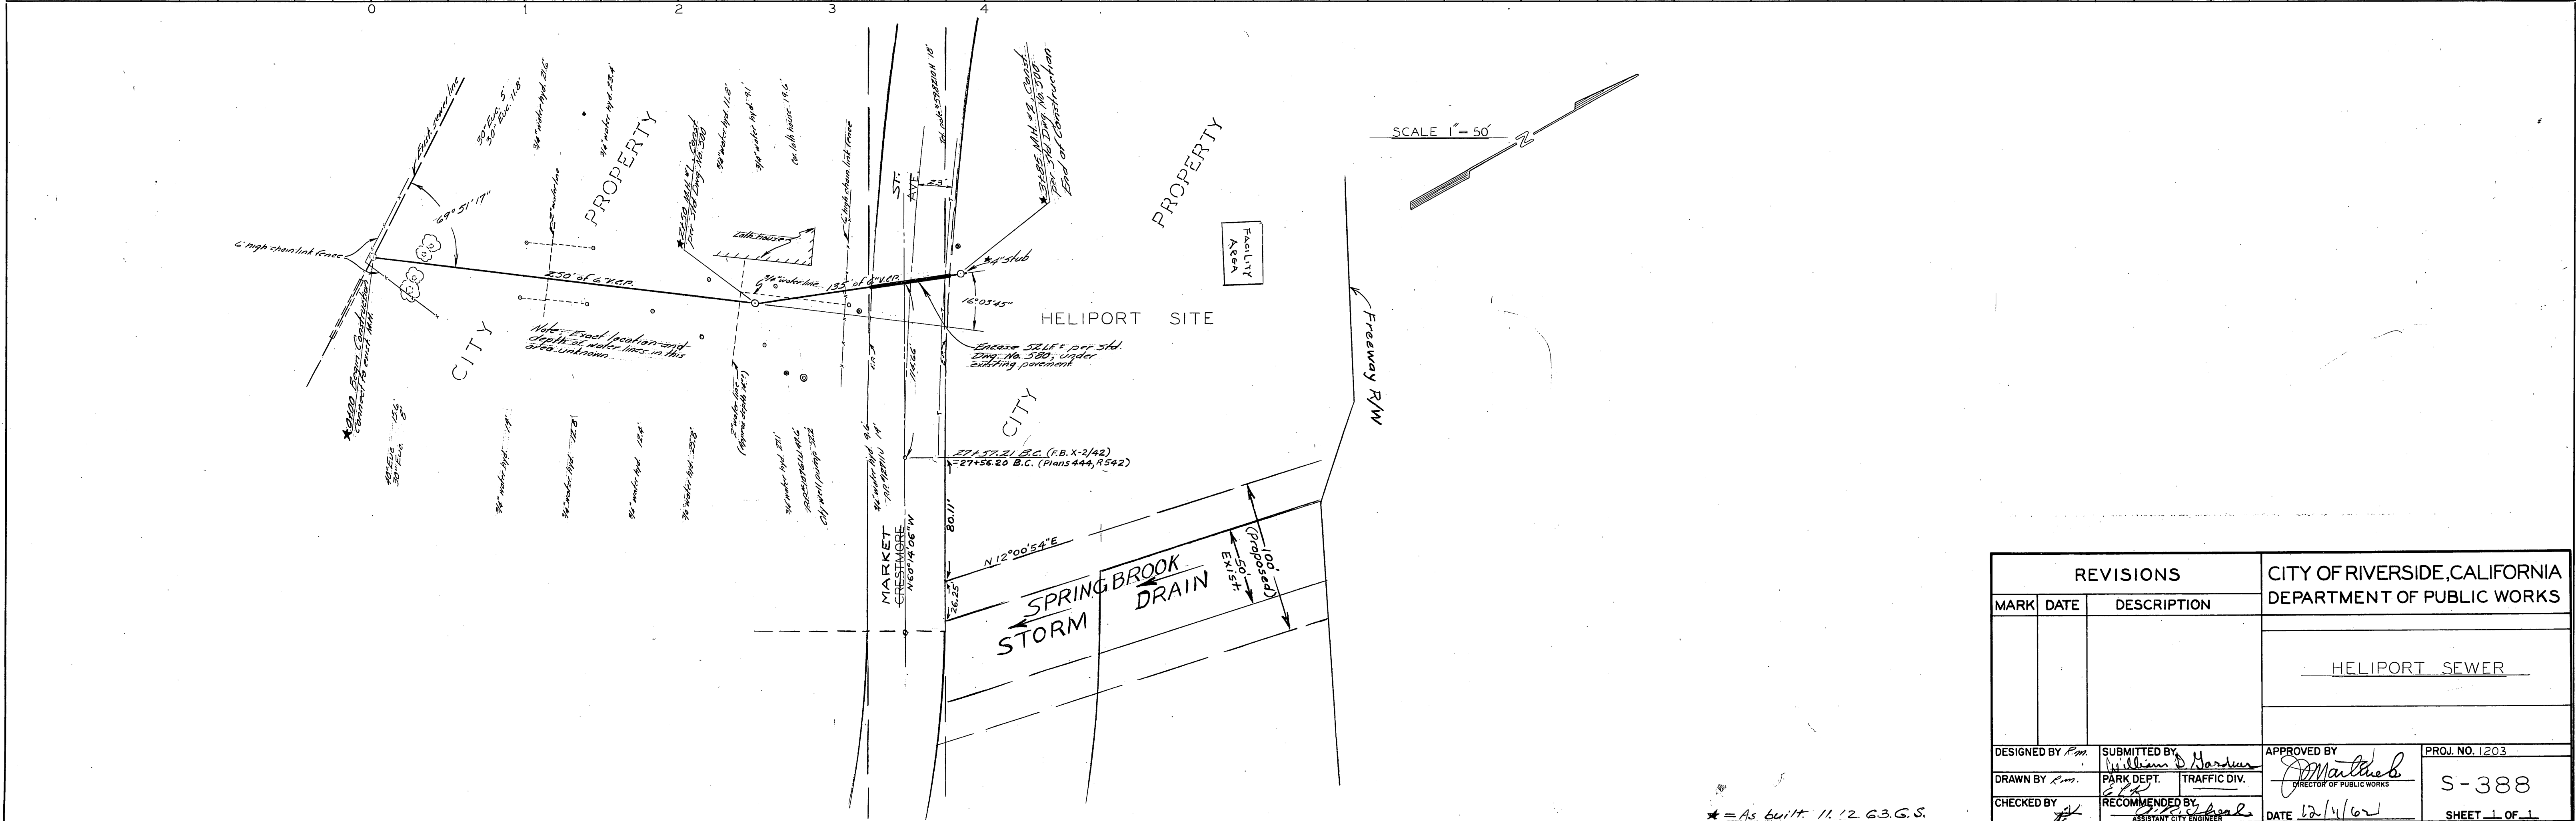

SCALE 1"=50'

PLAN	SUBMITTED	BY	DATE
NOTE BOOK NO.	PLOTTED		
	ALIGNMENT CHECKED		
	R/L OF WAY CHECKED		

REVISIONS			CITY OF RIVERSIDE, CALIFORNIA DEPARTMENT OF PUBLIC WORKS	
MARK	DATE	DESCRIPTION	HELIPORT SEWER	
DESIGNED BY	SubMITTED BY	APPROVED BY	PROJ. NO. 1203	
DRAWN BY	PARK DEPT. TRAFFIC DIV.	<i>Matthew</i> DIRECTOR OF PUBLIC WORKS	S-388	
CHECKED BY	RECOMMENDED BY	DATE 12/4/62	SHEET 1 OF 1	

* = As built. 11.12.63.G.S.