


PROFILE	DATE
SURVEYED	
PLANNED	
CHECKED	
BY	

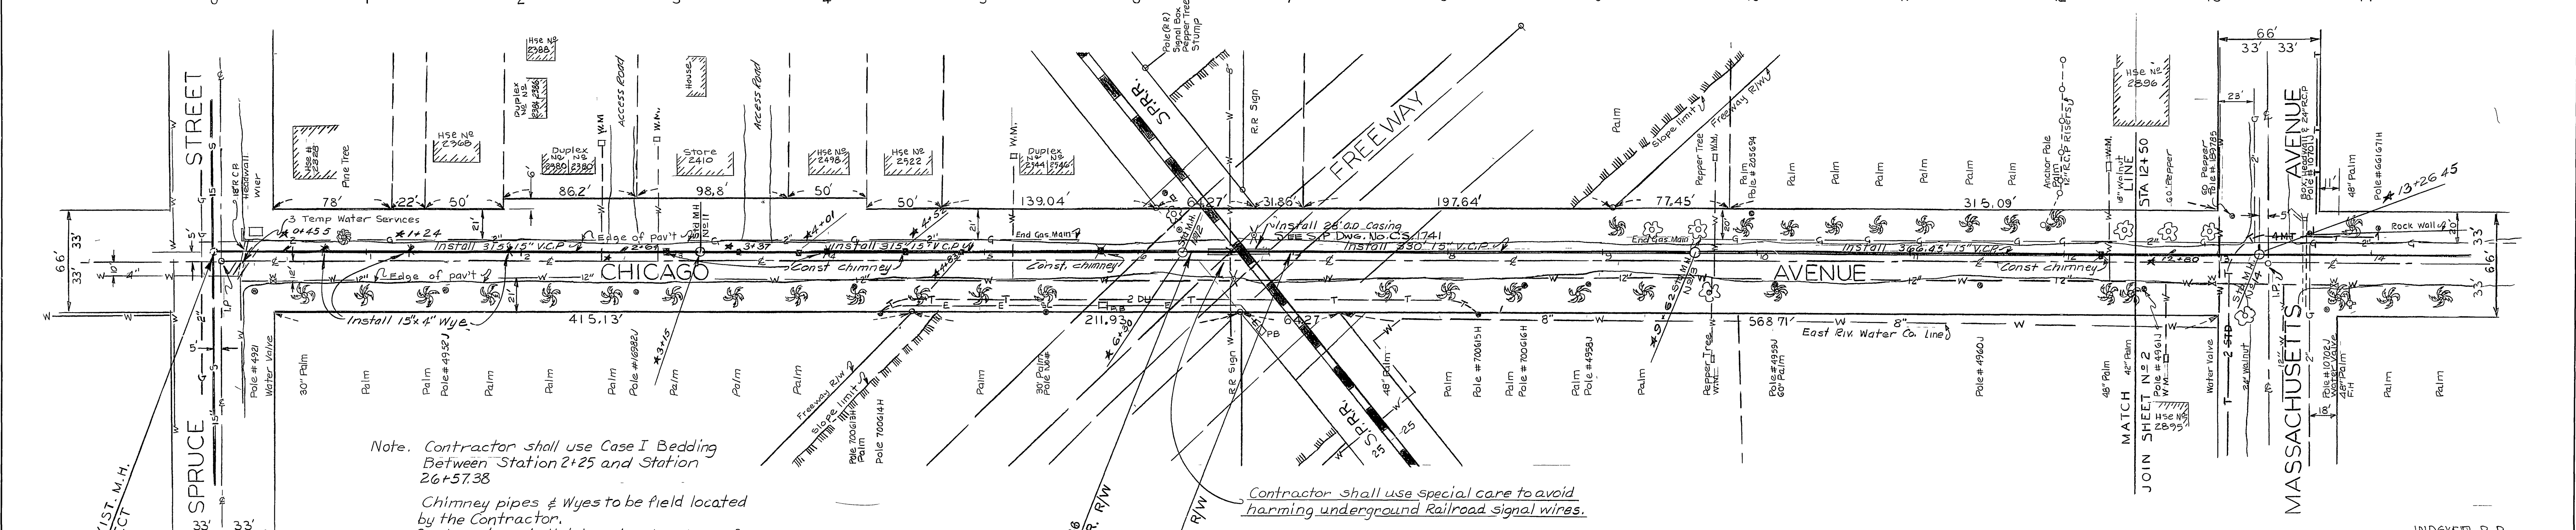


Note. Contractor shall use Case I Bedding Between Station 2+57.38 and Station 26+57.38

Chimney pipes & Wyes to be field located by the Contractor. Contractor shall determine location of existing house sewers and shall locate Chimney pipes and Wyes so as to be most economically connected to future laterals

House locations are not to scale and shown on lot occupied only.


NOTE:
FOR SPRUCE STREET SEWER
SEE PLAN S-228

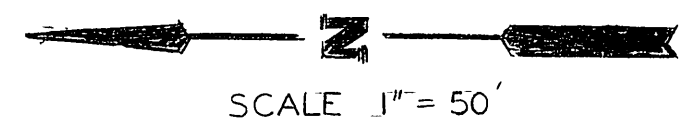

* = As built 10.25.63 GS

PLAN	DATE
SURVEYED	
PLANNED	
CHECKED	
BY	

REVISIONS		CITY OF RIVERSIDE, CALIFORNIA DEPARTMENT OF PUBLIC WORKS	
MARK	DATE	DESCRIPTION	
DESIGNED BY		APPROVED BY	
DRAWN BY		PROJECT NO. 50339	
CHECKED BY		S-409	
		DATE 4-19-63	
		SHEET 1 OF 2	

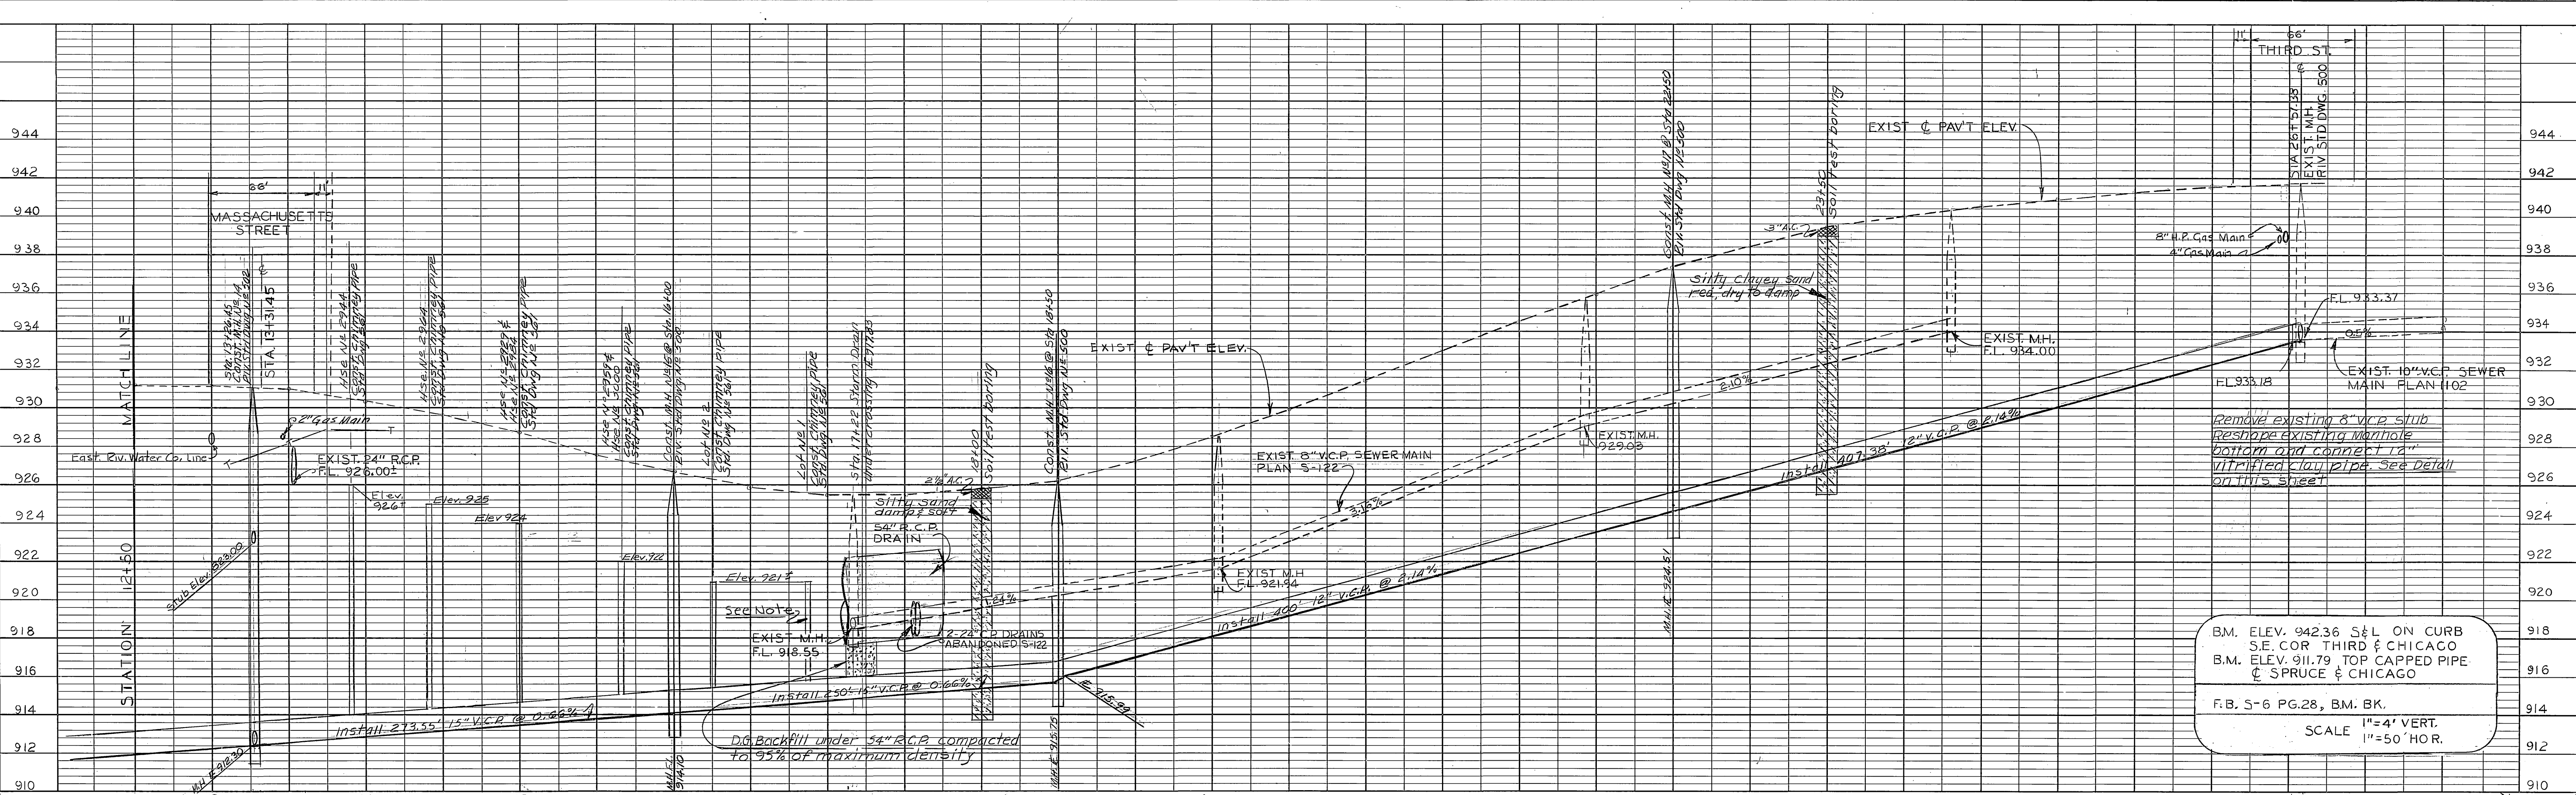


Remove existing 8" v.c.p. stub Reshape existing manhole bottom and connect to 10" vitrified clay pipe. See Detail on this sheet.

B.M. ELEV. 942.36 S&L ON CURB S.E. COR. THIRD & CHICAGO
B.M. ELEV. 911.79 TOP CAPPED PIPE & SPRUCE & CHICAGO


F.B. S-6 PG.28, B.M. BK.
SCALE 1"=4' VERT.
1"=50' HOR.

PROFILE	DATE	BY
NOTED		
FLATTED		
CHECKED		
STRUCTURE		
NOTATIONS		
CRD.		

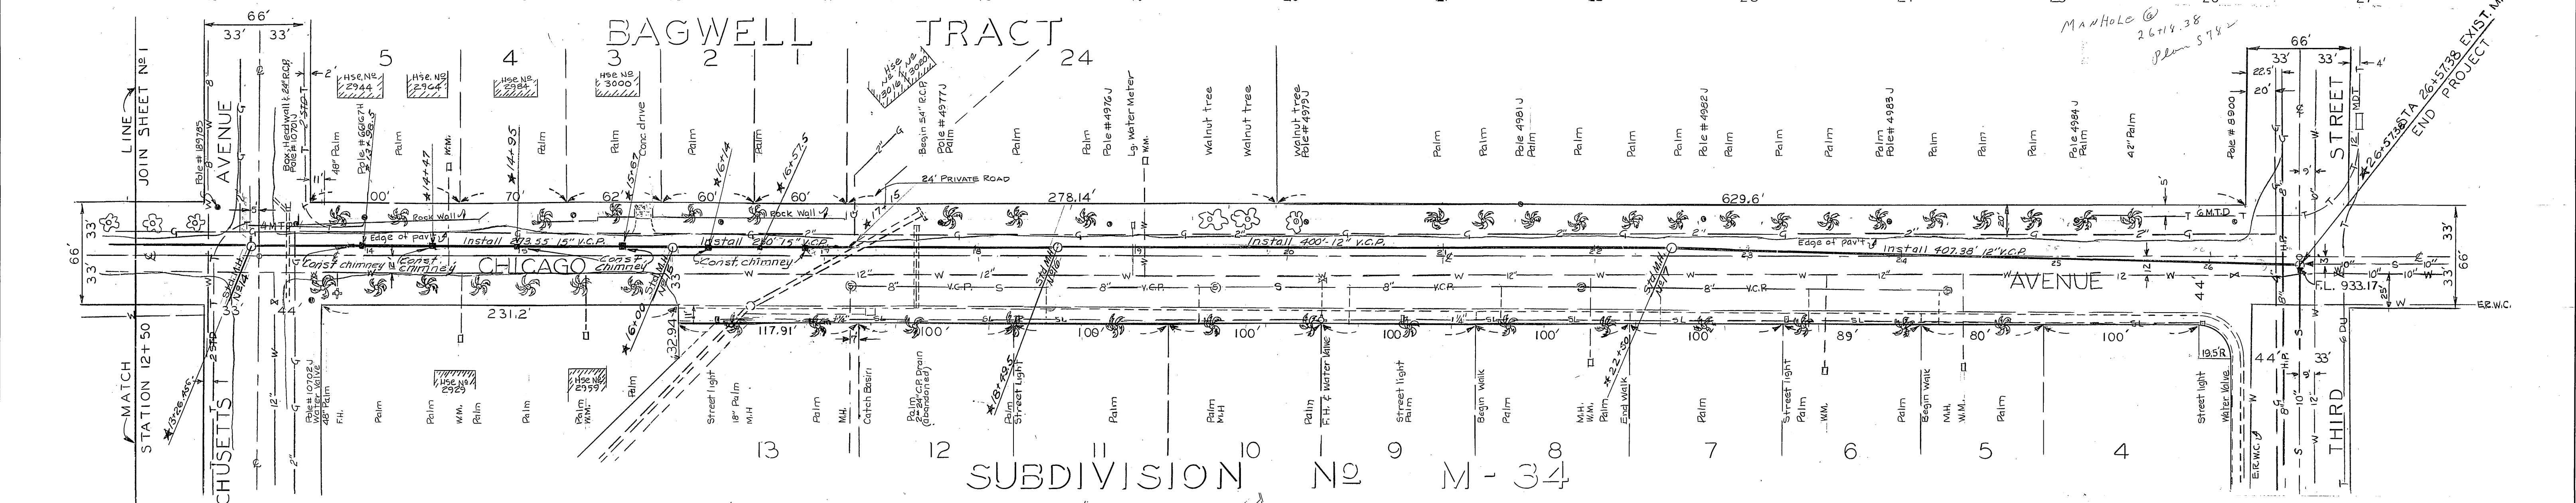

Note: House locations are not to scale and shown on lot occupied only.

Note: Chimney pipes to be field located by the Contractor. Contractor shall determine location of existing house sewers and shall locate chimney pipes so as to be most economically connected to future sewer laterals. Location and top of chimney pipe for Lot 1 shall be such that House No 3016 & 3020 can be served.

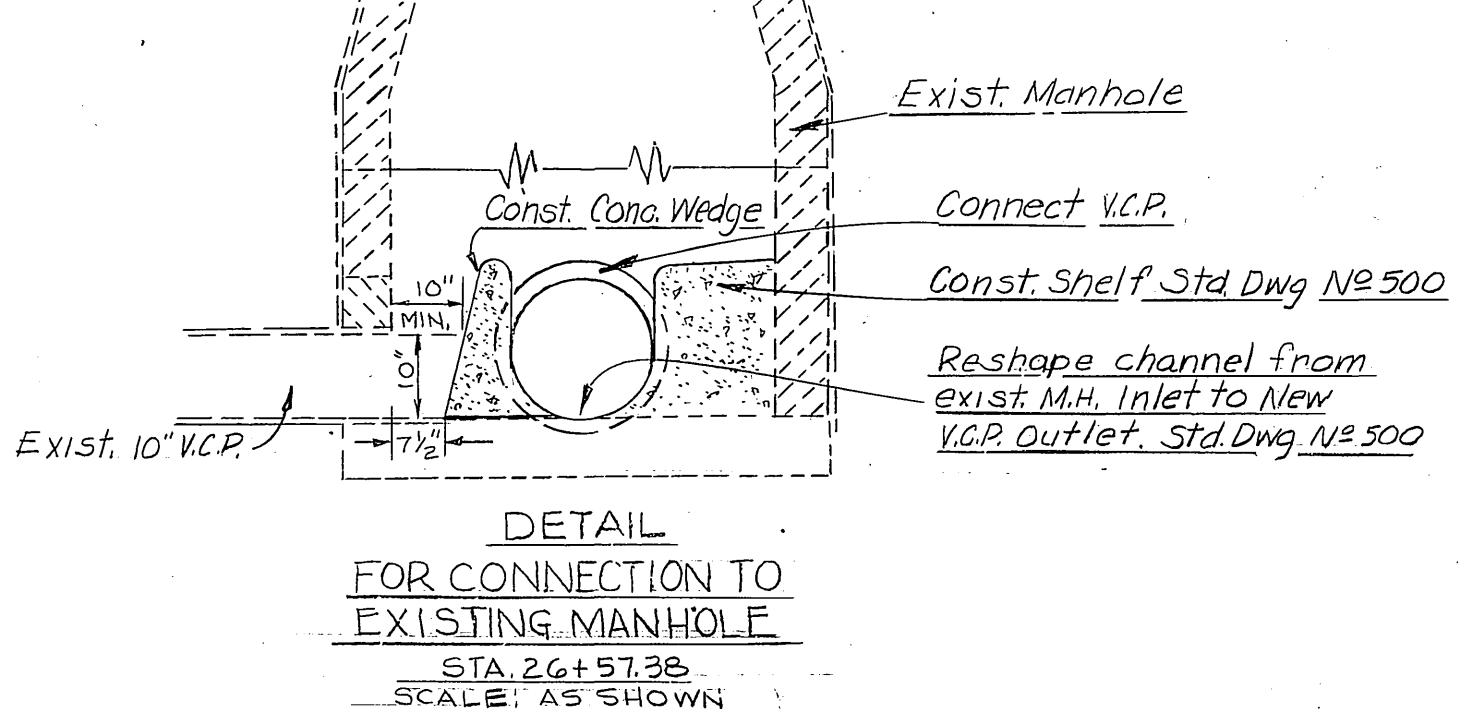

SCALE 1" = 50'

*As built 10.25.63. G.S.

PLAN	DATE	BY
NOTED		
FLATTED		
CHECKED		
ALIGNED		
NOTATIONS		
CRD.		

REVISIONS		CITY OF RIVERSIDE, CALIFORNIA DEPARTMENT OF PUBLIC WORKS	
MARK	DATE	DESCRIPTION	
DESIGNED BY 4/16		SUBMITTED BY William D. Hanson	APPROVED BY <i>[Signature]</i> DIRECTOR OF PUBLIC WORKS
DRAWN BY 5/2		PARK DEPT. TRAFFIC DIV.	PROJ. NO. 5039
CHECKED BY 8/16		RECOMMENDED BY <i>[Signature]</i> ASSISTANT CITY ENGINEER	DATE 4-19-63
CHICAGO AVENUE RELIEF TRUNK SEWER No. 2 CHICAGO AVENUE FROM SPRUCE STREET TO THIRD STREET			S-409 SHEET 2 OF 2