
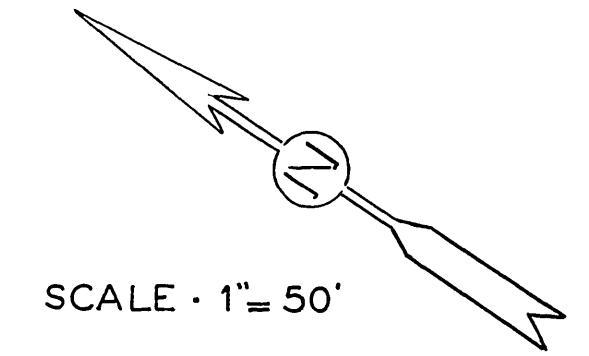


SCALES: HORIZONTAL 1" = 50'
 VERTICAL 1" = 5'

T.B.M. 946.91 "X" ON BOLT FH
 NE. COR. VICTORIA & MARY
 FB 576-54

PROFILE	
NO.	DATE

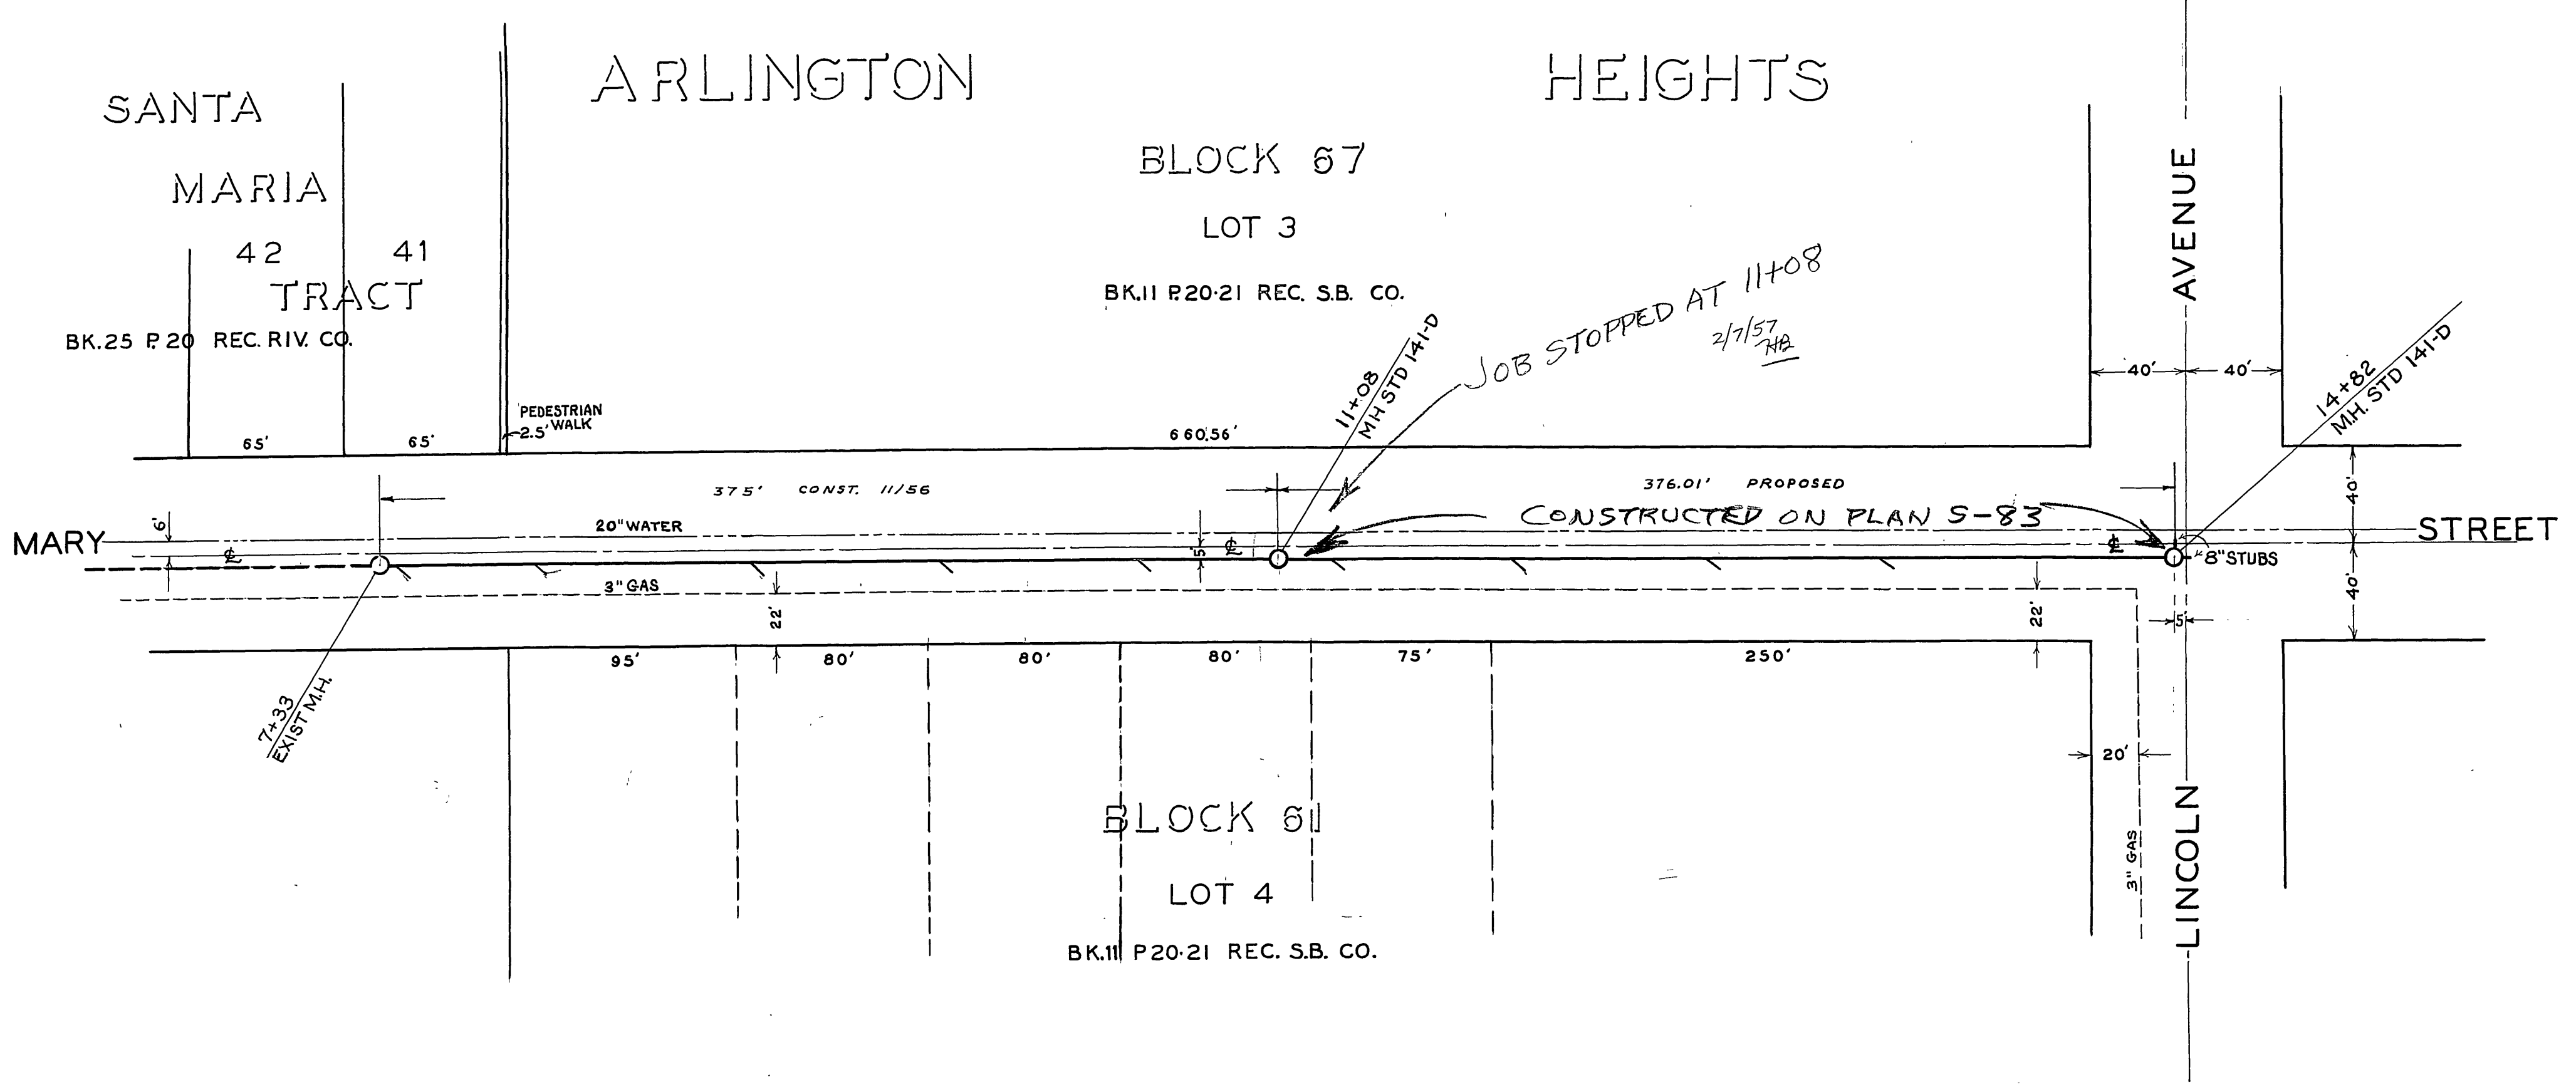

SCALE - 1" = 50'

PLAN	
NO.	DATE

REVISIONS		CITY OF RIVERSIDE CALIFORNIA DEPARTMENT OF PUBLIC WORKS	
MARK	DATE		DESCRIPTION

DESIGNED BY DRAWN BY T.L.S.	CHECKED BY <i>[Signature]</i>	APPROVED BY <i>[Signature]</i> DIRECTOR OF PUBLIC WORKS	S-41 SHEET 1 OF 1
RECOMMENDED BY <i>[Signature]</i> ASSISTANT CITY ENGINEER	DATE July 19, 1906		