


BEGINNING OF SEWER WORK
 NO SEWER CONSTRUCTION IN THIS AREA - SEE PROFILE

SLY LATERALS FROM STA. 52+00 TO STA. 59+00 ARE 55' FROM E

LEGEND

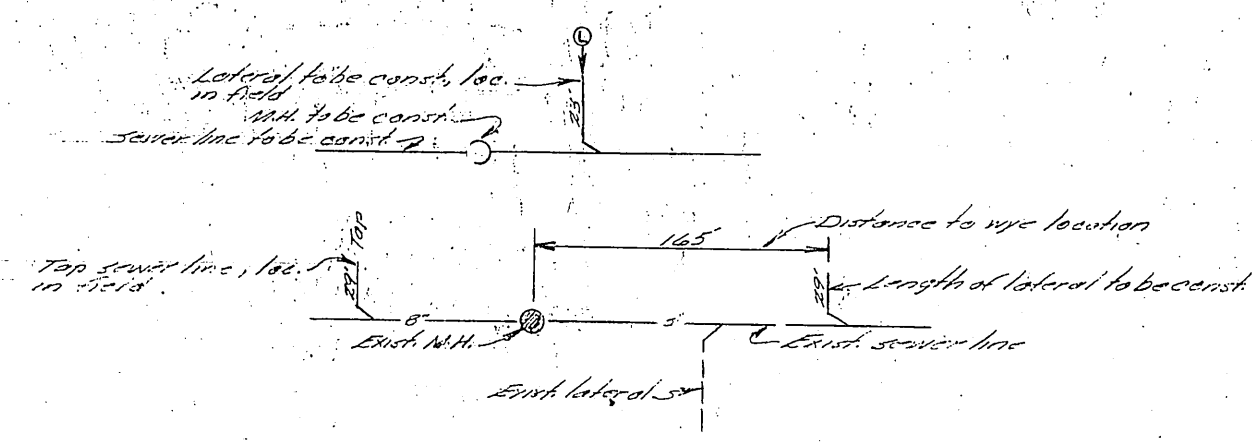

REVISIONS

DATE	DESCRIPTION
8-22-63	Revised plan per State review

CITY OF PLEASANTON
 DEPARTMENT OF PUBLIC WORKS

SANITARY SEWER

STA. 47+05.53
 TO
 STA. 62+00

PROJECT # 10-29-64 BE

Michael J. [Signature]

ACCT. NO. 5049


S-415

PROFILE

AP	2
NO. 1000	
DATE	
BY	



PLAN

AP	2
NO. 1000	
DATE	
BY	

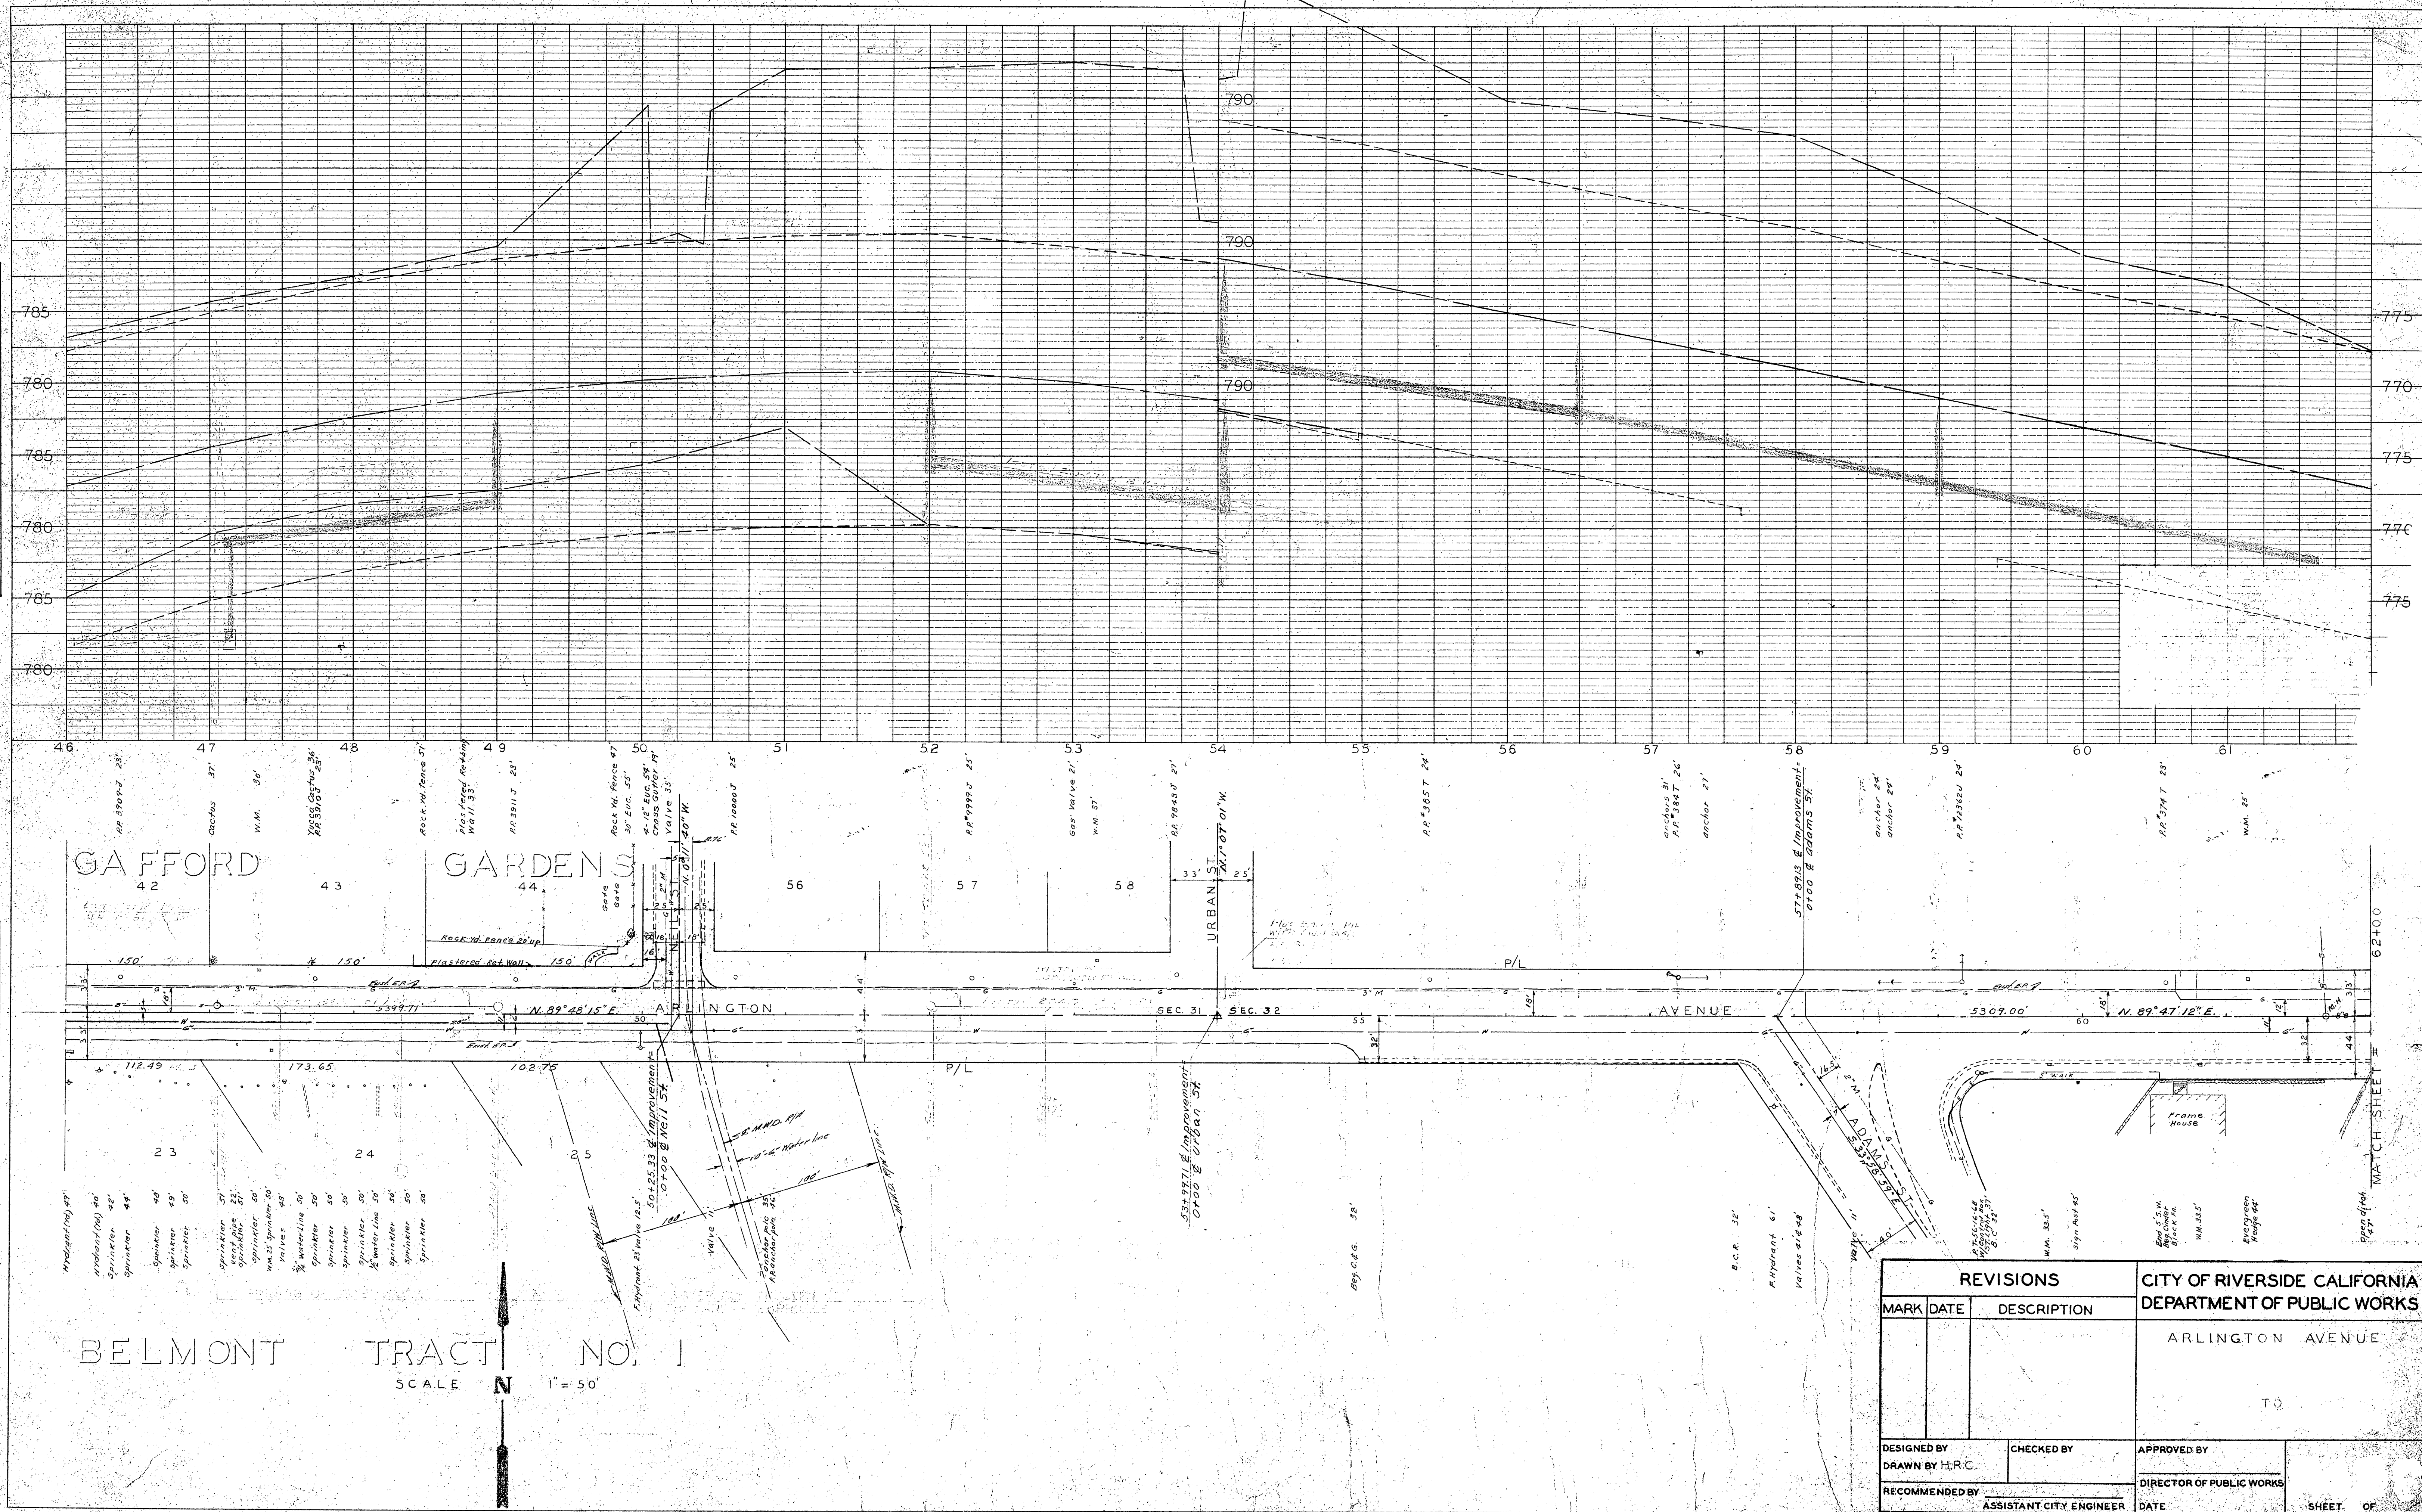

BELMONT TRACT NO. 1
 SCALE 1" = 50'

REVISIONS			CITY OF RIVERSIDE CALIFORNIA DEPARTMENT OF PUBLIC WORKS	
MARK	DATE	DESCRIPTION	ARLINGTON AVENUE	
			TO	
DESIGNED BY		CHECKED BY	APPROVED BY	
DRAWN BY H.R.C.			DIRECTOR OF PUBLIC WORKS	
RECOMMENDED BY		ASSISTANT CITY ENGINEER	DATE	SHEET OF

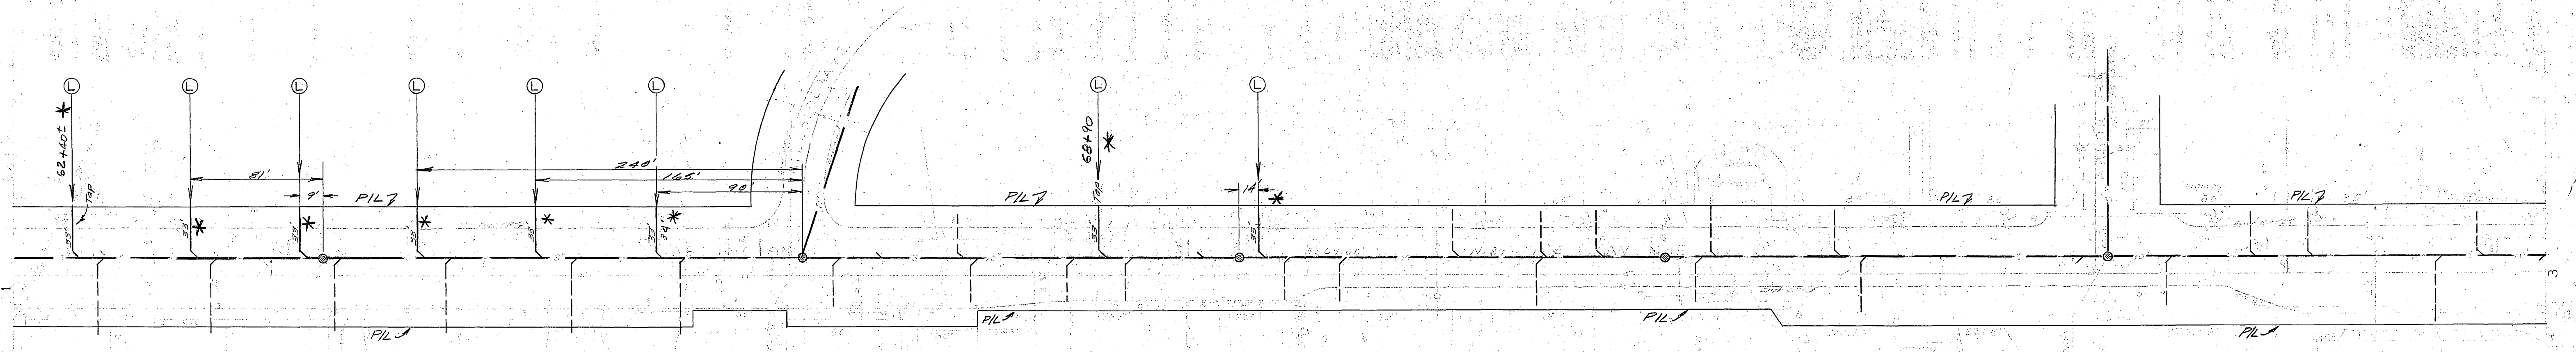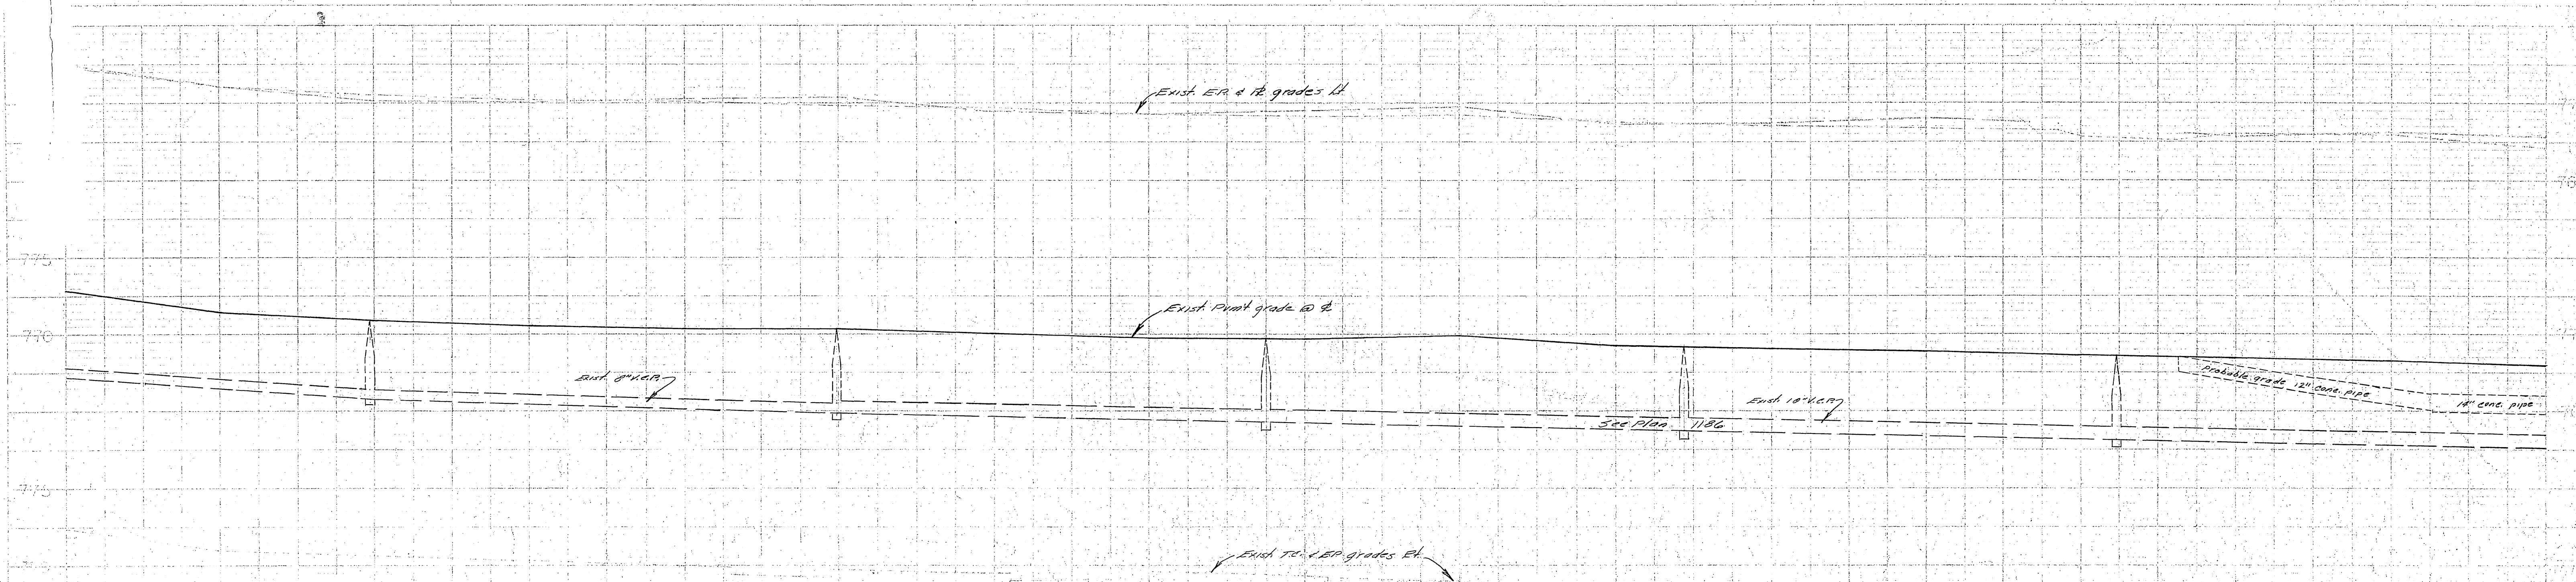

ST. PAUL PARK HO.

SCALE: 1\"/>

* As built
1-15-65

REVISIONS		CITY OF WYOMING SIDE
MARK	DATE	DESCRIPTION
52263		Revised plan per State Review for 605 width and

DEPARTMENT OF PUBLIC WORKS

SANITARY SEWER


STA. 62+00

STA. 78+00


ACCT. NO. 5049

S-415

W.D.G. J. Mantich
A.P. Thal 7-8-63

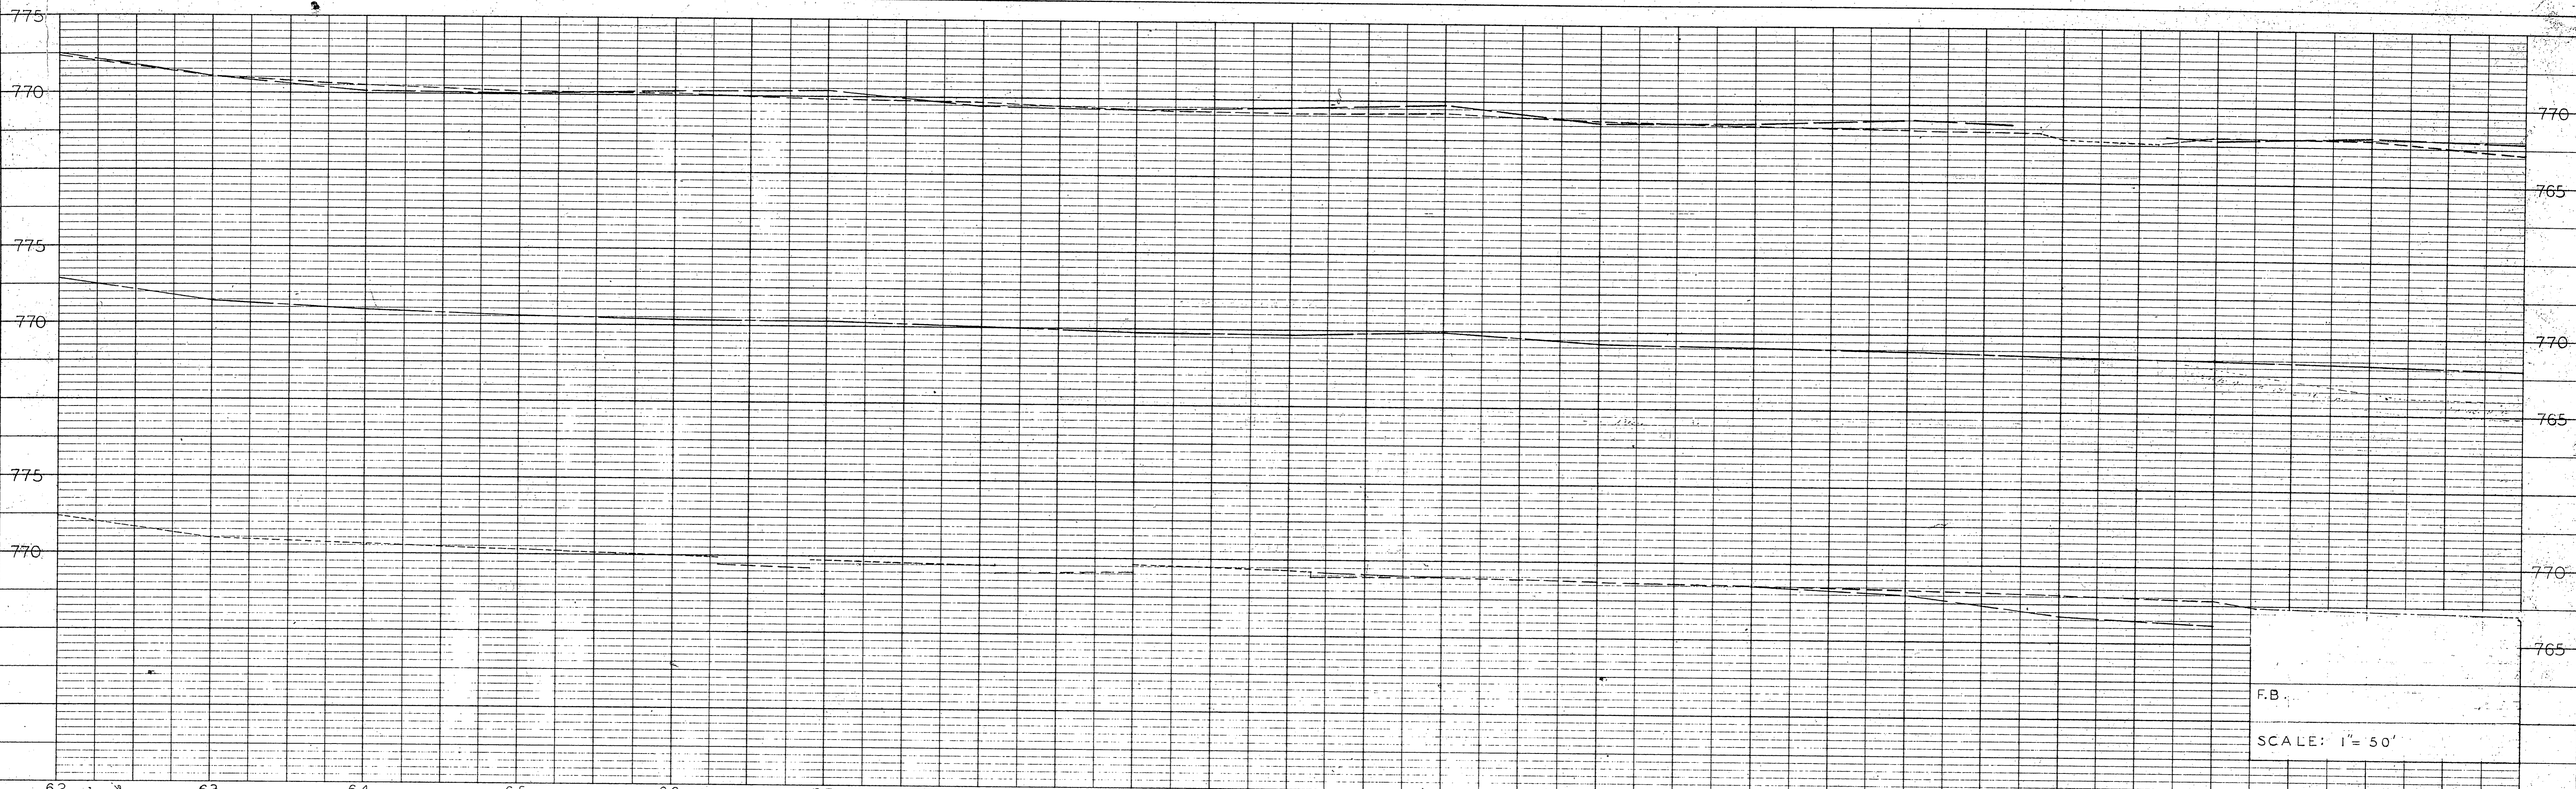

SCALE: 1" = 50'

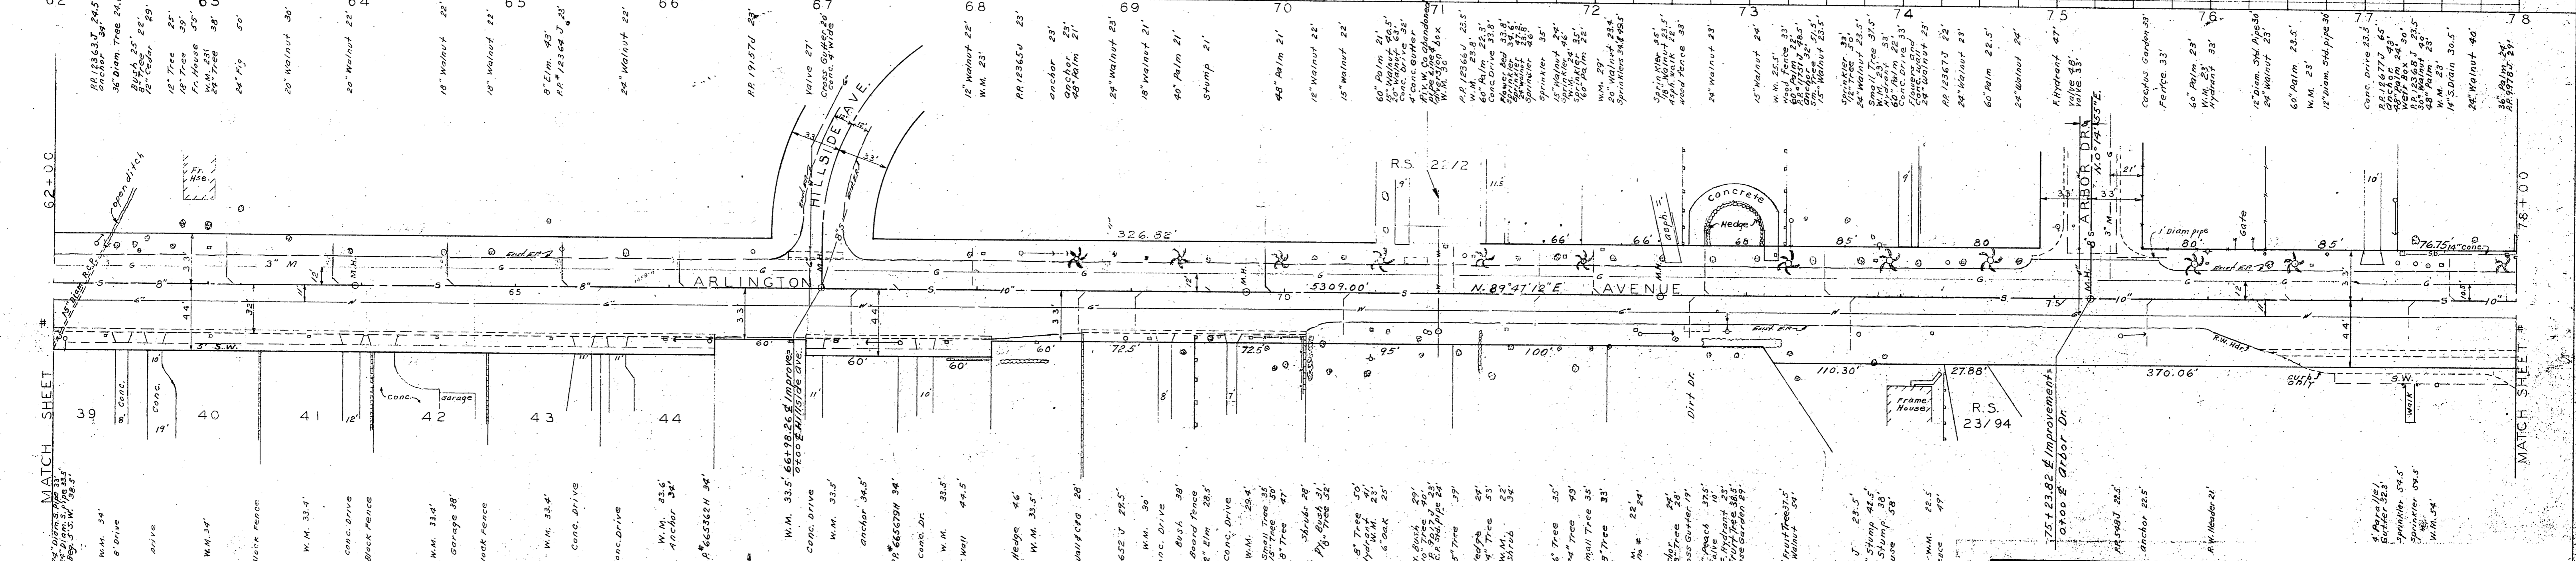

ST. PAUL PARK NO. 2

SCALE 1" = 50'



REVISIONS		CITY OF RIVERSIDE CALIFORNIA DEPARTMENT OF PUBLIC WORKS
MARK	DATE	
DESIGNED BY	CHECKED BY	APPROVED BY
DRAWN BY H.R.C.		
RECOMMENDED BY	ASSISTANT CITY ENGINEER	DIRECTOR OF PUBLIC WORKS
		DATE
		SHEET OF

PROFILE

DATE	
BY	
CHECKED	

PLAN

DATE	
BY	
CHECKED	

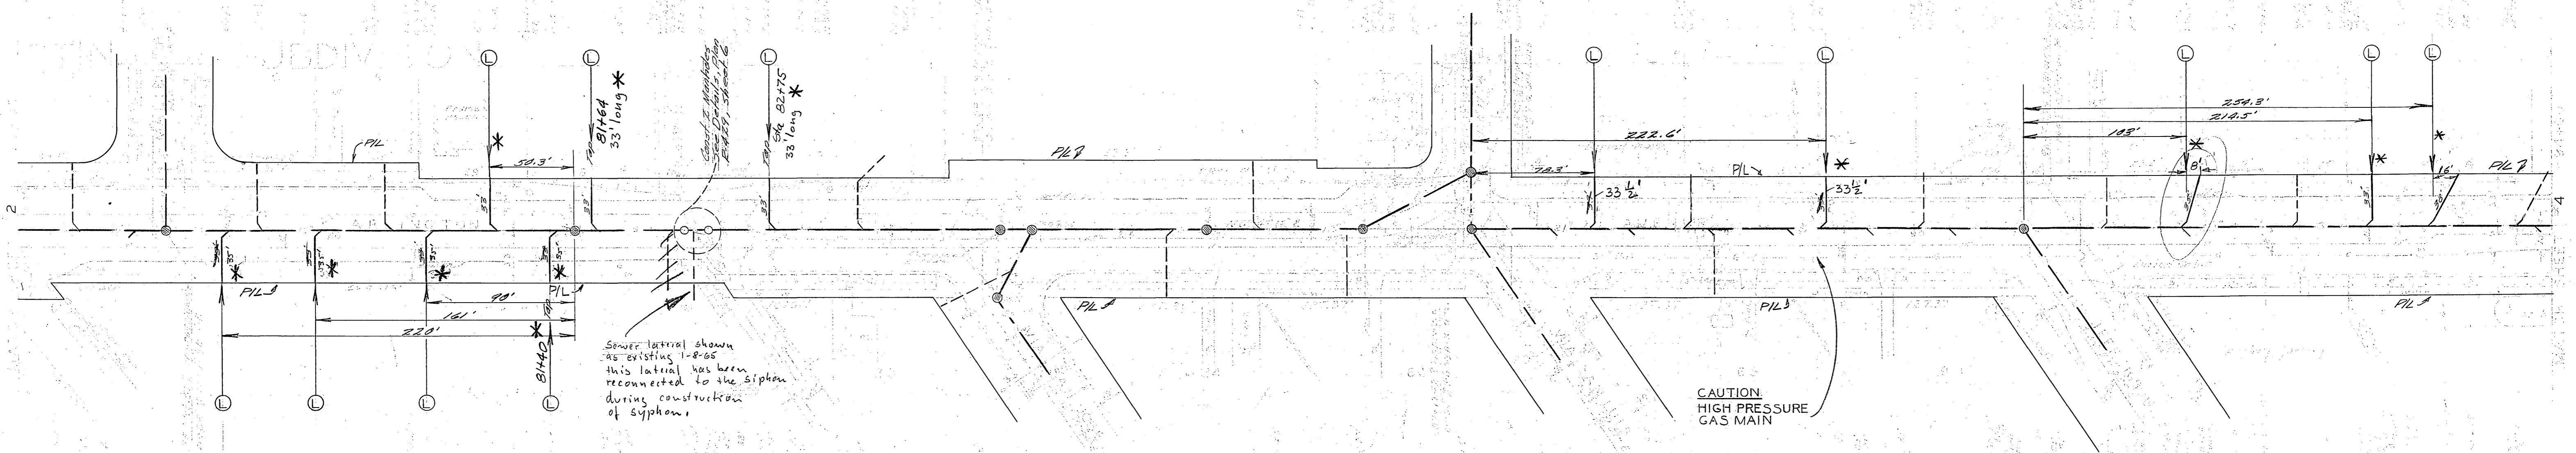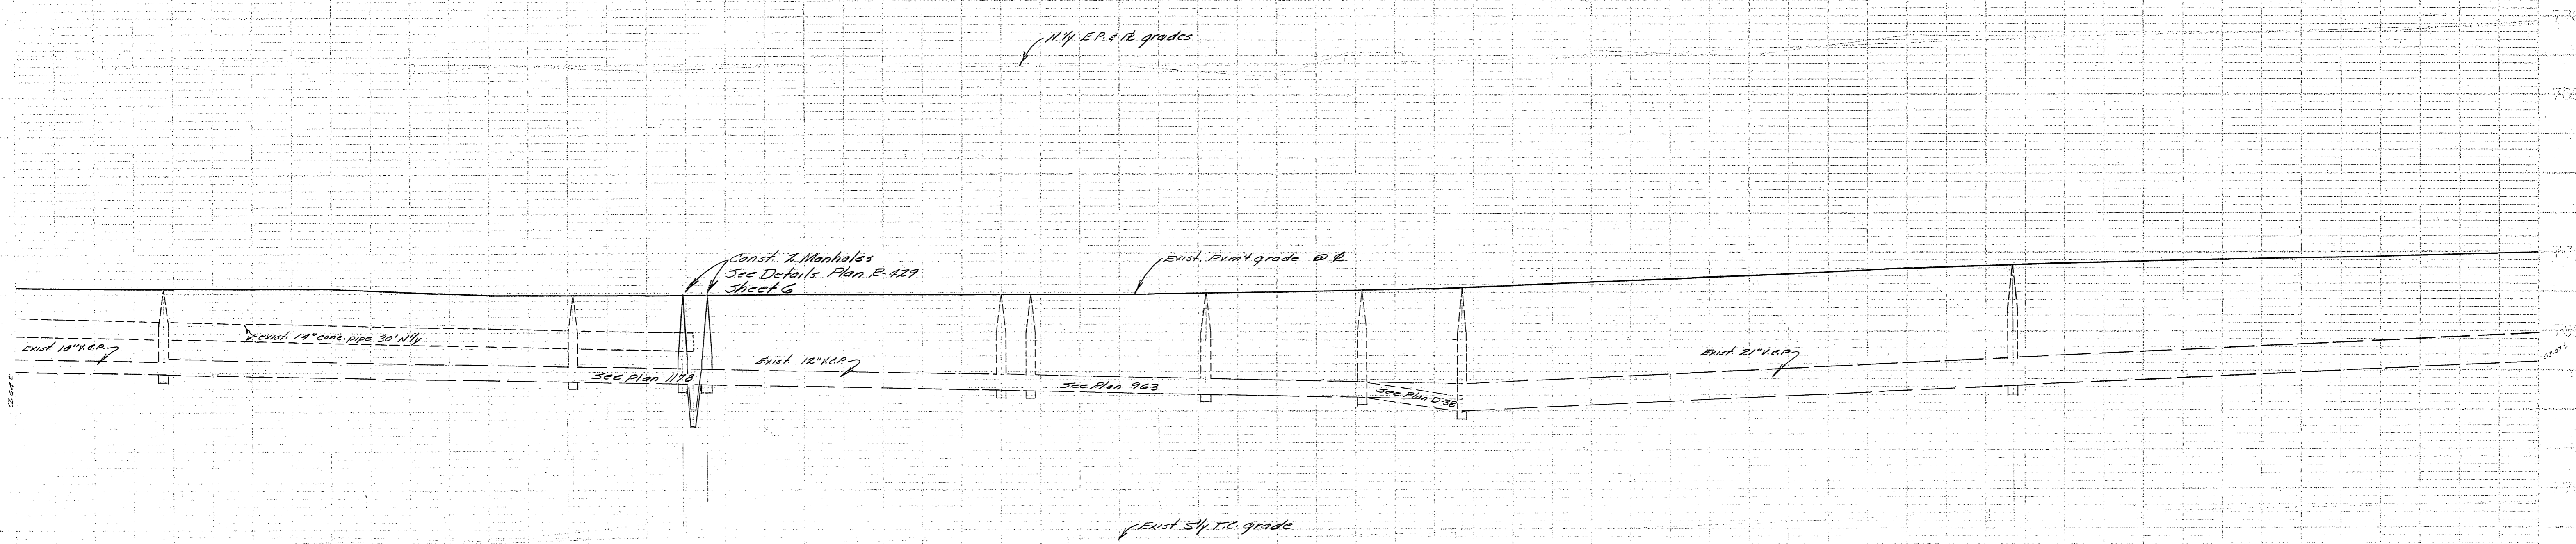



REVISIONS		CITY OF DAVIS, CALIFORNIA DEPARTMENT OF PUBLIC WORKS
MARK	DATE	
1	7-8-63	Revised plan per State Revenue 0001 was for Rev. 0002 Revised this sheet after second State revenue Com. # 001

SANITARY SEWER
 STA. 78+00
 STA. 94+00
 ACCT. NO. 5049
S-415
 3 4

All laterals built at 90° except laterals at approx. Sta 91+70 Lt. Sta 93+25 Lt.

* As built
7-15-63

Wags
A.P. Z. Seal
J. Matthews
7-8-63

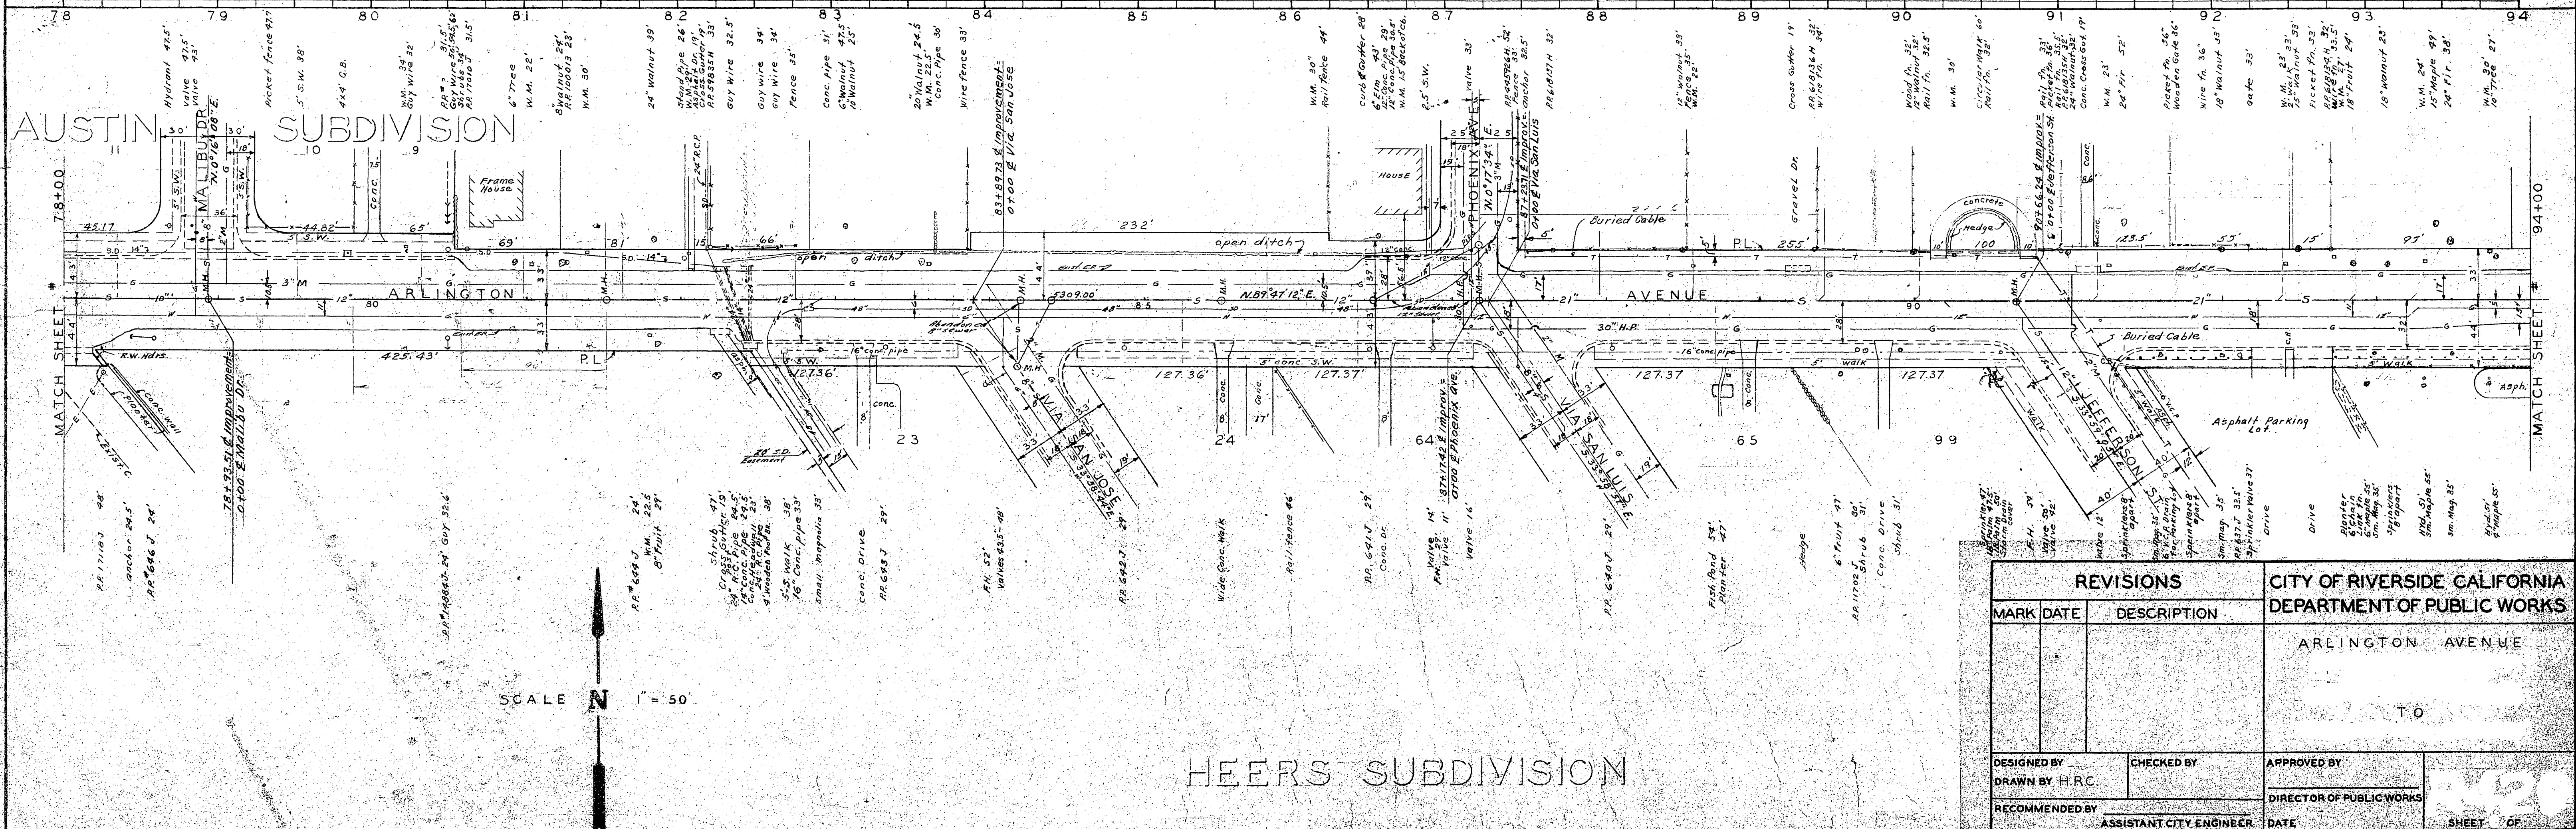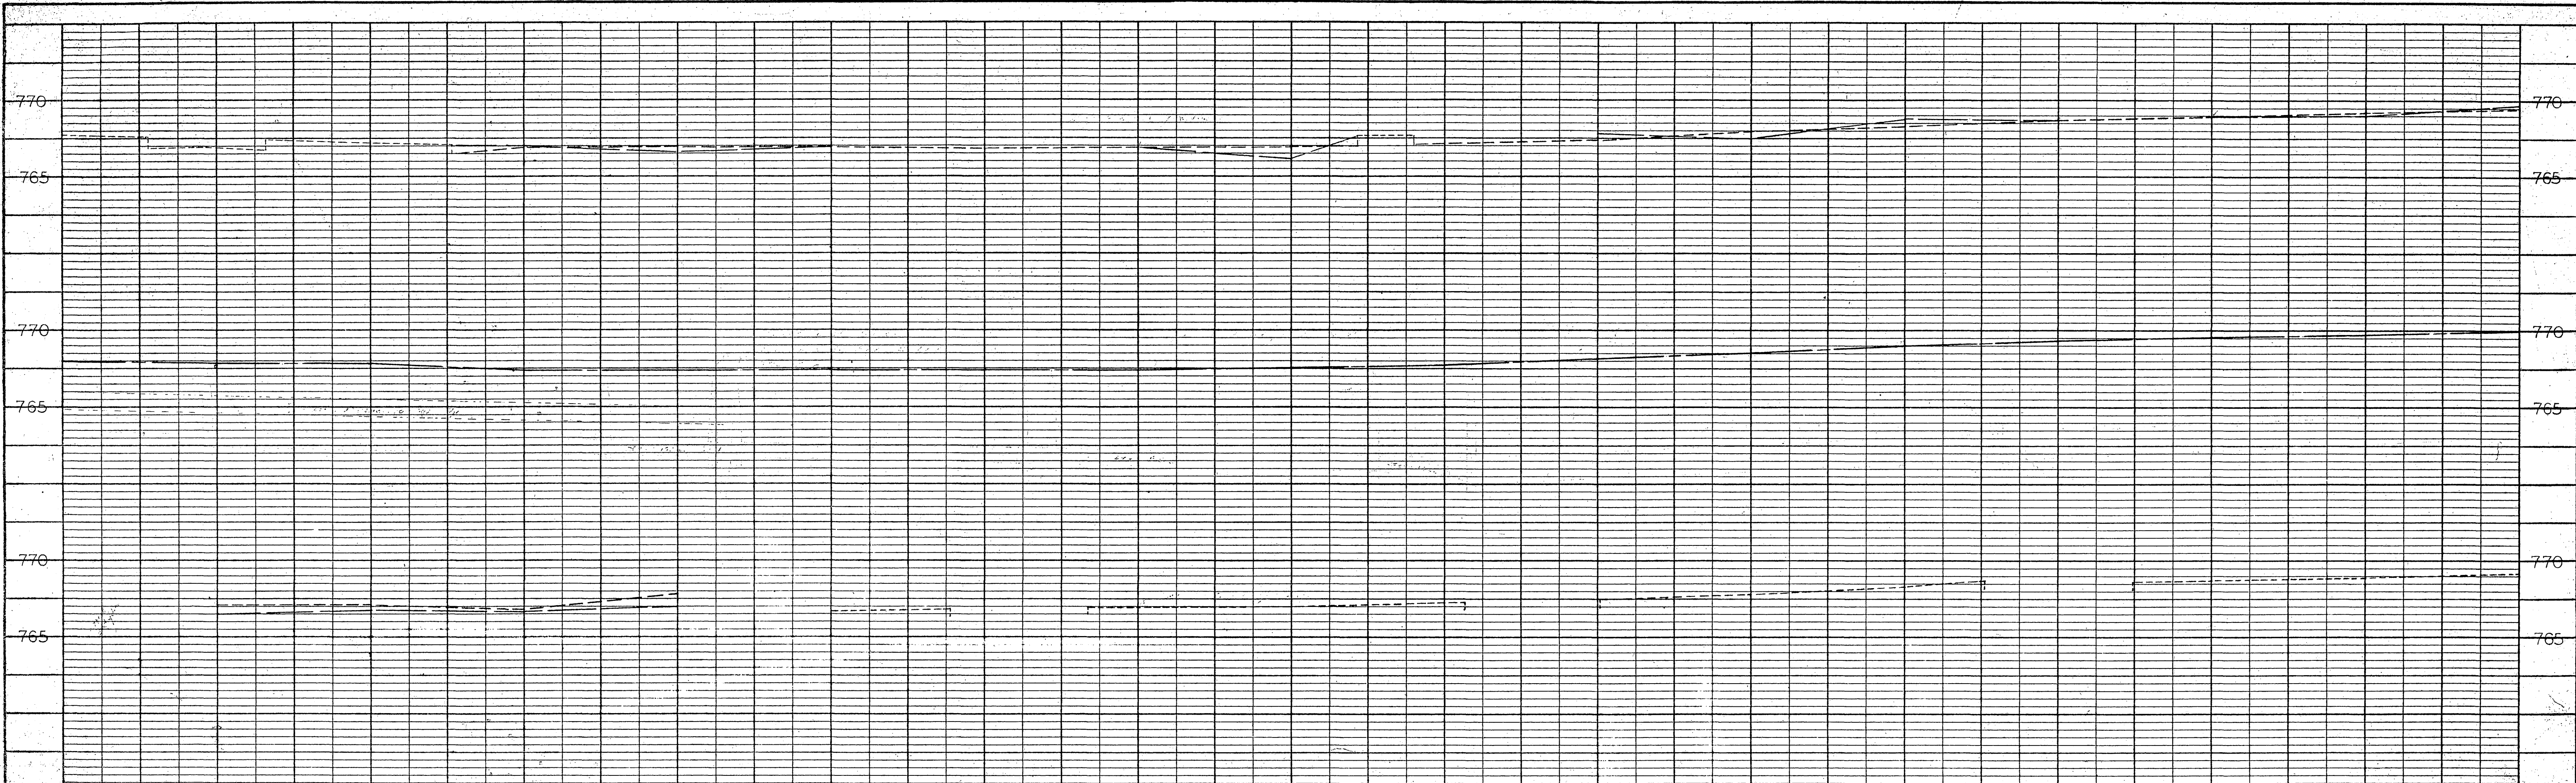

SCALE N 1" = 50'

HEERS SUBDIVISION

PROFILE	
DATE	BY
STRUCTURE NOTATIONS	
GRADES CHECKED	
SURVEYED	
NOTE BOOK	

PLAN	
DATE	BY
ALIGNMENT CHECKED	
RI OF WAY CHECKED	
SURVEYED	
NOTE BOOK	



REVISIONS		CITY OF RIVERSIDE, CALIFORNIA DEPARTMENT OF PUBLIC WORKS	
MARK	DATE	DESCRIPTION	

DESIGNED BY		CHECKED BY		APPROVED BY	
DRAWN BY H.R.C.					
RECOMMENDED BY		ASSISTANT CITY ENGINEER		DATE	

ARLINGTON AVENUE

T.O.

SHEET OF

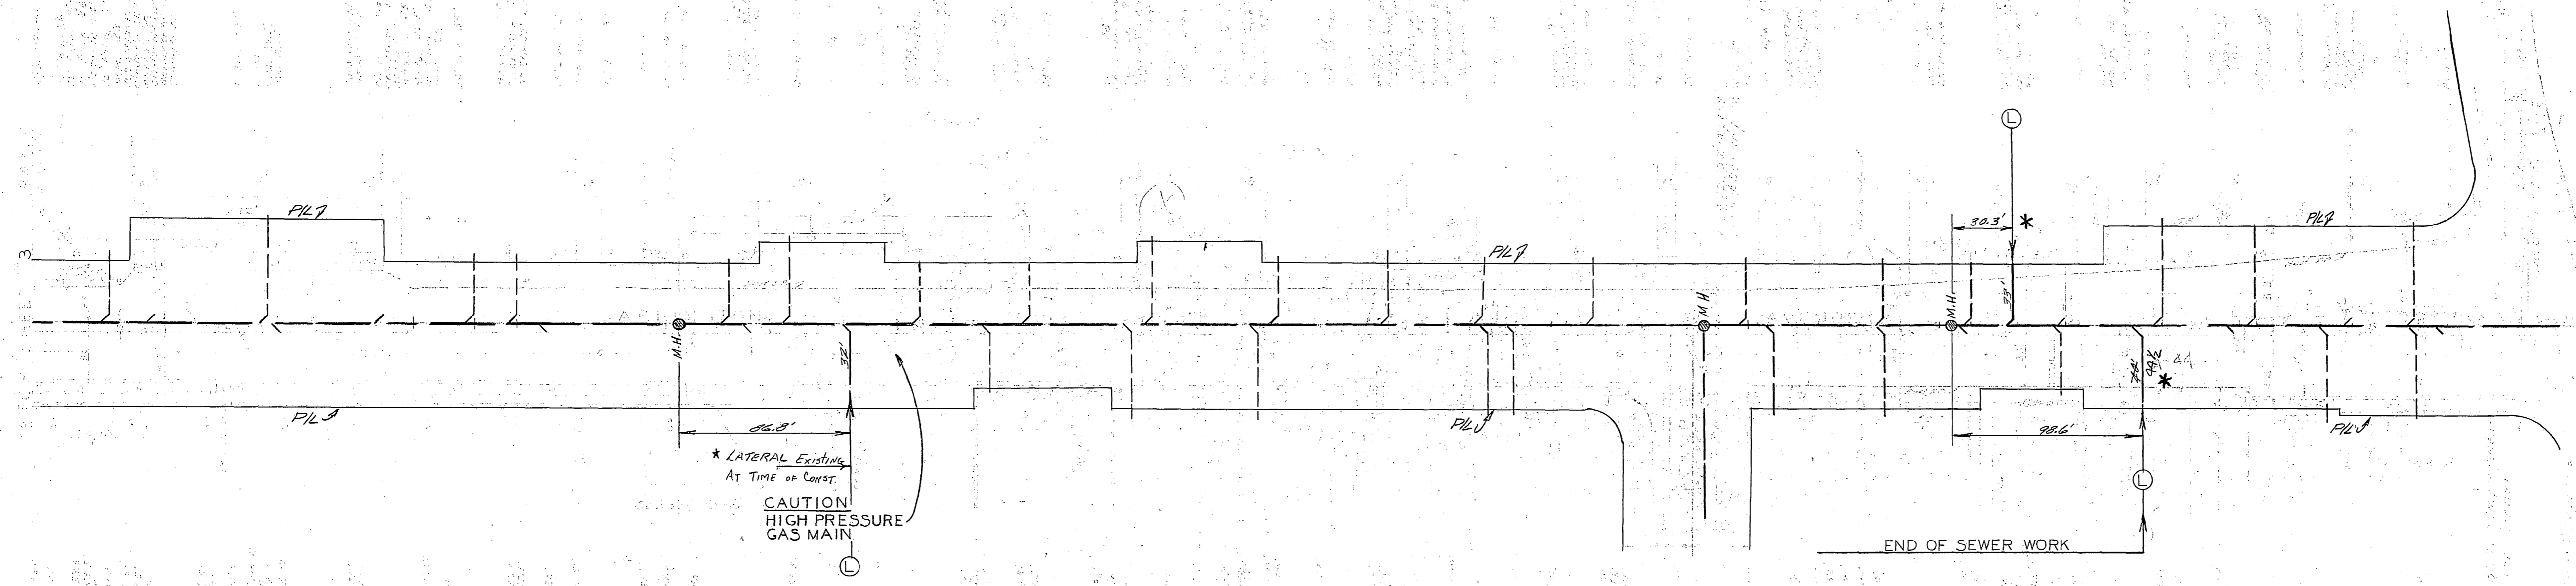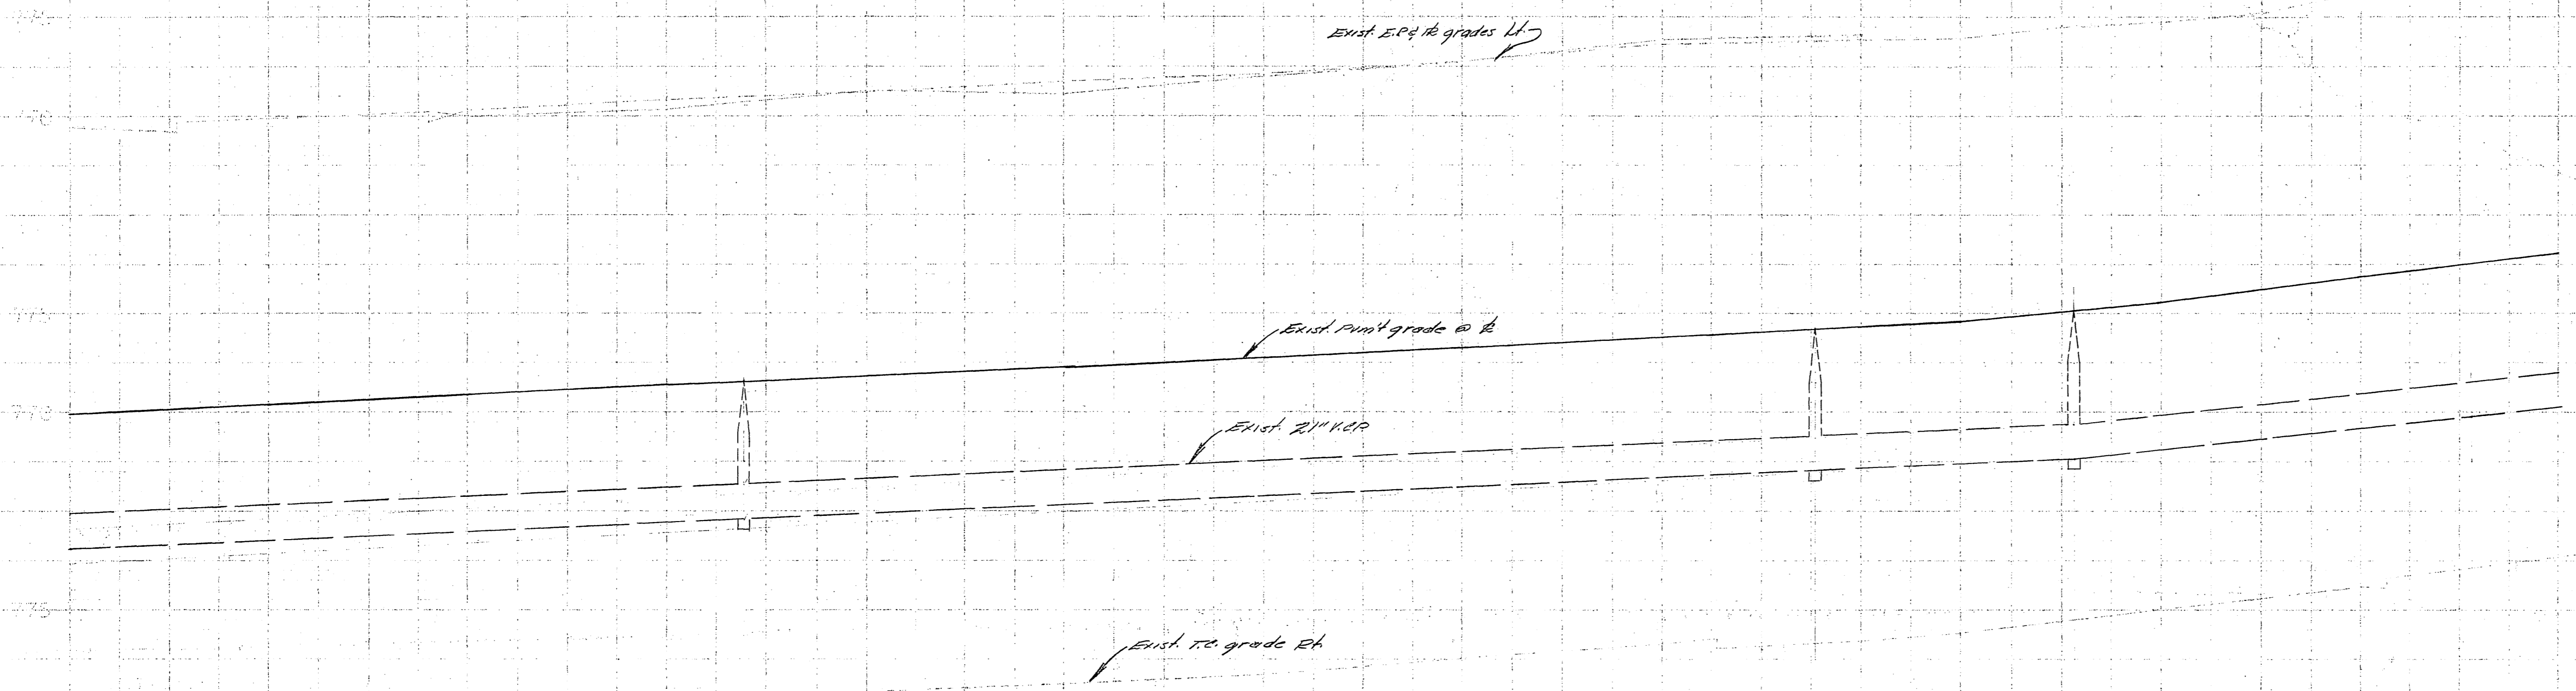

REVISIONS		CITY OF RIVERSIDE CALIFORNIA DEPARTMENT OF PUBLIC WORKS	
MARKING	DESCRIPTION		
1	As built		
2	Revised plan per stable review 083 w/8 of km.		

SANITARY SEWER
STA. 94+00.

ACCT. NO. 5049
S-415
4 4

* As built 1-15-65
w/g
A. Mitchell
J. Mitchell
7-5-63

PLATE



ENGINEERING EXAMINATION CHECKED

DATE

PLATE

ENGINEERING EXAMINATION CHECKED

DATE

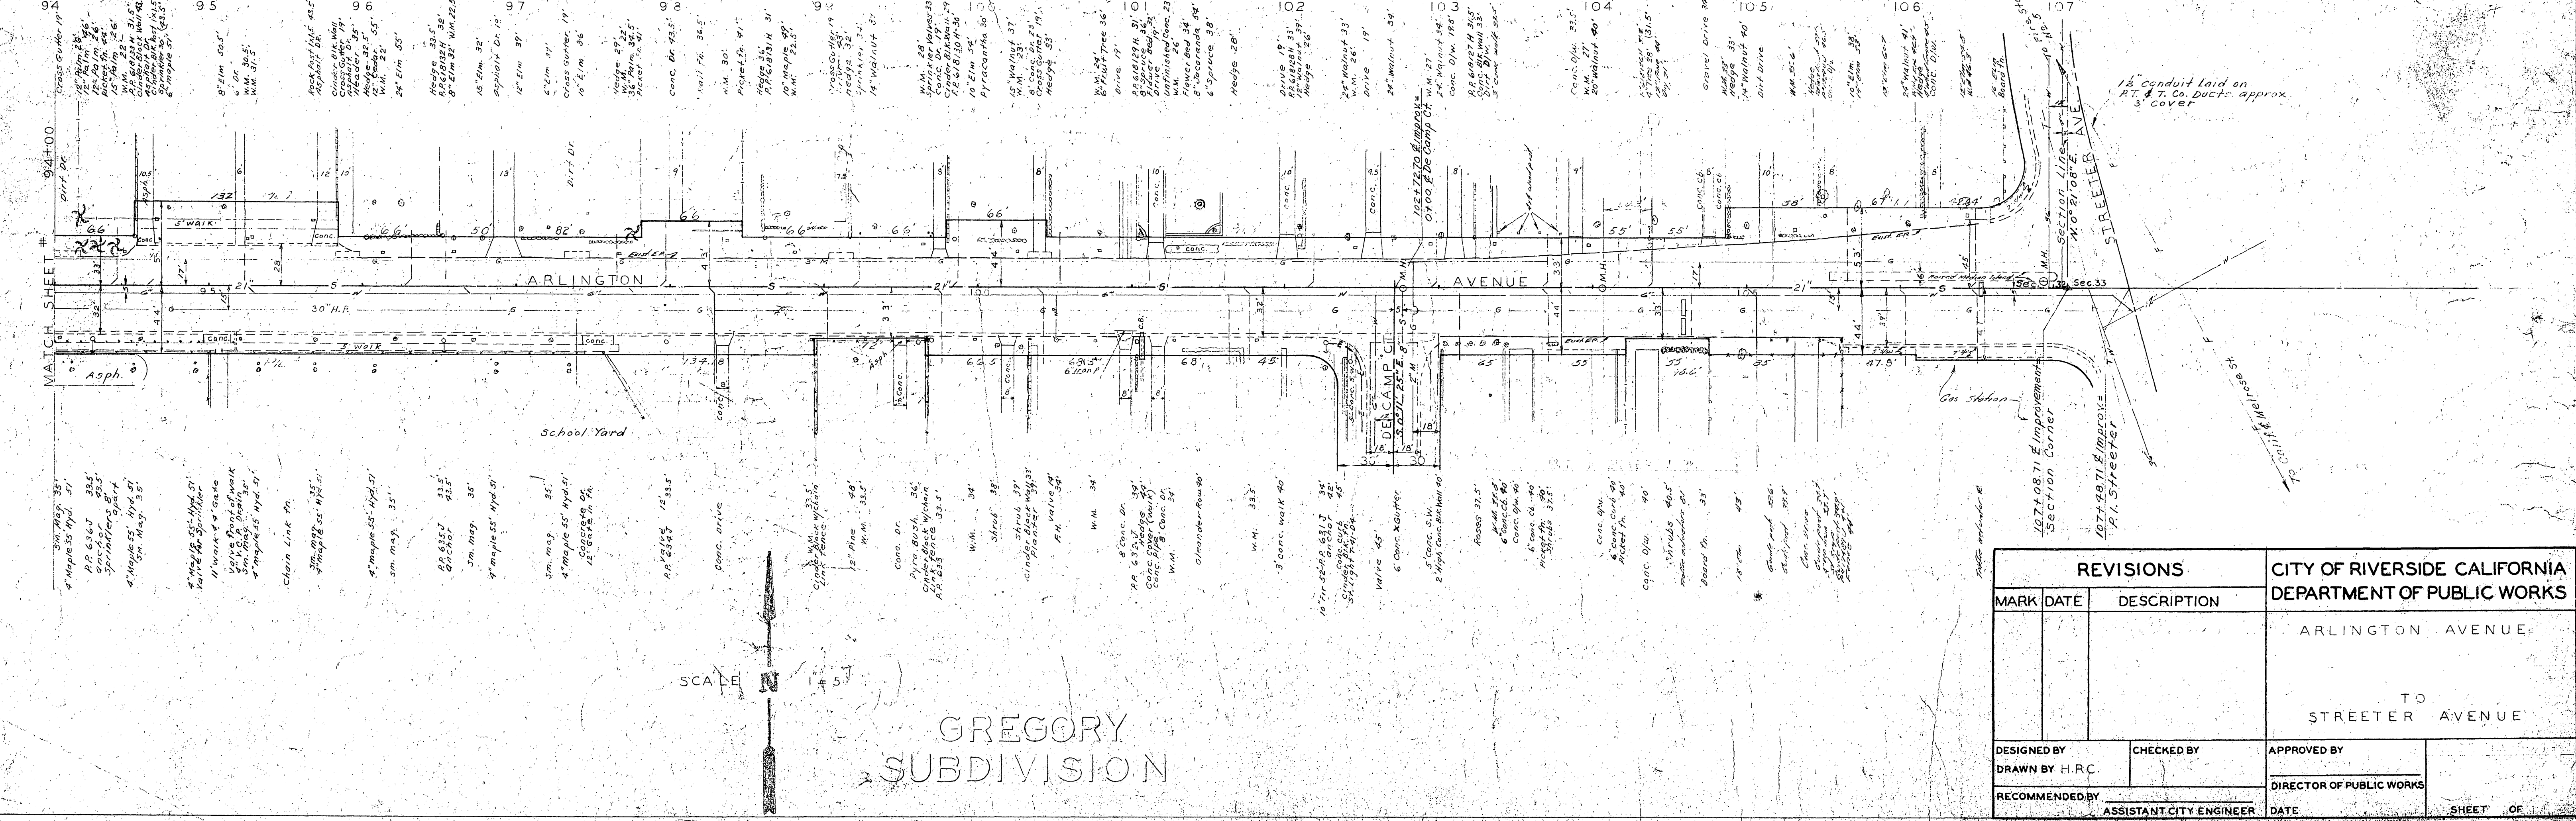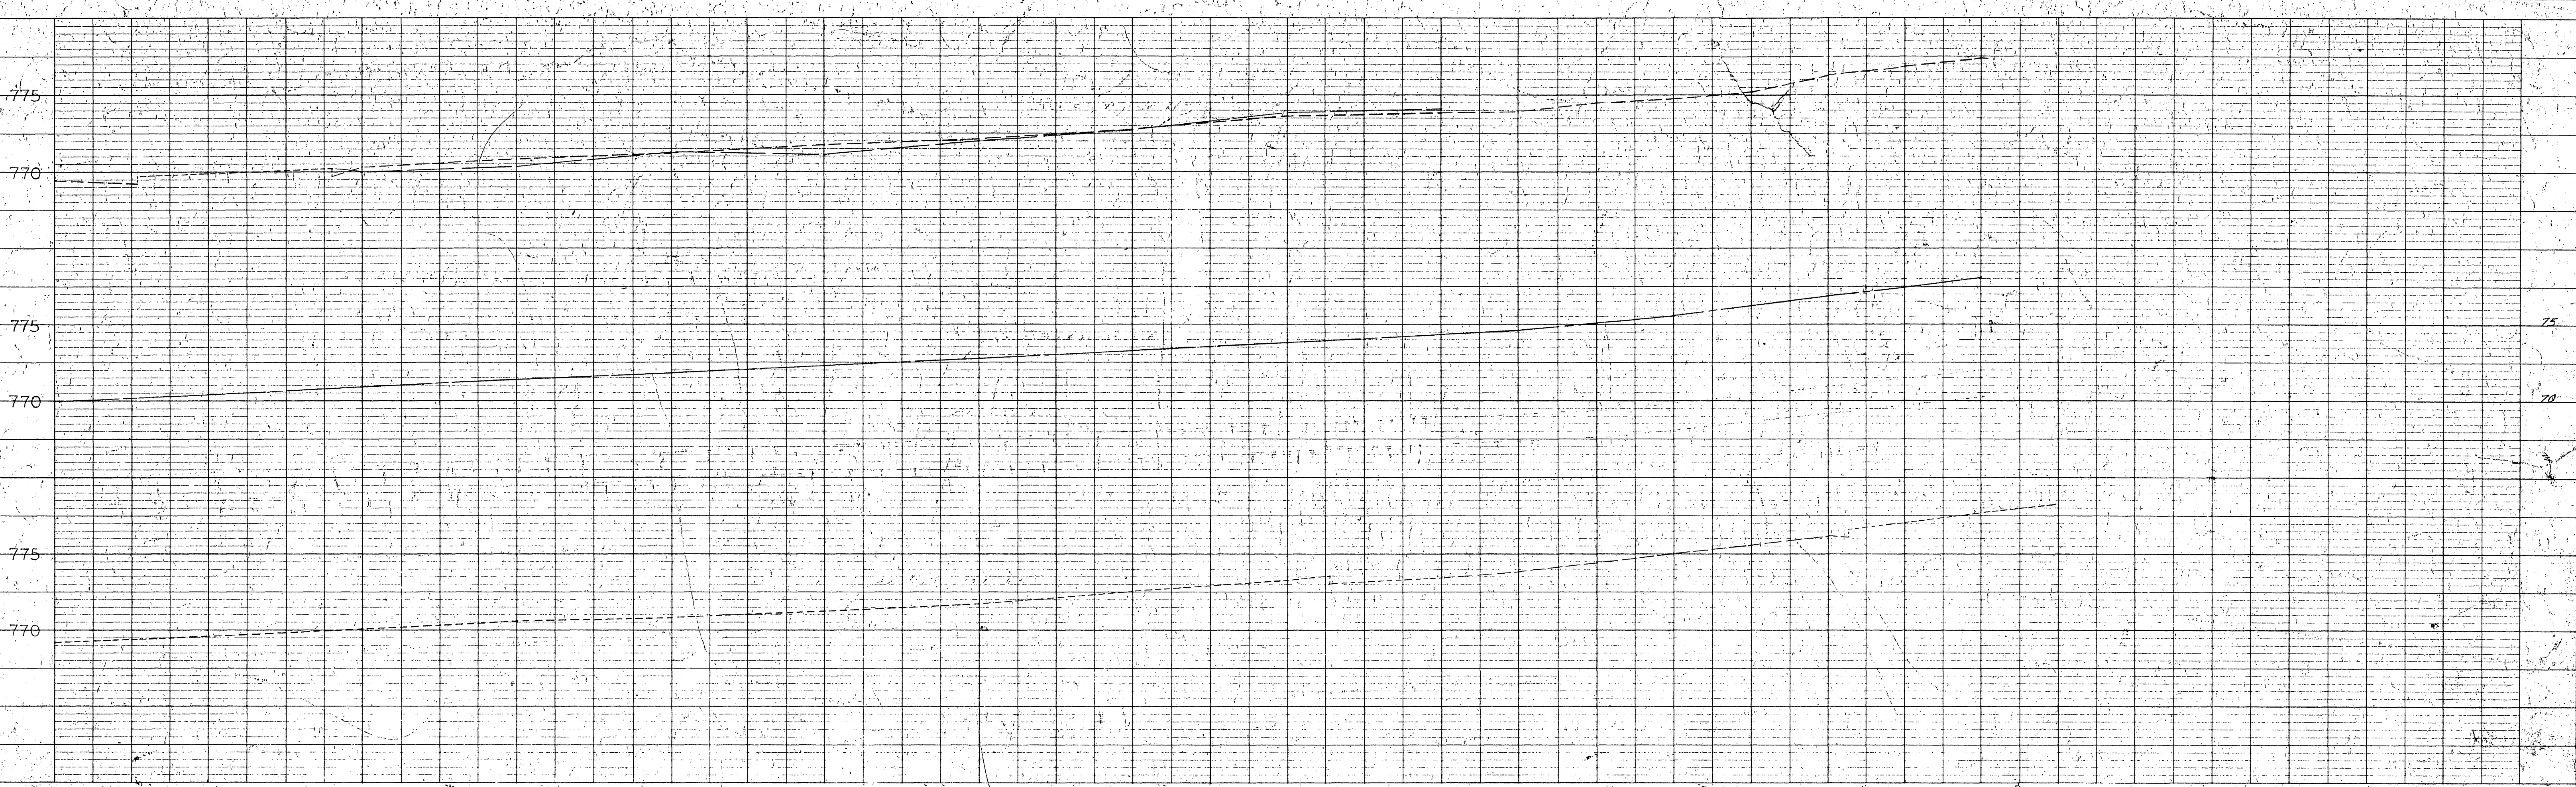

SCALE 1" = 5'

GREGORY
SUBDIVISION

REVISIONS		CITY OF RIVERSIDE CALIFORNIA DEPARTMENT OF PUBLIC WORKS	
MARK	DATE	DESCRIPTION	
			ARLINGTON AVENUE TO STREETER AVENUE
DESIGNED BY	CHECKED BY	APPROVED BY	
DRAWN BY H.R.C.		DIRECTOR OF PUBLIC WORKS	
RECOMMENDED BY	ASSISTANT CITY ENGINEER	DATE	SHEET OF