


PROFILE:

NO. 800	PLANNED	DATE
NO. 801	DESIGNED	
NO. 802	CHECKED	
NO. 803	STRUCTURE NOTATIONS CH. 10	

BENCH MARKS:
Elev. 823.72, Spike on RR # 2526 J E side MYERS opp. HOUSE # 3095.
Elev. 821.67, Top of 34" I.P. North Cor. of Prop.

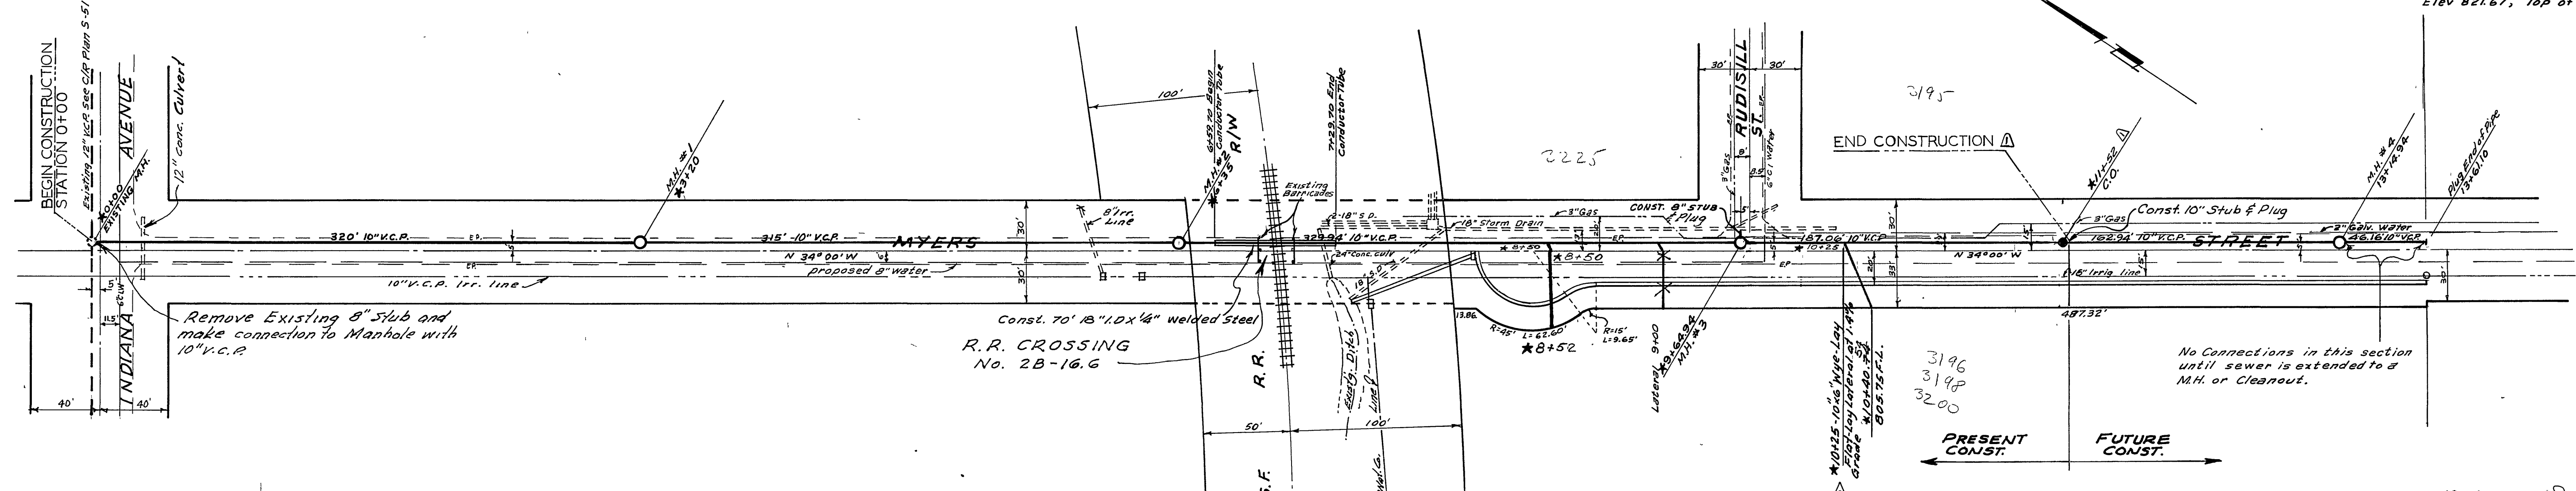

Remove Existing 8" Stub and make connection to Manhole with 10" V.C.P.

Const. 70' 18" I.D. x 1/4" welded Steel R.R. CROSSING No. 2B-16.G

No Connections in this section until sewer is extended to M.H. or Cleanout.

QUANTITY ESTIMATE PRESENT

10" Vitrified Clay Pipe	1152 LF
6" Vitrified Clay Pipe	76 LF
Manholes Standard No. 500.	3 EA.
18" I.D. x 1/4" Welded Steel Conductor Tube	70 LF
Pavement Replacement	3,485 SF
6" x 10" Wye	2 EA.
Seal Coat	17,153 SF.
Clean-out standard No. 560	1 EA.

NOTE TO CONTRACTOR
The existence and location of any underground utility pipes or structures shown on these plans are obtained by a search of available records. To the best of our knowledge there are no existing utilities except as shown on these plans. The Contractor is required to take due precautionary measures to protect the utility lines shown and any other lines not of record or not shown on these plans.

- GENERAL NOTES:**
- Construction shall be in accordance with the City of Riverside Department of Public Works Standard Specifications No. 461 and Standard Drawing.
 - All laterals to be constructed in accordance with Standard Drawing No. 562.
 - Joints in vitrified clay pipe sewer shall conform to A.S.T.M. Standard C-425-60T, or the latest revision thereto.
 - Pipe shall be bedded Case II Std. Dwg. No. 452.

Laterals & Wye Relocated to Sta 10+25 from Sta 10+50.
Approved: [Signature]
DIR. DEPT. OF PUBLIC WORKS
Date

ACCT. NO. 05-3060-5050

REVISIONS

MARK	DATE	DESCRIPTION
7-10-63	APPROVED	FOR CITY CONTRACT STA 0+00 TO STA 9+64.94
7-11-63	APPROVED	LIMIT OF CONSTRUCTION EXTENDED FROM STA 9+64.94 TO STA 11+00.00

CITY OF RIVERSIDE, CALIFORNIA
DEPARTMENT OF PUBLIC WORKS

MYERS STREET SEWER EXTENSION
INDIANA AVE. TO RUDISILL ST.

DESIGNED BY 196 SUBMITTED BY "50"
DRAWN BY B.E.L. PARK DEPT. 63 DIV. 10
CHECKED BY [Signature] RECOMMENDED BY 500/35-48
DATE 7-2-63

APPROVED BY [Signature] DIR. DEPT. OF PUBLIC WORKS
DATE 7-2-63

PROJ. NO. **5-420**
SHEET 1 OF 1