



Note: Contractor shall uncover sewer at Sta. 2+37 and engineer shall verify elevation of flow line before cut sheets are issued.

PROFILE  
 SCALES: 1"=50' HORIZ.  
 1"=5' VERT.

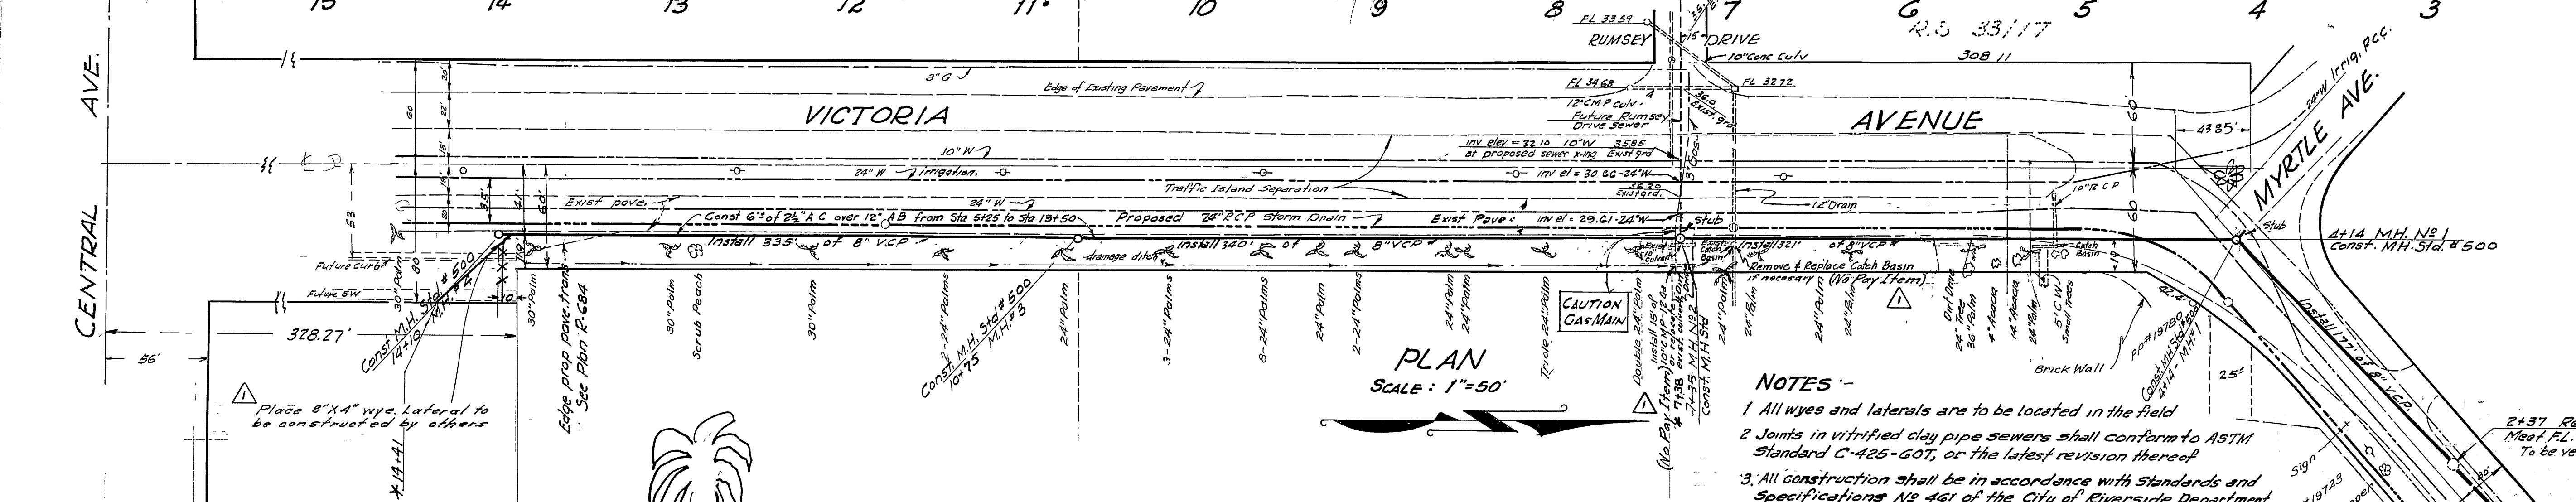

PLAN  
 SCALE: 1"=50'

- NOTES:-
- 1 All wyes and laterals are to be located in the field
  - 2 Joints in vitrified clay pipe sewers shall conform to ASTM Standard C-425-60T, or the latest revision thereof
  - 3 All construction shall be in accordance with Standards and Specifications No 461 of the City of Riverside Department of Public Works. Pipe shall be bedded in Case II Standard Drawing No 452
  - 4 It shall be the responsibility of the Contractor to clear the Right of Way in accordance with the provisions of law as it affects each utility including irrigation lines and appurtenances, and at no extra cost to the City of Riverside.
  - 5 Top of Manholes to match existing ground elevation
  - 6 M.H. 4 to be raised to grade after paving.
  - 7 B.M. is chiseled on top west end of divider island & CENTRAL AVE 50' East of & VICTORIA AVE. Elevation: 949.62
  - 8 Trim edge of exist. paving to straight line and construct paving as shown on Typical Section to produce smooth crown section. Restore all catch basins and culvert pipes as necessary.

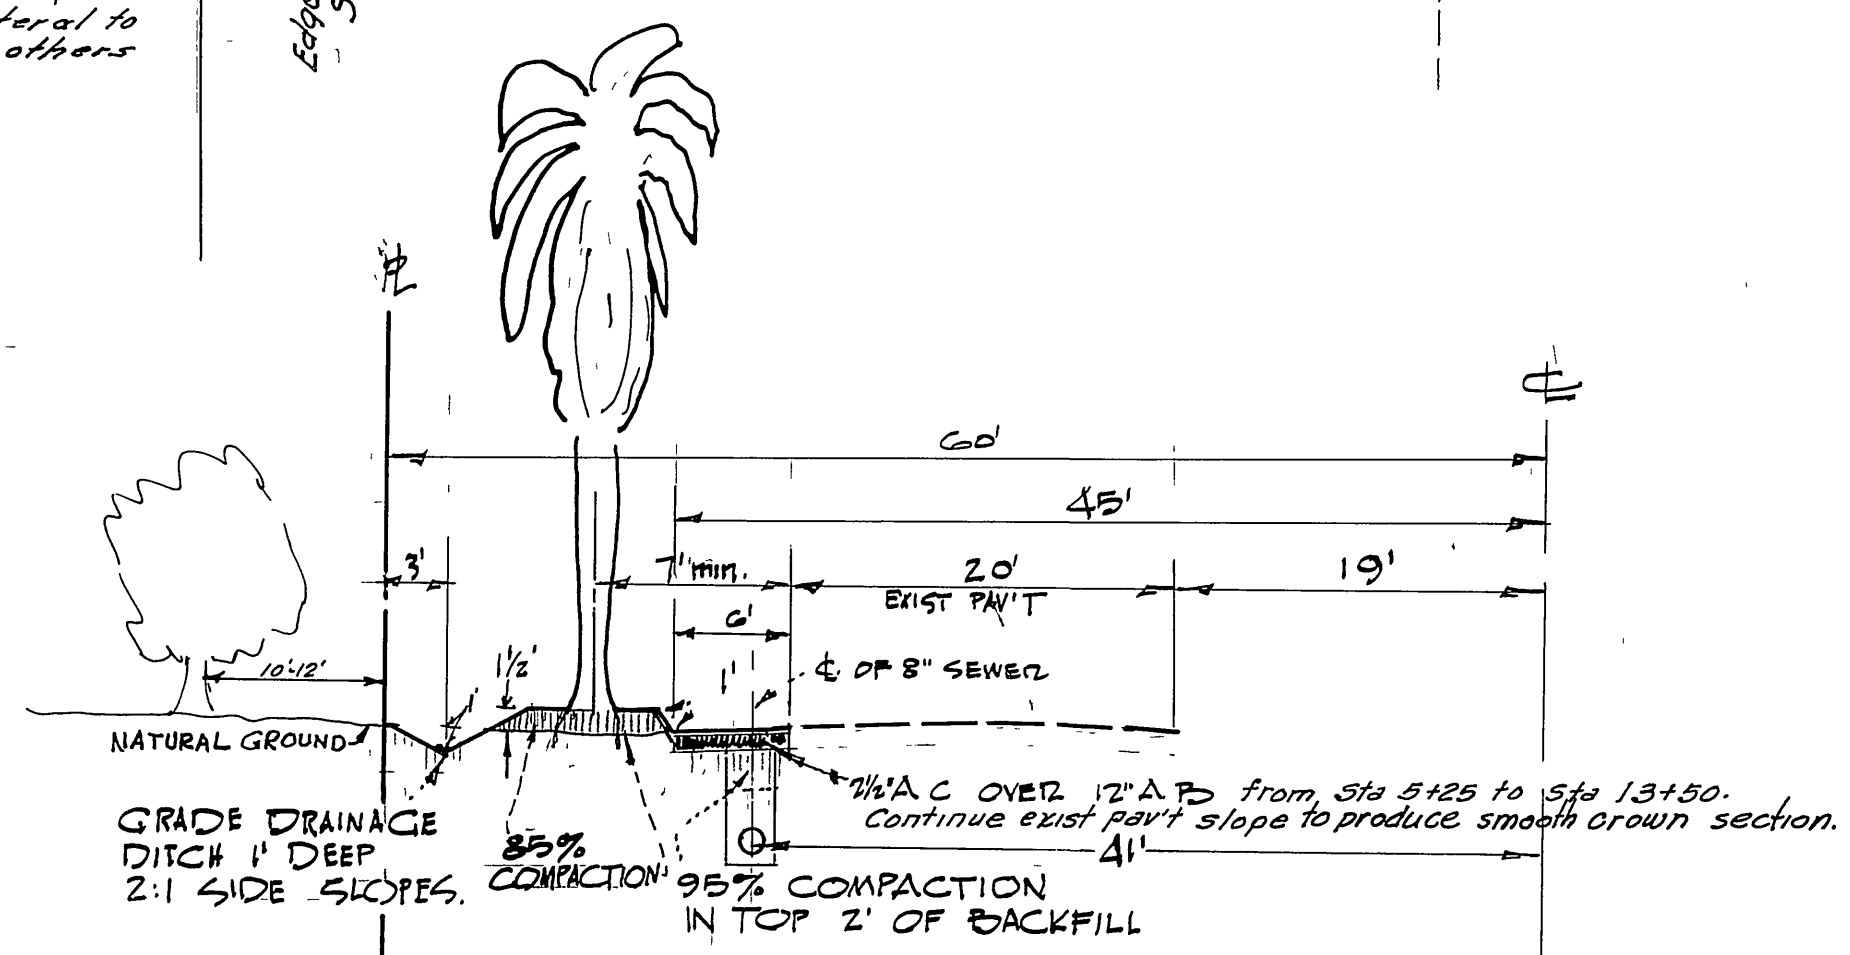

TYPICAL SECTION STA 7+50 to STA 14+10.  
 SCALE: 1"=10'

McKEE & CRAWLEY  
 SURVEYORS AND ENGINEERS  
 Riverside, California

APPROVED: *George O. Crawley* Field Eng. (S.E.)  
 DATE: Aug 2, 1963

CITY OF RIVERSIDE, CALIFORNIA  
 DEPARTMENT OF PUBLIC WORKS

VICTORIA AVENUE  
 SEWER EXTENSION  
 EL SINORE RD TO CENTRAL AVE.

MARK	DATE	DESCRIPTION
Δ	4-3-64	Revised plan for City Contract # 4484

DESIGNED BY: [Signature]  
 DRAWN BY: [Signature]  
 CHECKED BY: [Signature]

SUBMITTED BY: *William D. Gardner*  
 PARK DEPT. TRAFFIC DIV.

RECOMMENDED BY: [Signature]

DATE: 4-3-64

PROJ. NO. 5-437

SHEET 1 OF 1

\* As built 5-28-64 BE