


SCALE
 HORIZ 1" = 50'
 VERT 1" = 5'

BENCH MARK: Elev 1037.89
 Chisel Bl 5/4 and BCR SE. Cor. of Canyon Crest & Blaine St.

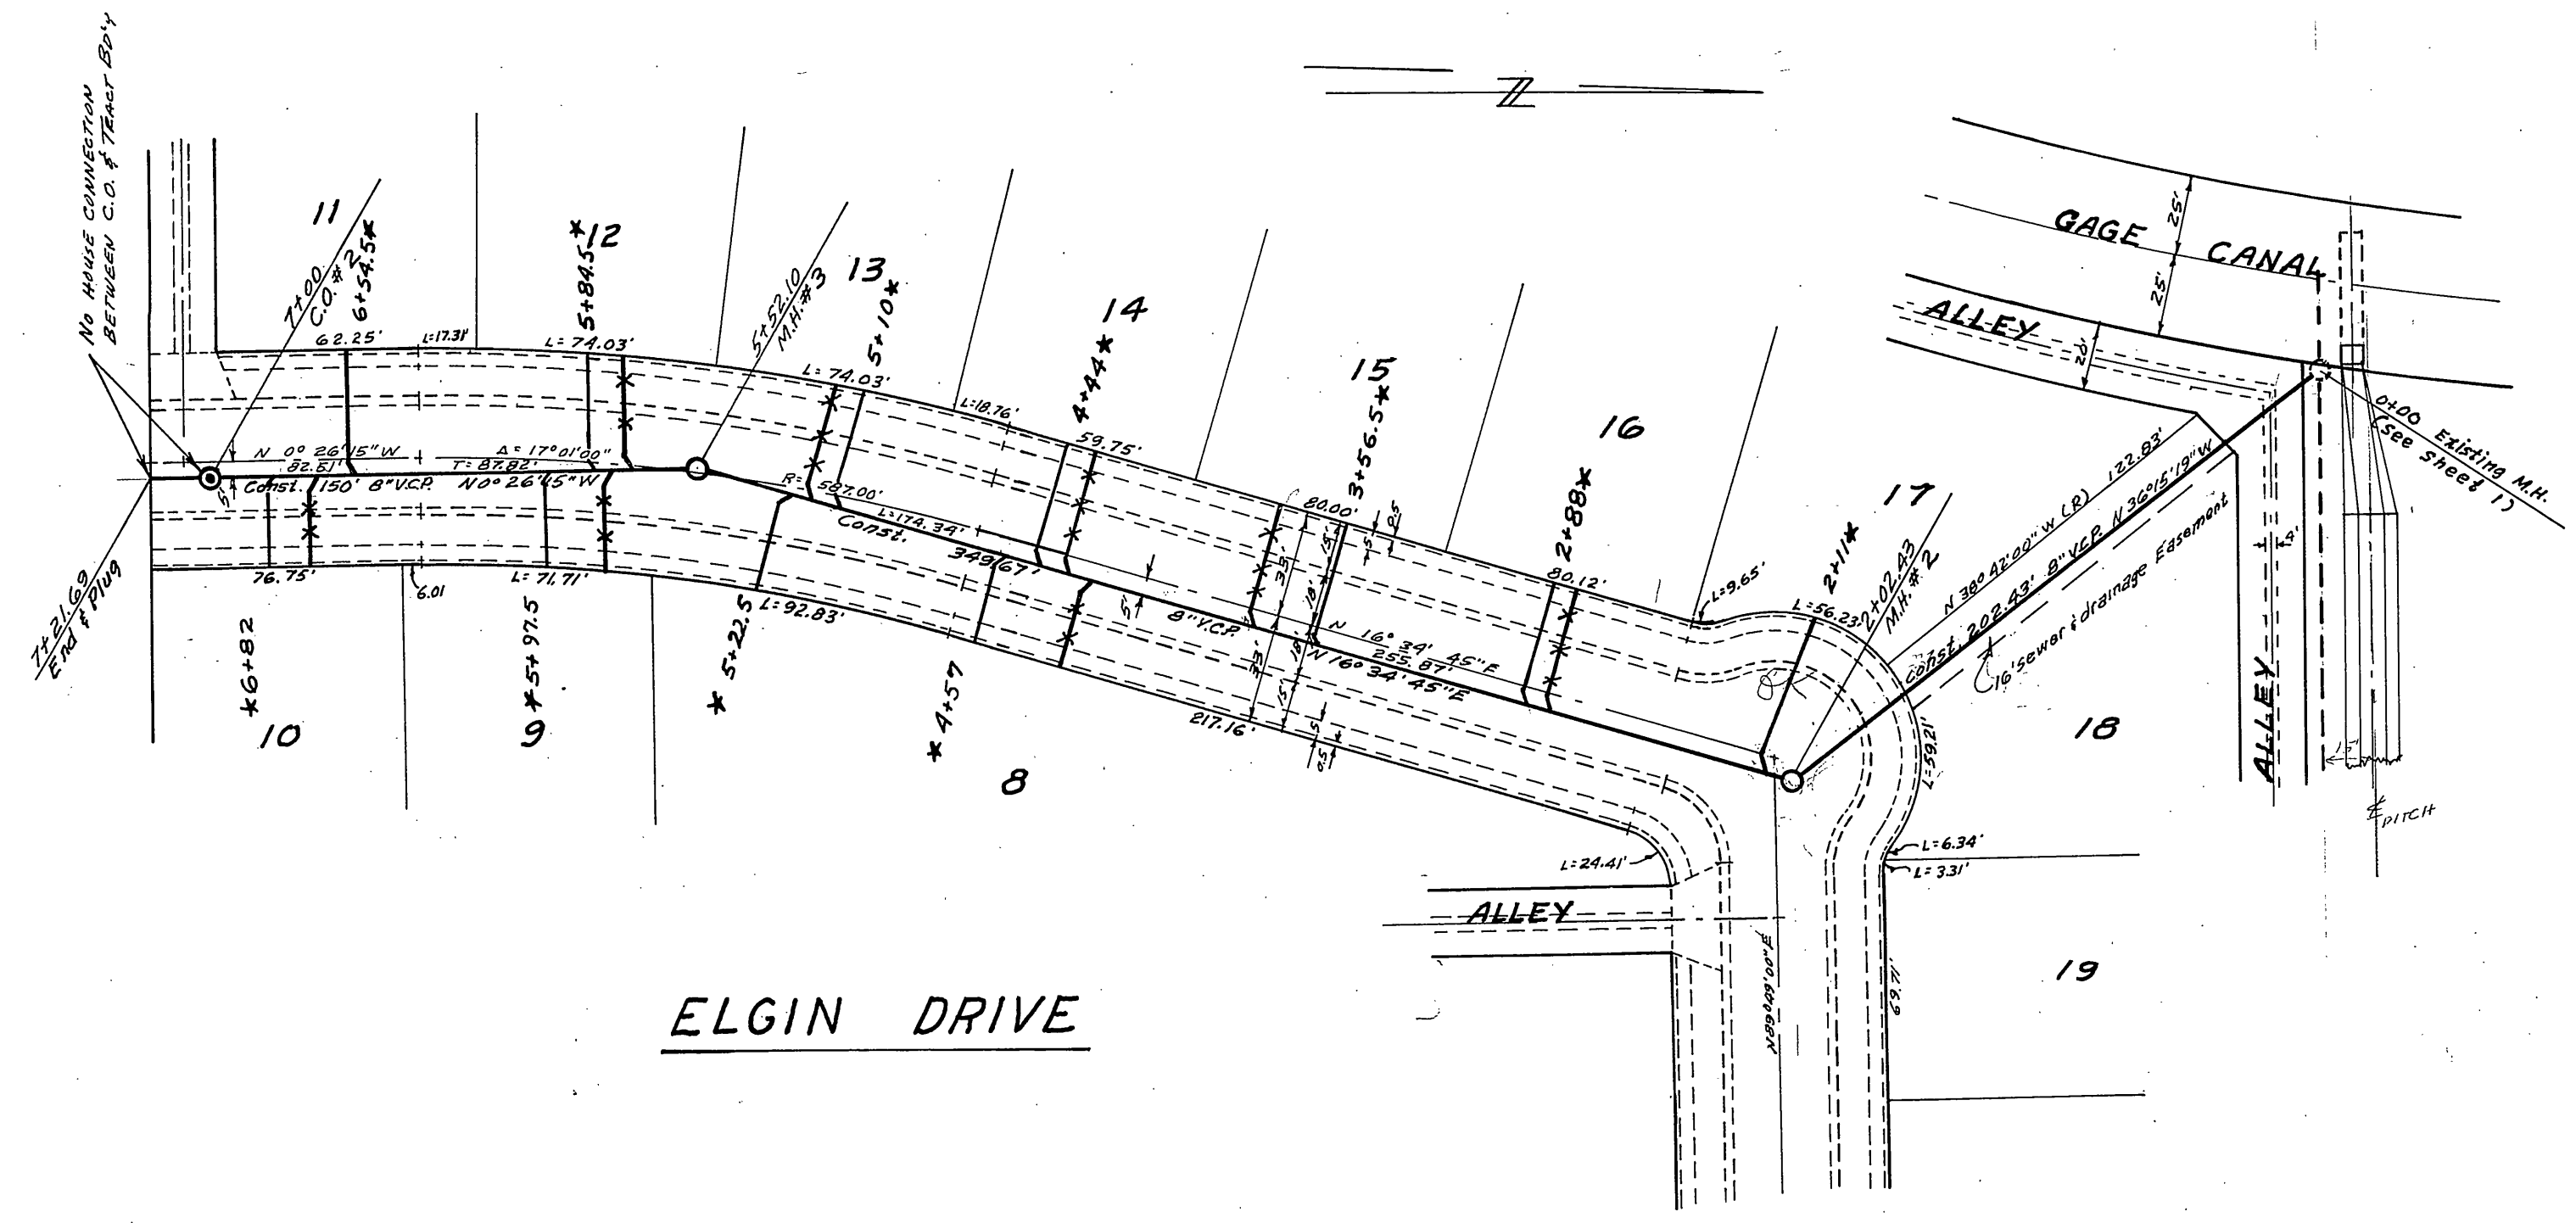

REVISION MARK DATE DESCRIPTION A 4-17-64 ENW RWD BY <i>[Signature]</i> SAME AS REV. A A 3-4-64 ENW RWD BY <i>[Signature]</i> CORRECT SLOPE CLOS TO STREETS			ALBERT A. WEBB ASSOCIATES CIVIL ENGINEERS - RIVERSIDE, CALIFORNIA APPROVED <i>[Signature]</i> DATE 12/30/63 1987 CITY OF RIVERSIDE, CALIFORNIA DEPARTMENT OF PUBLIC WORKS SEWER PLAN & PROFILE ELGIN DRIVE TRACT No 2602
DATE DEC 63 DRAWN AW CHECKED <i>[Signature]</i> RGN	SCALE 1" = 50' W.Q. 63-10 F.S. 517	APPROVED BY <i>[Signature]</i> DIRECTOR OF PUBLIC WORKS DATE 2-3-64 SHEET 2 OF 2 NO. S-454	

As built 5-28-64 B.E.

DWG No 63-10-B

PROFILE	NO.	DATE
SURVEYED		
PLANNED		
DESIGNED		
CHECKED		
BY		

PLAN	NO.	DATE
SURVEYED		
PLANNED		
DESIGNED		
CHECKED		
BY		