


PROFILE	
NO.	5-47
DATE	
BY	
CHECKED	
APPROVED	
DATE	

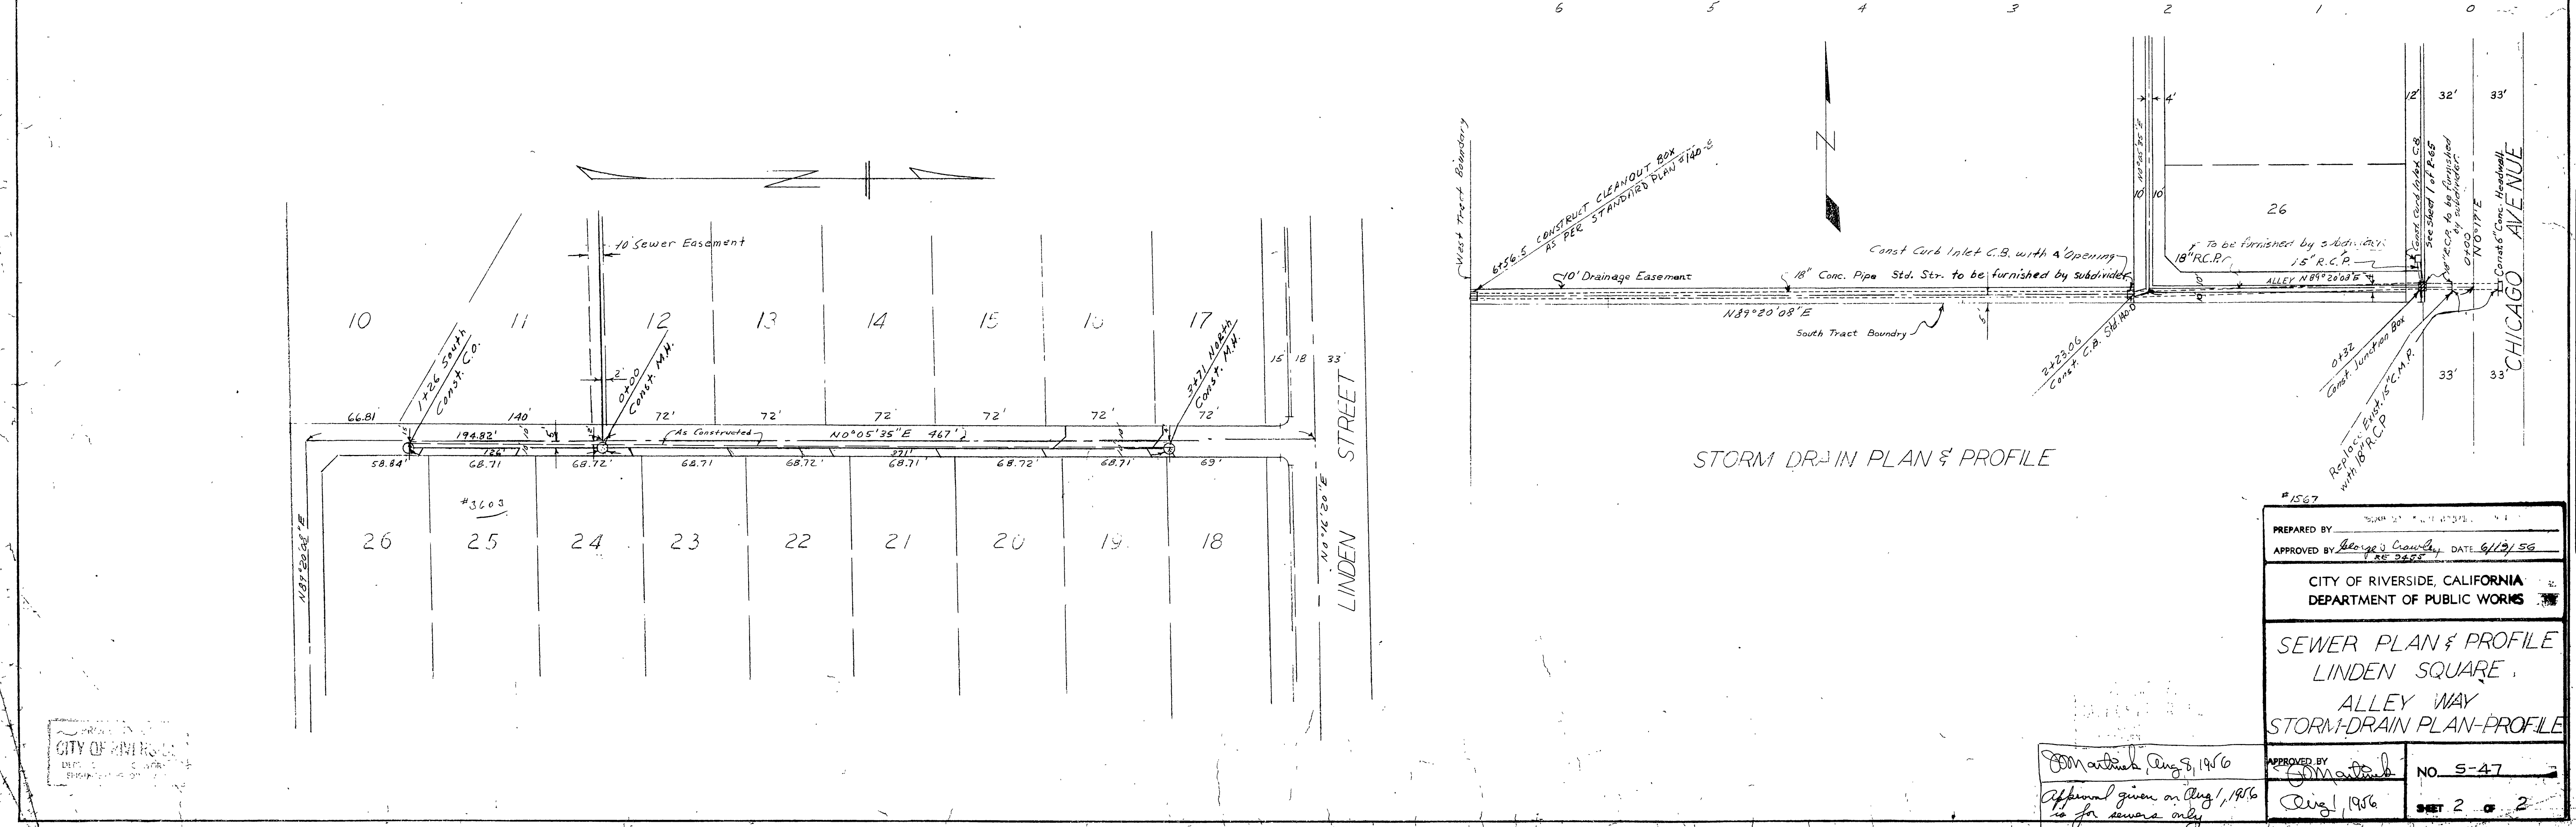

PLAN	
NO.	5-47
DATE	
BY	
CHECKED	
APPROVED	
DATE	

PREPARED BY: [Signature]
 APPROVED BY: George J. Crowley, DATE: 6/10/56
 CITY OF RIVERSIDE, CALIFORNIA
 DEPARTMENT OF PUBLIC WORKS
 SEWER PLAN & PROFILE
 LINDEN SQUARE
 ALLEY WAY
 STORM-DRAIN PLAN-PROFILE
 NO. 5-47
 SHEET 2 OF 2

Approved on Aug 1, 1956
 for sewers only