
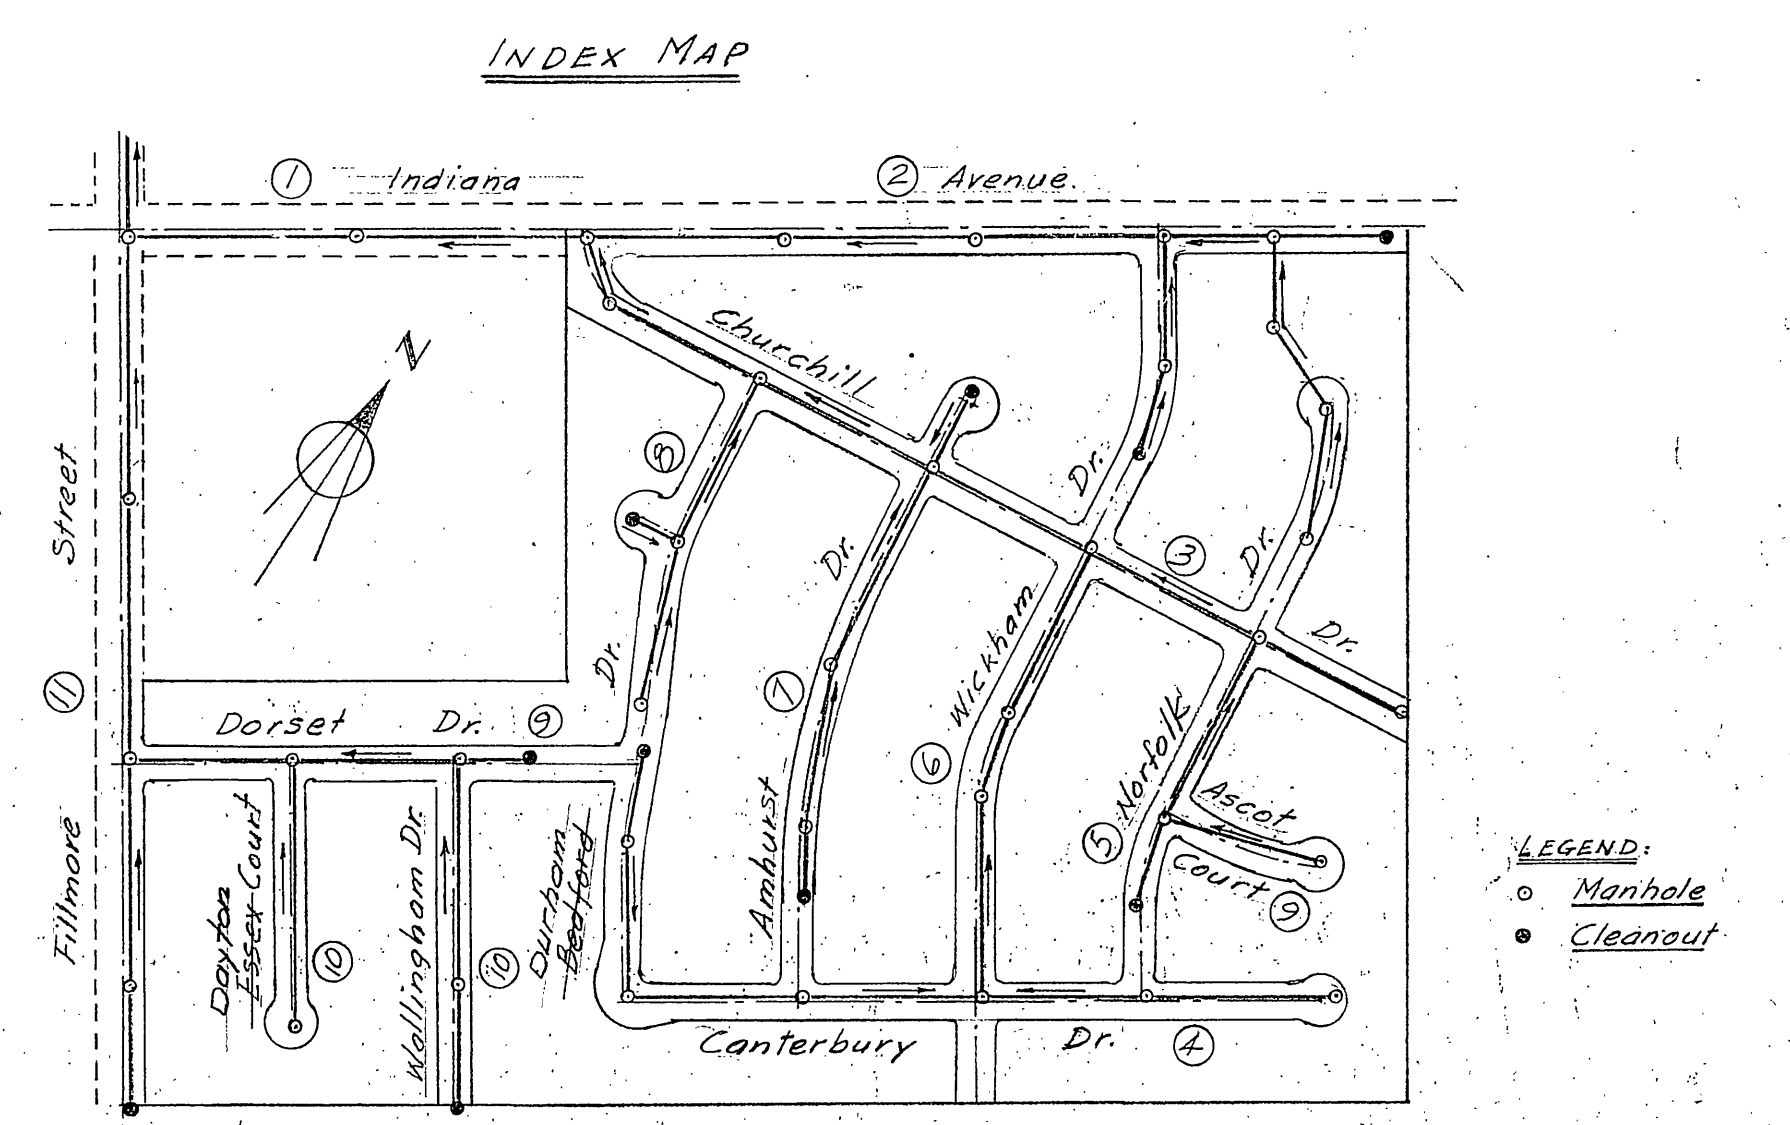


PLAN	DATE
SURVEYED	BY
PLOTTED	CHECKED
NOTE BOOK	RT. OF WAY CHECKED
NO.	

PROFILE	DATE
SURVEYED	BY
NOTED	CHECKED
B. N.E. NOTED	
STRUCTURE NOTATIONS	CHK'D
NO. 339	

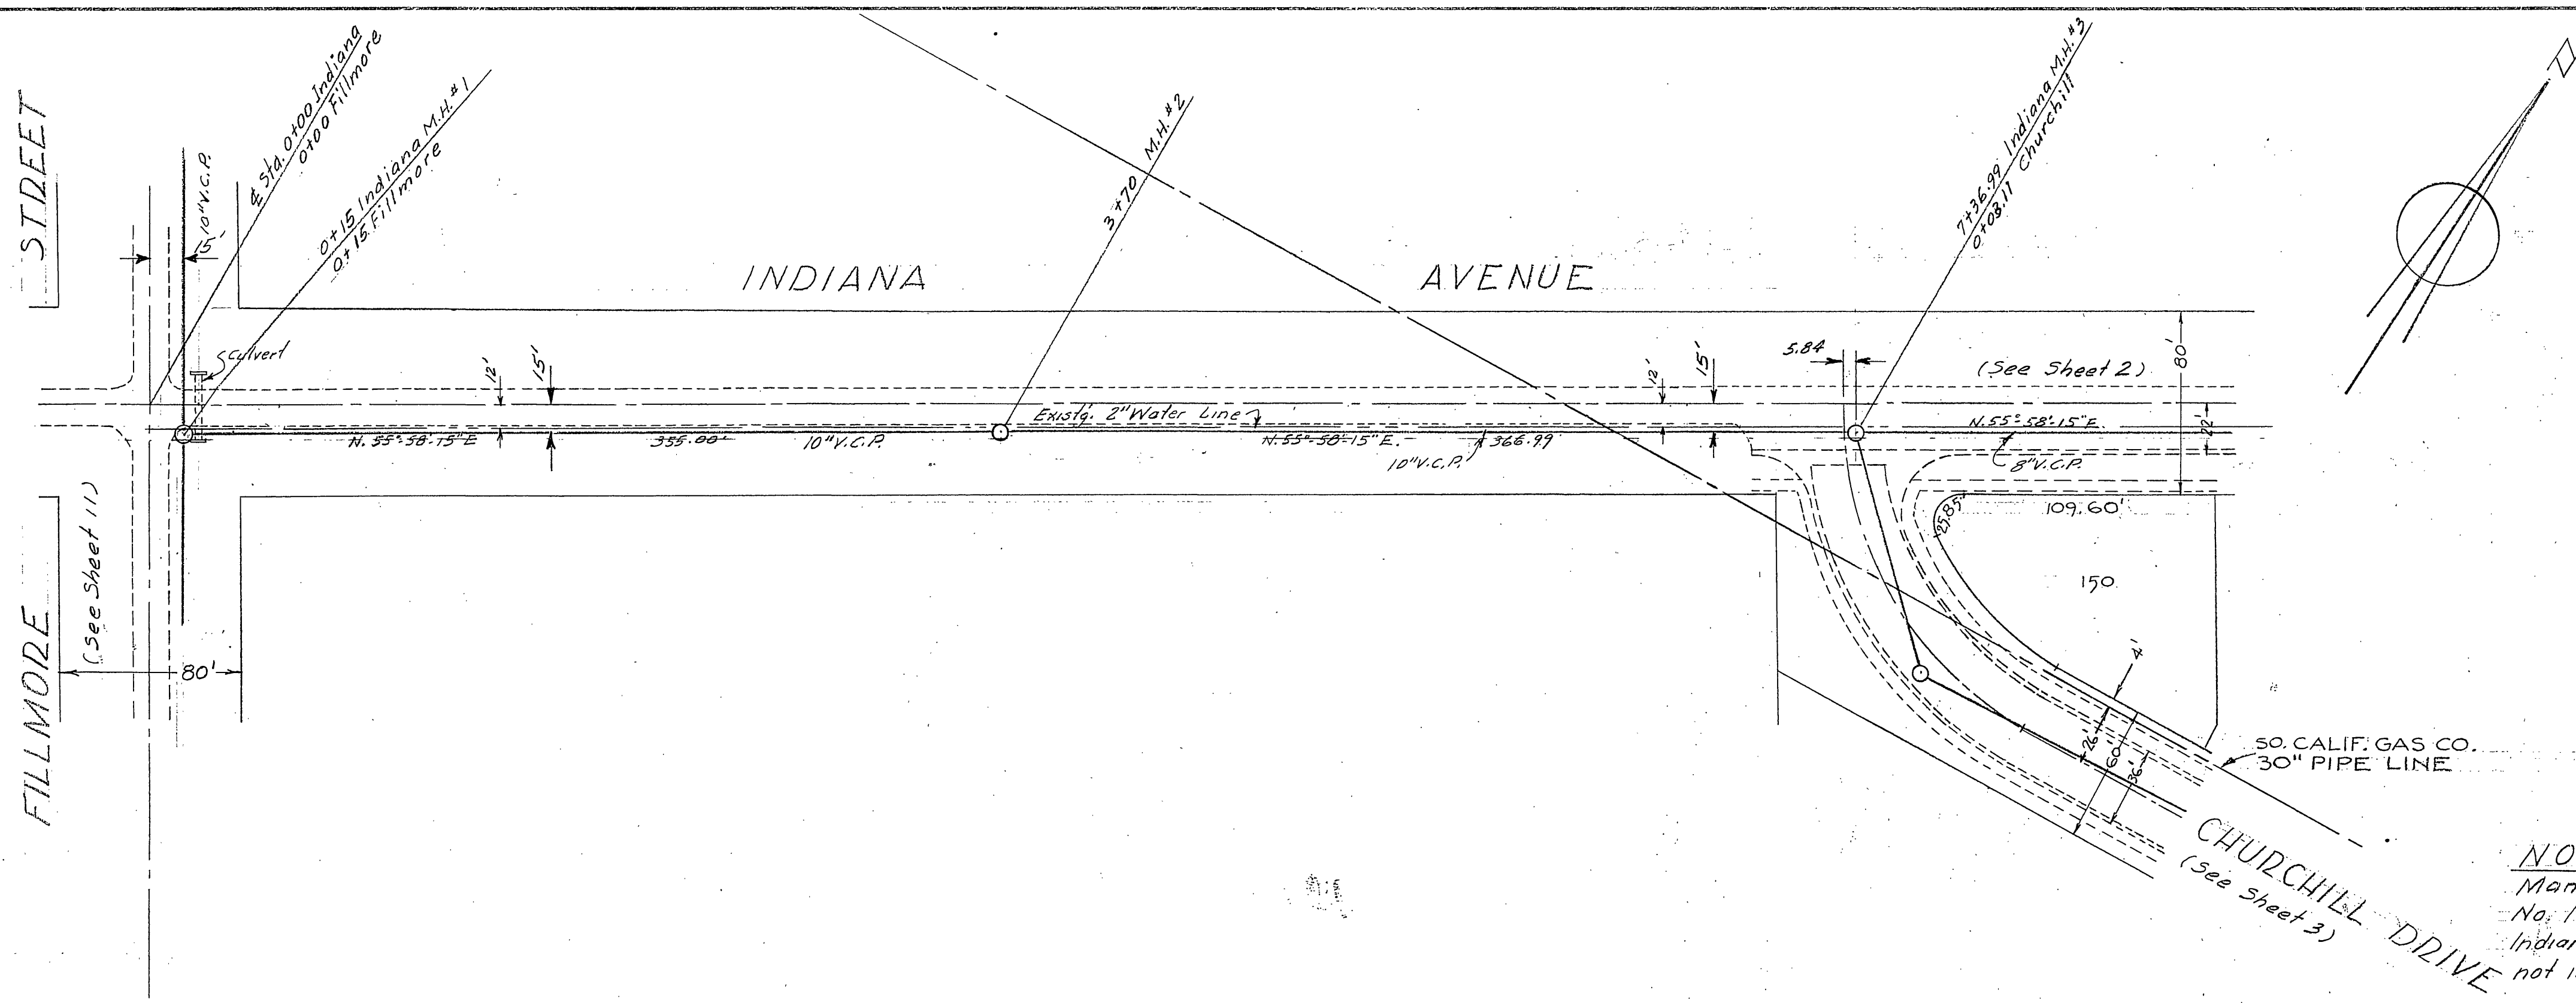


**NOTE**  
 Manholes No. 1 through 10, Cleanouts No. 1 & 2, and all Sewer Mains on Indiana & Fillmore are offsite and are not included in these Plans.

Sewer Relocated on Indiana		5-24-60	REC
REVISIONS	DATE	BY	
TOWN AND COUNTRY ESTATES UNIT NO. 4			
SEWER PLAN AND PROFILE			
INDIANA AVENUE			
SCALE 1"=50'	DATE 12-59	W.O. 59-186	SHEET
DRAWN L.G.	CHECKED	OF 11 SHEETS	DWG. NO. 59-186
ALBERT A. WEBB ASSOCIATES CIVIL ENGINEERS		RIVERSIDE CALIFORNIA	

La Sierra Community Services District  
 Approved April 27 1960  
 By J. B. Reed  
 DATE May 12 1960  
 APPROVED Sewer line layout & Velocities  
 RIVERSIDE COUNTY DEPARTMENT OF PUBLIC HEALTH  
 BY M. S. Hawkins

**Quantity Estimate (Onsite Only)**


8" Vitrified Clay Sewer Pipe	8,192 lin. ft.
4" Vitrified Clay Sewer Pipe	6,070 lin. ft.
8" x 8" Vitrified Clay Wyes	203
Std # 500 Manhole	8
8" Stub	1

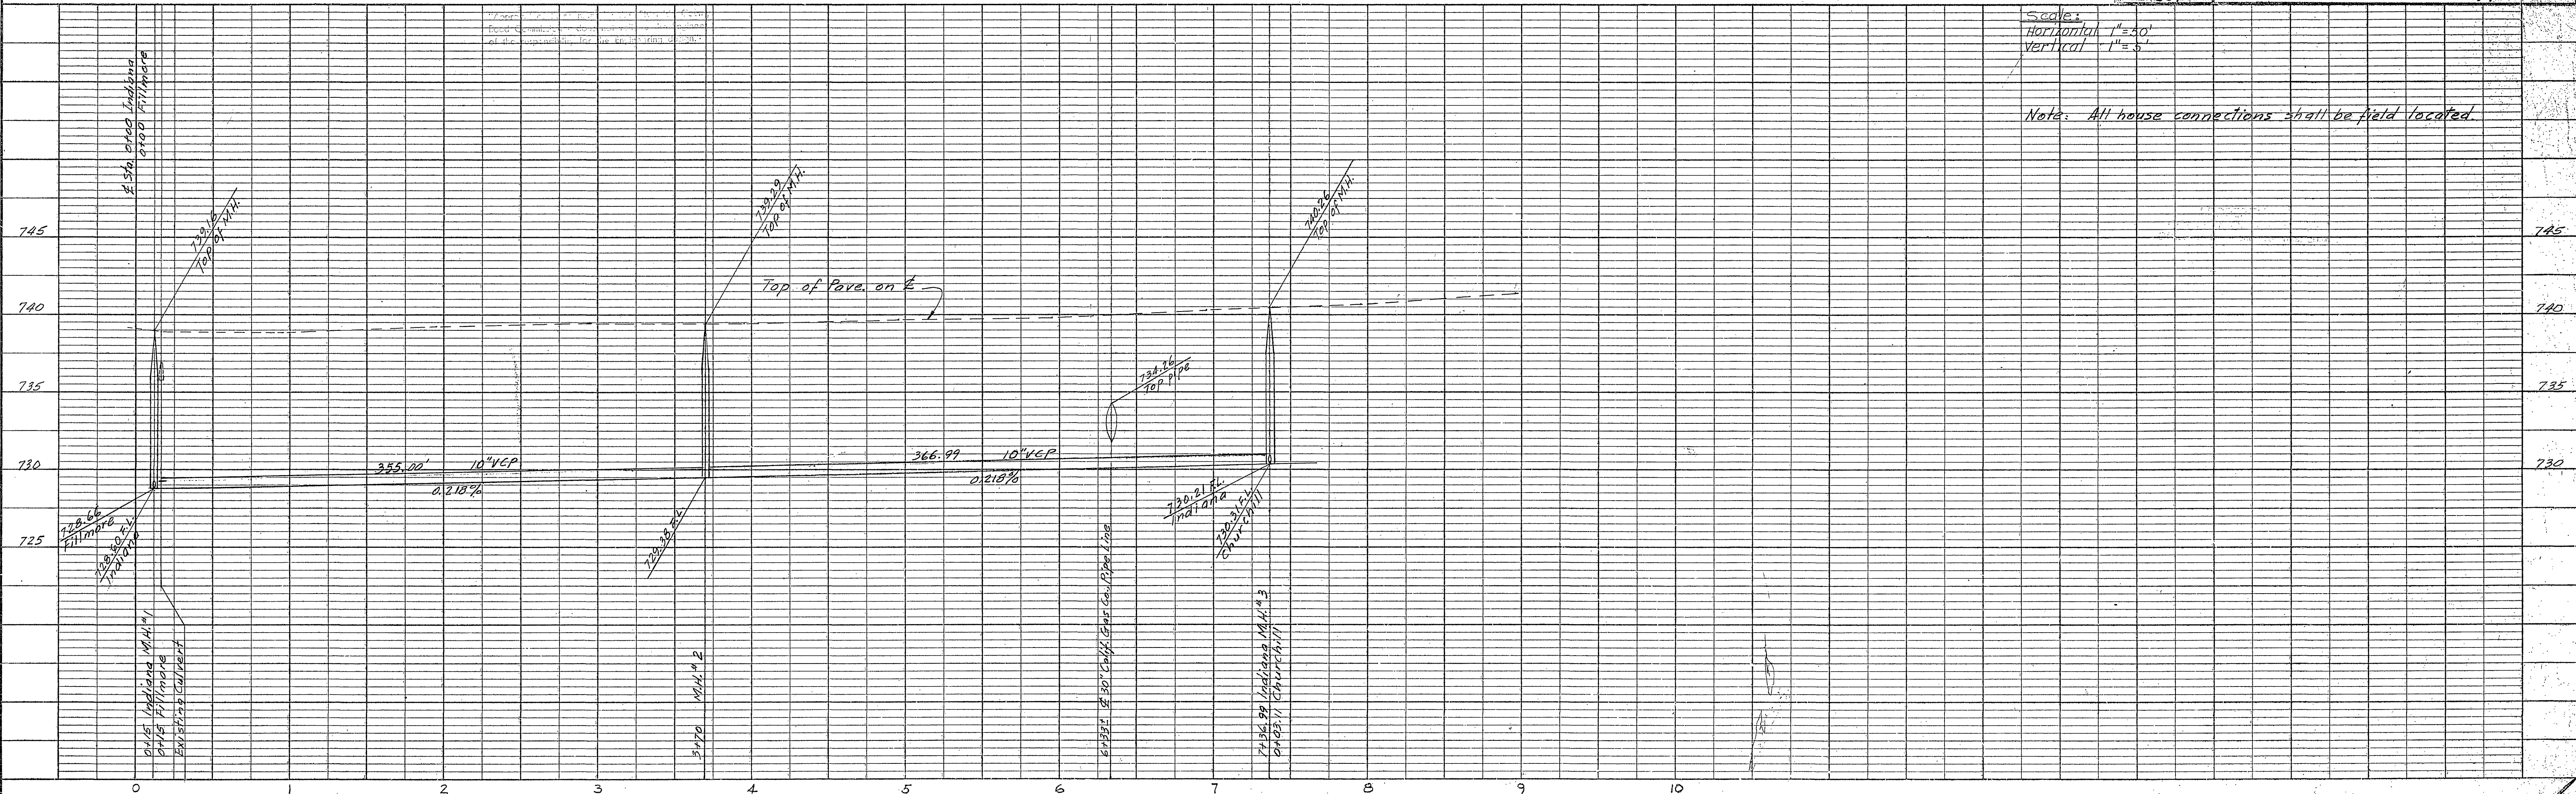

Scales:  
 Horizontal 1"=30'  
 Vertical 1"=5'

Note: All house connections shall be field located.

PLAN	DATE
SURVEYED	BY
PLOTTED	DATE
NOTE BOOK	
ALIGNMENT CHECKED	
RT. OF WAY CHECKED	
NO.	

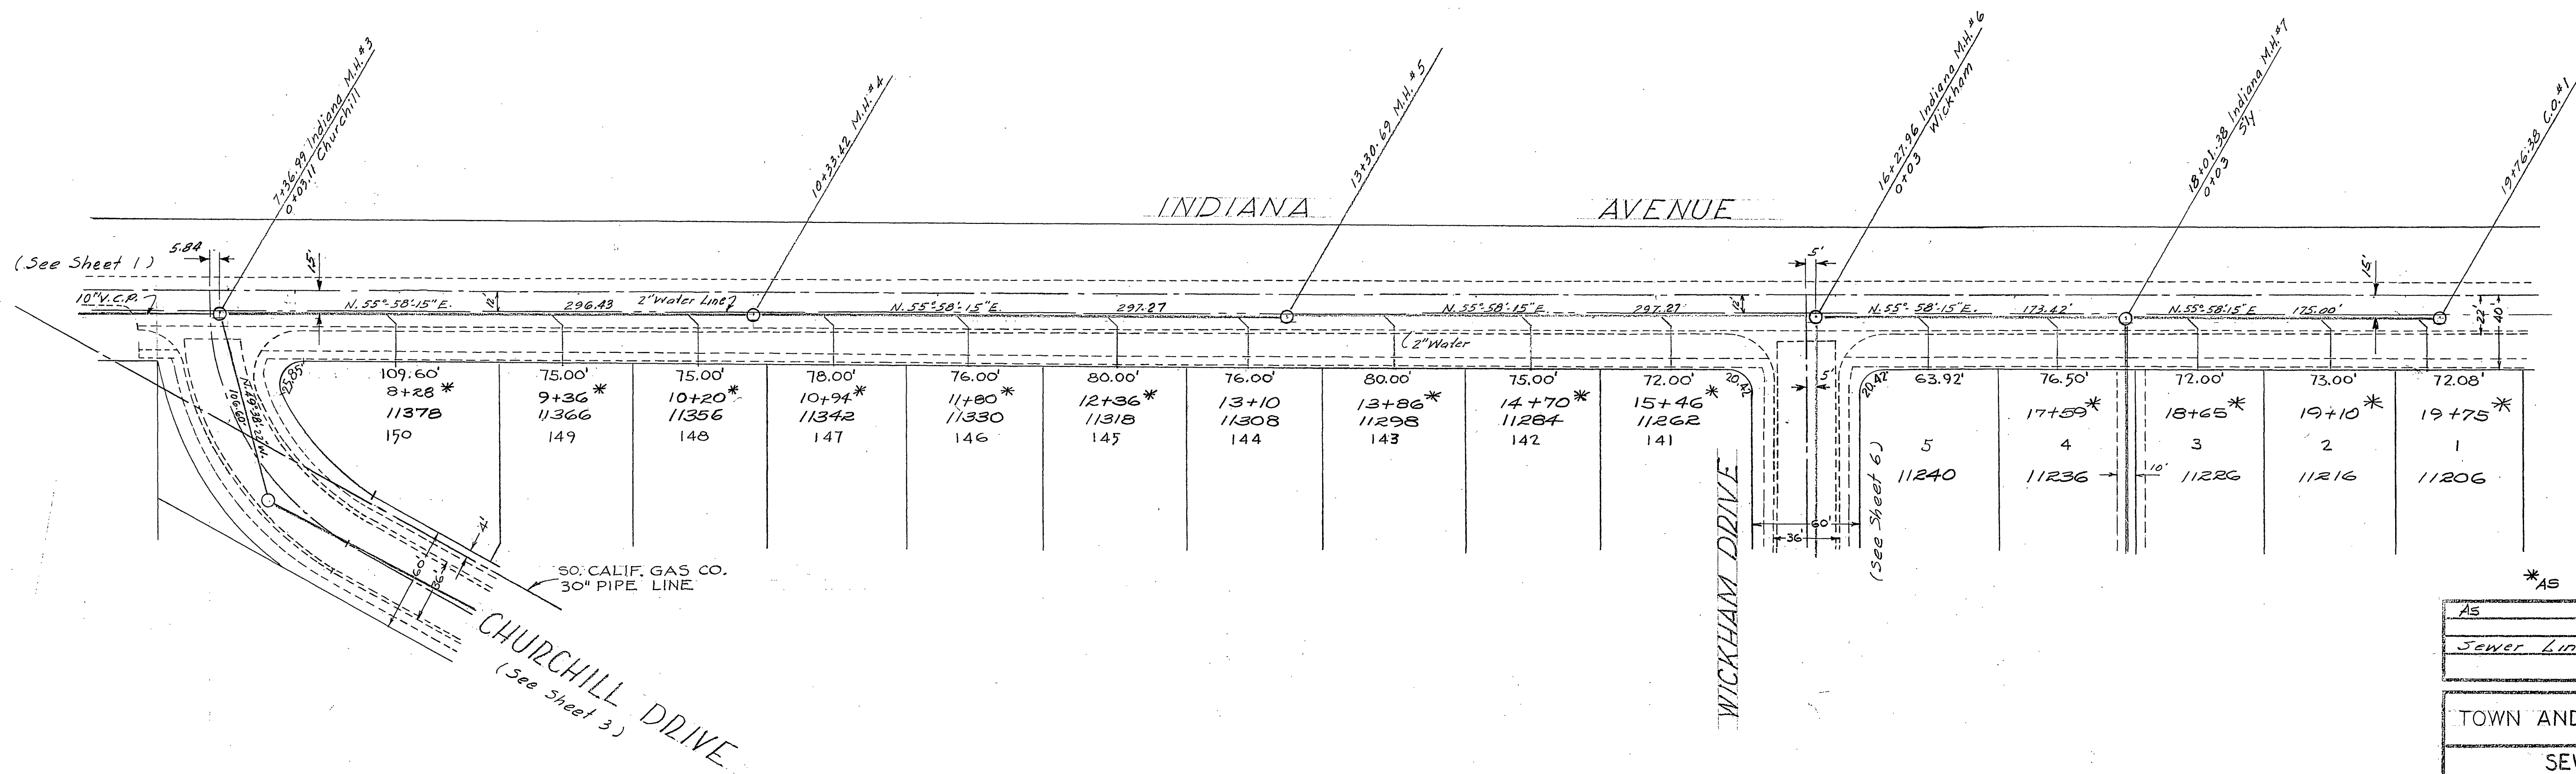


FILE	DATE
NOTES OVERLEAF	
REVISIONS NOTED	
STRUCTURE NOTATIONS CHECKED	
NO.	


La Sierra Community Services District  
 Approved \_\_\_\_\_ 19\_\_\_\_  
 By \_\_\_\_\_

DATE May 12, 1960  
 APPROVED Sewer Line Layout & Velocities  
 RIVERSIDE COUNTY DEPARTMENT OF PUBLIC HEALTH  
 BY Dr. J. Lawrence

*AS BUILT	
AS	
Sewer Line Relocated	52460 REC
REVISIONS	DATE BY
TOWN AND COUNTRY ESTATES UNIT NO. 4	
SEWER PLAN AND PROFILE	
INDIANA AVENUE	
SCALE 1"=50'	W.O. 59-186
DATE 12-59	SHEET 2
DRAWN L.G.	OF 11 SHEETS
TRACED	DWG. NO. 59-186
CHECKED	
P.E. 339	
ALBERT A. WEBB ASSOCIATES	
CIVIL ENGINEERS	
RIVERSIDE CALIFORNIA	

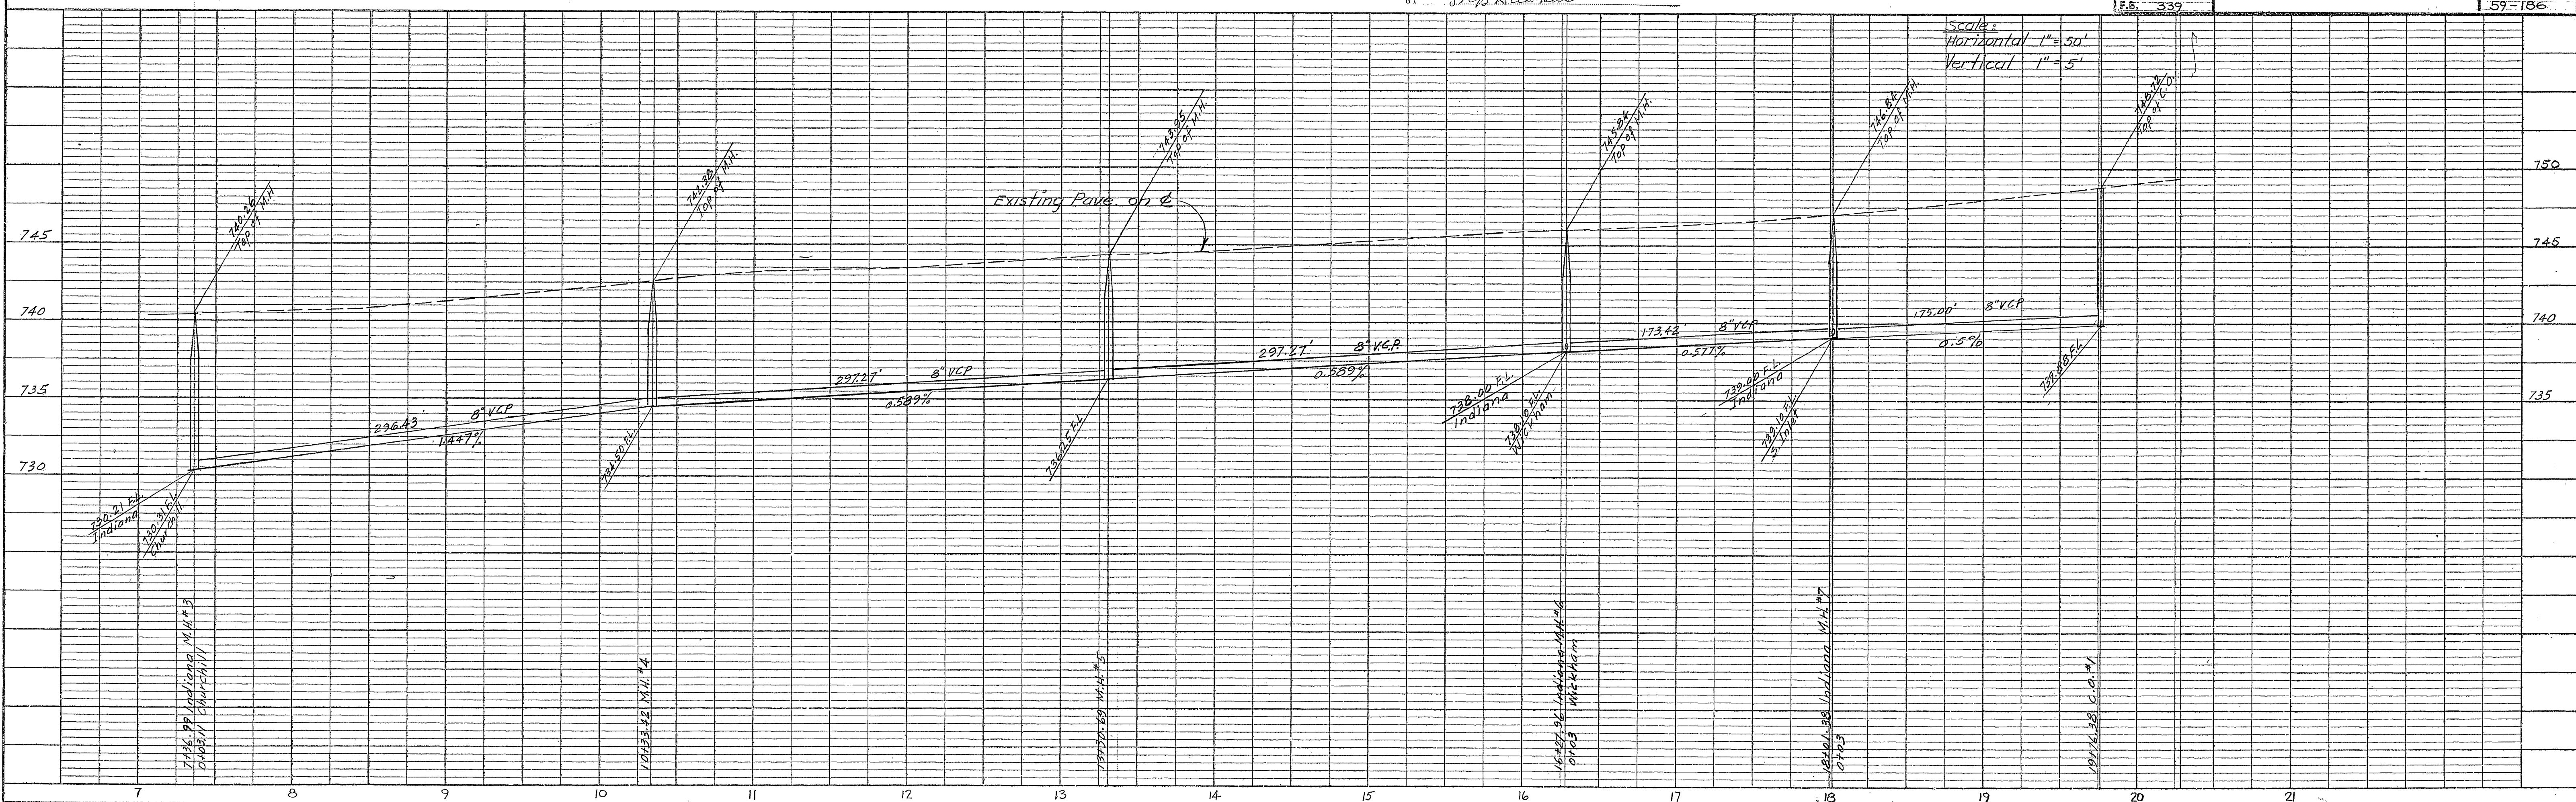


PLAN SURVEYED BY DATE  
 PLOTTED BY  
 NOTE BOOK NO.  
 CHECKED BY  
 DATE  
 BY

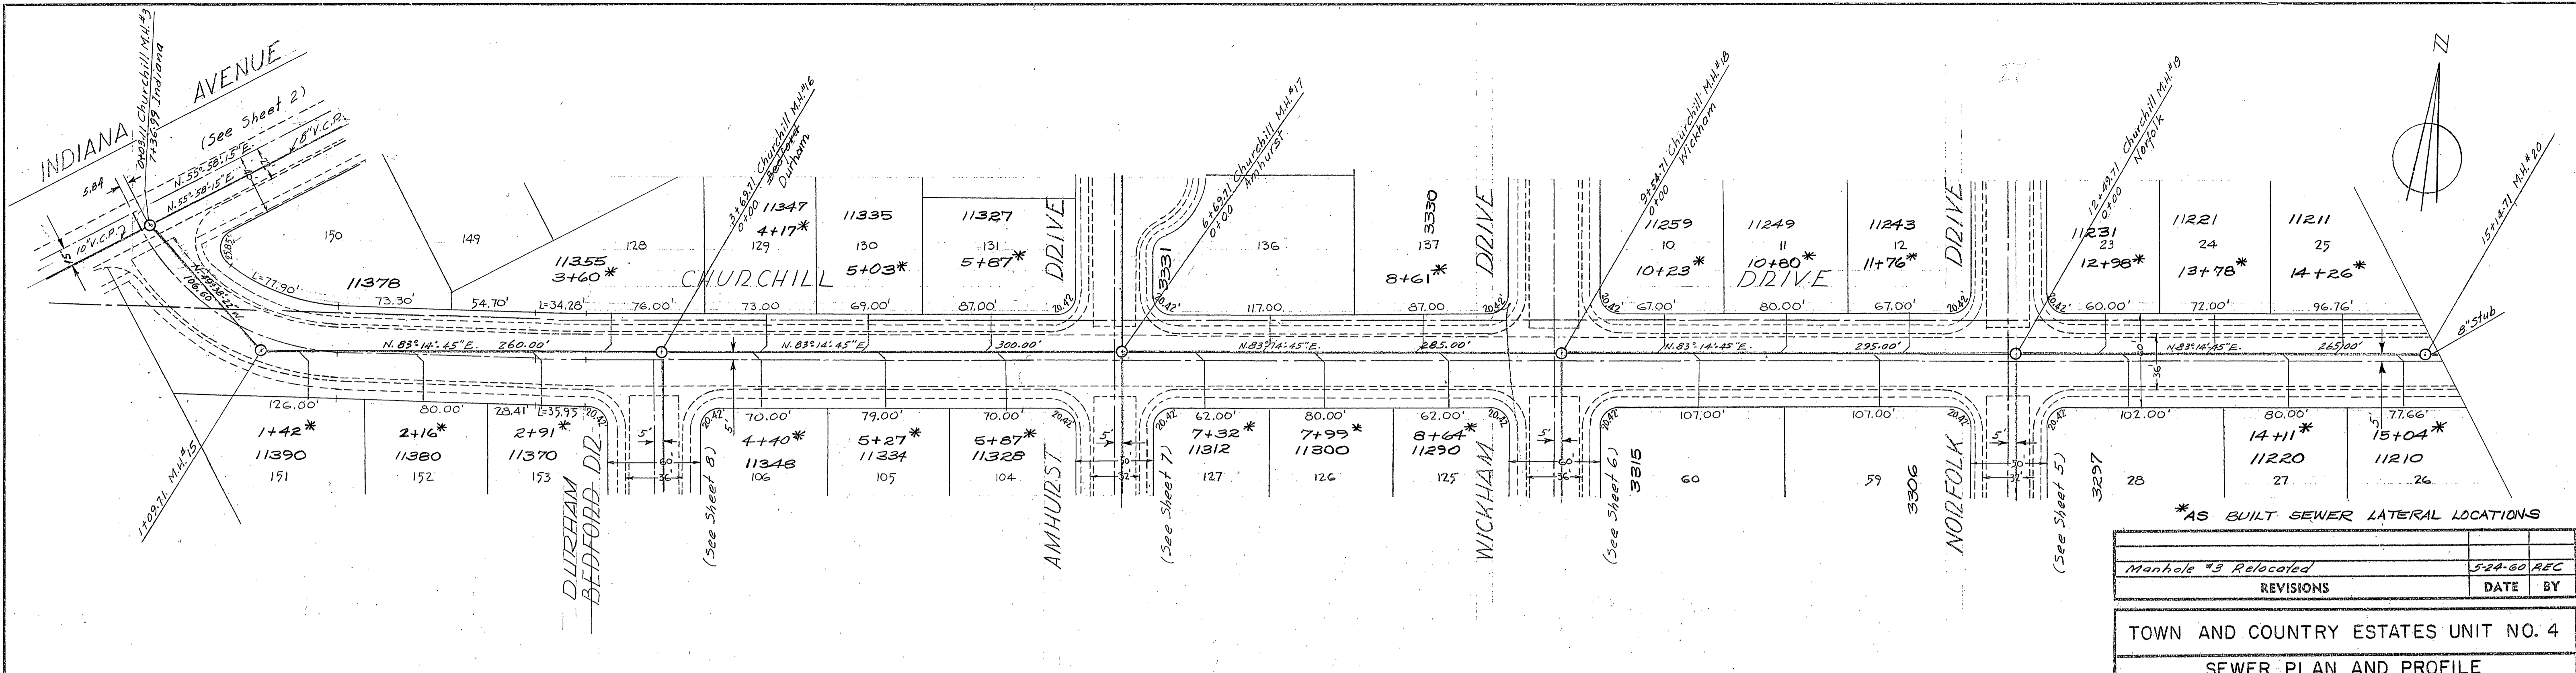



La Sierra Community Services District  
 Approved \_\_\_\_\_ 1959  
 By \_\_\_\_\_

* AS BUILT SEWER LATERAL LOCATIONS	
Manhole #9 Relocated	524-60 REC
REVISIONS	DATE BY
TOWN AND COUNTRY ESTATES UNIT NO. 4	
SEWER PLAN AND PROFILE	
CHURCHILL DRIVE	
SCALE 1"=50'	W.O. 59-186
DATE 12-59	SHEET 3
DRAWN L.G.	OF 11 SHEETS
TRACED	DWG. NO. 59-186
CHECKED	
F.B. 339	
ALBERT A. WEBB ASSOCIATES CIVIL ENGINEERS	RIVERSIDE CALIFORNIA

PROFILE SURVEYED BY DATE  
 PLOTTED BY  
 NOTE BOOK NO.  
 CHECKED BY  
 DATE  
 BY

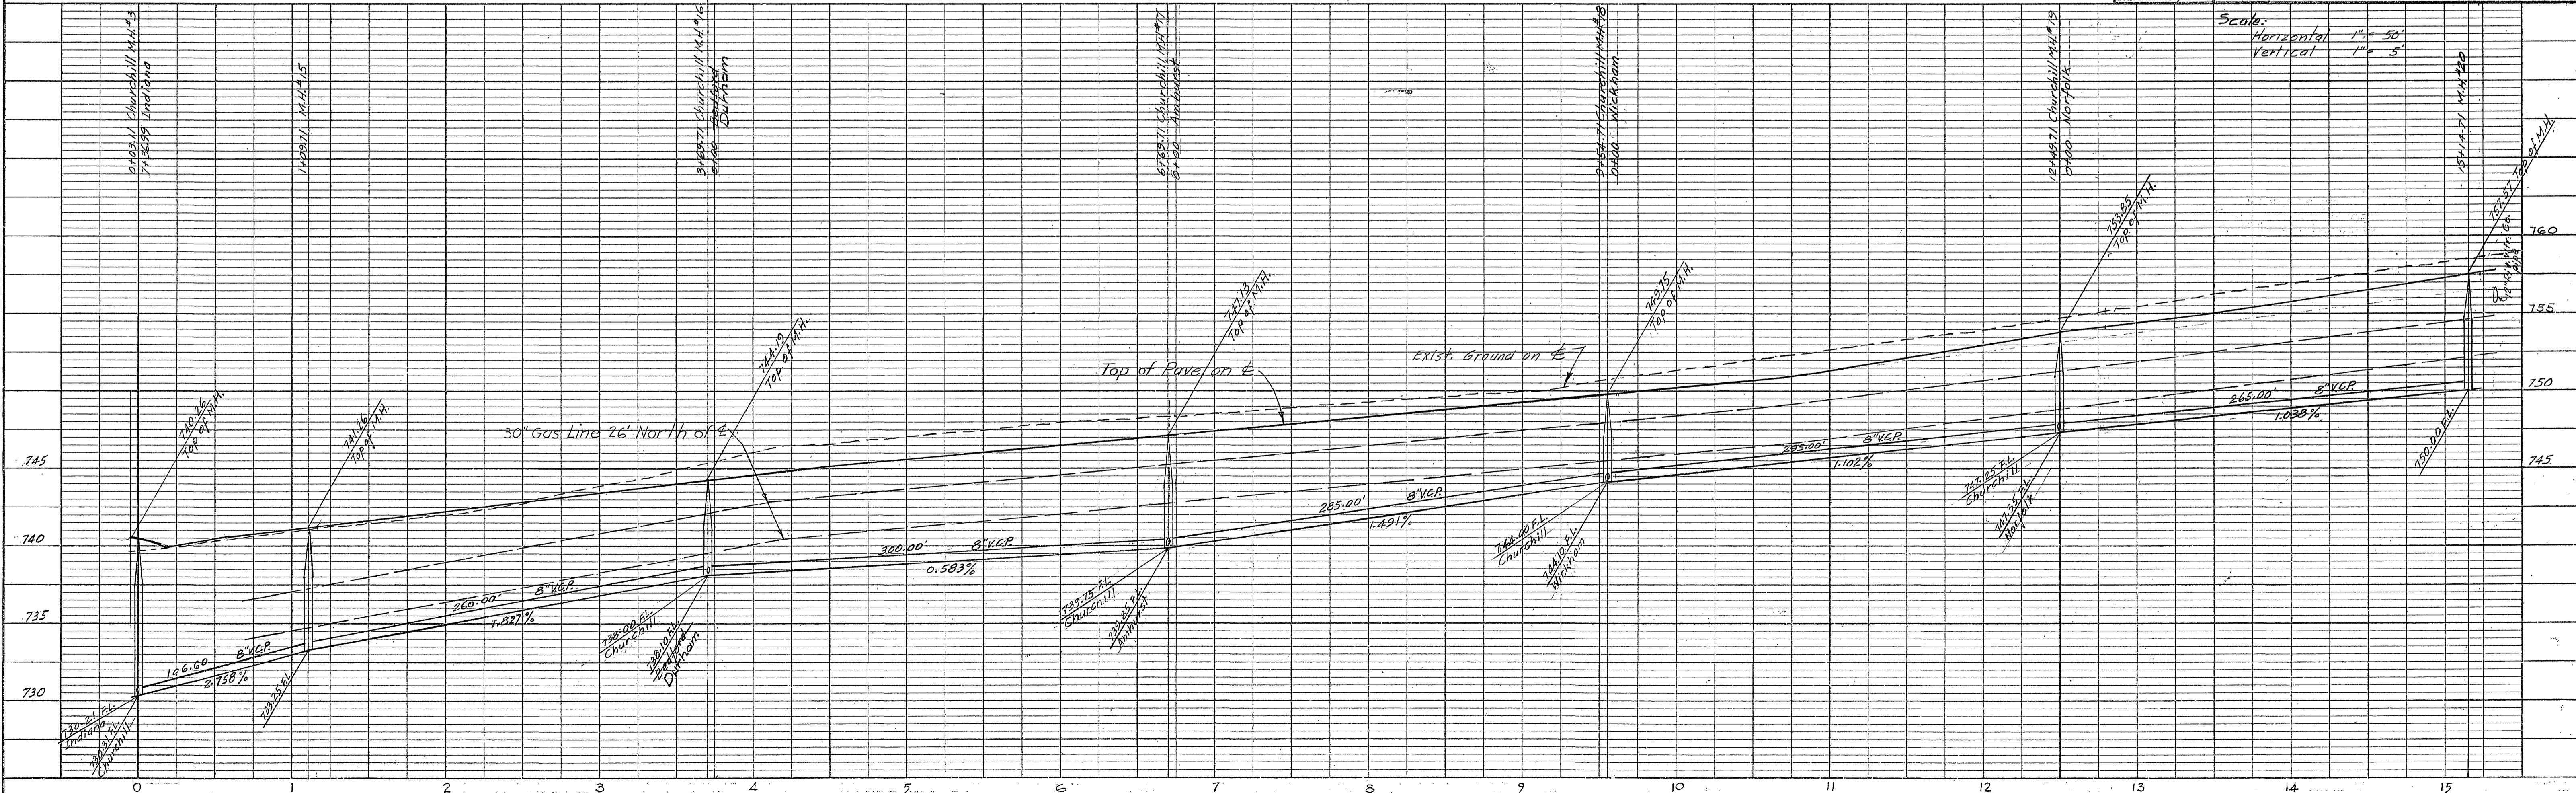

PLAN	SURVEYED	DATE
NOTE BOOK	PLOTTED	BY
NO.	CHECKED	
	RT. OF WAY CHECKED	

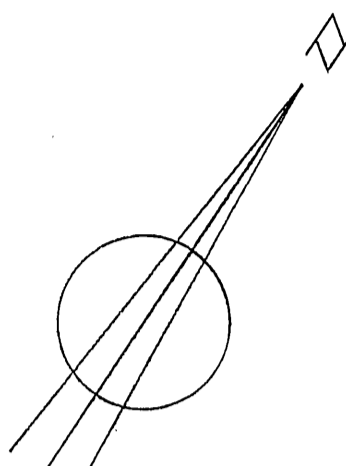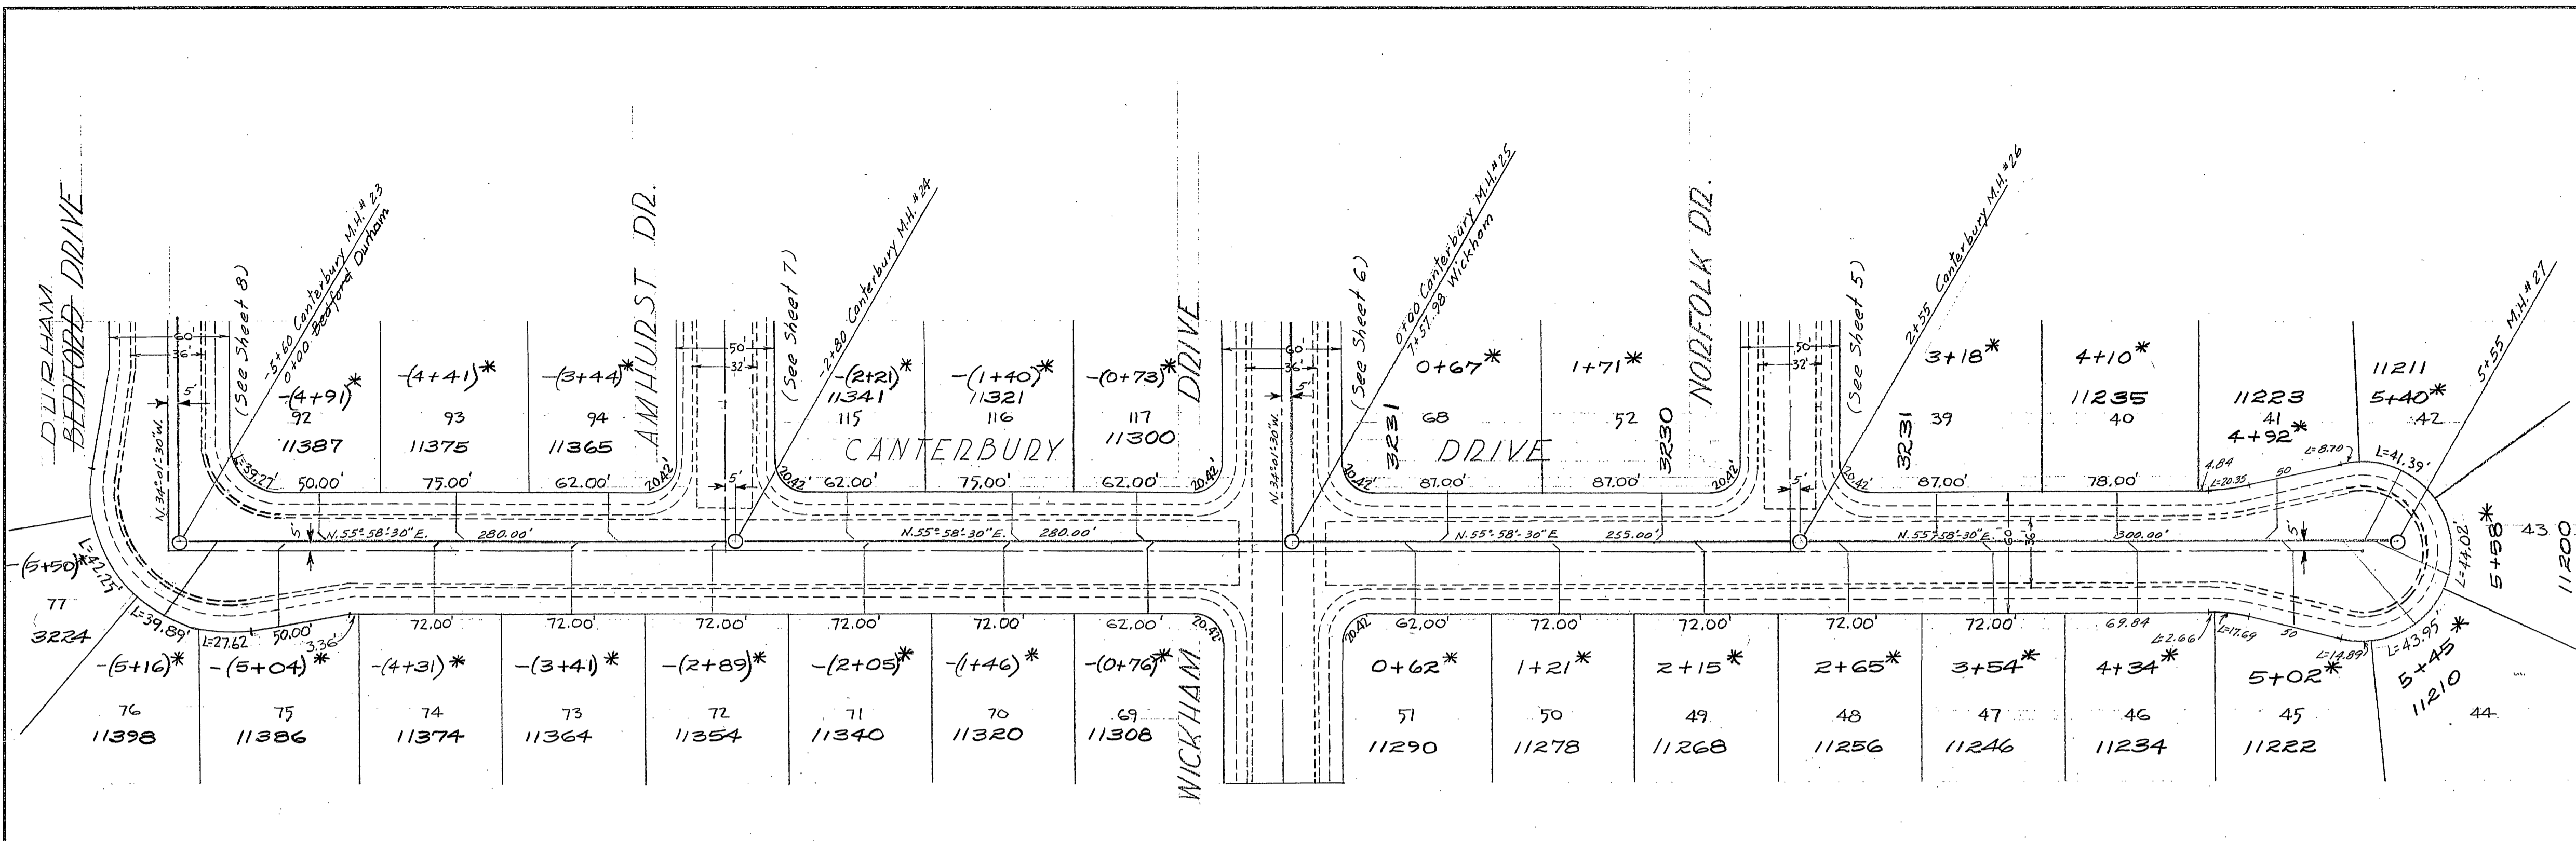

La Sierra Community Services District


Approved \_\_\_\_\_ 1959

By \_\_\_\_\_

\*AS BUILT SEWER LATERAL LOCATIONS


REVISIONS		DATE	BY
TOWN AND COUNTRY ESTATES UNIT NO. 4			
SEWER PLAN AND PROFILE			
CANTERBURY DRIVE			
SCALE 1"=20'	DATE 12-59	W.O. 59-186	
DRAWN L.G.	CHECKED	SHEET 4	
TRACED	F.B. 339	OF 11 SHEETS	
CHECKED		DWG. NO. 59-186	
ALBERT A. WEBB ASSOCIATES CIVIL ENGINEERS		RIVERSIDE CALIFORNIA	

PROFILE	SURVEYED	DATE
NOTE BOOK	PLOTTED	BY
NO.	CHECKED	
	RT. OF WAY CHECKED	

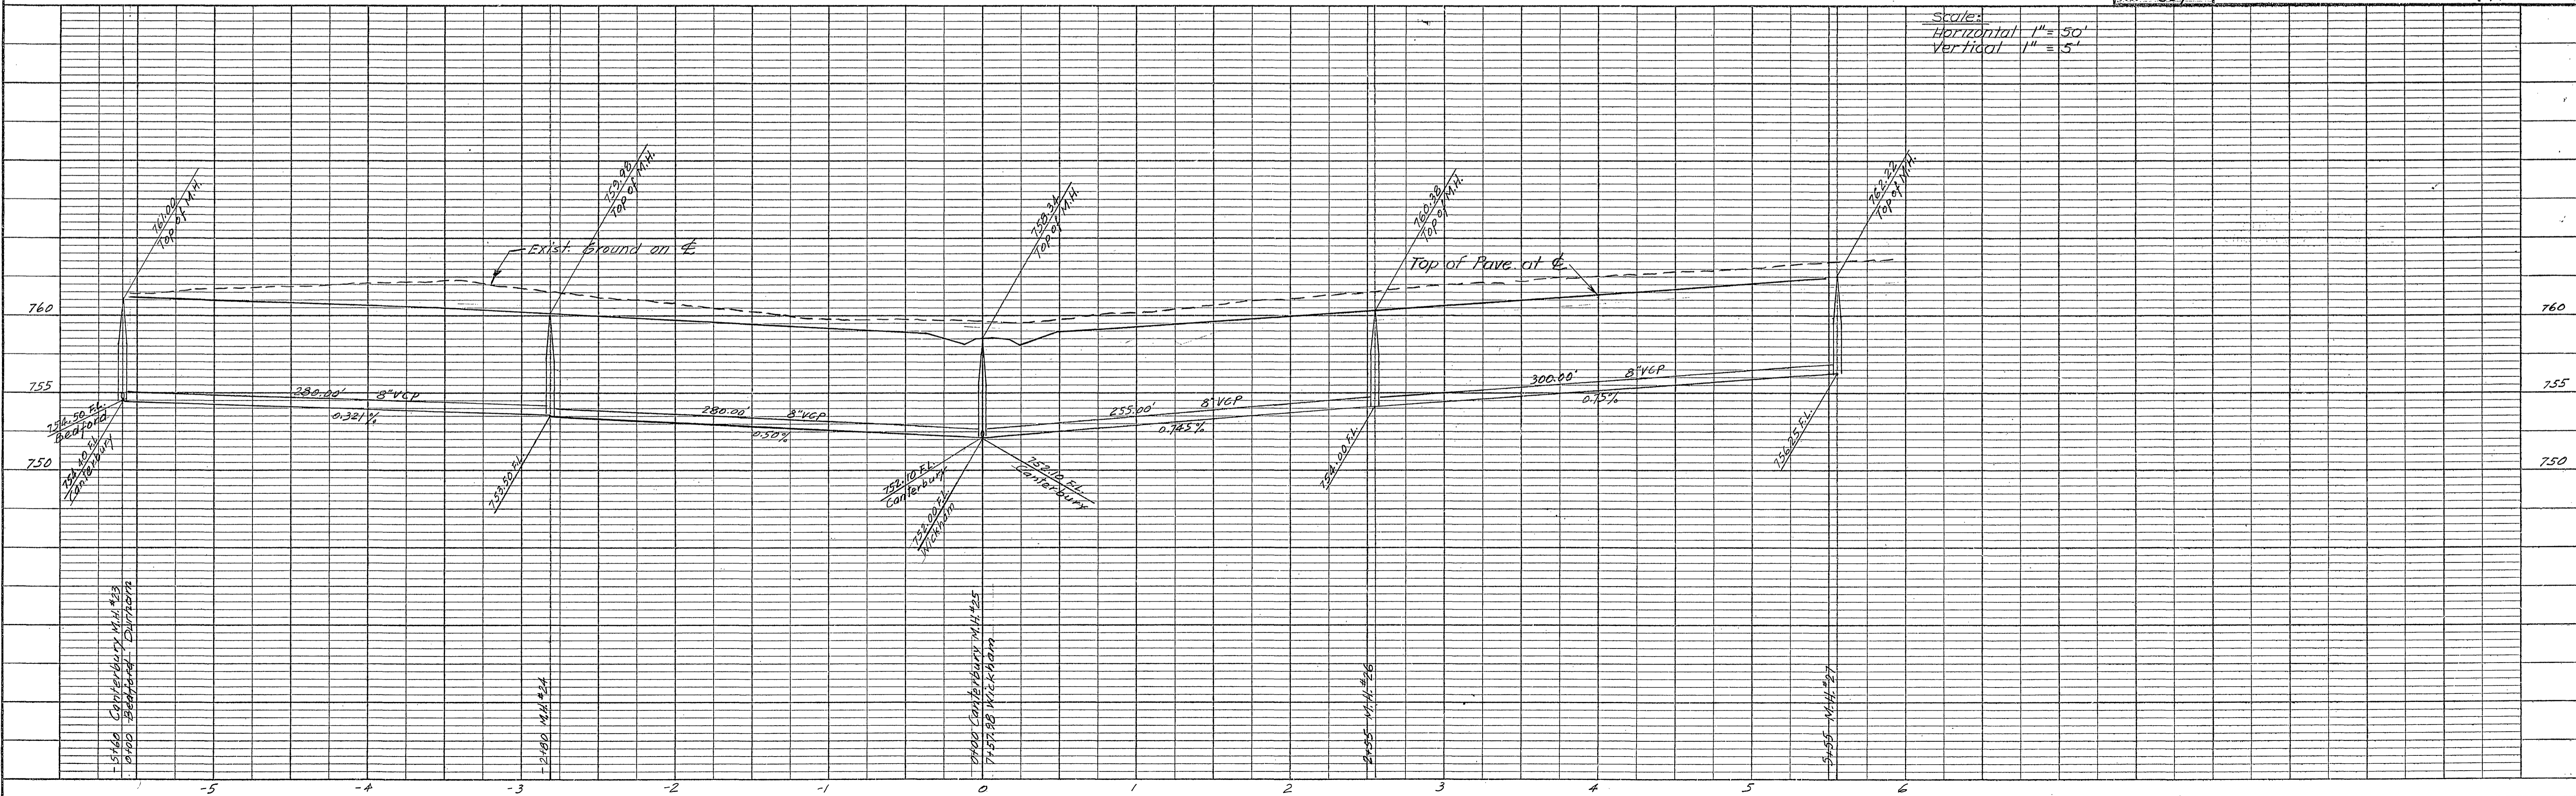

Scale:  
Horizontal 1"=50'  
Vertical 1"=5'

PLAN SURVEYED BY DATE  
 PLOTTED BY  
 NOTE BOOK NO. CHECKED BY  
 RT. OF WAY CHECKED BY

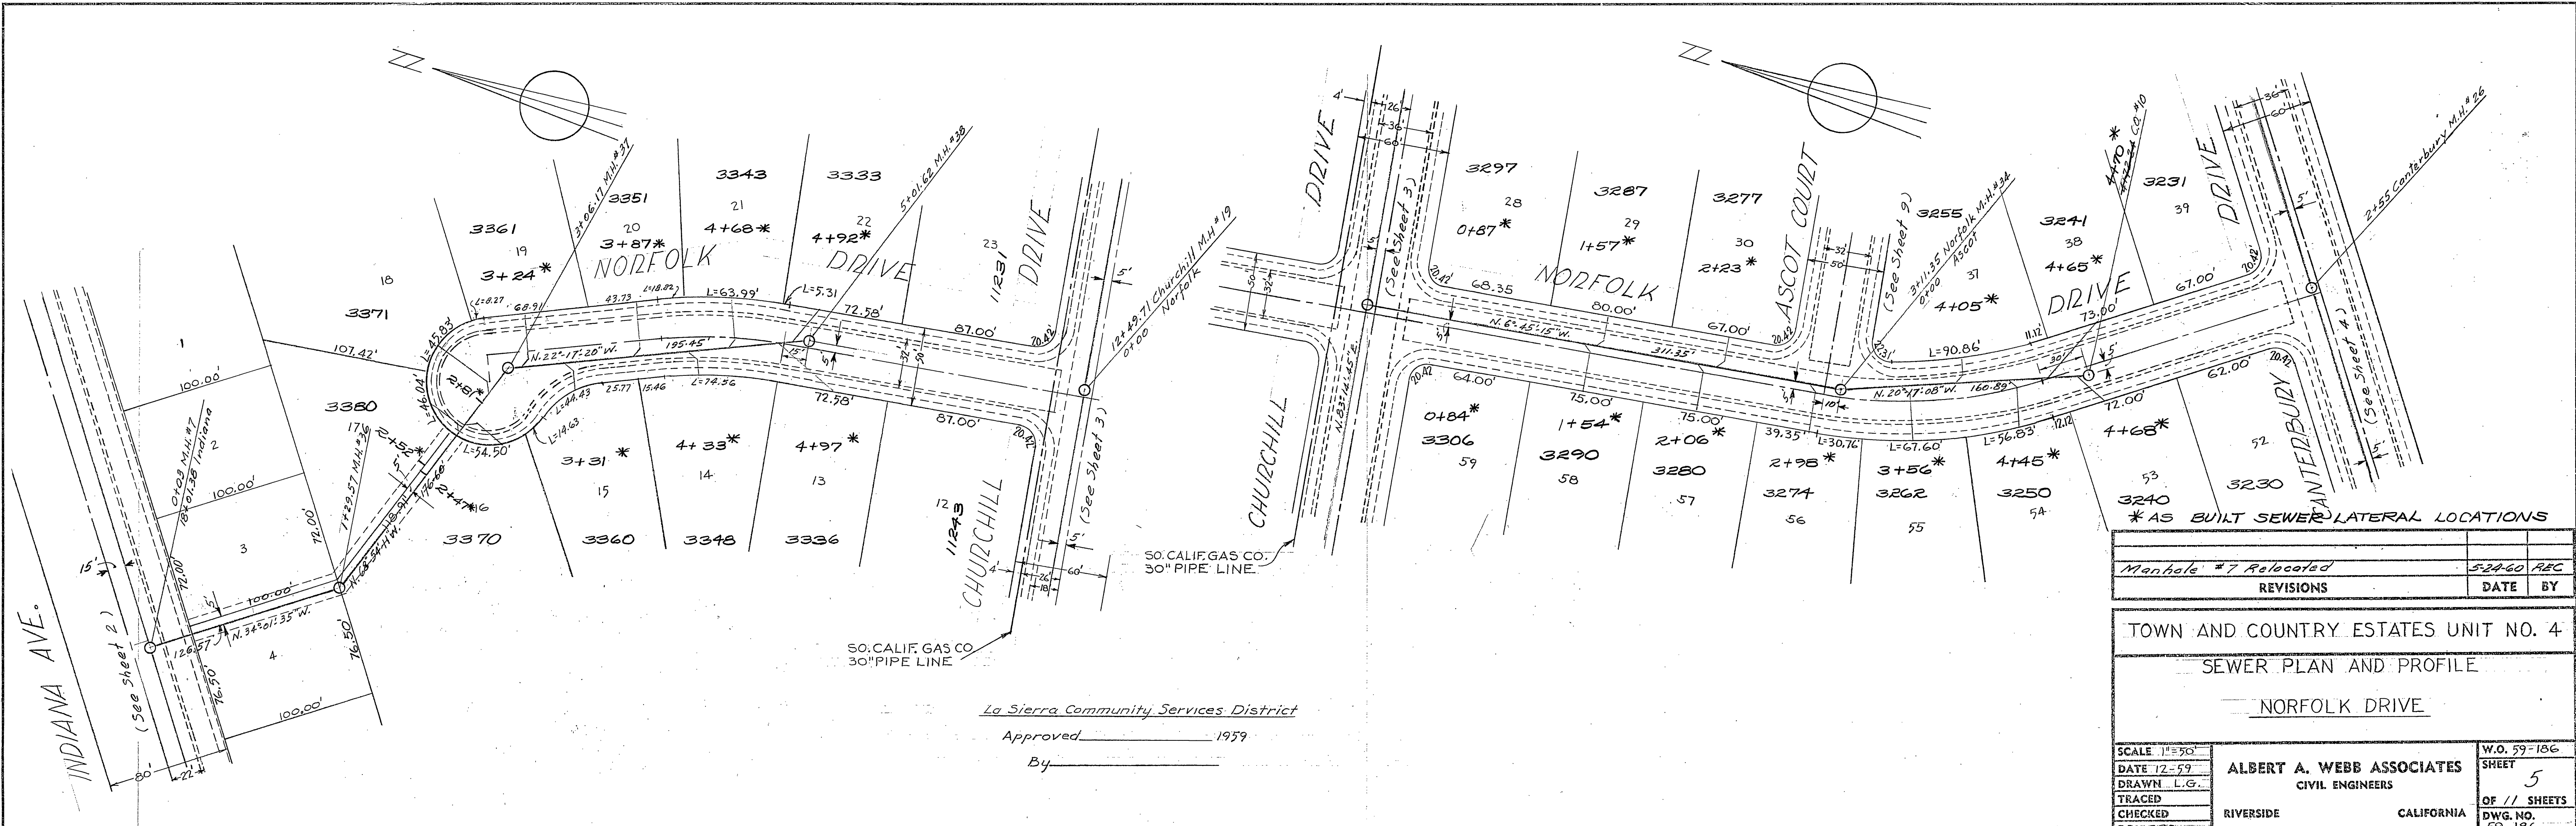


La Sierra Community Services District  
 Approved \_\_\_\_\_ 1959  
 By \_\_\_\_\_

REVISIONS	DATE	BY
Manhole #7 Relocated	5-24-60	REC


TOWN AND COUNTRY ESTATES UNIT NO. 4  
 SEWER PLAN AND PROFILE  
 NORFOLK DRIVE

SCALE 1"=50'	W.D. 59-186
DATE 12-59	SHEET 5
DRAWN L.G.	OF 11 SHEETS
TRACED	DWG. NO. 59-186
CHECKED	
F.B. 339	
ALBERT A. WEBB ASSOCIATES CIVIL ENGINEERS RIVERSIDE CALIFORNIA	

PROFILE SURVEYED BY DATE  
 PLOTTED BY  
 NOTE BOOK NO. CHECKED BY  
 STRUCTURE NOTATIONS CHK'D

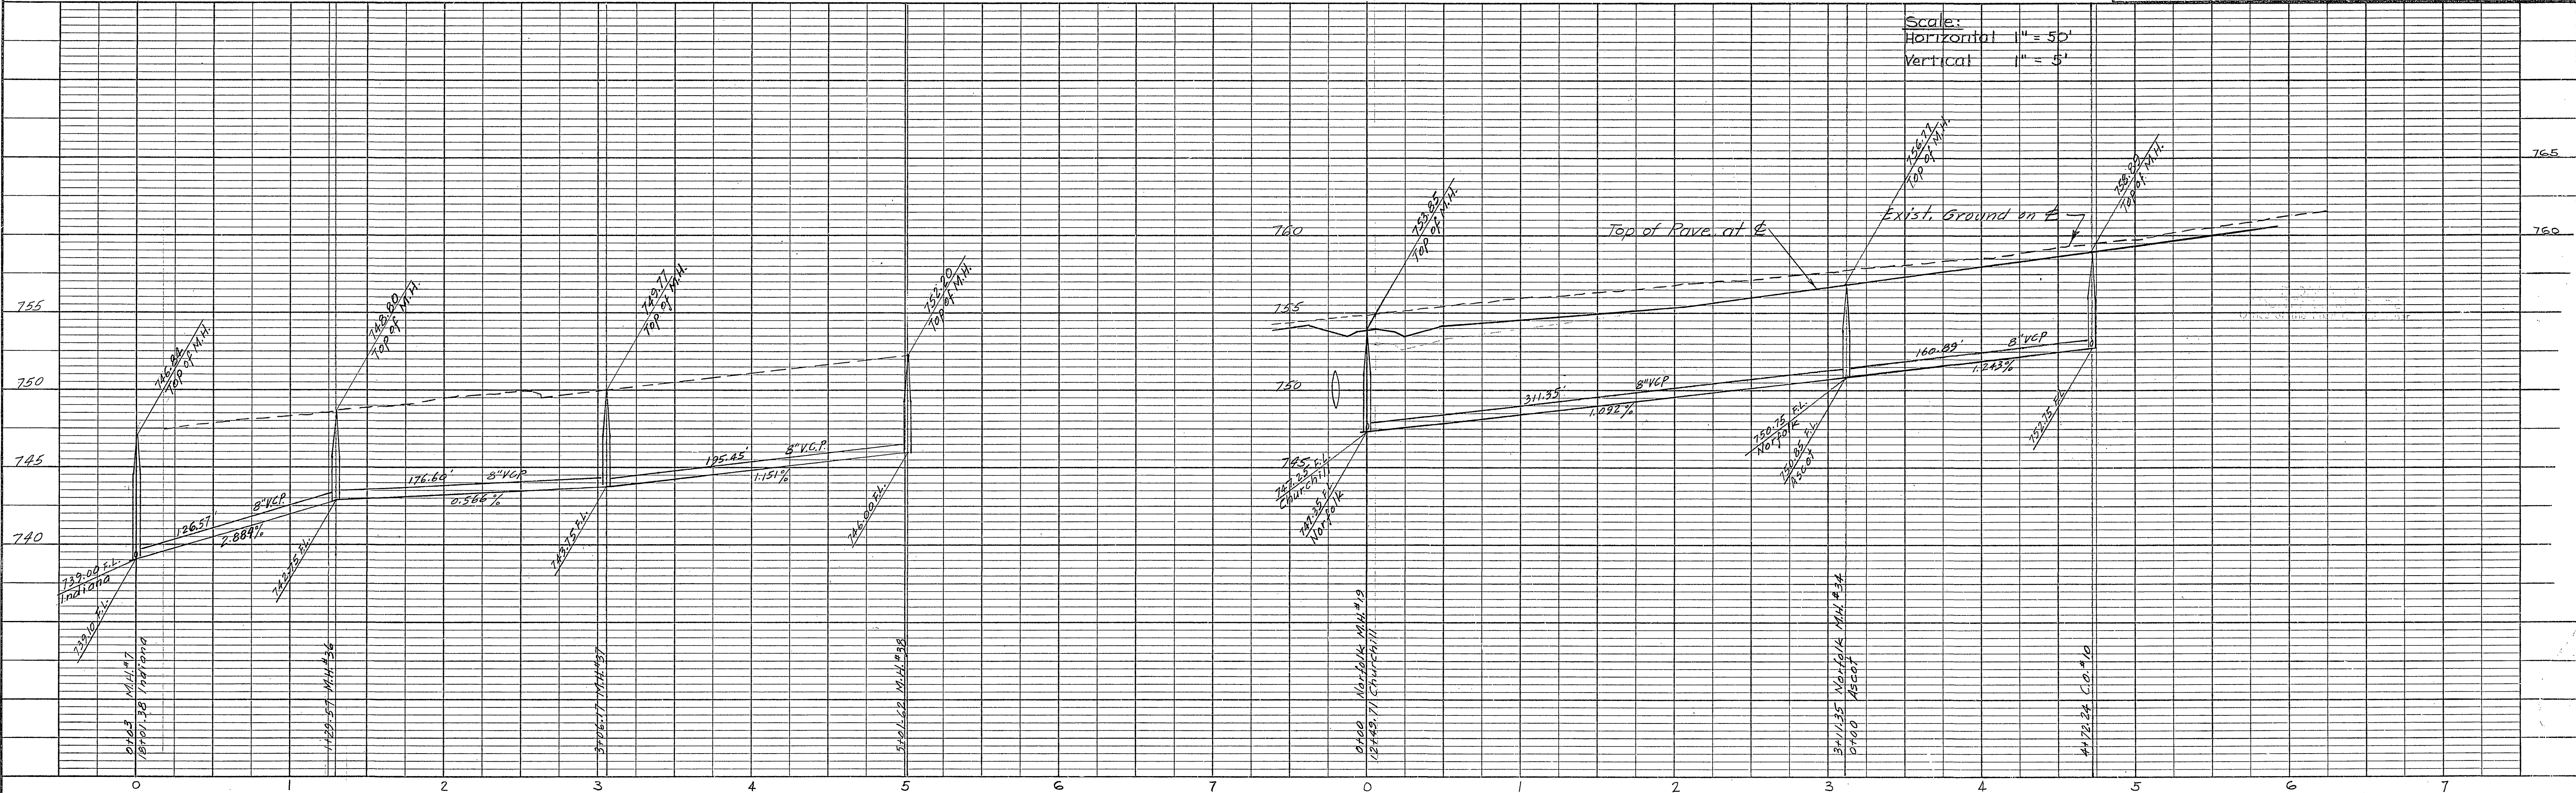

PLAN	DATE
SURVEYED	BY
ALIGNED	DATE
GRADES CHECKED	
RT. OF WAY CHECKED	
NO.	

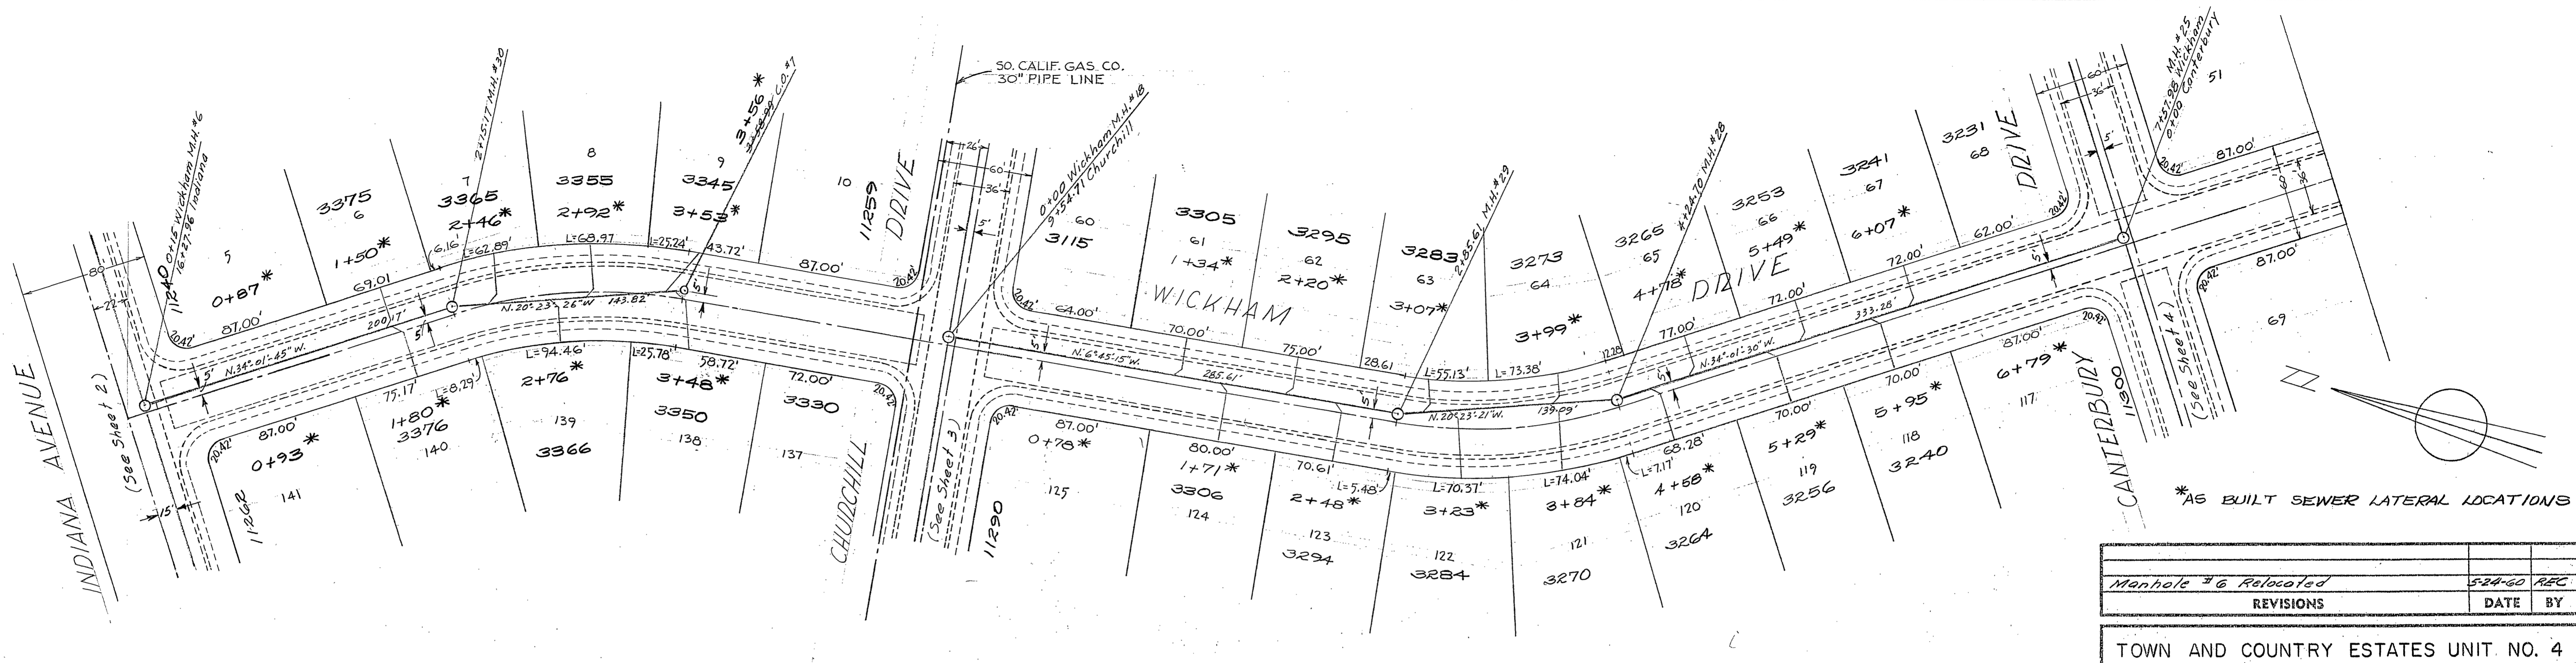


Manhole #6 Relocated	5-24-60	REC
REVISIONS	DATE	BY

TOWN AND COUNTRY ESTATES UNIT NO. 4  
SEWER PLAN AND PROFILE  
WICKHAM DRIVE



SCALE 1"=50'	W.O. 59-186
DATE 12-59	SHEET 6
DRAWN L.G.	OF 11 SHEETS
TRACED	DWG. NO. 59-186
CHECKED	
F.B. 339	

La Sierra Community Services District  
Approved \_\_\_\_\_ 1959  
By \_\_\_\_\_

PROFILE	DATE
SURVEYED	BY
GRADES CHECKED	
B. M.'S NOTED	
STRUCTURE NOTATIONS CHECKED	
NO.	

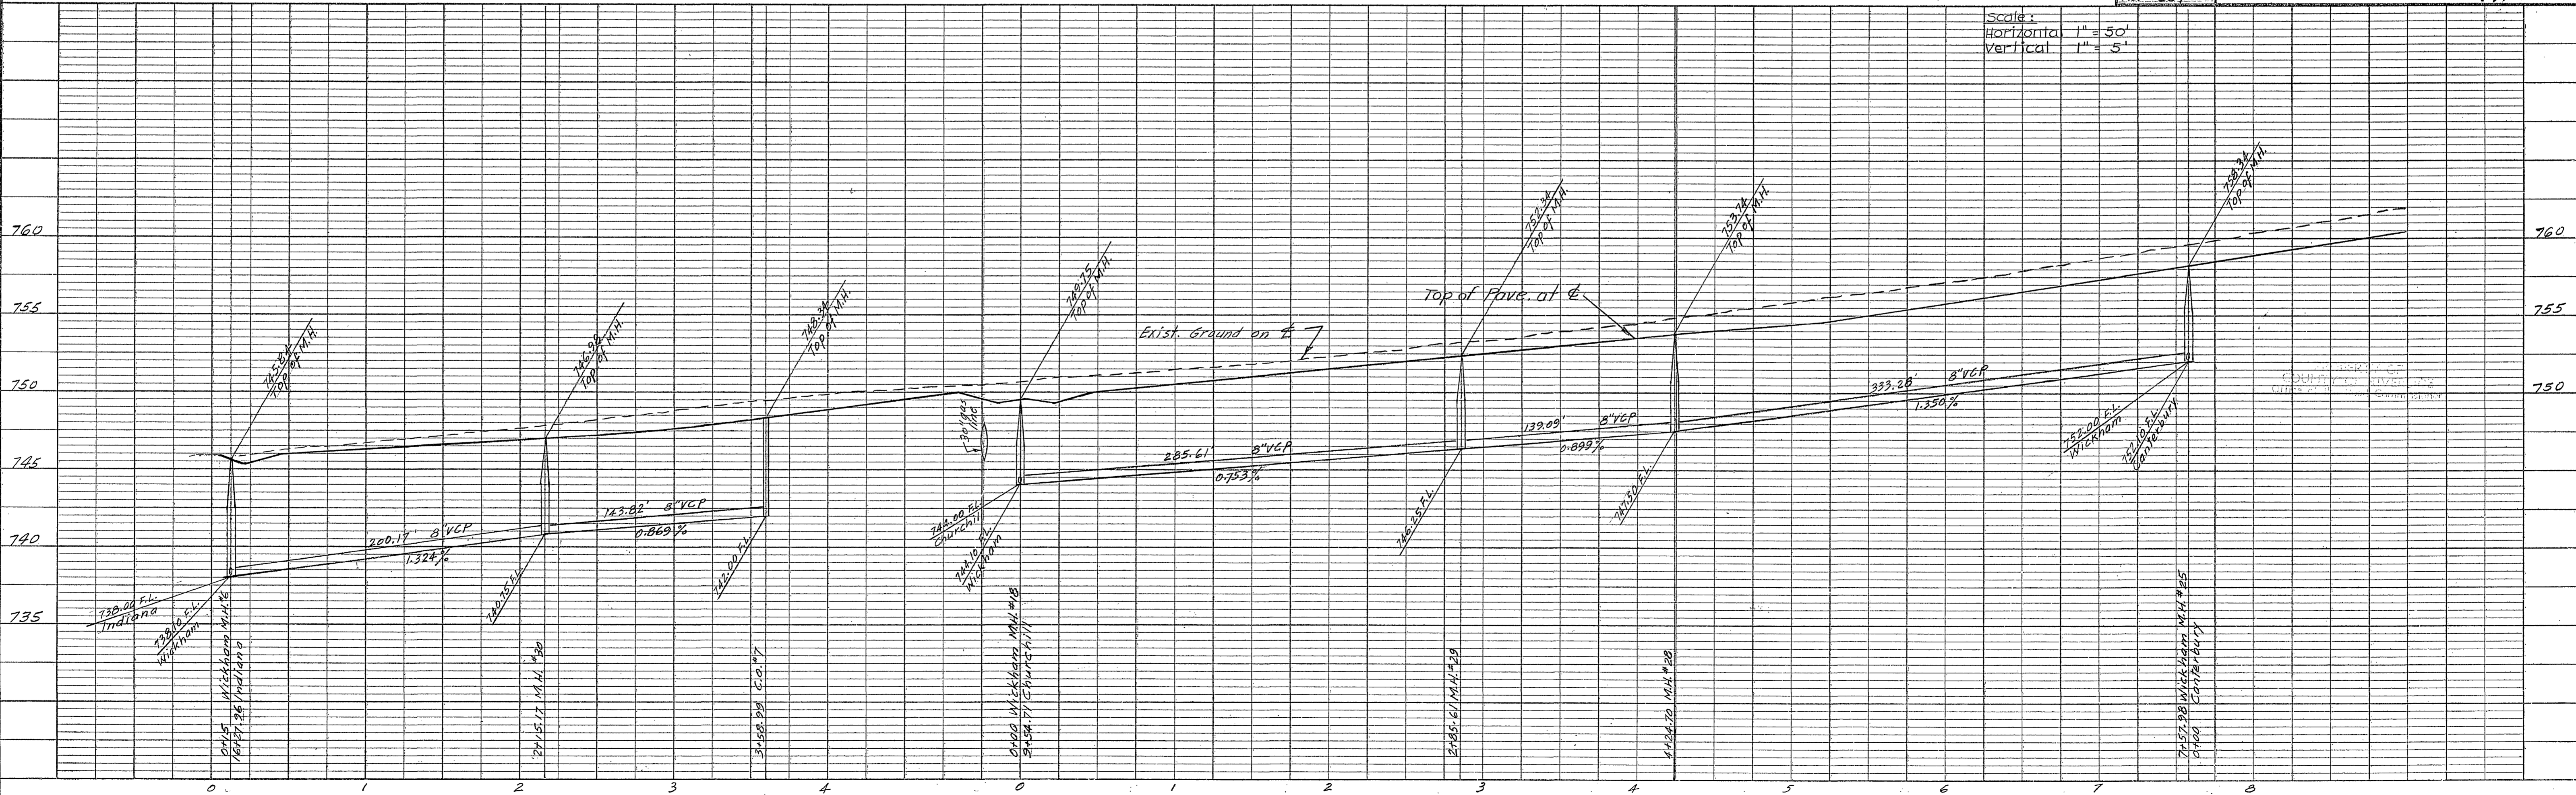

PLAN	SURVEYED	BY	DATE
	PLOTTED		
	ALIGNMENT CHECKED		
	RT. OF WAY CHECKED		
	NO.		

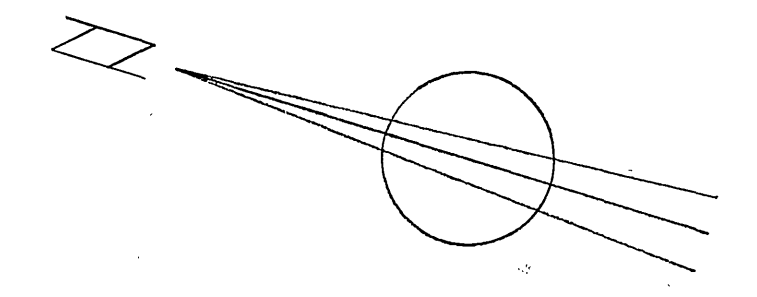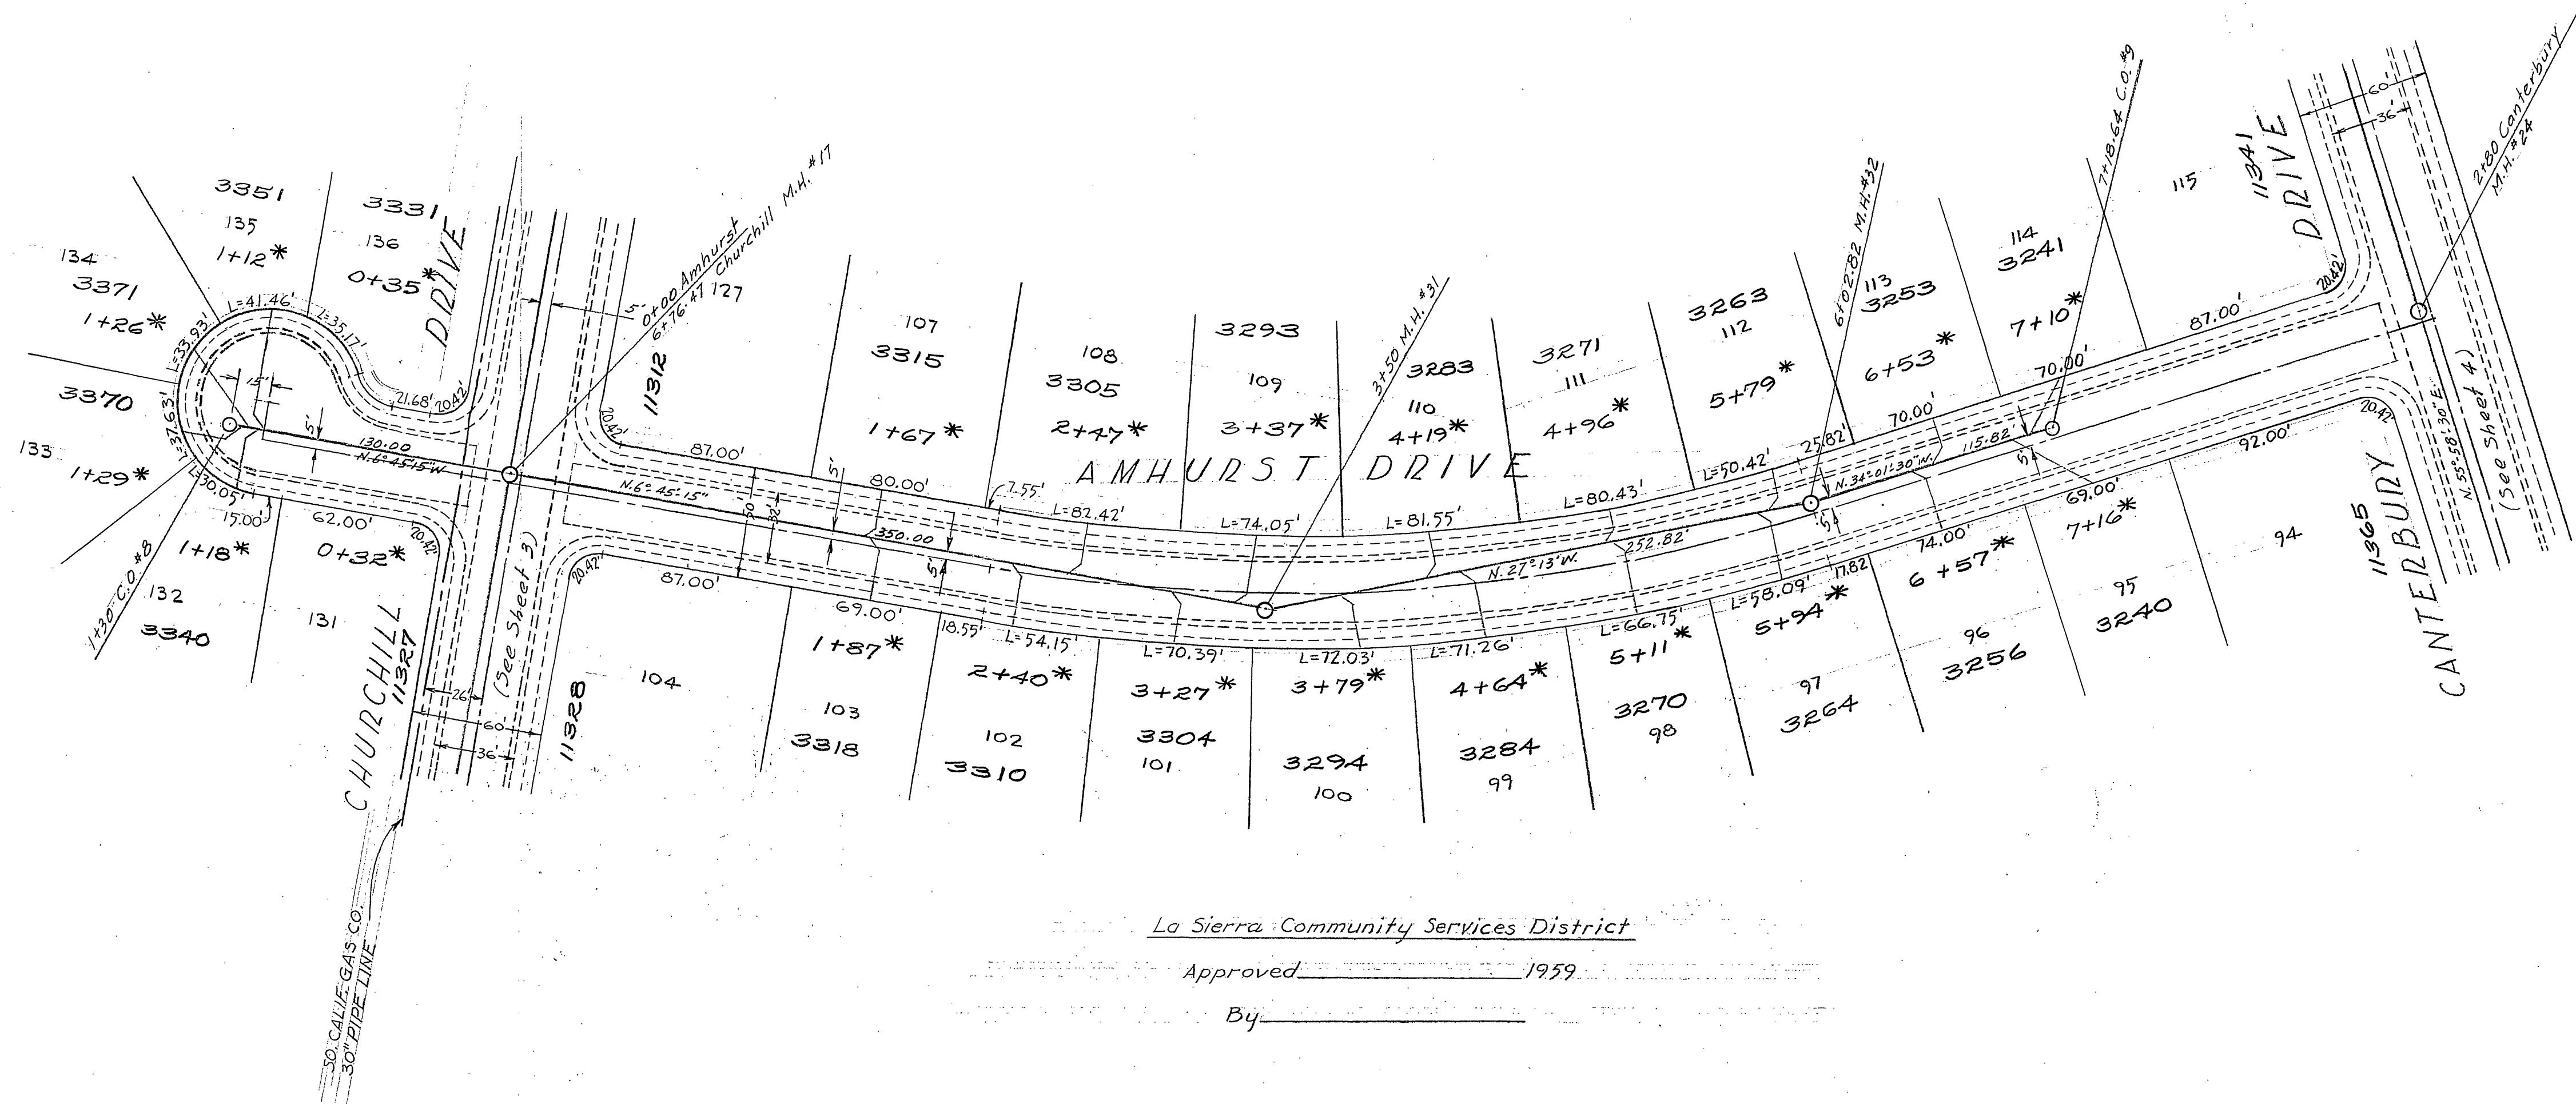

\* AS BUILT SEWER LATERAL LOCATIONS


REVISIONS	DATE	BY

TOWN AND COUNTRY ESTATES UNIT NO 4  
SEWER PLAN AND PROFILE  
AMHURST DRIVE

La Sierra Community Services District  
Approved \_\_\_\_\_ 1959  
By \_\_\_\_\_


SCALE 1"=50'	ALBERT A. WEBB ASSOCIATES CIVIL ENGINEERS RIVERSIDE CALIFORNIA	W.O. 59-186
DATE 12-59		SHEET 7
DRAWN L.G.		OF 11 SHEETS
TRACED		DWG. NO. 59-186
CHECKED		F.B. 339

PROFILE	SURVEYED	BY	DATE
	PLOTTED		
	ALIGNMENT CHECKED		
	STRUCTURE NOTATIONS CHECKED		
	NO.		

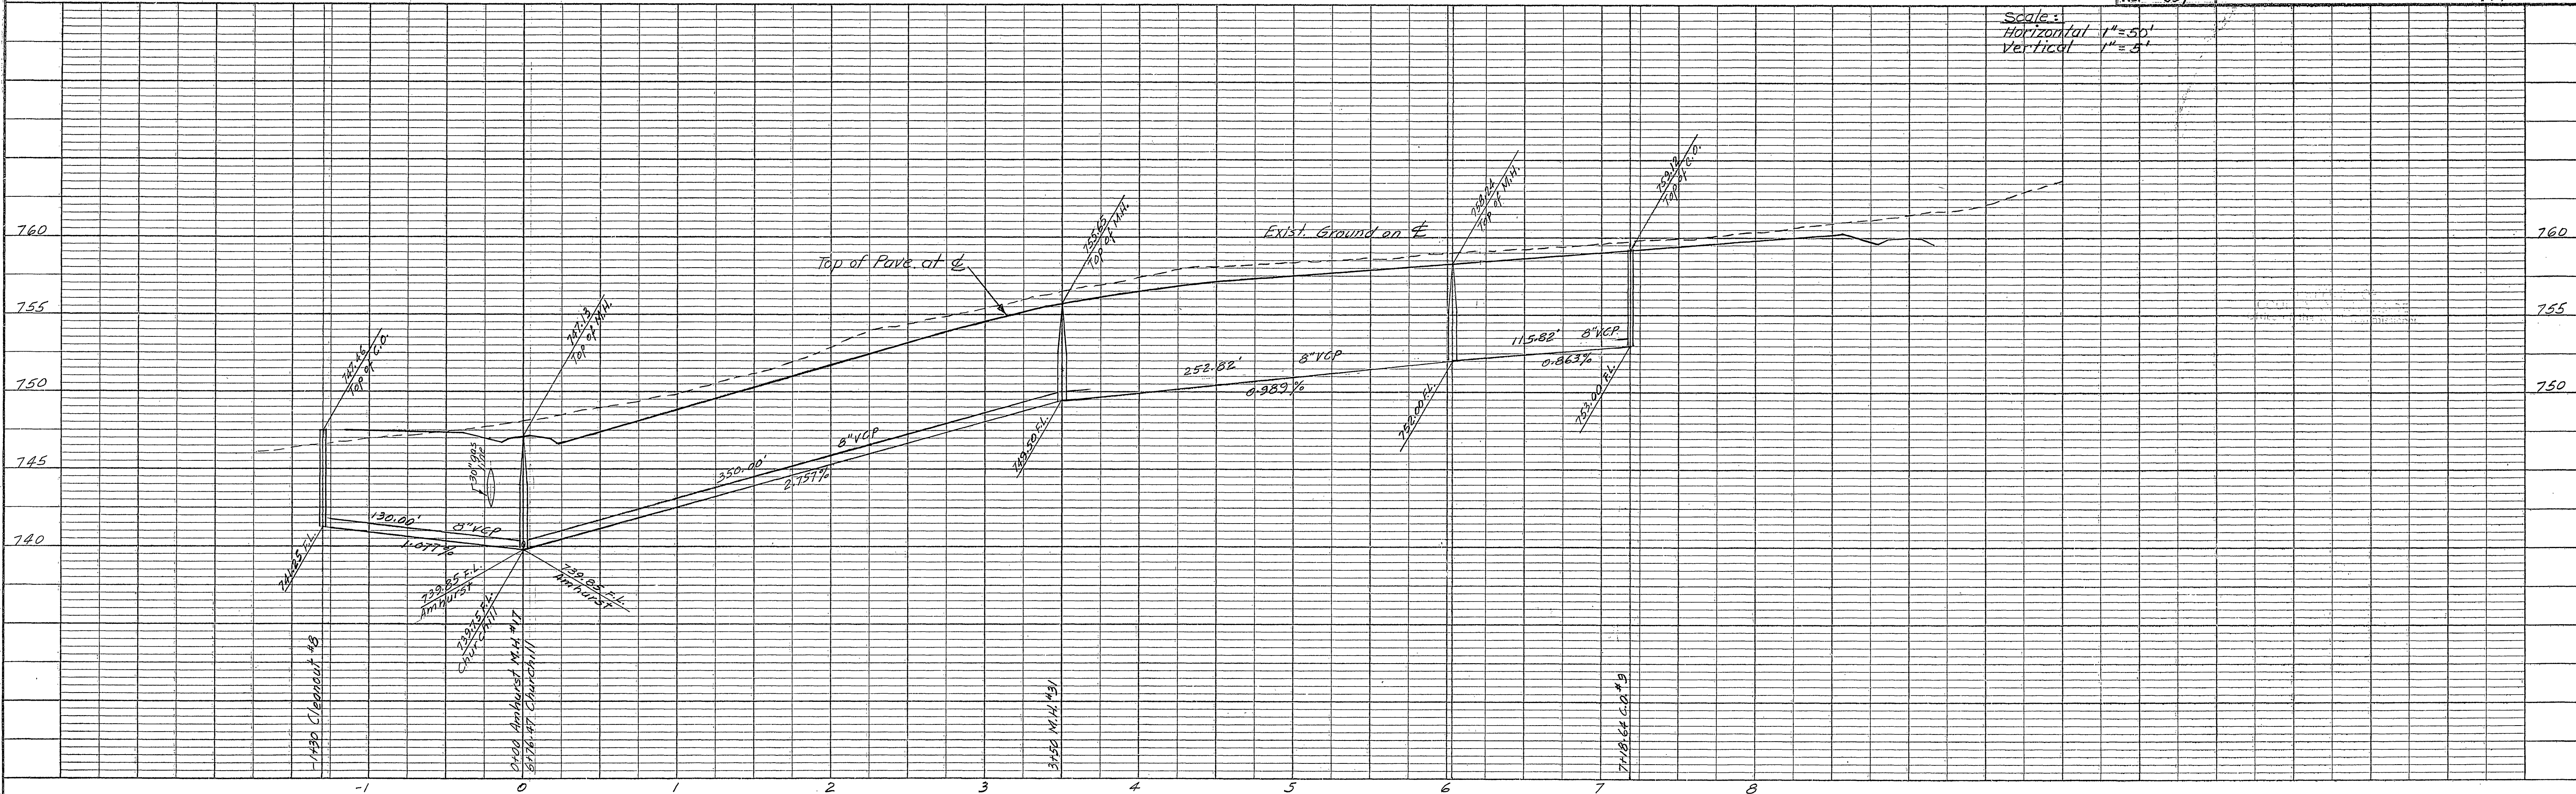

Scale:  
Horizontal 1"=50'  
Vertical 1"=5'

PLAN SURVEYED BY DATE  
 PLOTTED BY  
 NOTE BOOK NO.  
 DATE CHECKED BY  
 RT. OF WAY CHECKED

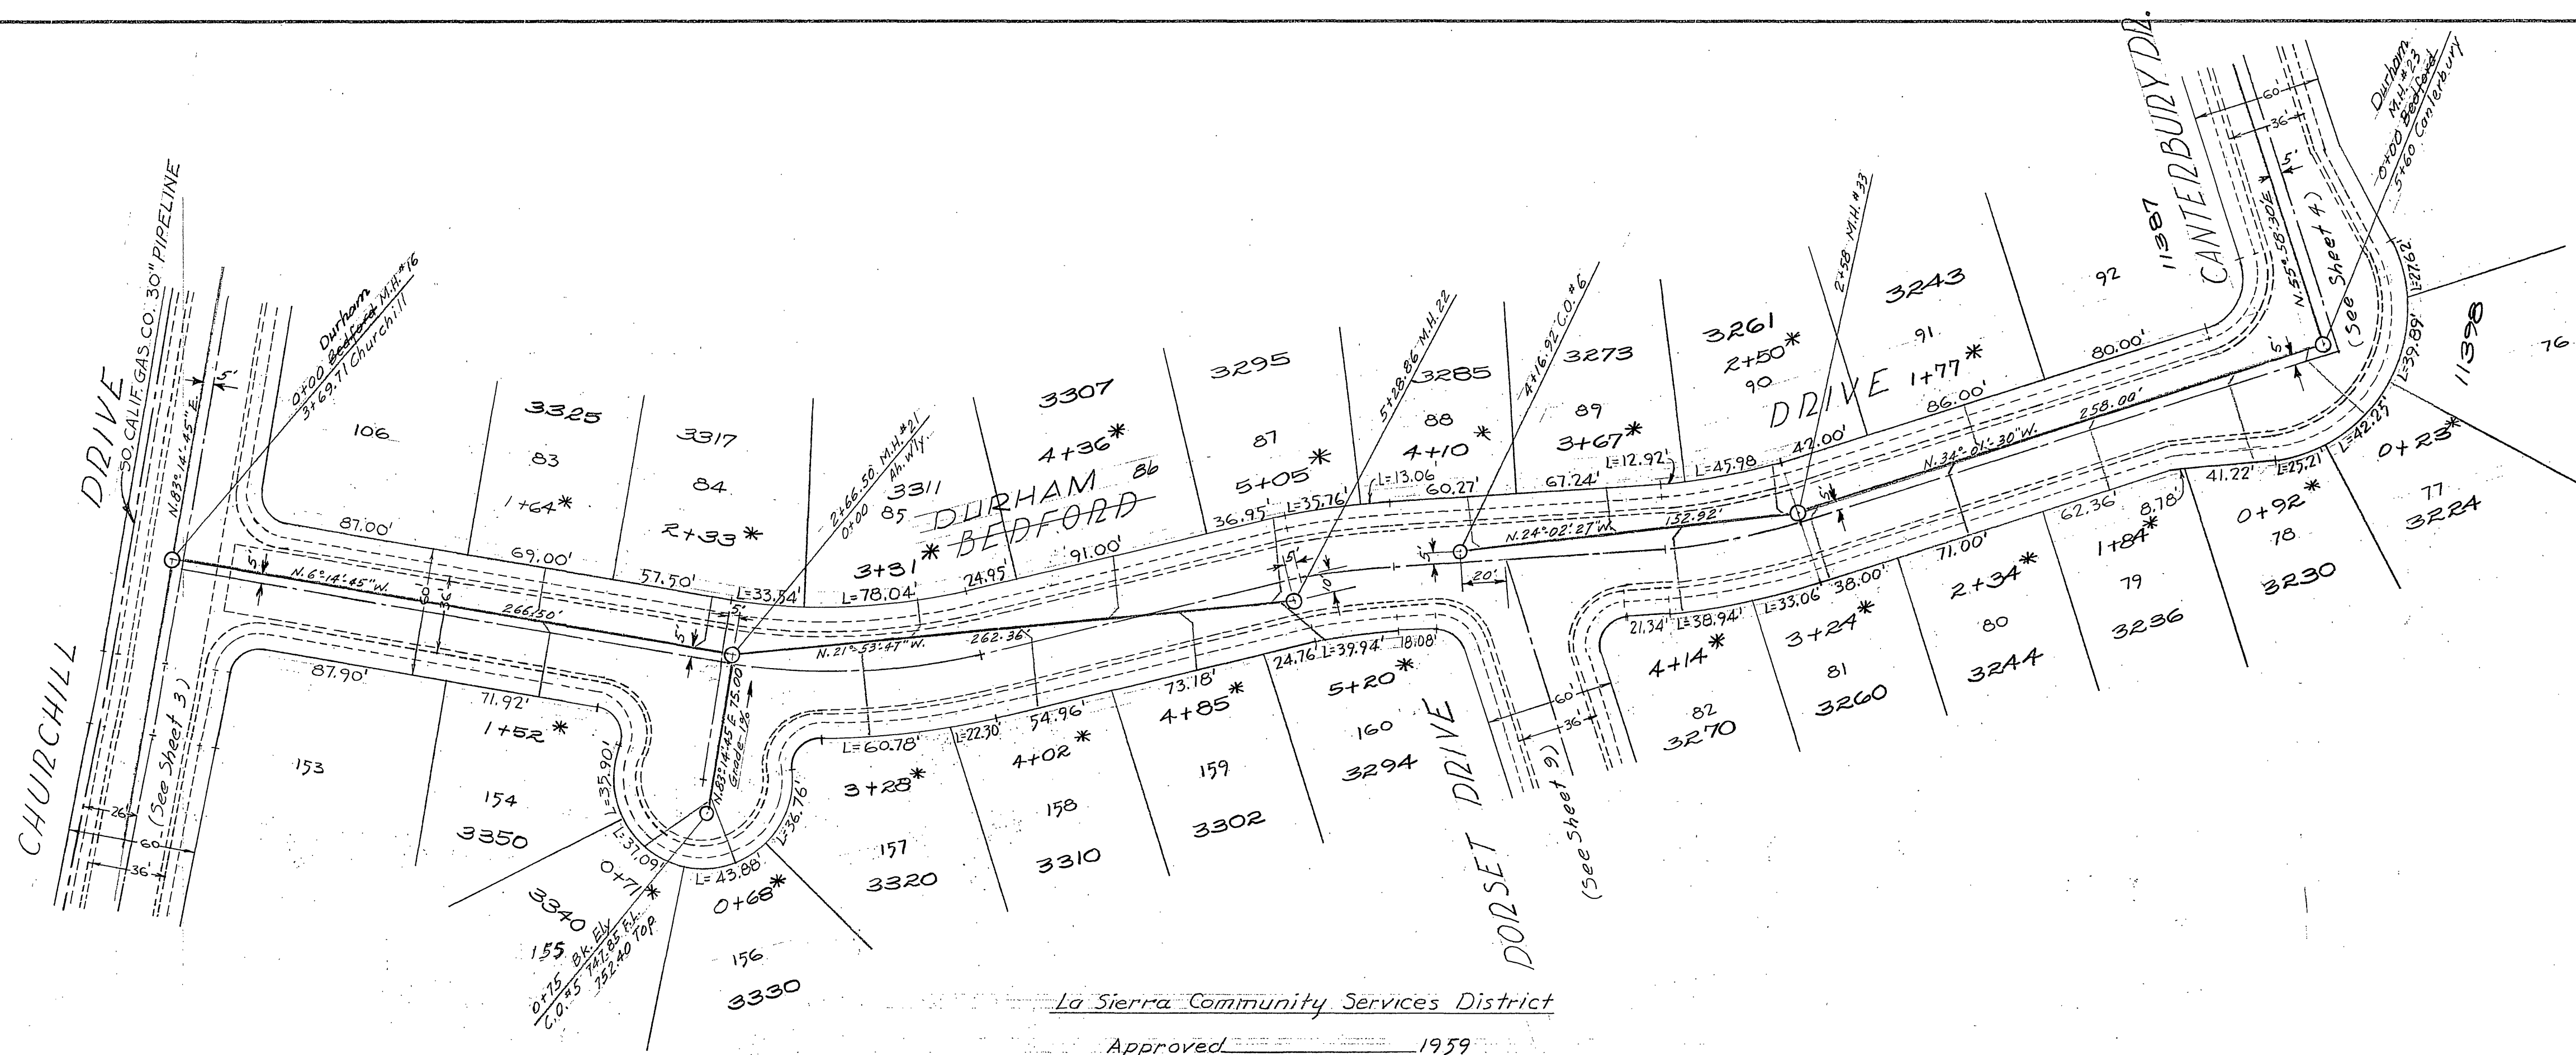

\*AS BUILT SEWER LATERAL LOCATIONS

REVISIONS	DATE	BY

TOWN AND COUNTRY ESTATES UNIT NO. 4


SEWER PLAN AND PROFILE  
 DURHAM  
 BEDFORD DRIVE

La Sierra Community Services District  
 Approved \_\_\_\_\_ 1959  
 By \_\_\_\_\_

SCALE 1"=50'	W.O. 59-186
DATE 12-59	SHEET 8
DRAWN L.G.	OF 11 SHEETS
TRACED	DWG. NO. 59-186
CHECKED	
F.B. 339	


ALBERT A. WEBB ASSOCIATES  
 CIVIL ENGINEERS  
 RIVERSIDE CALIFORNIA

PROFILE SURVEYED BY DATE  
 PLOTTED BY  
 NOTE BOOK NO.  
 DATE CHECKED BY  
 STRUCTURE NOTATIONS CHECKED

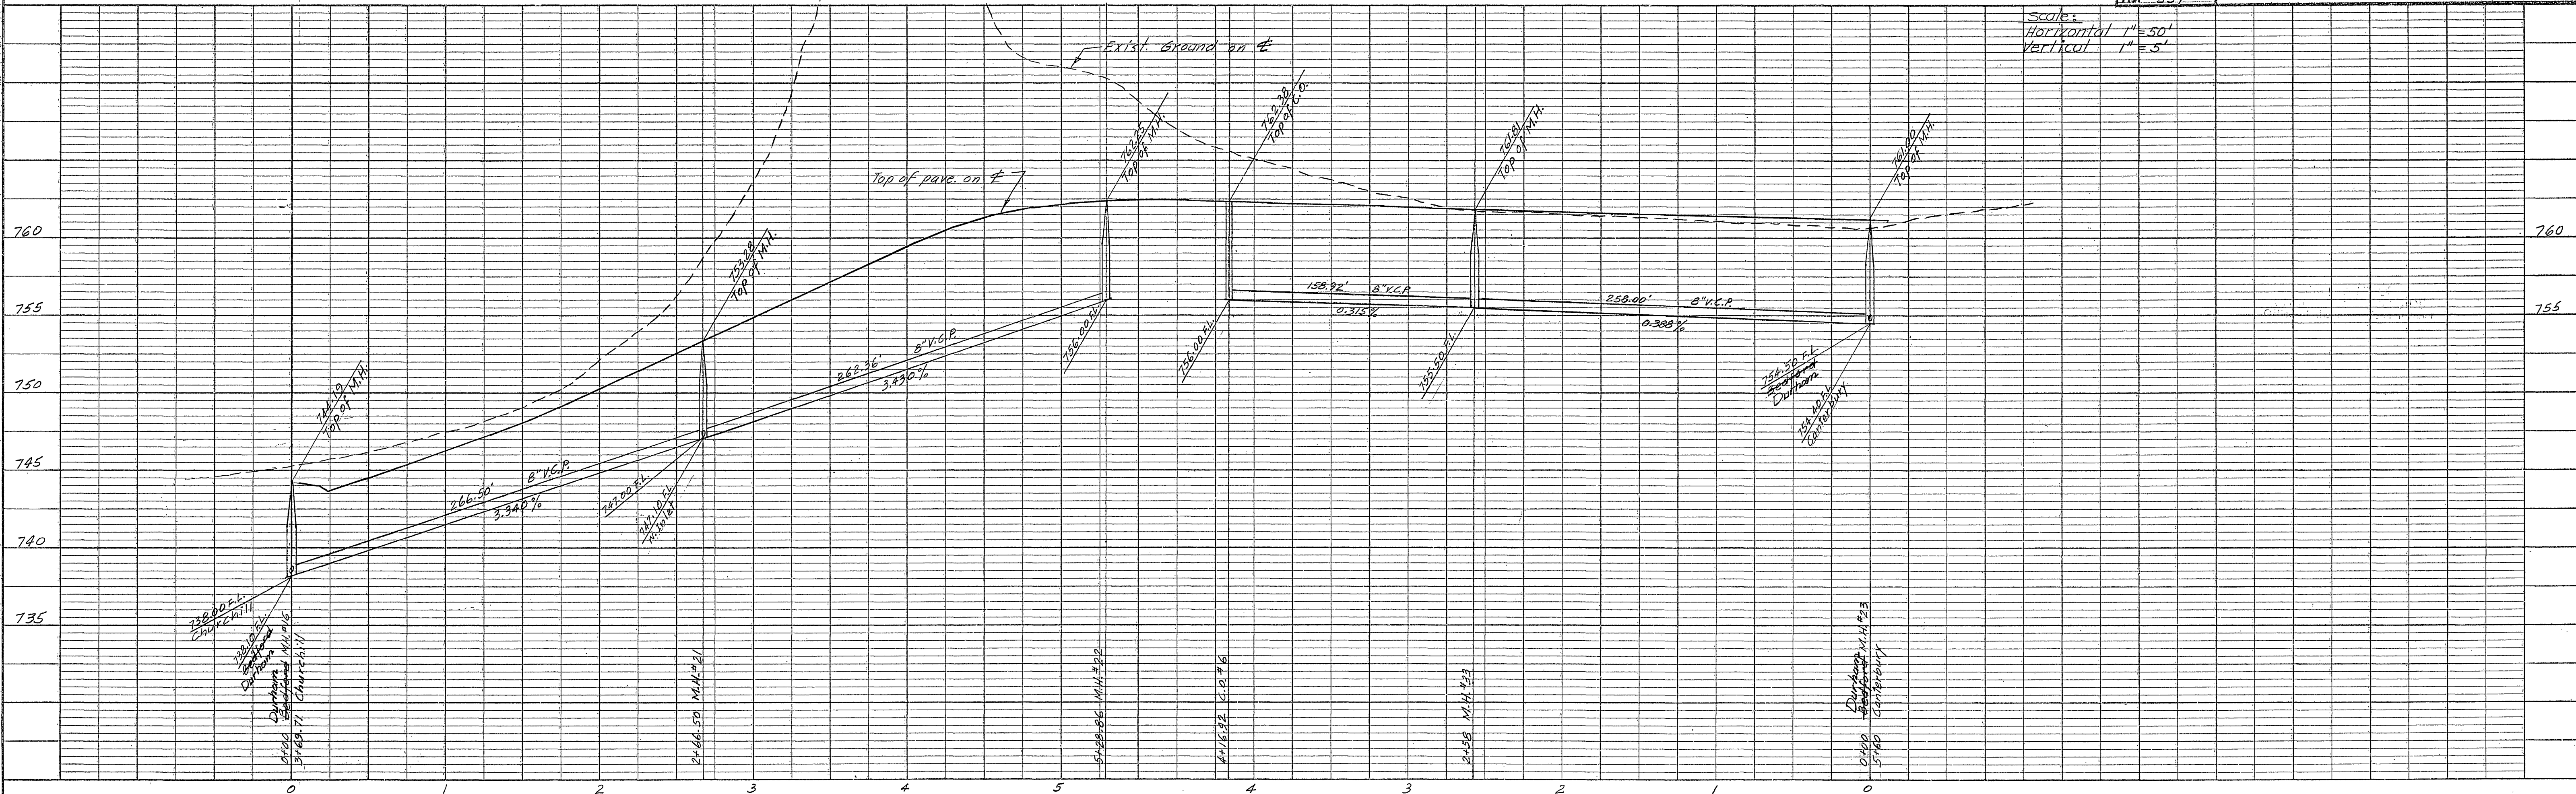




PLAN	SURVEYED	DATE
	PLOTTED	
	CHECKED	
	BY	
	NO.	

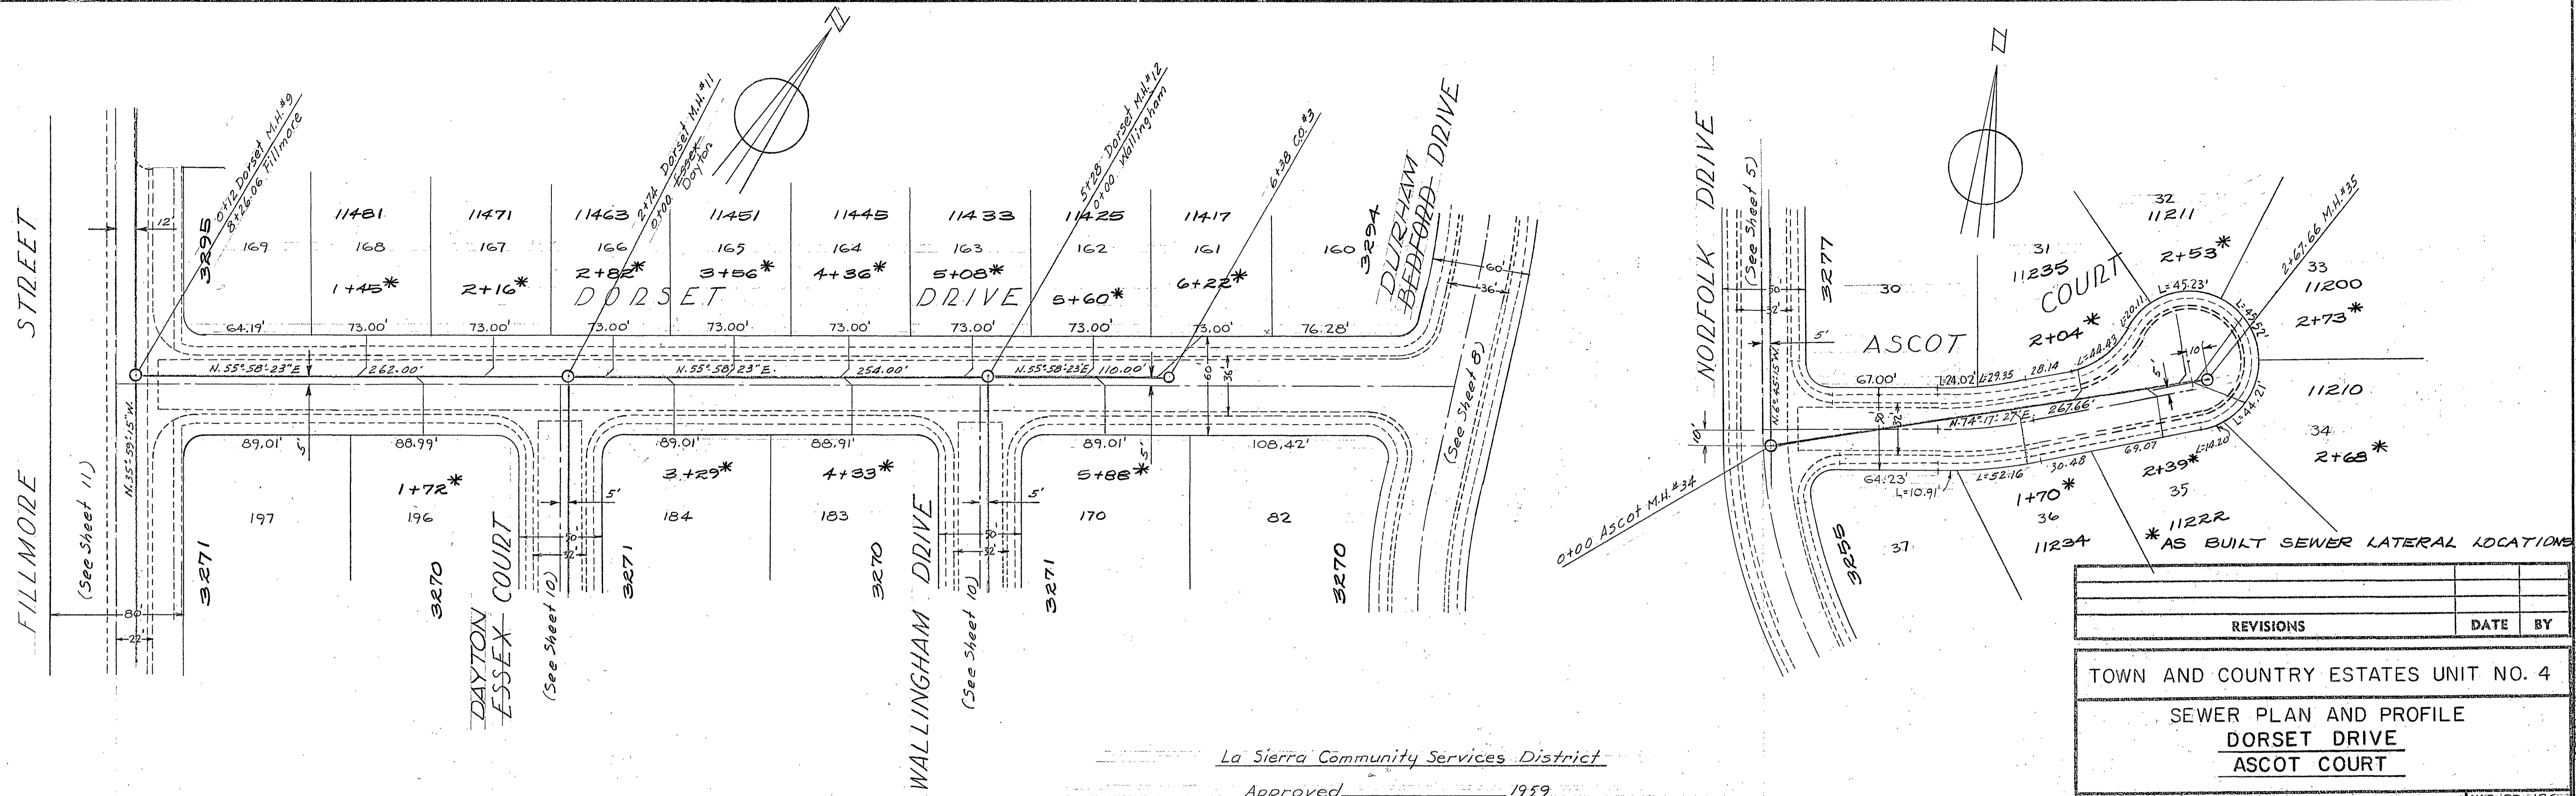

REVISIONS		DATE	BY
TOWN AND COUNTRY ESTATES UNIT NO. 4			
SEWER PLAN AND PROFILE			
DORSET DRIVE			
ASCOT COURT			
SCALE	1" = 50'	W.O. 59-186	
DATE	12-59	SHEET 9	
DRAWN	L.G.	OF 11 SHEETS	
TRACED		DWG. NO. 59-186	
CHECKED		RIVERSIDE CALIFORNIA	
F.B.	339		



La Sierra Community Services District  
 Approved \_\_\_\_\_ 1959  
 By \_\_\_\_\_

PROFILE	SURVEYED	DATE
	PLOTTED	
	CHECKED	
	BY	
	NO.	

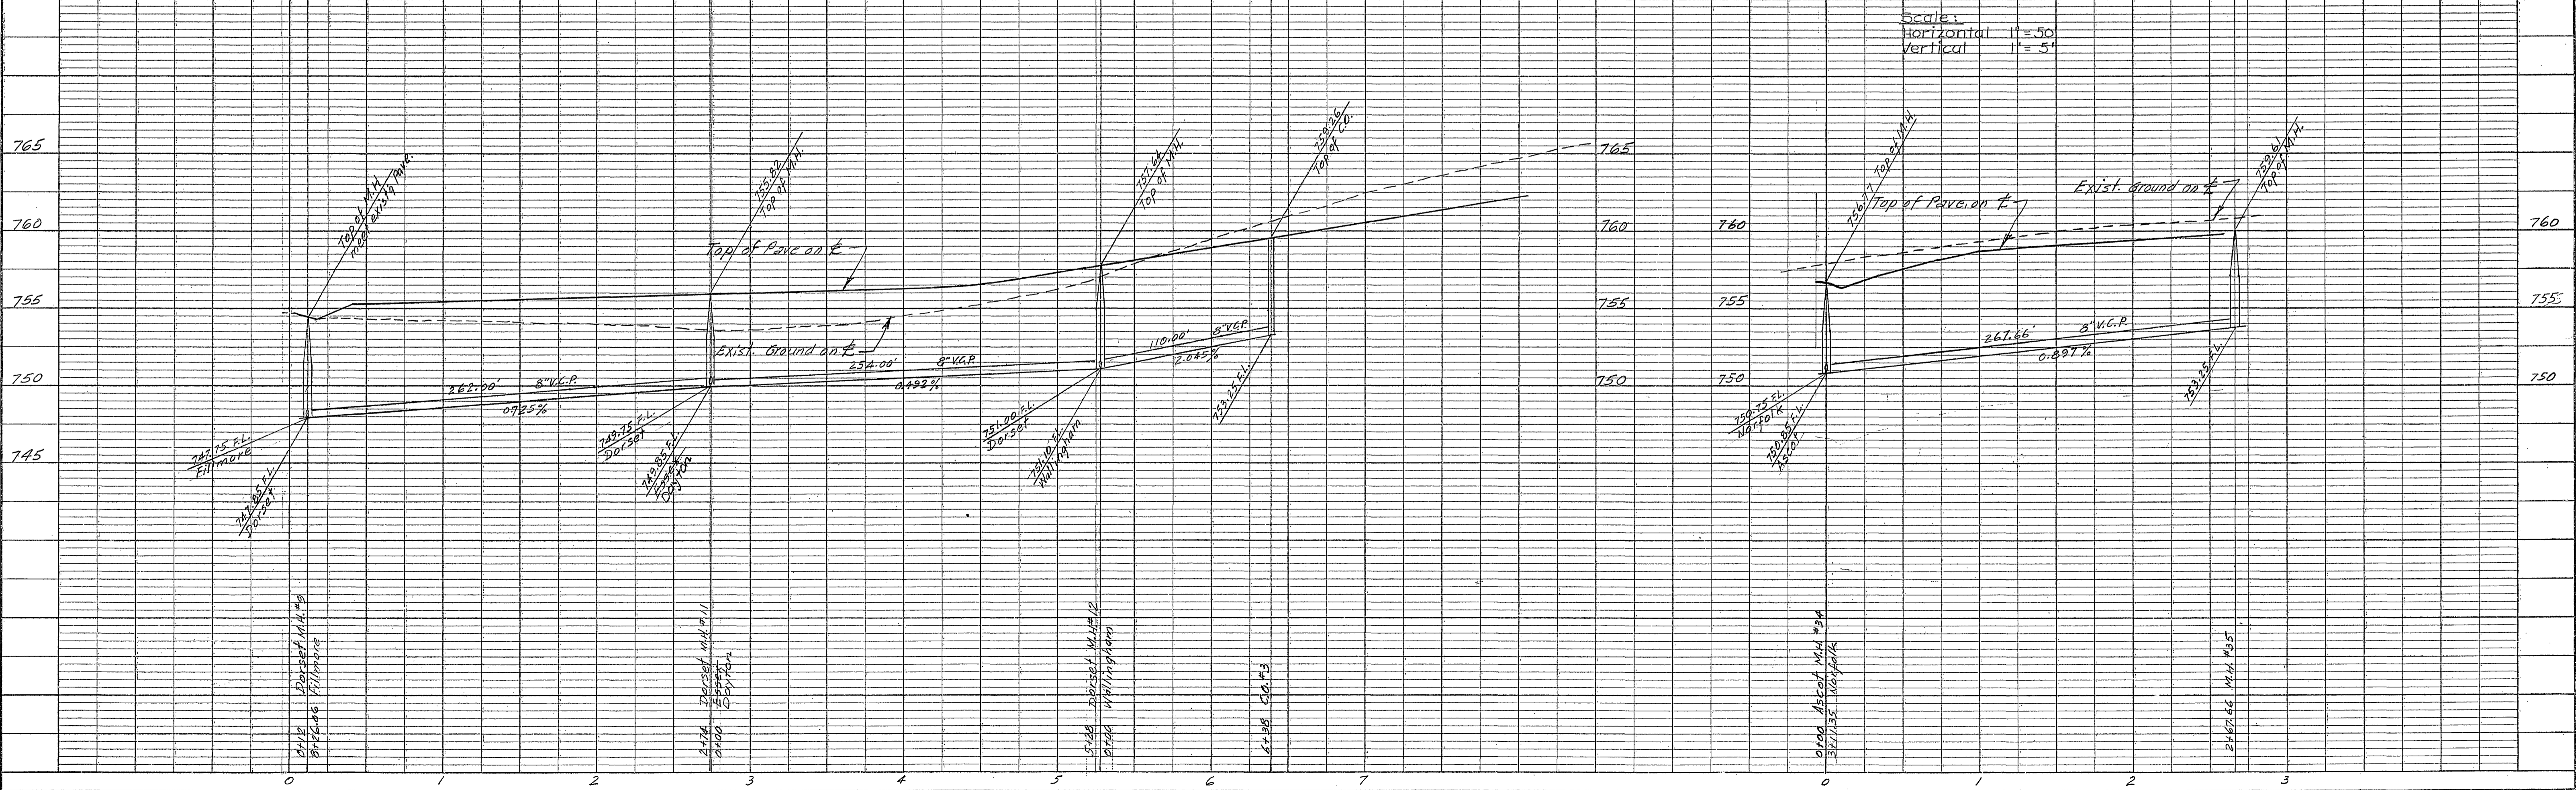

Scale:  
 Horizontal 1" = 50'  
 Vertical 1" = 5'

PLAN	SURVEYED	DATE
	ALIGNMENT CHECKED	
	RT. OF WAY CHECKED	
	NO.	

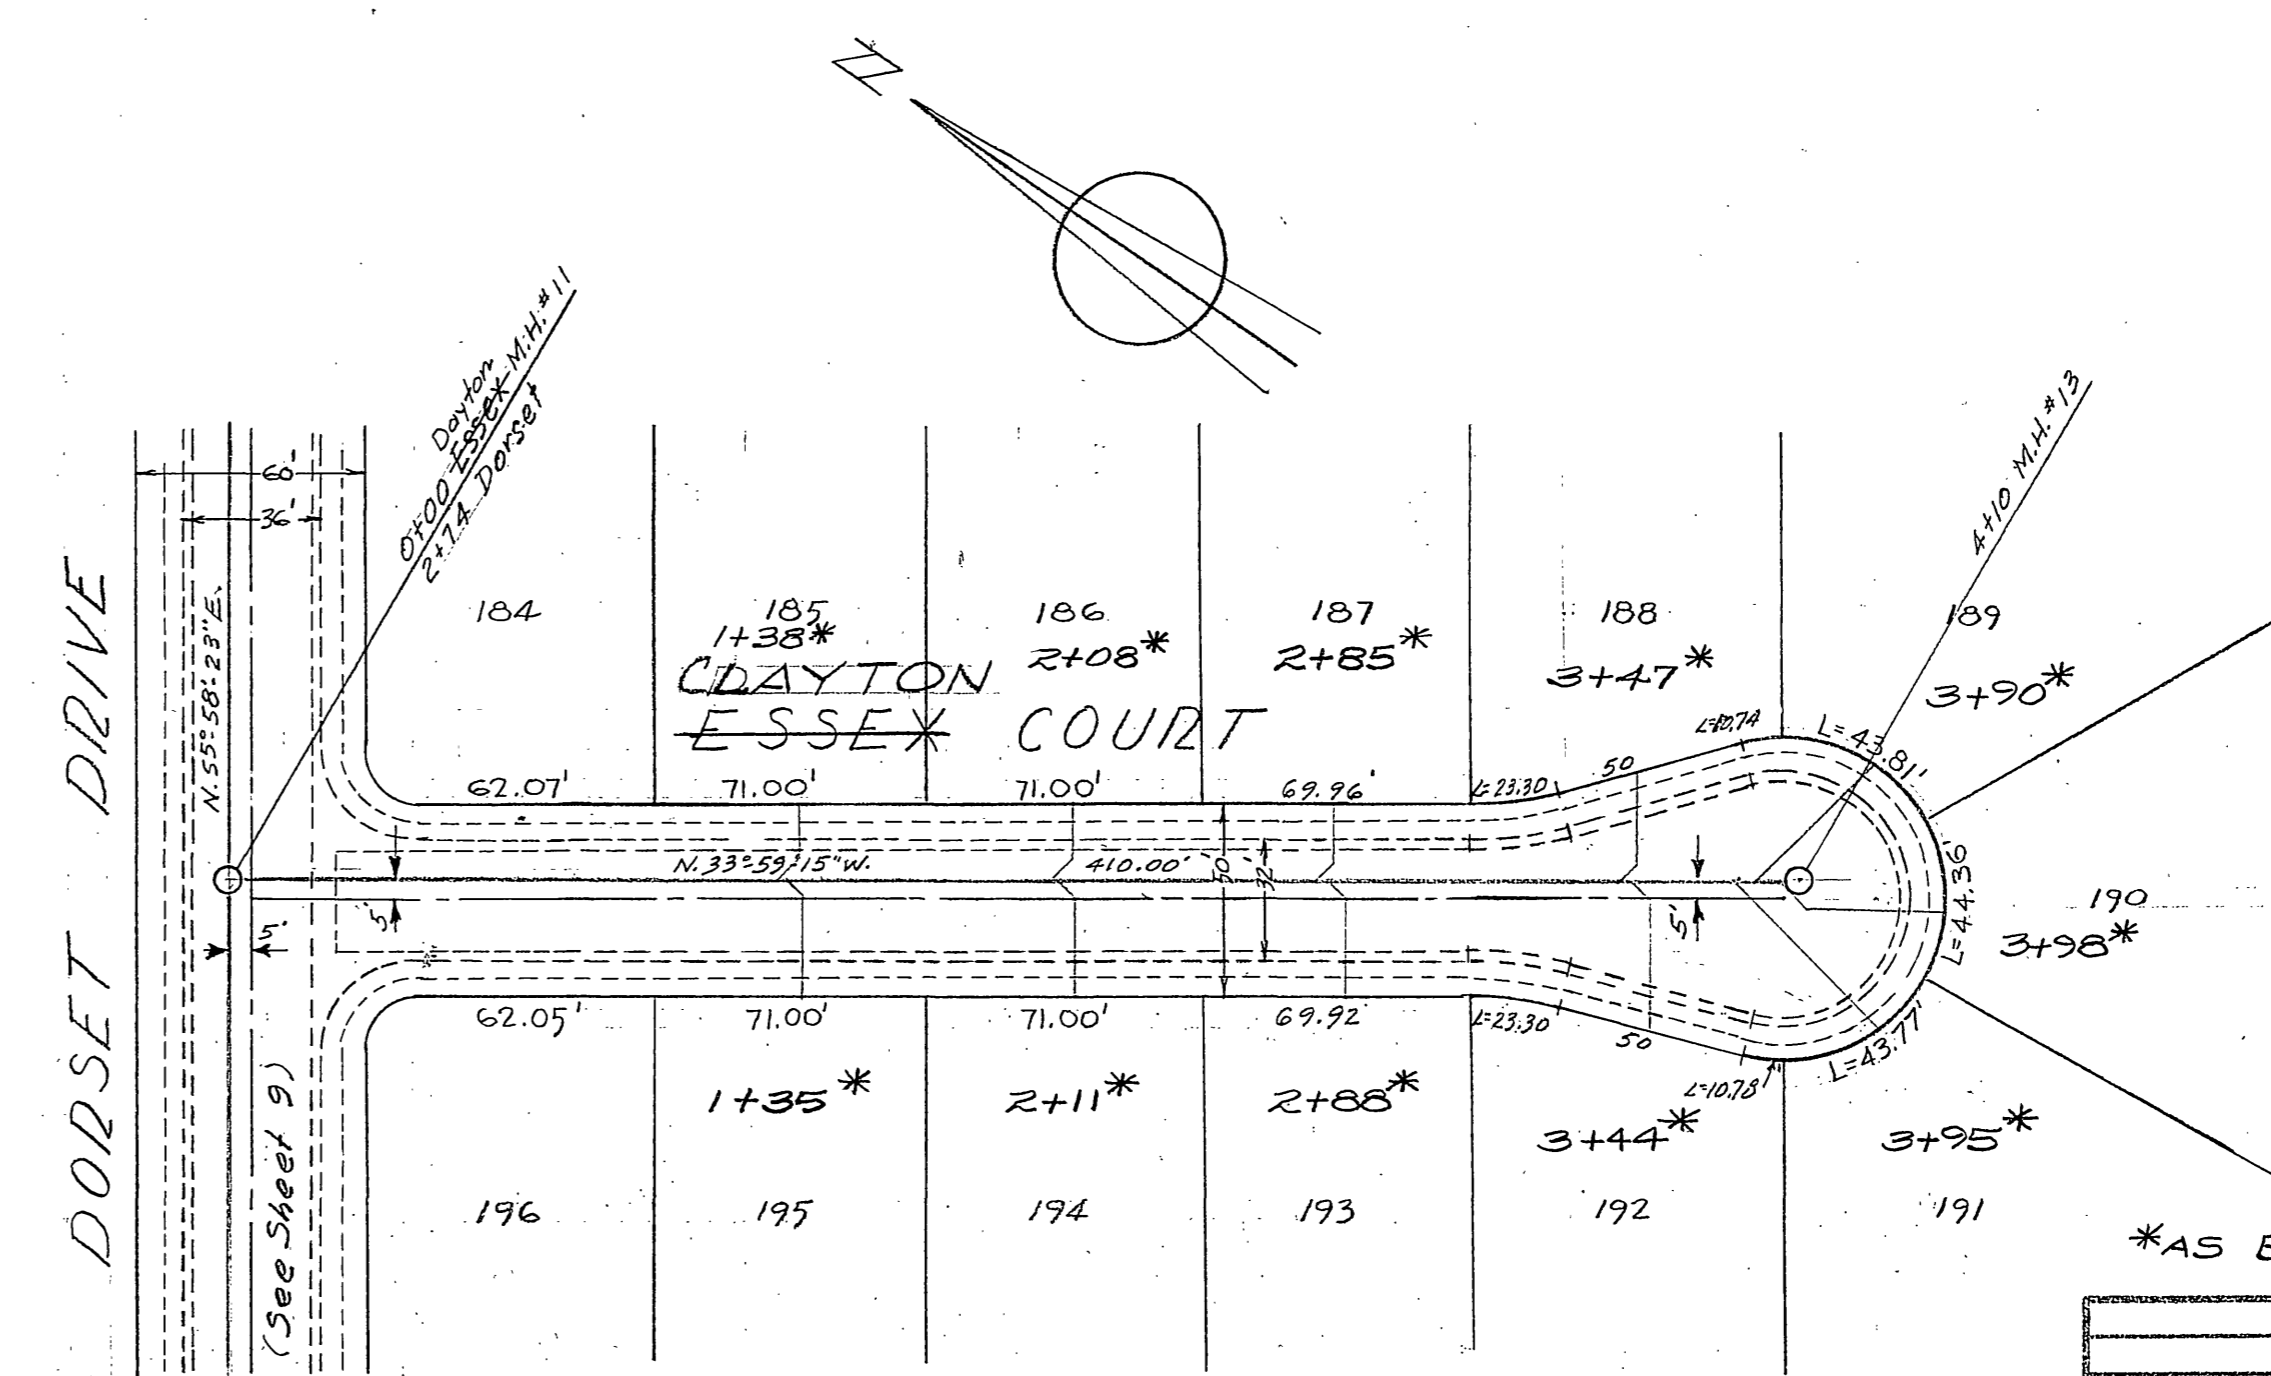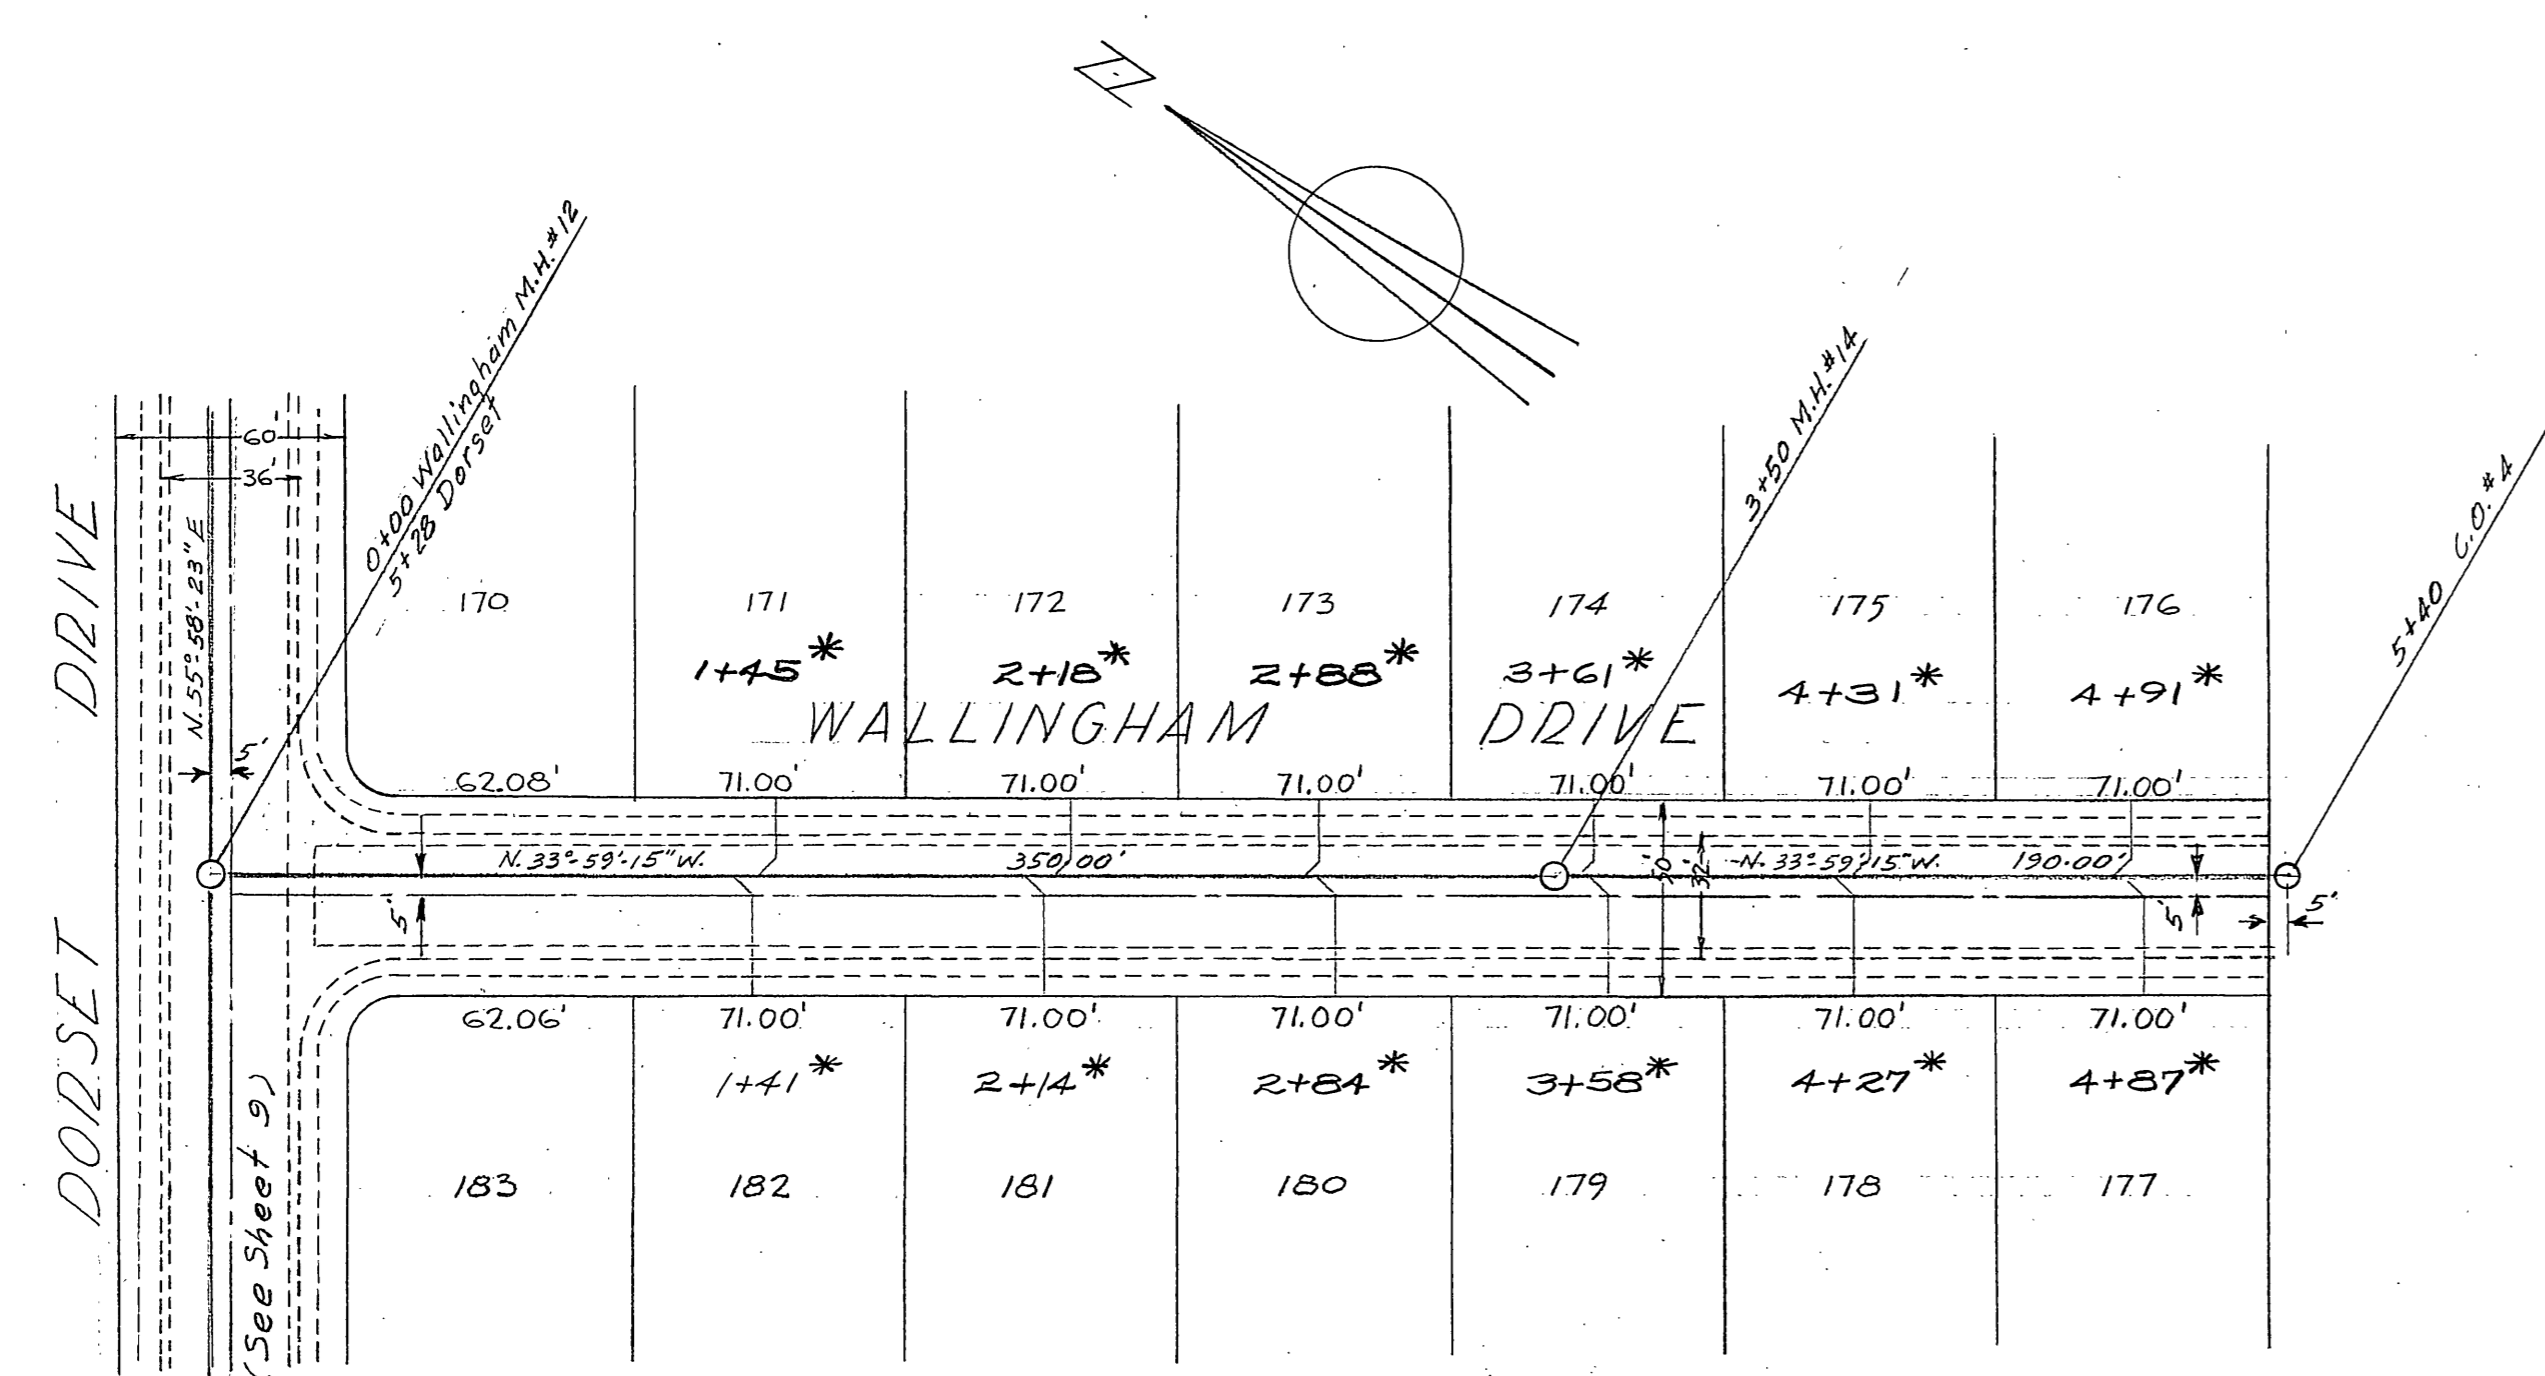

\*AS BUILT SEWER LATERAL LOCATIONS

REVISIONS	DATE	BY


TOWN AND COUNTRY ESTATES UNIT NO. 4

SEWER PLAN AND PROFILE  
WALLINGHAM DRIVE  
CLAYTON ESSEX COURT


SCALE 1"=50'	ALBERT A. WEBB ASSOCIATES CIVIL ENGINEERS RIVERSIDE CALIFORNIA	W.O. 59-186
DATE 12-59		SHEET 10
DRAWN L.G.		OF 11 SHEETS
CHECKED		DWG. NO. 59-186
E.B. 339		

La Sierra Community Services District  
Approved \_\_\_\_\_ 1959  
By \_\_\_\_\_

PROFILE	SURVEYED	DATE
	GRADES CHECKED	
	B. M.S. NOTED	
	STRUCTURE NOTATION CHECKED	
	NO.	

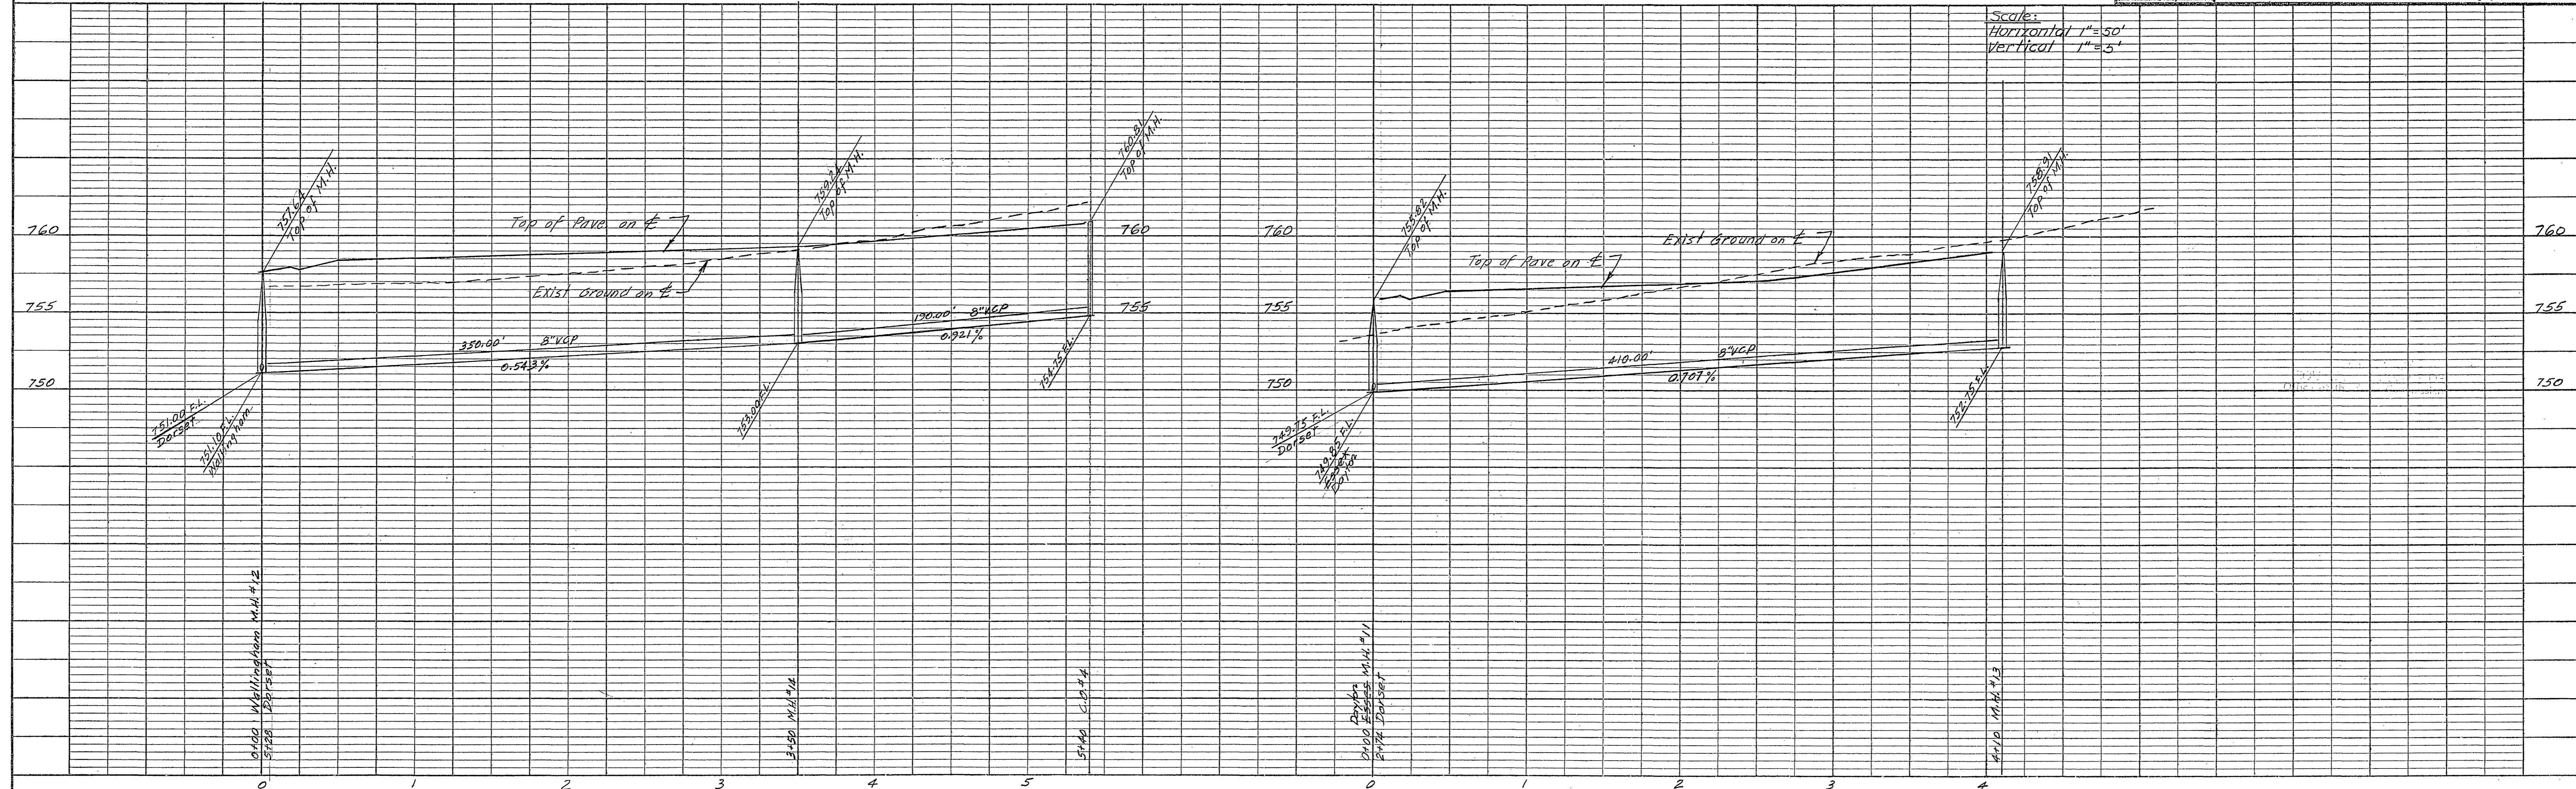

PLAN	SURVEYED	DATE
	PLOTTED	BY
	CHECKED	
	RT. OF WAY CHECKED	
	NO.	

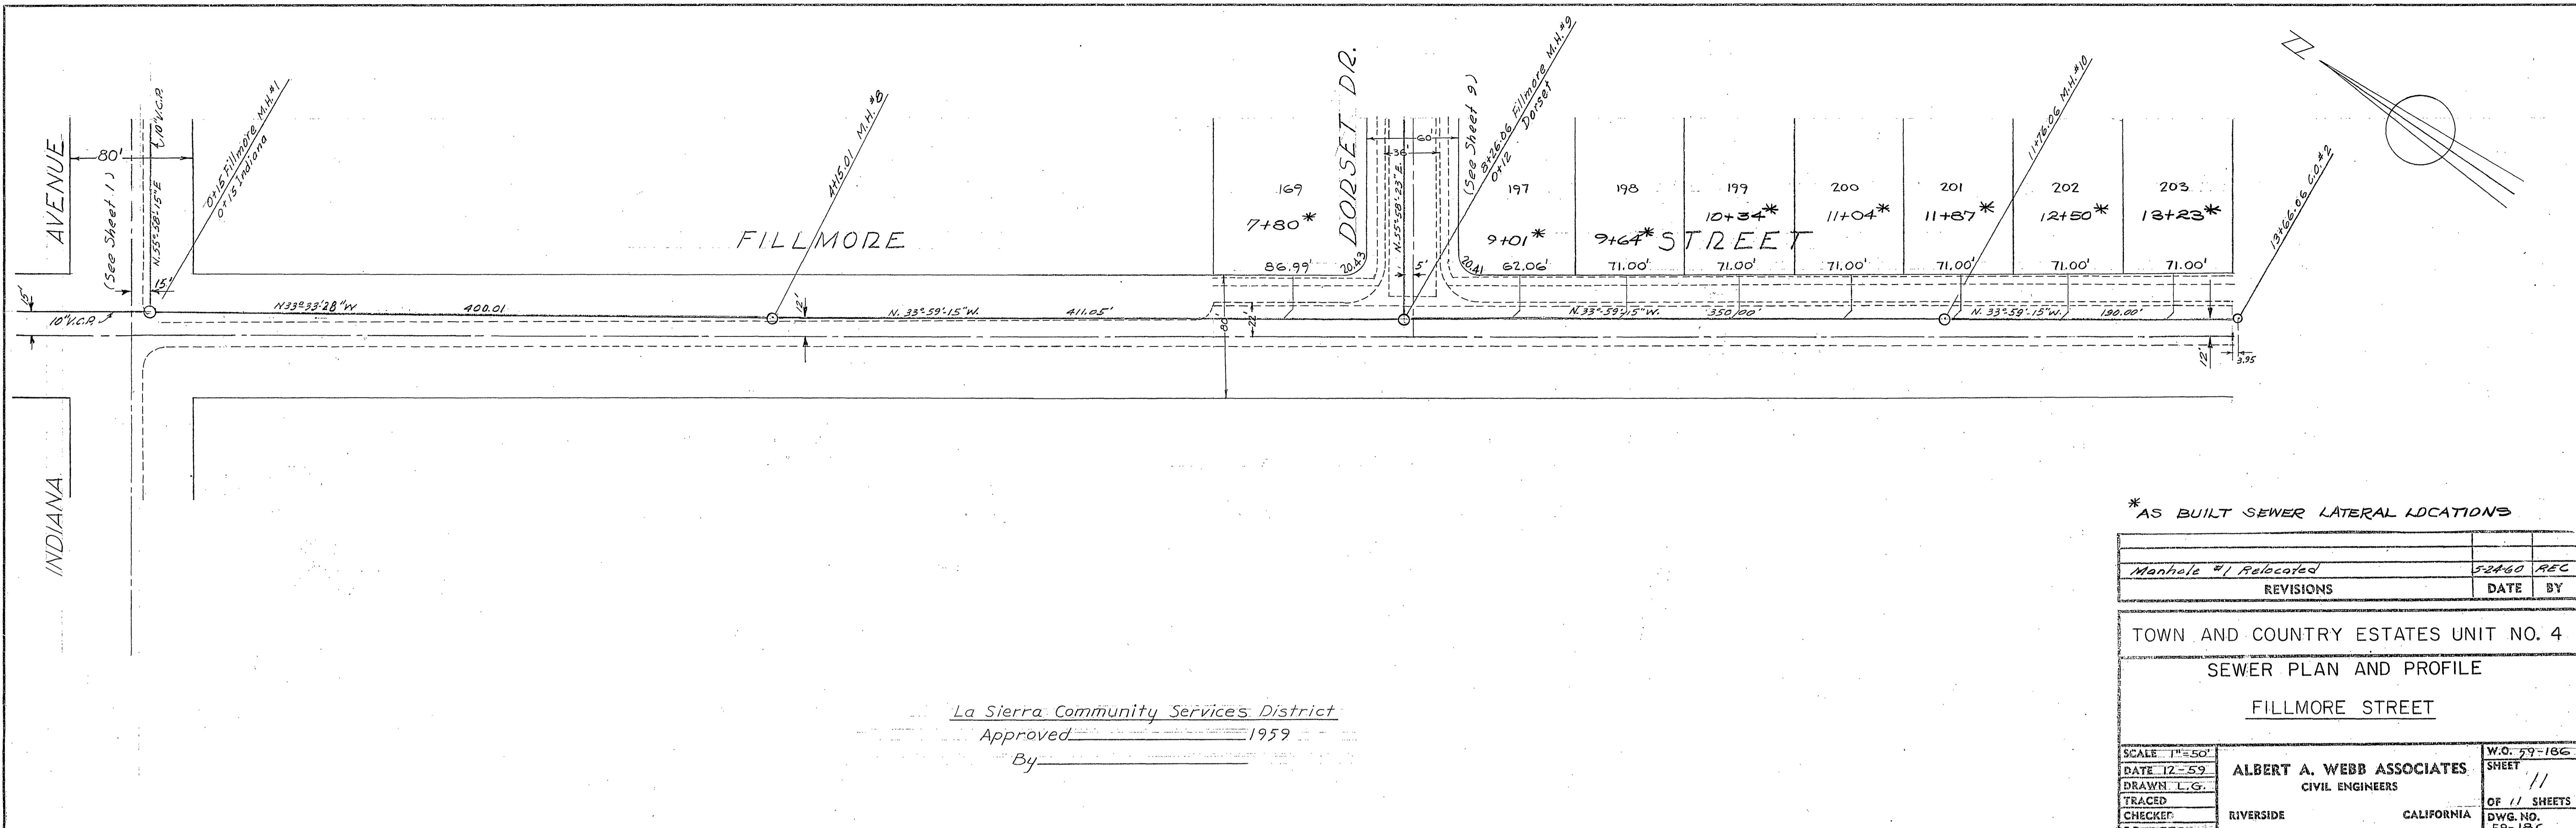

La Sierra Community Services District  
 Approved \_\_\_\_\_ 1959  
 By \_\_\_\_\_

\* AS BUILT SEWER LATERAL LOCATIONS

Manhole #1 Relocated	5-24-60	REC
REVISIONS	DATE	BY

TOWN AND COUNTRY ESTATES UNIT NO. 4  
 SEWER PLAN AND PROFILE  
 FILLMORE STREET

SCALE 1"=50'	W.O. 59-186
DATE 12-59	SHEET
DRAWN L.G.	11
TRACED	OF 11 SHEETS
CHECKED	DWG. NO.
F.B. 339	59-186

ALBERT A. WEBB ASSOCIATES  
 CIVIL ENGINEERS  
 RIVERSIDE CALIFORNIA

PROFILE	SURVEYED	DATE
	PLOTTED	BY
	CHECKED	
	STRUCTURE NOTATIONS CHECKED	
	NO.	

