


RECEIVED
 APR 28 1968
 DEPT. OF
 PUBLIC WORKS

PLAN	SURVEYED	DATE
	PLOTTED	BY
	ALIGNED	
	CHECKED	
	BY	
	NO.	


PROFILE	SURVEYED	DATE
	PLOTTED	BY
	CHECKED	
	BY	
	NO.	

Final Footage Measured by Manager for District
 + C.T. Johnson - 2-15-61 + Entered on Drawing with This Color Ink

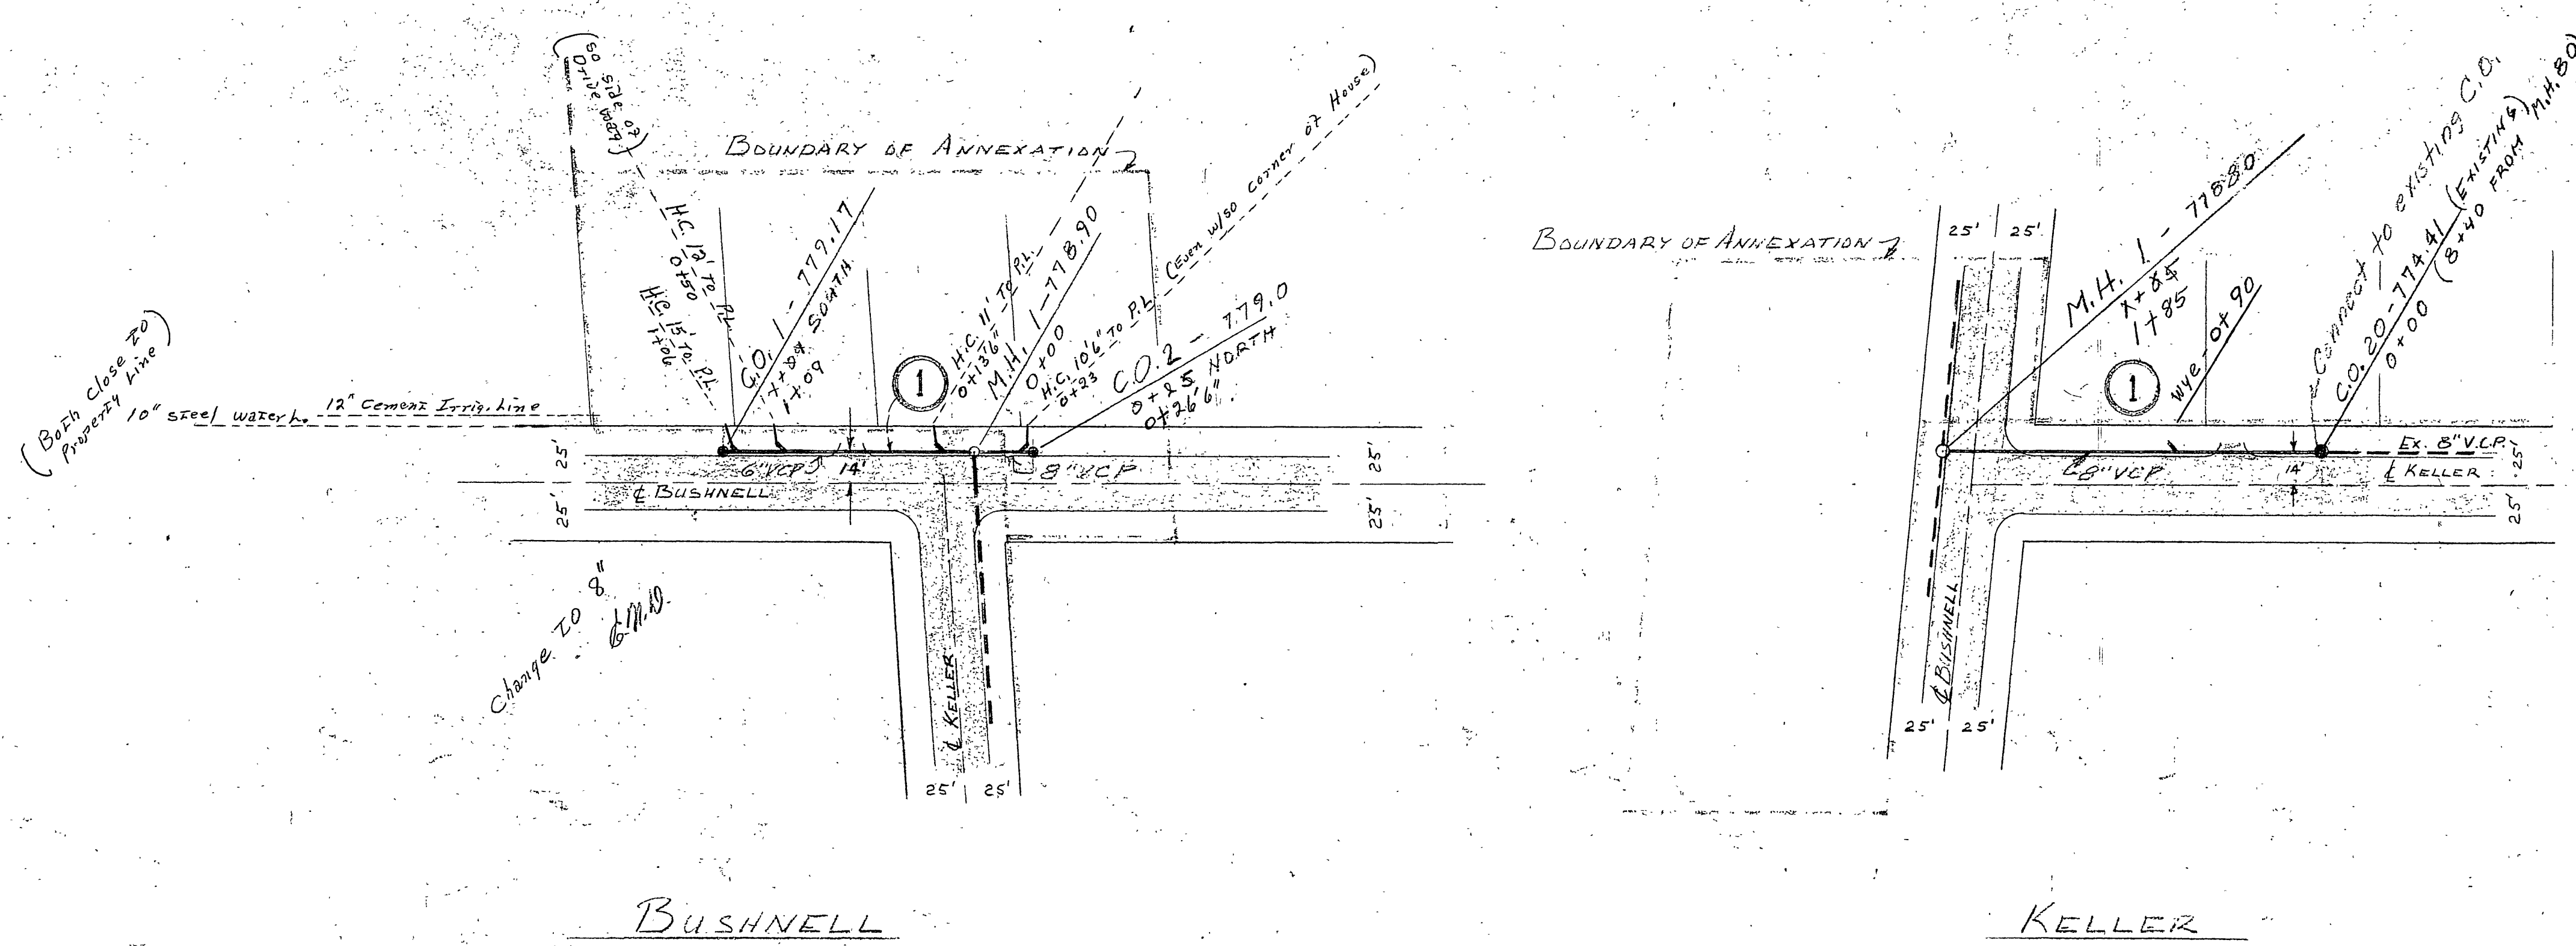

PLAN SCALE: 1"=50'

Approved by The Board
 of Directors for L.C.S.D.
 9-20-66
 Corby M. Sanderson, Mgr.

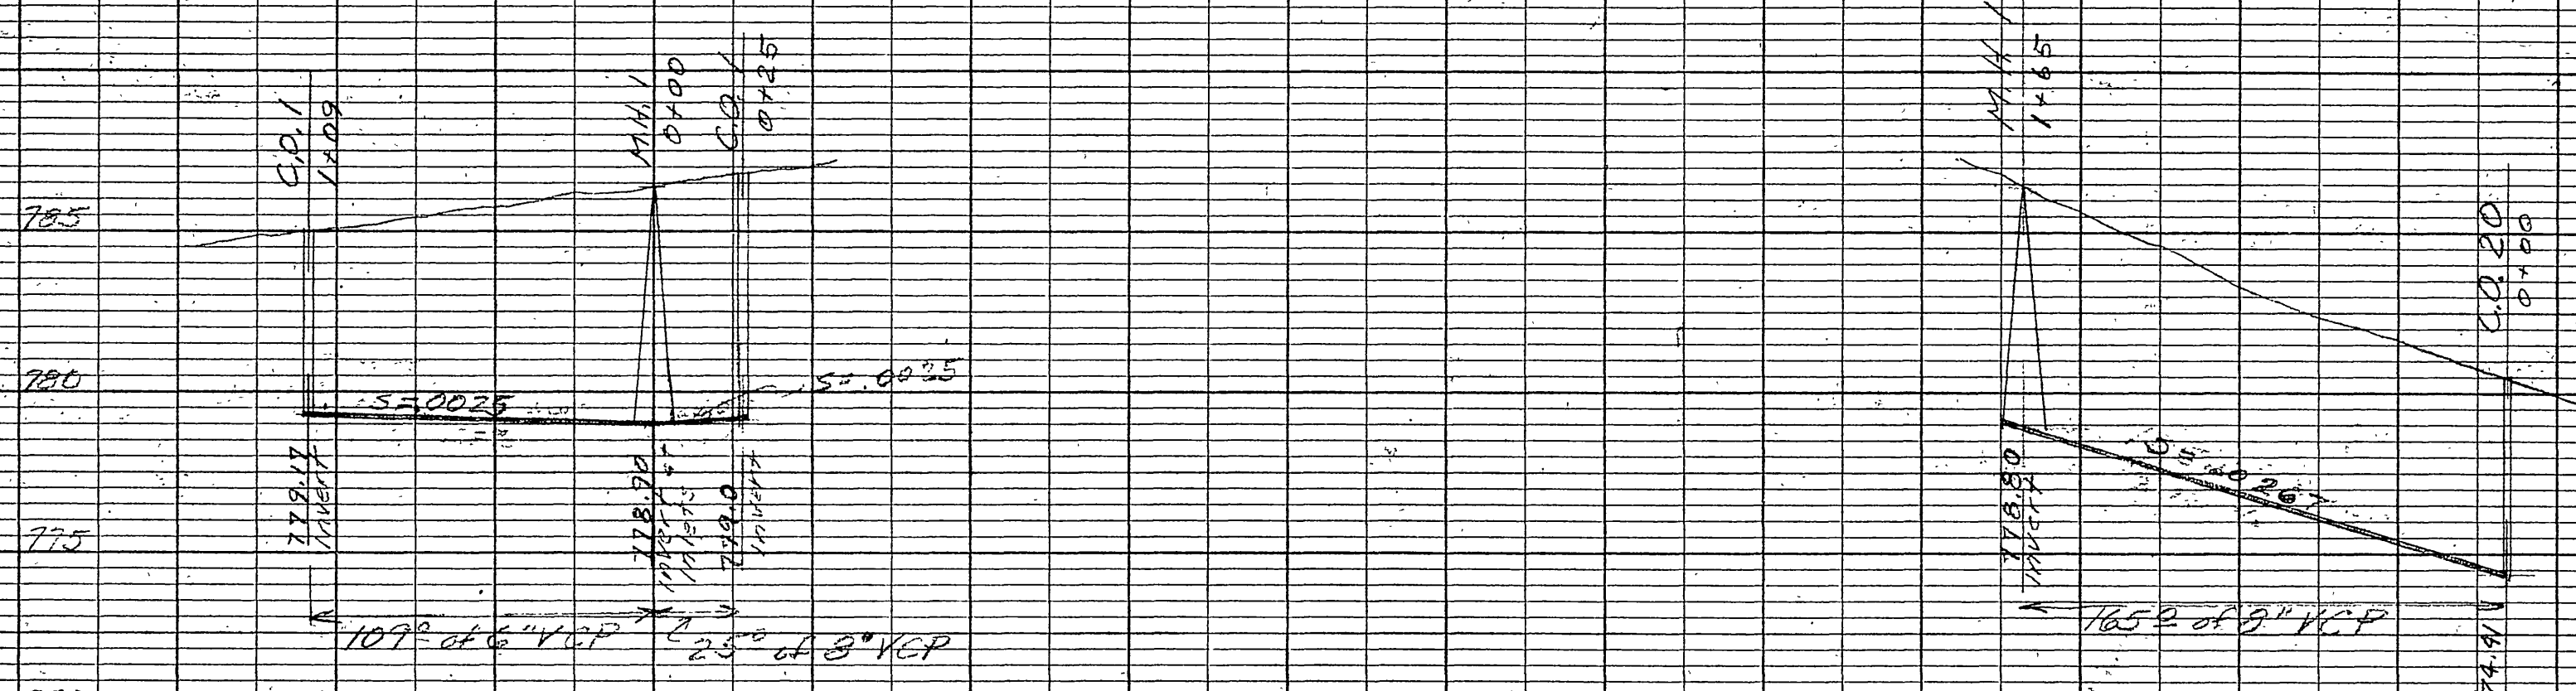

PROFILE SCALES
 HORIZONTAL 1"=50'
 VERTICAL 1"=5'

NOTE:
 Vitrified Clay Pipe to meet
 specification ASTM C18-44T
 Standard Strength Clay Sewer
 Pipe
 Manhole shall conform to
 Standard No. 344 and
 Blanked shall conform to
 Standard No. 31 both of
 "Subdivision Improvement
 Standards", May 23, 1959
 County of Riverside

1. CONSTRUCT 18" V.C.P. SEWER, STD. MANHOLE, STD. CATCHBASINS, 4" V.C.P. HOUSE CONNECTIONS, & V.P.S.

SANITARY SEWERS	
ANNEXATION NUMBER 28	
LA SIERRA COMMUNITY SERVICE DISTRICT	
DATE: AUG 1960	APPROVED: [Signature]
DRAWN: W.K.I.	CHECKED: [Signature]
CH'D: A.R.	DATE: 08 1960