


PLAN  
 SURVEYED \_\_\_\_\_ DATE \_\_\_\_\_  
 PLOTTED \_\_\_\_\_ BY \_\_\_\_\_  
 NOTE BOOK GRADES CHECKED \_\_\_\_\_  
 NO. \_\_\_\_\_ ALIGNMENT CHECKED \_\_\_\_\_  
 \_\_\_\_\_ RT. OF WAY CHECKED \_\_\_\_\_

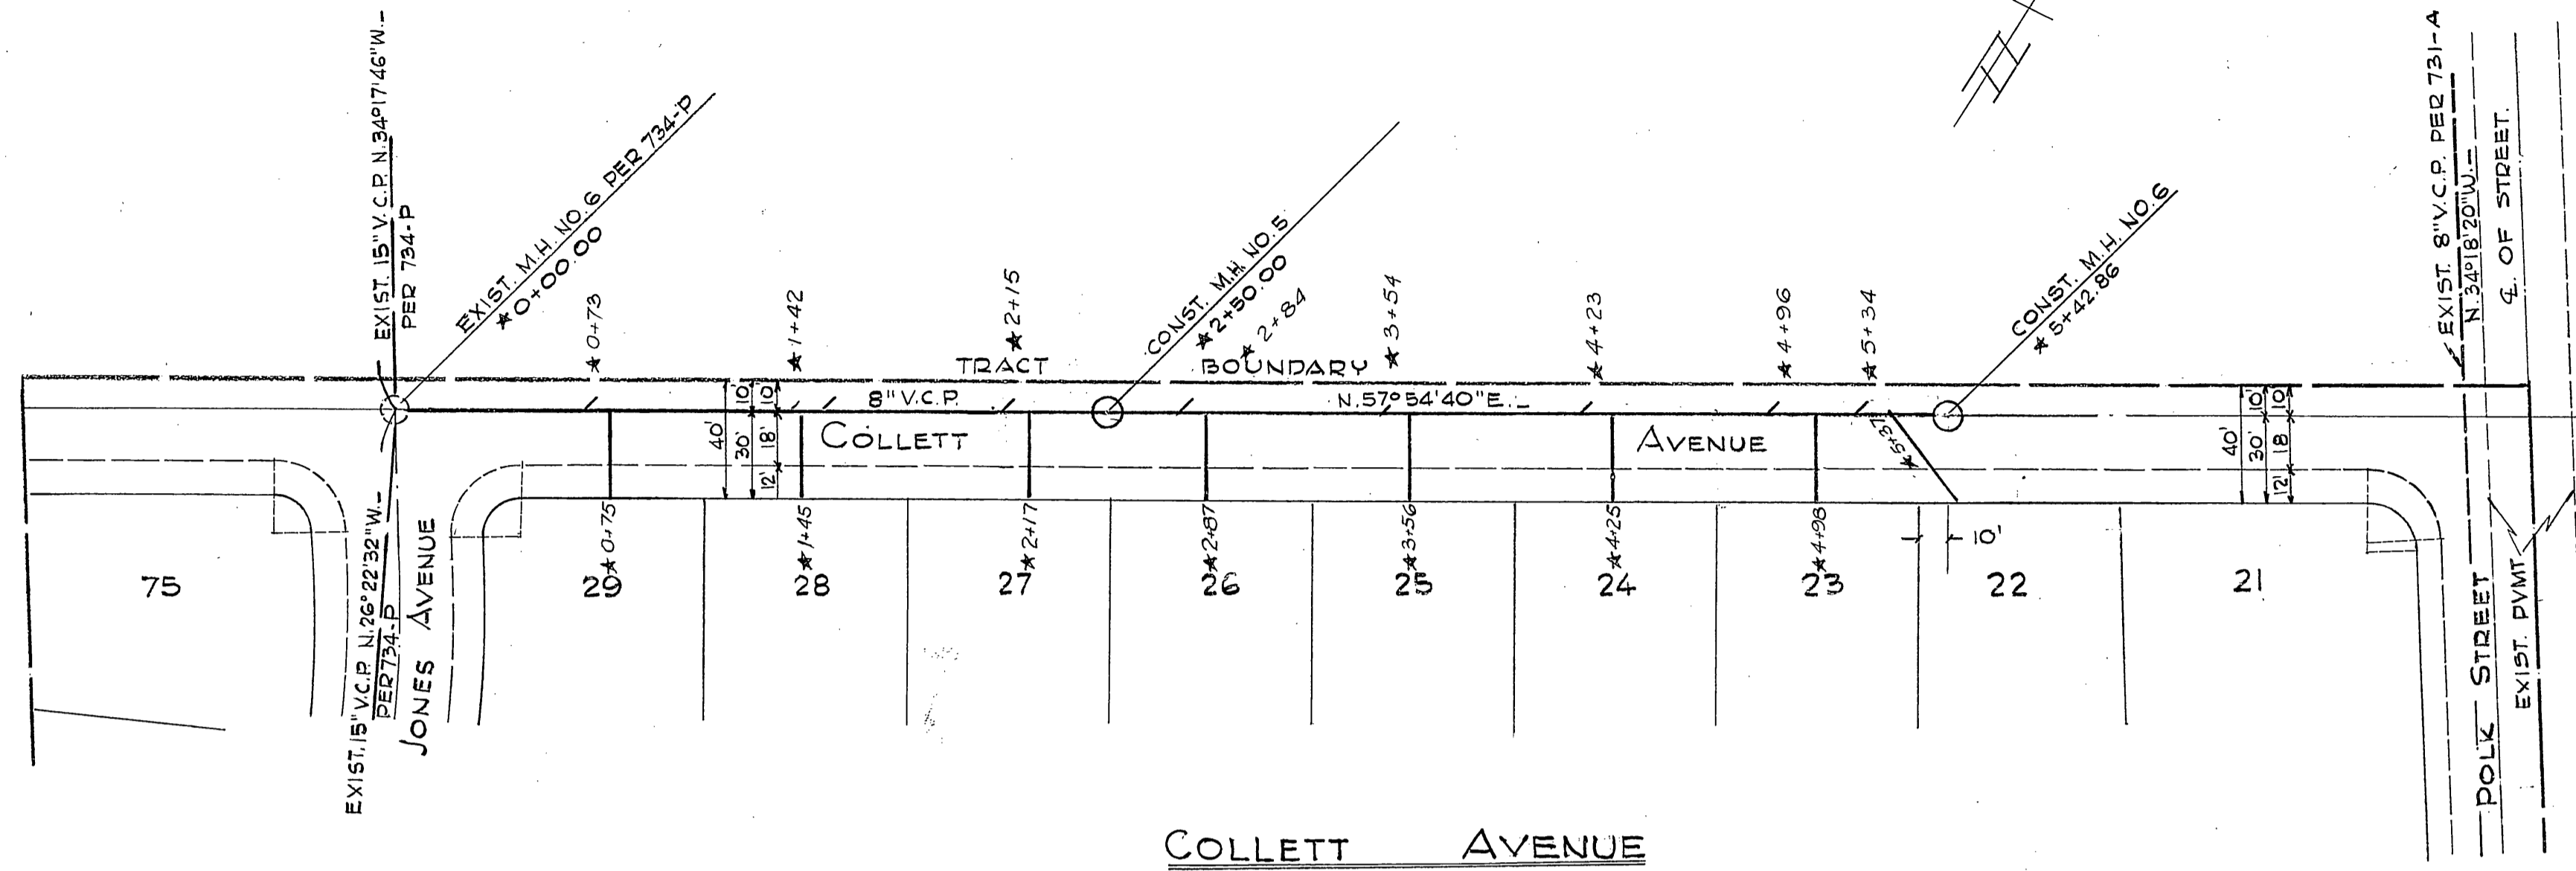

COLLETT AVENUE

PLAN  
 SCALE  
 1" = 50'

QUANTITY ESTIMATE

MANHOLES - 4 EA.  
 JUNCTION CHAMBERS - 2 EA.  
 8" V.C.P. SEWER - 1677.28 LIN. FT.  
 4" V.C.P. SEWER - 2160.00 LIN. FT.

"Approval of these plans by the Department of Public Health of Riverside County does not relieve the Engineer or architect of the responsibility for the Engineering or Architectural design."

RIVERSIDE COUNTY HEALTH DEPARTMENT


- FOOD ESTABLISHMENT
- TRAILER PARK
- MOTEL, APT., HOTEL
- DWELLING
- COMMERCIAL BUILDING
- WATER SOURCE
- WATER LINE LAYOUT
- SEWAGE DISPOSAL
- GAL. SEPTIC TANK
- SQ. FT. OF LEACH LINE
- SEEPAGE PIT
- CONNECTION TO SEWER
- SEWER LINE LAYOUT
- SWIMMING POOL

This is to Certify that the Riverside County Health Department Approves for Occupancy, Construction or Installation the Items Checked Above.

Date 9-3-59 By *[Signature]*

GENERAL NOTES -

1. USE STANDARD M.H. NO. 29
2. USE 4" V.C.P. FOR HOUSE CONNECTIONS

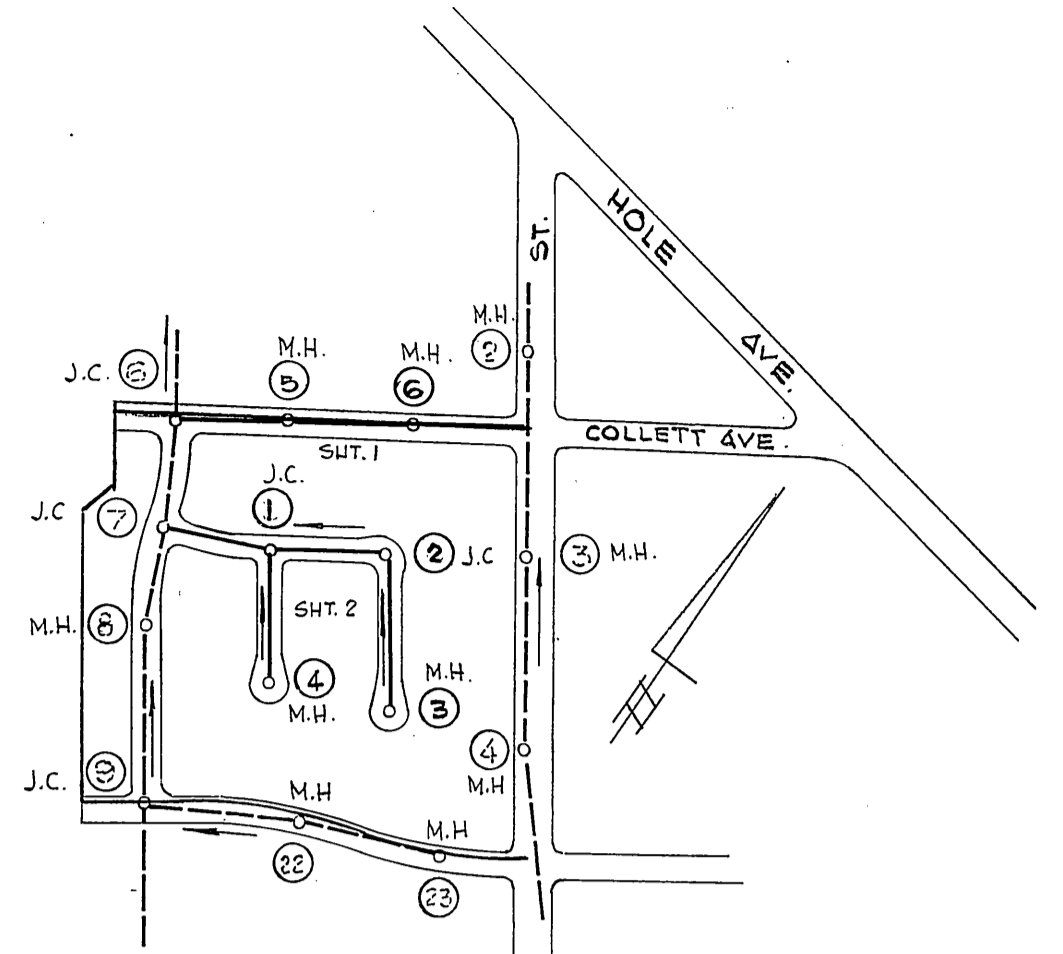


KEY MAP  
 1" = 400'

LEGEND

- ⑥ M.H. NOT INCLUDED ON THIS PLANS
- ③ M.H. INCLUDED ON THIS PLANS

PROFILE  
 SURVEYED \_\_\_\_\_ DATE \_\_\_\_\_  
 PLOTTED \_\_\_\_\_ BY \_\_\_\_\_  
 NOTE BOOK GRADES CHECKED \_\_\_\_\_  
 NO. \_\_\_\_\_ STRUCTURE NOTATIONS CHECKED \_\_\_\_\_

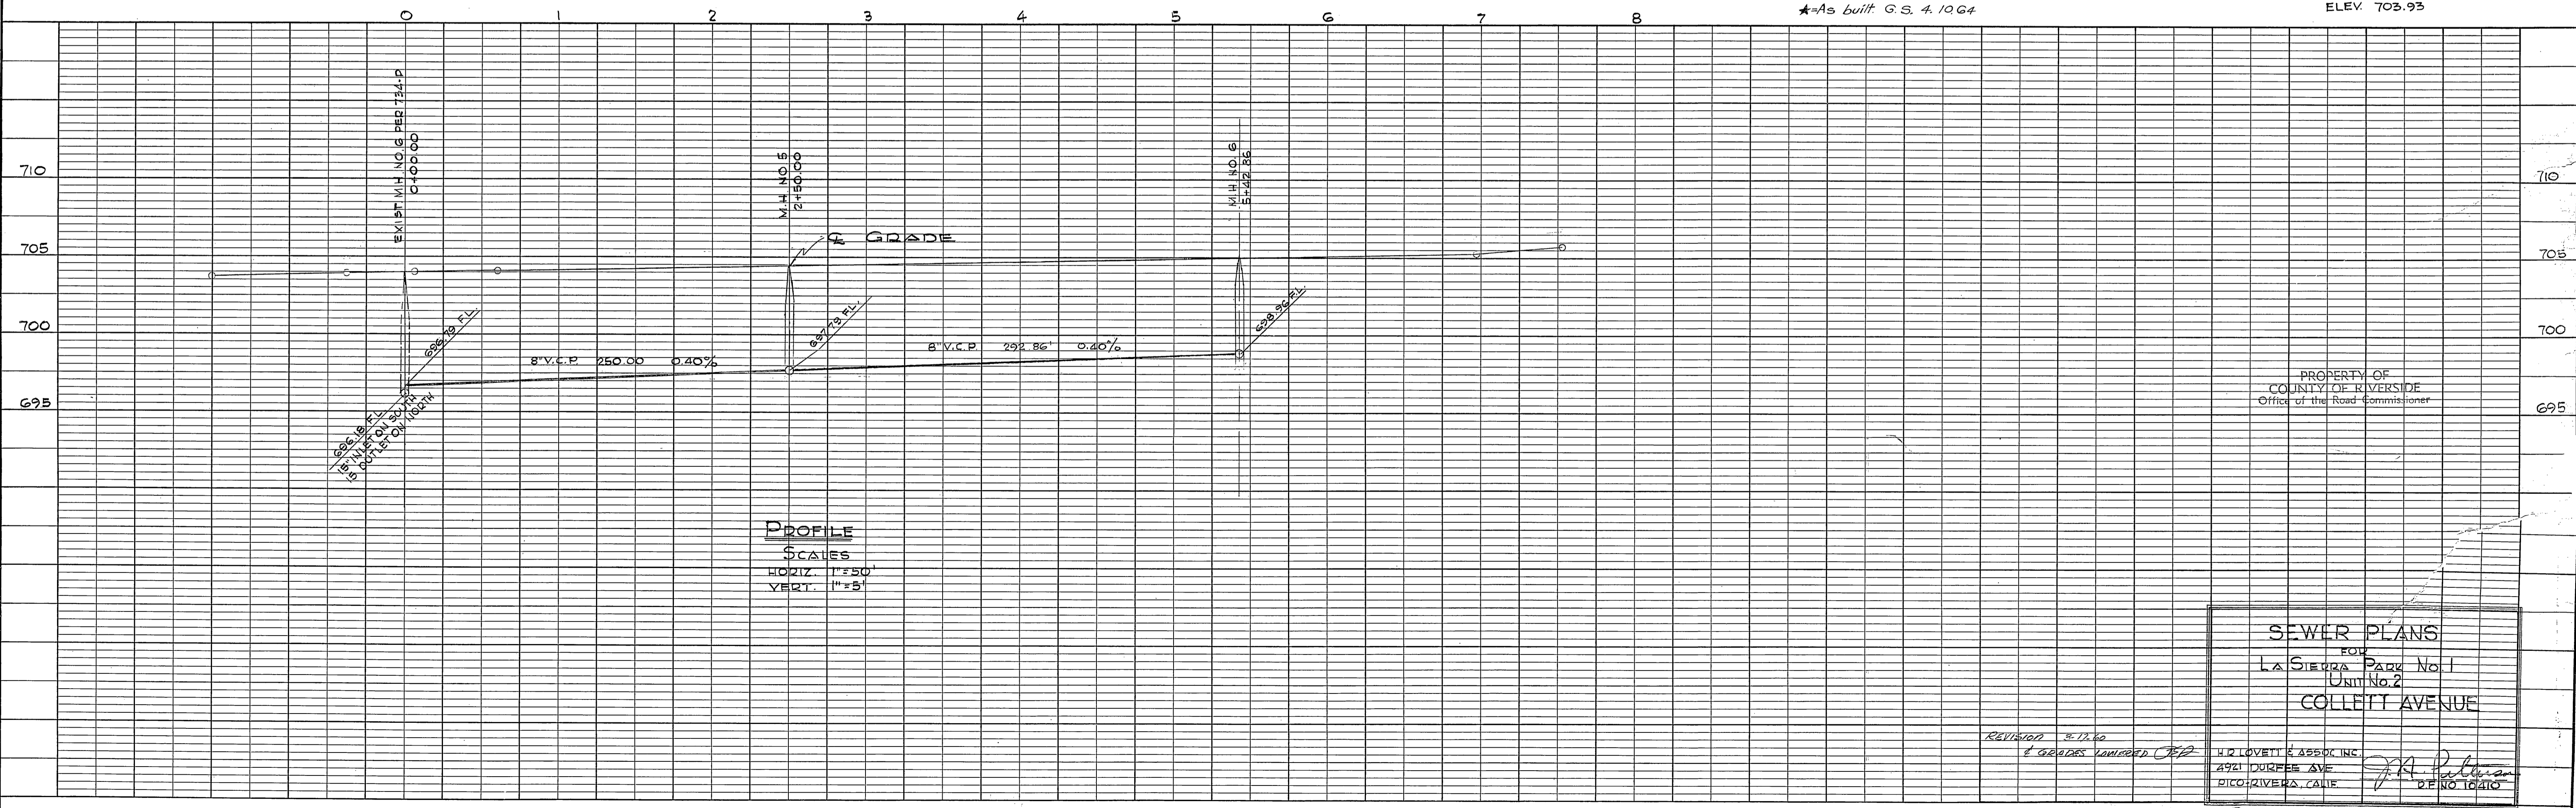

PROFILE  
 SCALES  
 HORIZ. 1" = 50'  
 VERT. 1" = 5'

\*As built G.S. 4, 1964

BENCH MARK -  
 RIVERSIDE COUNTY 13.M. NO. 7  
 CHISELED "X" ON STEP OF CHURCH  
 N.W. CORNER HOLE AVE. & JONES AVE.  
 ELEV. 703.93

PROPERTY OF  
 COUNTY OF RIVERSIDE  
 Office of the Road Commissioner

SEWER PLANS  
 FOR  
 LA SIERRA PARK No. 1  
 UNIT No. 2  
 COLLETT AVENUE

REVISION 8-12-60  
 & GRADES UNLAPPED OFF


H. LOVETT & ASSOC. INC.  
 4921 DURESS AVE.  
 RIVERSIDE, CALIF.

*[Signature]*  
 ENGINEER

SHEET 1 OF 2 SHEETS

PLAN	SURVEYED	DATE
	PLOTTED	BY
	ALIGNMENT CHECKED	
	RT. OF WAY CHECKED	
	NO.	

PROFILE	SURVEYED	DATE
	PLOTTED	BY
	GRADES CHECKED	
	STRUCTURE NOTATION CHECKED	
	NO.	

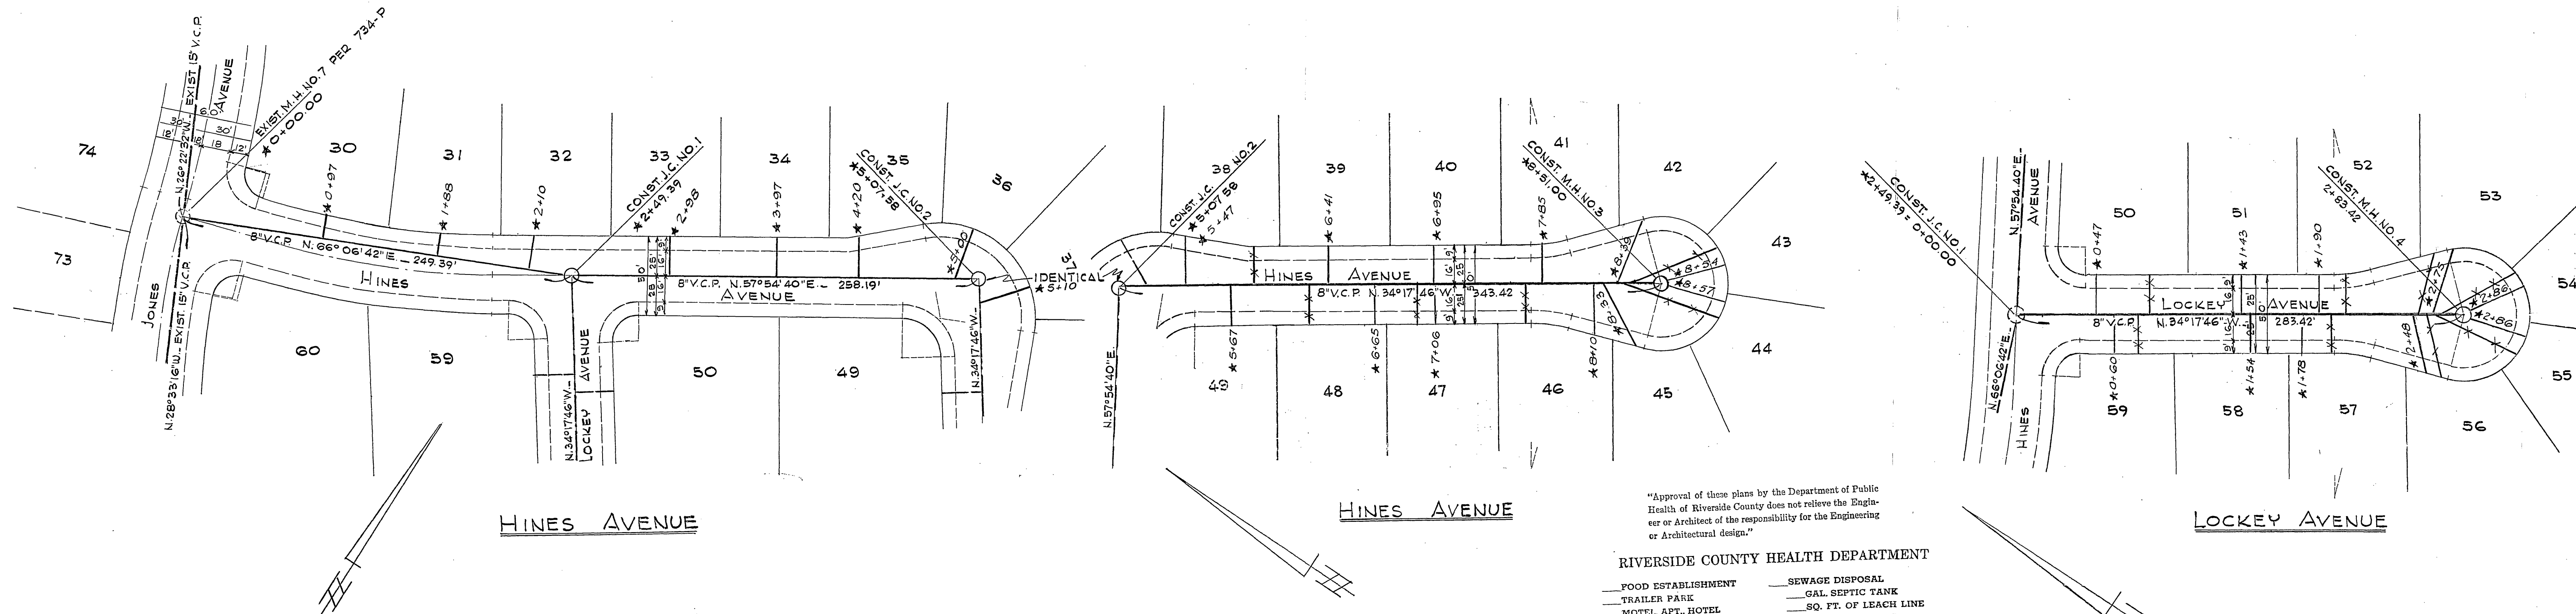

"Approval of these plans by the Department of Public Health of Riverside County does not relieve the Engineer or Architect of the responsibility for the Engineering or Architectural design."

RIVERSIDE COUNTY HEALTH DEPARTMENT


FOOD ESTABLISHMENT	SEWAGE DISPOSAL
TRAILER PARK	GAL. SEPTIC TANK
MOTEL, APT., HOTEL	SQ. FT. OF LEACH LINE
DWELLING	X SEWAGE FIT
COMMERCIAL BUILDING	CONNECTION TO SEWER
WATER SOURCE	X SEWER LINE LAYOUT
WATER LINE LAYOUT	SWIMMING POOL

PLAN  
SCALE - 1" = 50'

This is to Certify that the Riverside County Health Department Approves for Occupancy, Construction or Installation (the Item(s) Checked Above).

Date 9-3-59 By M. Lawrence

BENCH MARK  
RIVERSIDE COUNTY B.M. NO. 7  
CHISELED "X" ON STEP OF CHURCH  
N.W. CORNER HOLE AVE. & JONES AVE.  
ELEV. 703.93

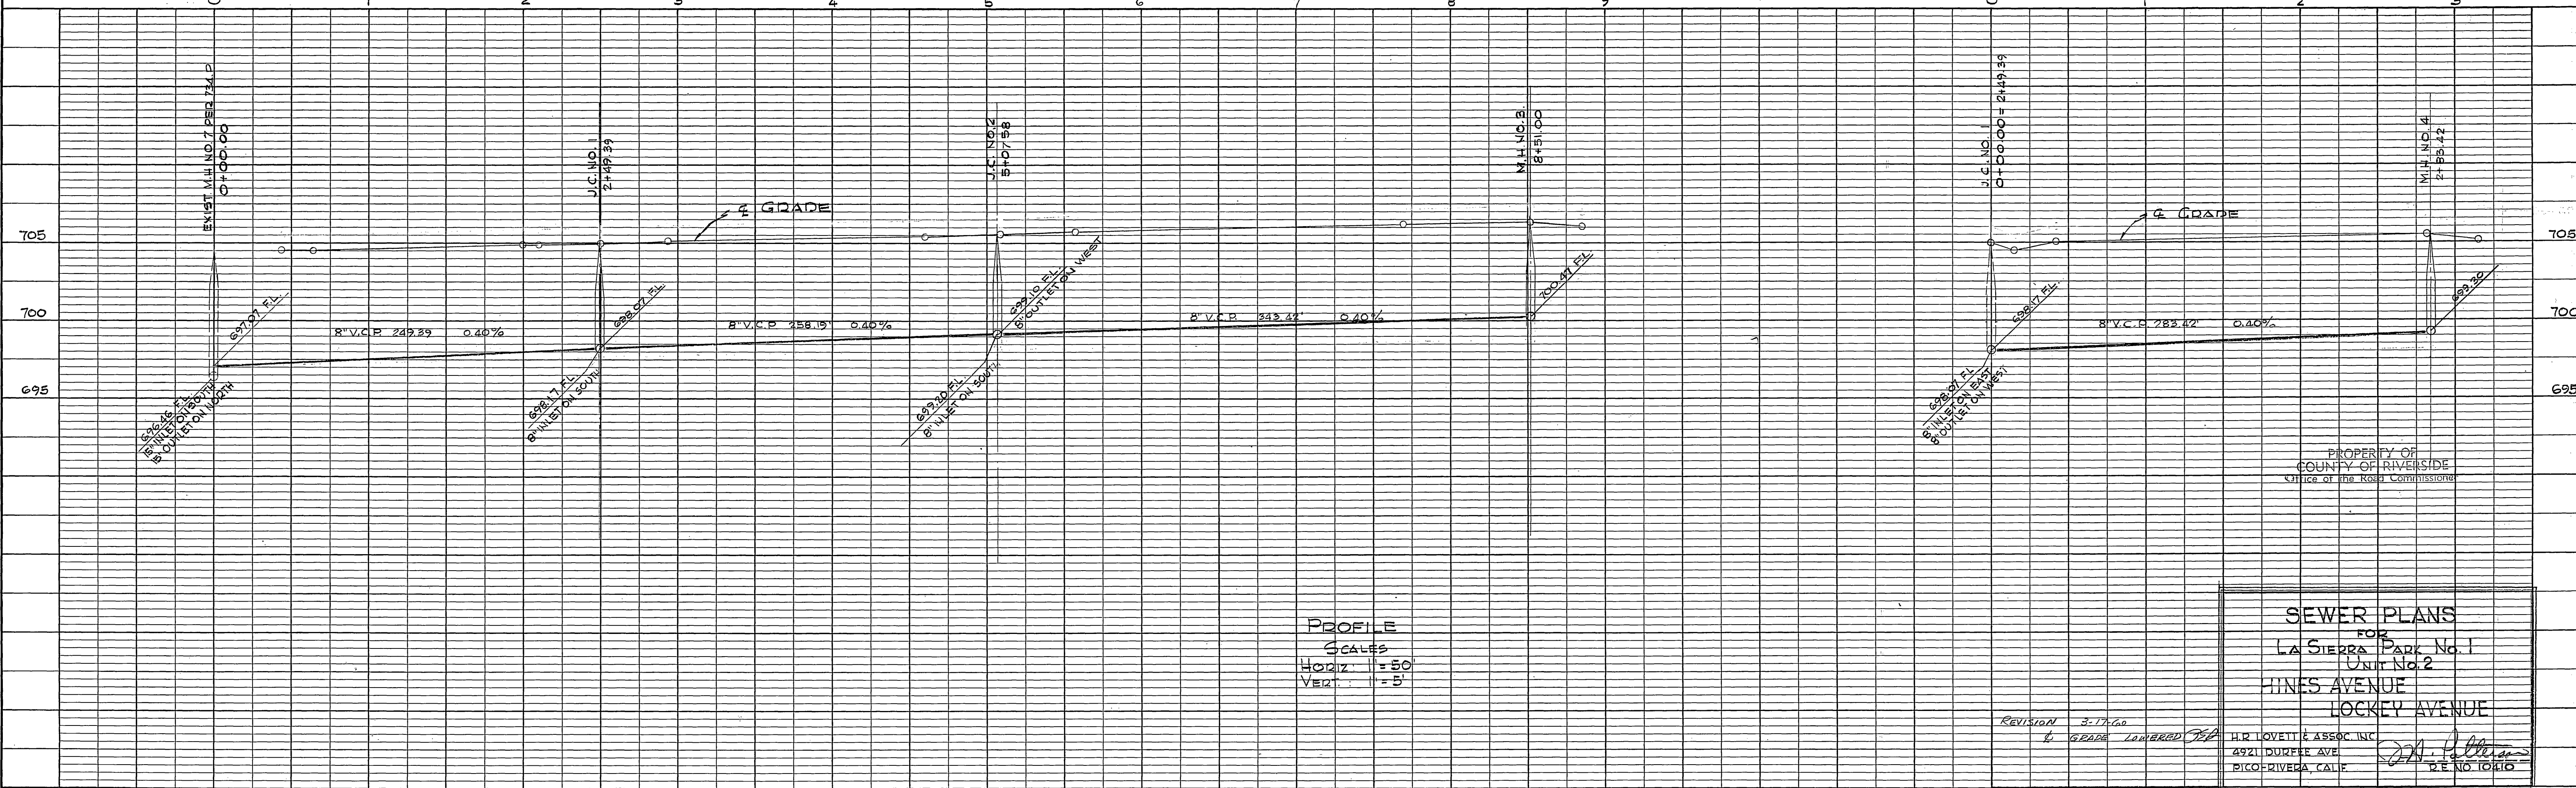

PROFILE  
SCALE  
HORIZ. 1" = 50'  
VERT. 1" = 5'

PROPERTY OF  
COUNTY OF RIVERSIDE  
Office of the Road Commission

SEWER PLANS  
FOR  
LA SIERRA PARK No. 1  
Unit No. 2  
HINES AVENUE  
LOCKEY AVENUE

REVISION 3-17-60  
L. GERRARD LAMBERT

H.R. LOVETT & ASSOC. INC.  
4921 DURFEE AVE.  
MICO-RIVERA, CALIF.  
S.E. NO. 10410