


PLAN	DATE	BY
SURVEYED		
NOTE BOOK		
ALIGNMENT CHECKED		
RT. OF WAY CHECKED		
NO.		

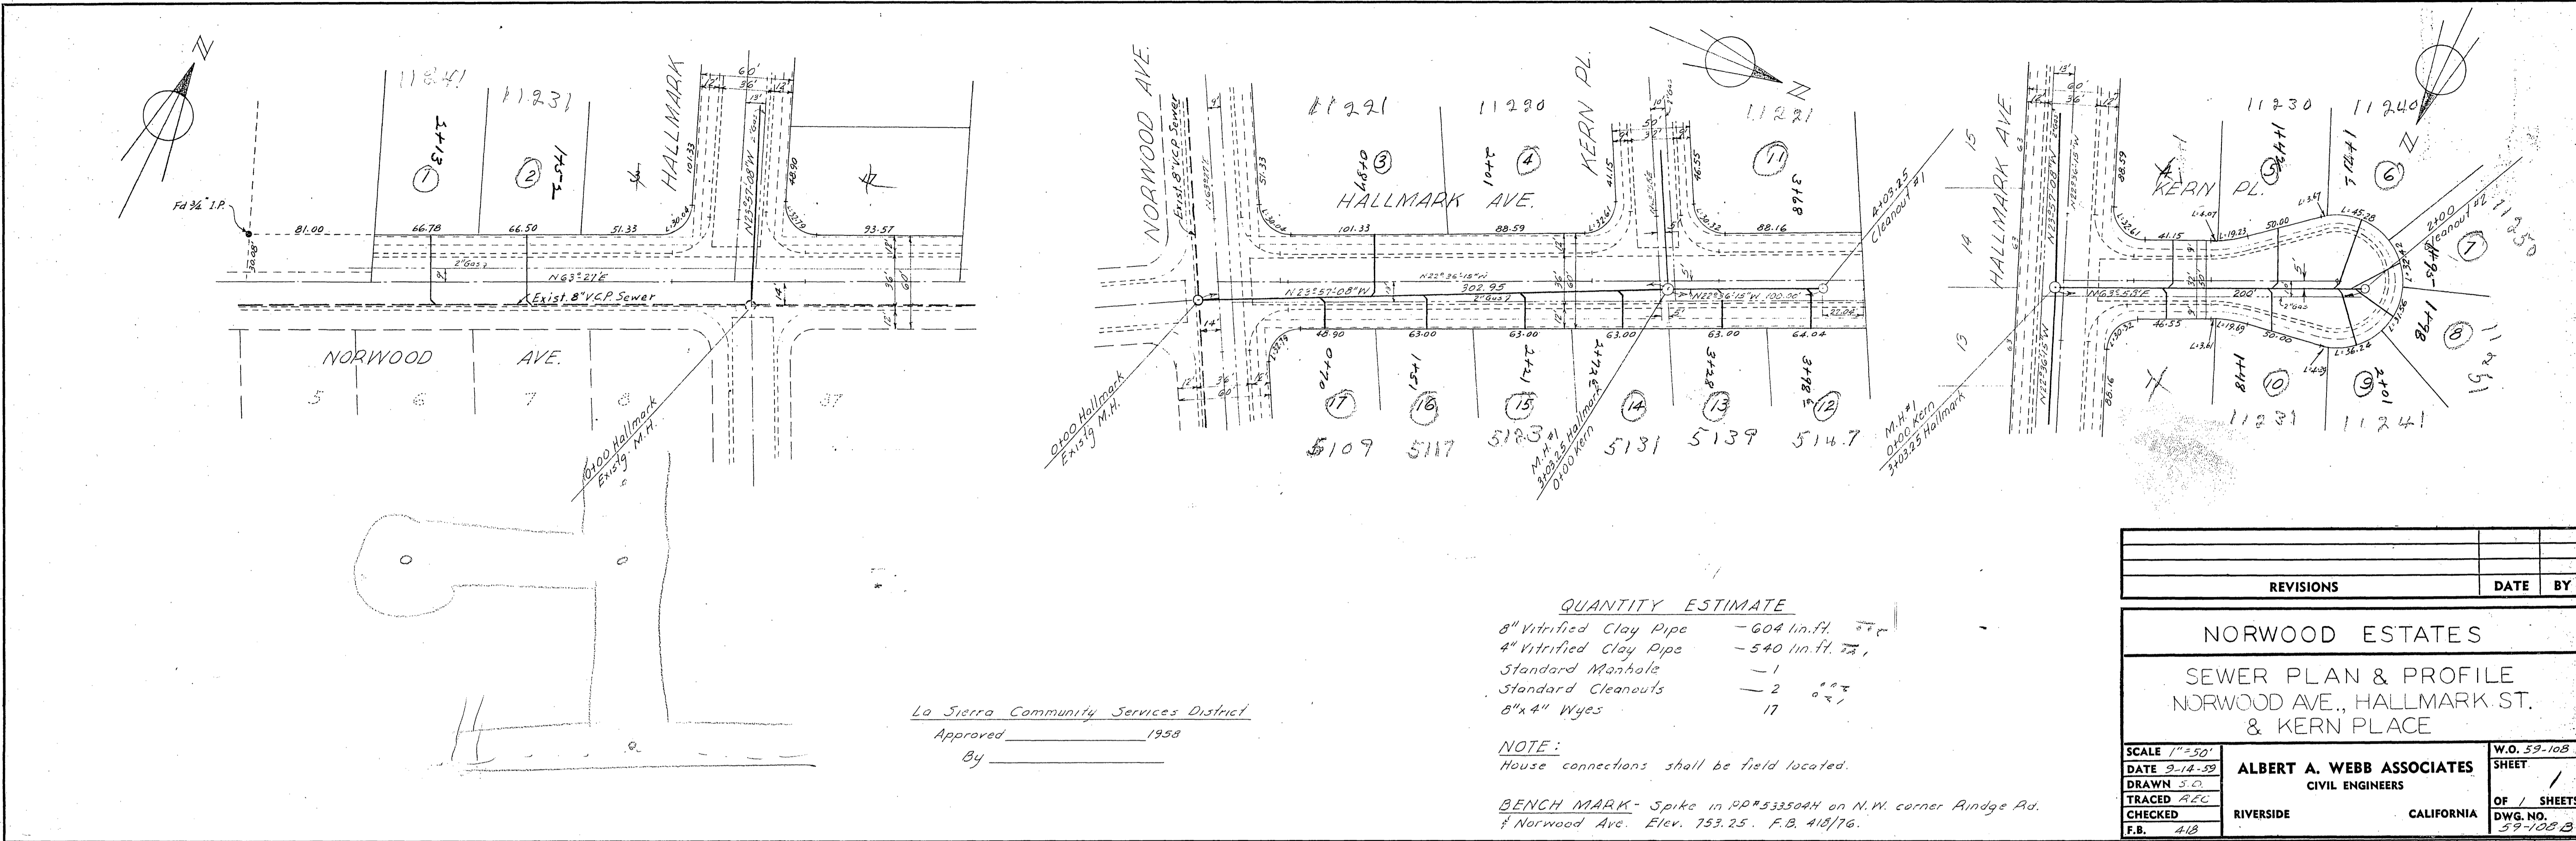

La Sierra Community Services District
 Approved _____ 1958
 By _____

QUANTITY ESTIMATE

8" Vitrified Clay Pipe	- 604 lin. ft.
4" Vitrified Clay Pipe	- 540 lin. ft.
Standard Manhole	- 1
Standard Cleanouts	- 2
6" x 4" Wyes	- 1

NOTE:
 House connections shall be field located.

BENCH MARK: Spike in R.P. 5335044 on N.W. corner Ridge Ad. & Norwood Ave. Elev. 753.25. F.B. 418/76.

REVISIONS	DATE	BY
NORWOOD ESTATES		
SEWER PLAN & PROFILE		
NORWOOD AVE., HALLMARK ST. & KERN PLACE		
SCALE 1"=50'	DATE 9-12-58	W.O. 59-108
DRAWN S.O.	CHECKED REC	SHEET /
TRACED REC	ALBERT A. WEBB ASSOCIATES	OF 1 SHEETS
CHECKED	CIVIL ENGINEERS	DWG. NO.
F.B. 418	RIVERSIDE CALIFORNIA	59-108-B

PROFILE	DATE	BY
SURVEYED		
NOTE BOOK		
GRADES CHECKED		
B. M.'S NOTED		
STRUCTURE NOTINGS CHECKED		
NO.		

