


DATE	
BY	
REVISIONS	
NO. BOOK	
NOTE CHECKED	
ALIGNMENT CHECKED	
RT. OF WAY CHECKED	
NO.	

DATE	
BY	
REVISIONS	
NO. BOOK	
NOTE CHECKED	
GRADES CHECKED	
STRUCTURE NOTATIONS CHECKED	
NO.	

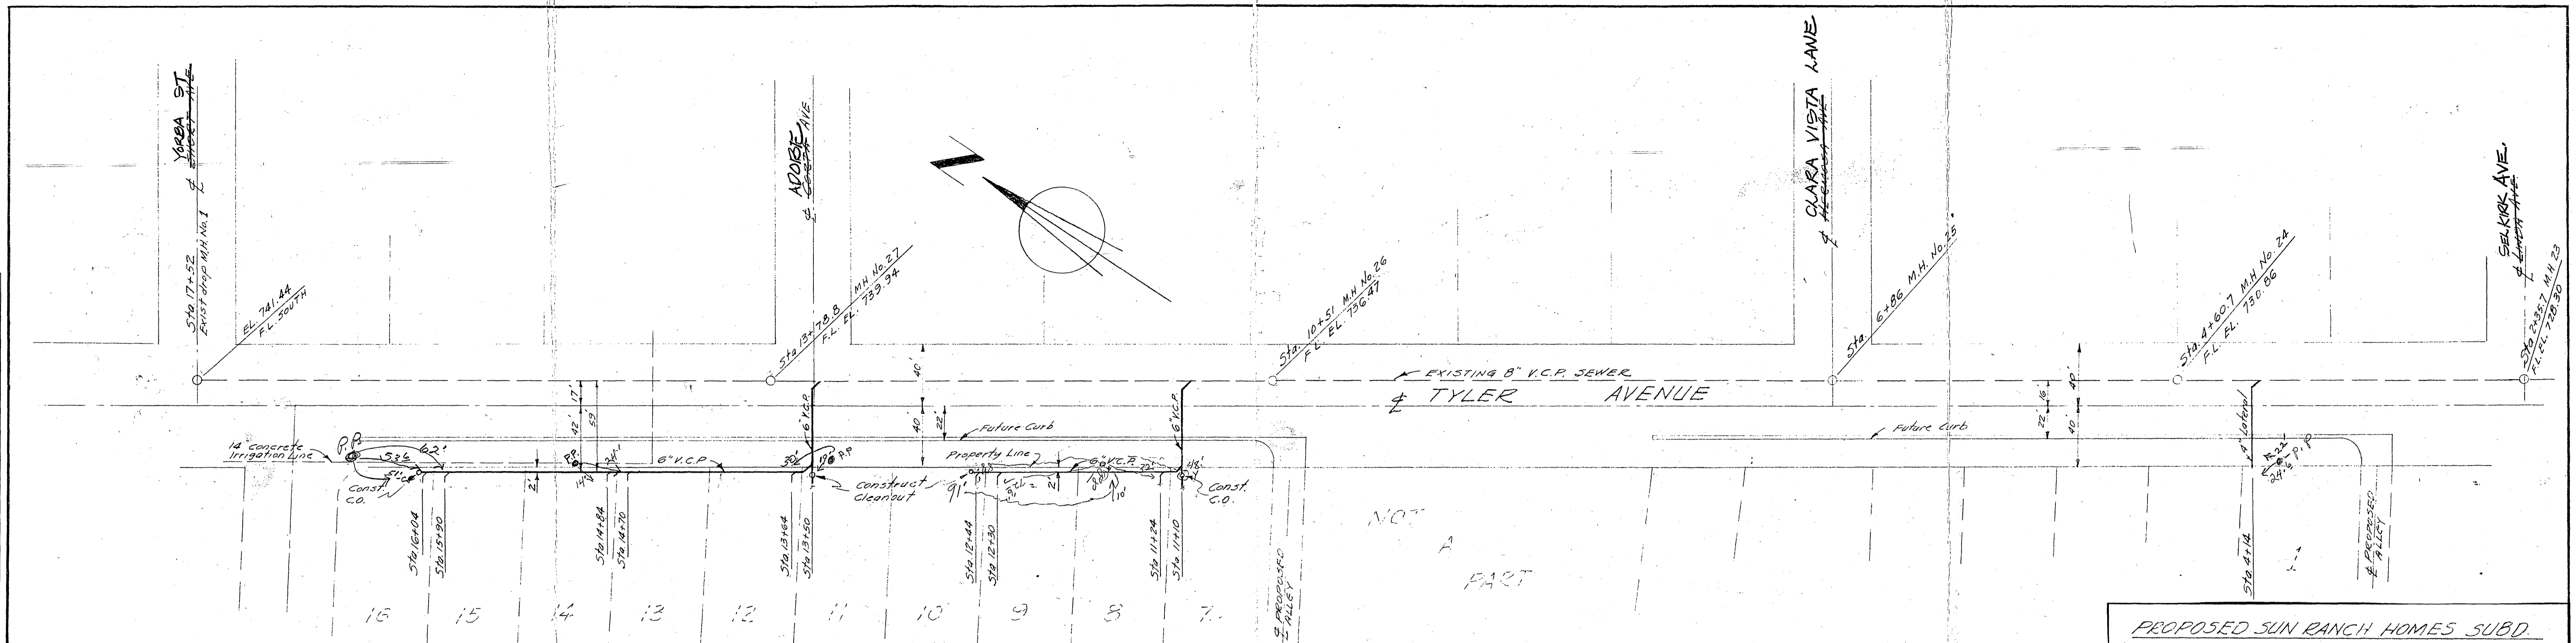

QUANTITY ESTIMATE

6" V.C.P.	-	375 Lin Ft =
4" V.C.P. Lateral	-	55 Lin Ft =
6x6 Wye	-	4 ea
6x4 Wye	-	8 ea
6" Cleanouts	-	4 ea
Connections to main	-	3

NOTES:
 Elevations and stations shown on existing manholes were obtained from cut sheets and Field Book on file in La Sierra Community Services office.
 Station 17+52 this plan = Sta. 32+48.76 on County Surveyor Road Plan No 710 H. Equation = 1696.76

PROPOSED SUN RANCH HOMES SUBD.

SEWER PLAN AND PROFILE
 TYLER AVENUE

SCALE	1" = 50'	W.O. 59-54
DATE	5-29-59	SHEET
DRAWN	JHS	
TRACED		
CHECKED		
F.B.	372	

ALBERT A. WEBB ASSOCIATES
 CIVIL ENGINEERS

RIVERSIDE CALIFORNIA

OF SHEETS
 DWG. NO. 59-54C

REVISIONS	DATE	BY

