


**GENERAL NOTES**

- Construction shall be in accordance with the City of Riverside, Department of Public Works, Standard Specifications No. 461 and Standard Drawings.
- It shall be the responsibility of the contractor to clear the right of way in accordance with the provisions of the law as it affects each utility including irrigation lines and appurtenances and of no cost to the City.
- Joints in vitrified clay pipe sewers shall conform to ASTM Standard C-425-60T, or the latest revision thereof.
- Pipe shall be bedded per Case II, Standard Drawing No. 452, unless otherwise specified on plan.
- Location of wyes and laterals to be determined in the field.

**QUANTITY ESTIMATE**

8" Vitrified Clay Pipe	3,350 L.F.
4" Vitrified Clay Pipe	1,665 L.F.
8" x 4" Wyes	53 Ea.
Manhole - Std. No. 500	11 Ea.
Cleanout - Std. No. 560	2 Ea.

Bench Mark: El. 877.88  
 Chisled "X" on top of curb 1' south of end of exist. curb @ North Tract Bdy. on E. side of Peacock Lane.

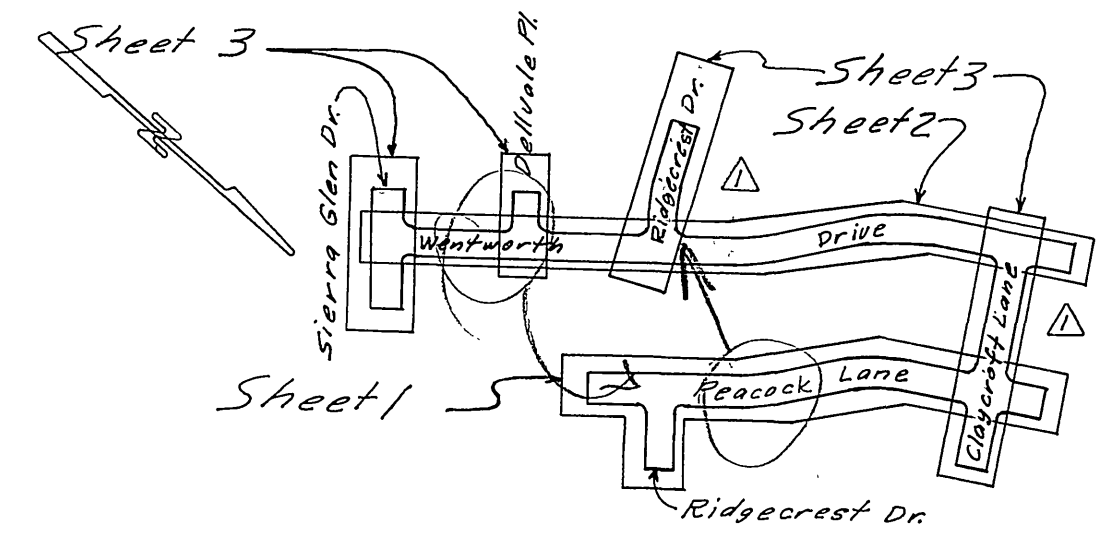

**INDEX MAP**  
 Scale: 1" = 400'

\* As built 9/16/64 BE.

REVISION	
MARK	DESCRIPTION


ALBERT A. WEBB ASSOCIATES  
 CIVIL ENGINEERS - RIVERSIDE, CALIFORNIA  
 APPROVED: *[Signature]* DATE: 7/27/64  
 CITY OF RIVERSIDE, CALIFORNIA  
 DEPARTMENT OF PUBLIC WORKS  
 SEWER PLAN & PROFILE  
**PEACOCK LANE**  
**RIDGECREST DRIVE**  
 TRACT No. 2740

DATE: Oct. 1963  
 SCALE: Vert. 1" = 10'  
 Horiz. 1" = 50'  
 DRAWN BY: JMK  
 CHECKED BY: JMK  
 DATE: 6-30-64


APPROVED BY: *[Signature]*  
 DIRECTOR OF PUBLIC WORKS  
 NO. S-534  
 SHEET 1 OF 3

PROFILE	DATE
SURVEYED	
PLOTTED	
NOTED	
STRUCTURE NOTATION	

PLANS	DATE
SURVEYED	
PLOTTED	
NOTED	
STRUCTURE NOTATION	

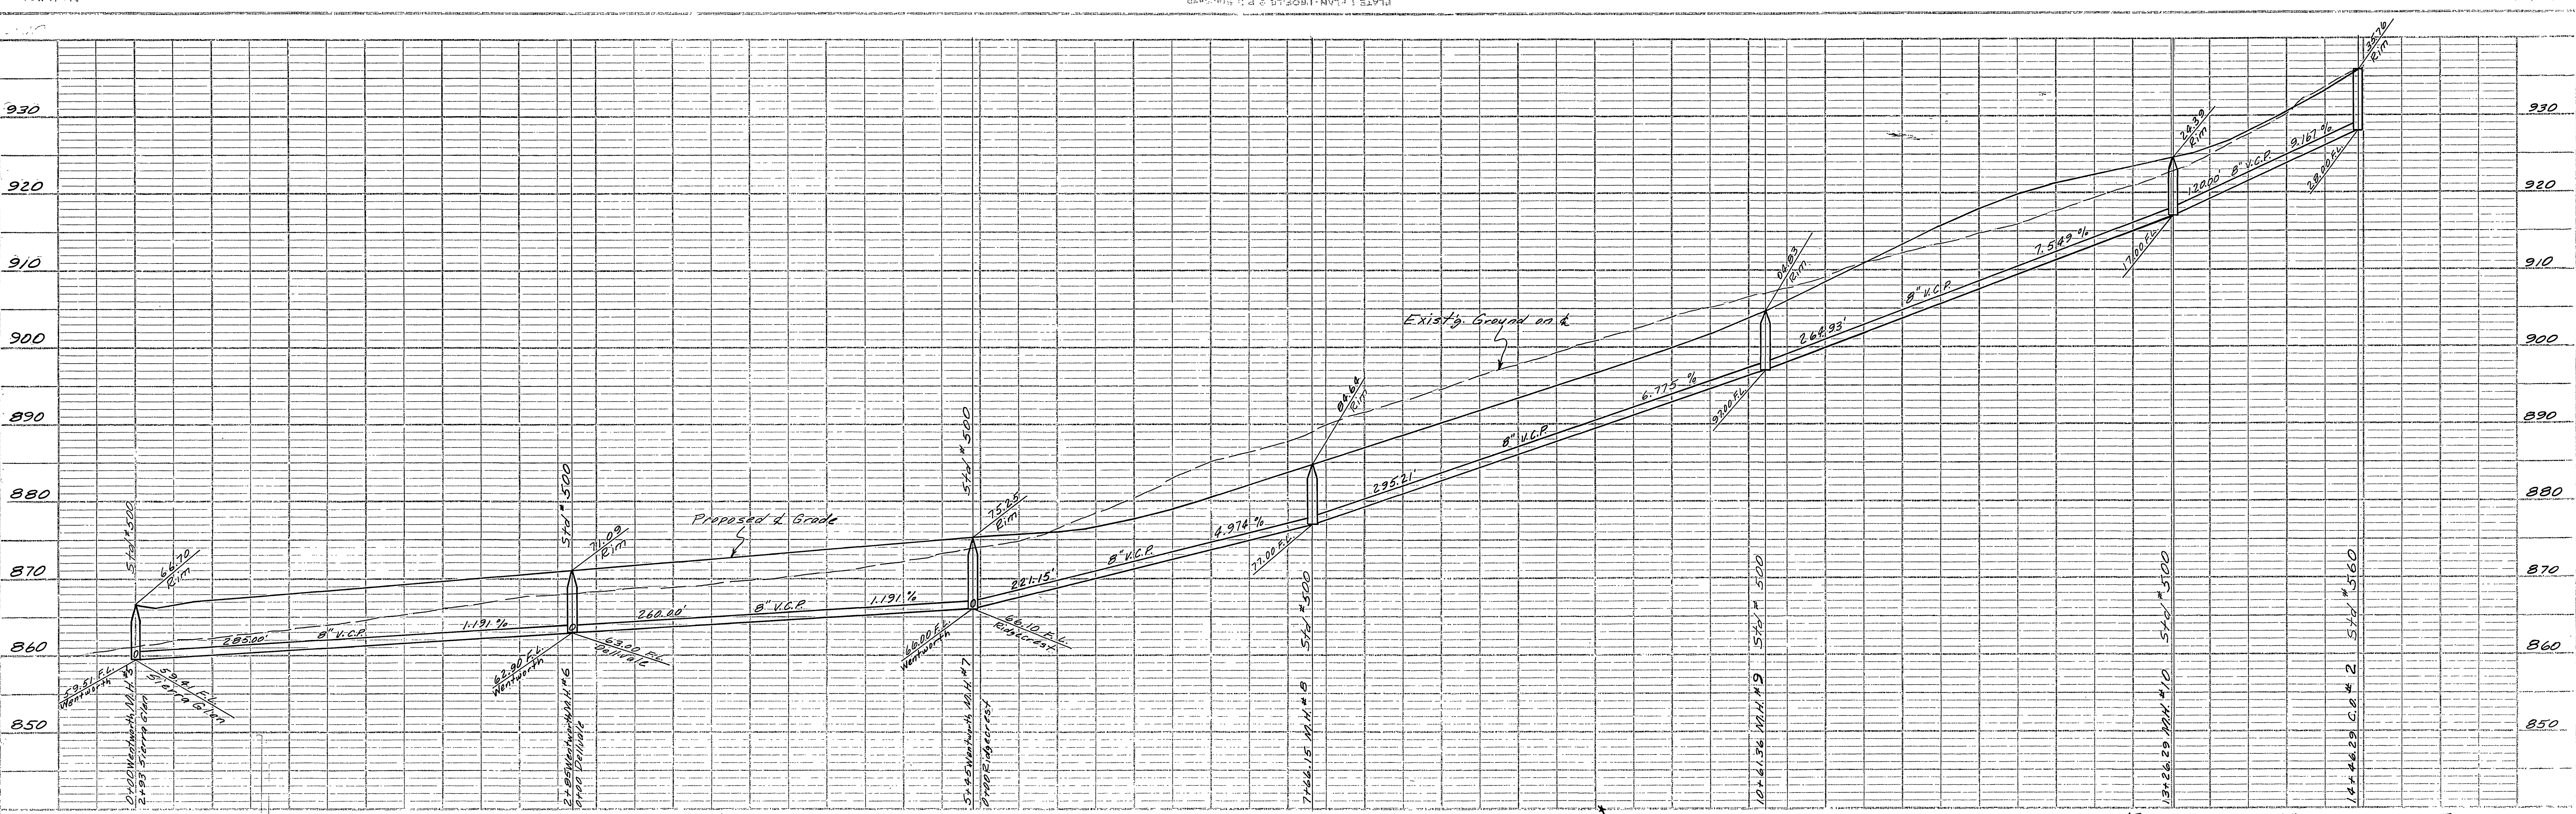

PROFILE	DATE
NO.	
BY	
DATE	


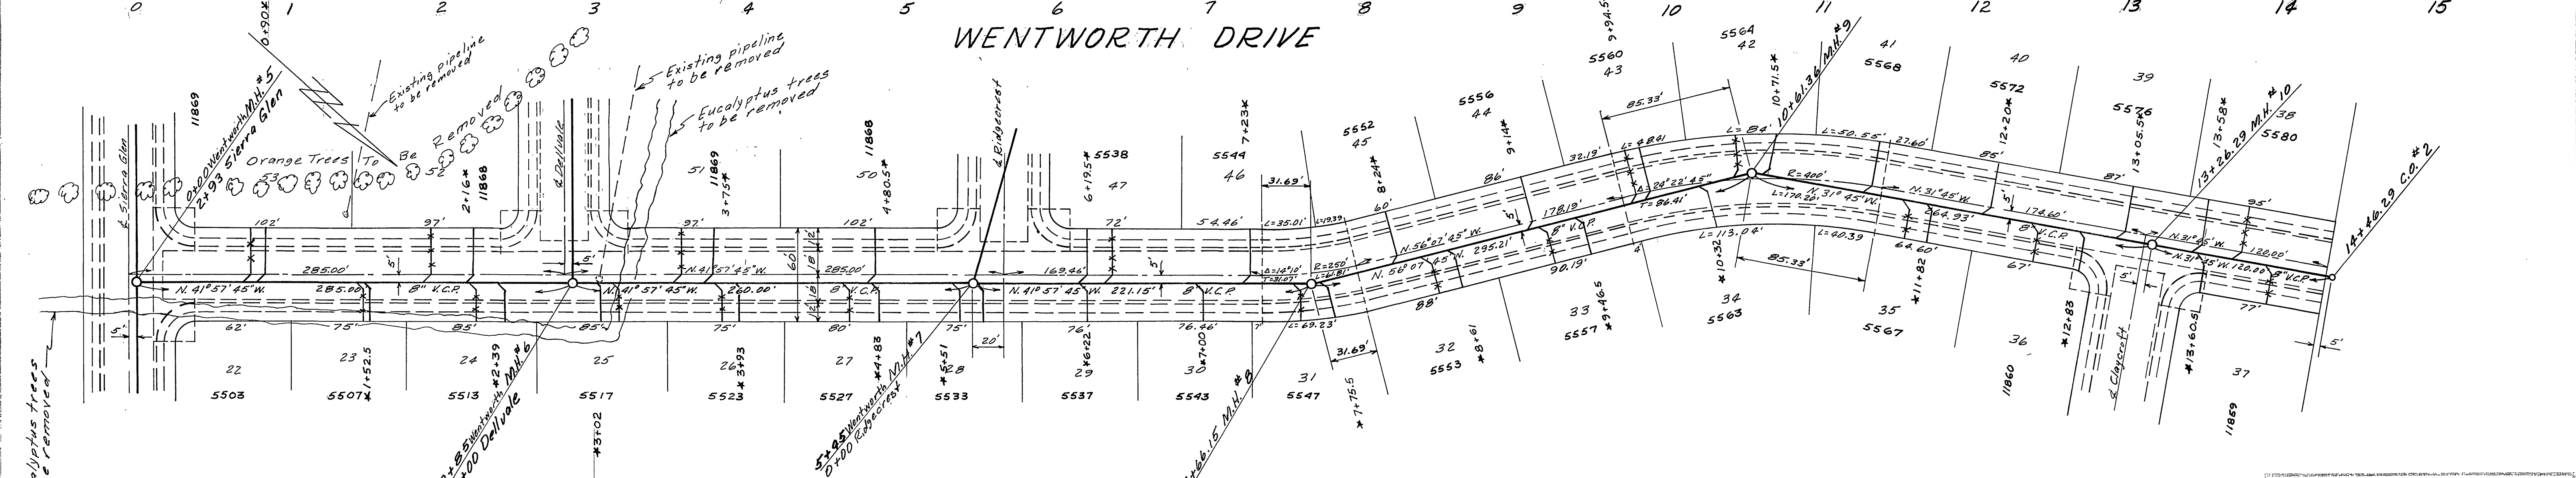


PLAN	DATE
NO.	
BY	
DATE	

Bench Mark: El. 864.04  
 Chiseled 'X' on top of curb 1' E. of West end of the end of exist curb on the South side of Sierra Glen Dr, approx 148' W. of intersection Sierra Glen & Peacock.

\*: As built 9/21/64 B.E.

ALBERT A. WEBB ASSOCIATES CIVIL ENGINEERS - RIVERSIDE, CALIFORNIA APPROVED: <i>Albert A. Webb</i> DATE 2/27/64 42 9876												
CITY OF RIVERSIDE, CALIFORNIA DEPARTMENT OF PUBLIC WORKS SEWER PLAN & PROFILE of <b>WENTWORTH DRIVE</b> in <b>TRACT No. 2740</b>												
<table border="1"> <thead> <tr> <th colspan="2">REVISION</th> </tr> <tr> <th>MARK</th> <th>DESCRIPTION</th> </tr> </thead> <tbody> <tr> <td> </td> <td> </td> </tr> <tr> <td> </td> <td> </td> </tr> </tbody> </table>	REVISION		MARK	DESCRIPTION					<table border="1"> <tr> <td>           Oct. 1963            J.M.W.            108         </td> <td>           SCALE Vert. 1"=10'            Horiz. 1"=50'            W.D.            63-183            4881542         </td> <td>           APPROVED BY  <i>Jan... ..</i>            DIRECTOR OF PUBLIC WORKS            DATE 6-30-64            SHEET 2 OF 3         </td> </tr> </table>	Oct. 1963 J.M.W. 108	SCALE Vert. 1"=10' Horiz. 1"=50' W.D. 63-183 4881542	APPROVED BY <i>Jan... ..</i> DIRECTOR OF PUBLIC WORKS DATE 6-30-64 SHEET 2 OF 3
REVISION												
MARK	DESCRIPTION											
Oct. 1963 J.M.W. 108	SCALE Vert. 1"=10' Horiz. 1"=50' W.D. 63-183 4881542	APPROVED BY <i>Jan... ..</i> DIRECTOR OF PUBLIC WORKS DATE 6-30-64 SHEET 2 OF 3										

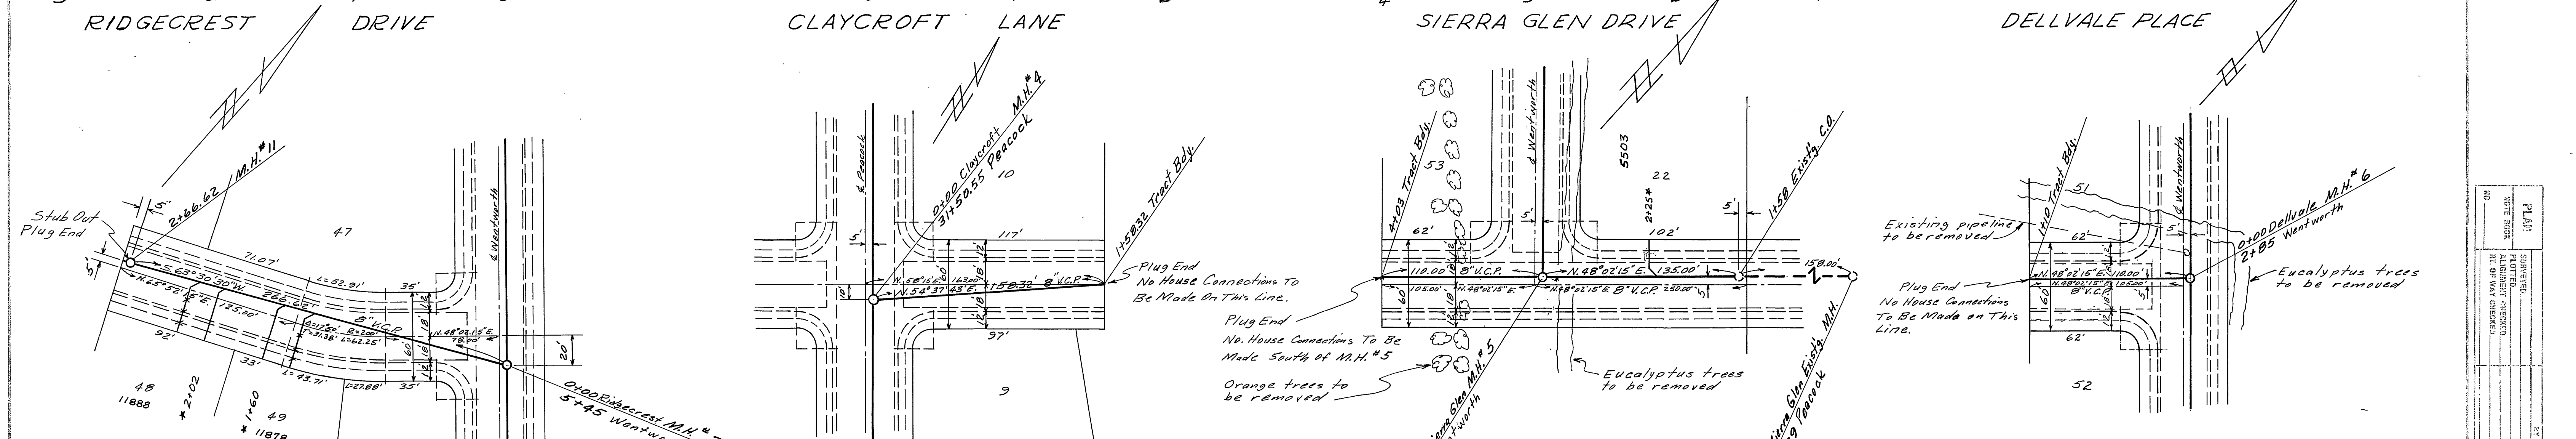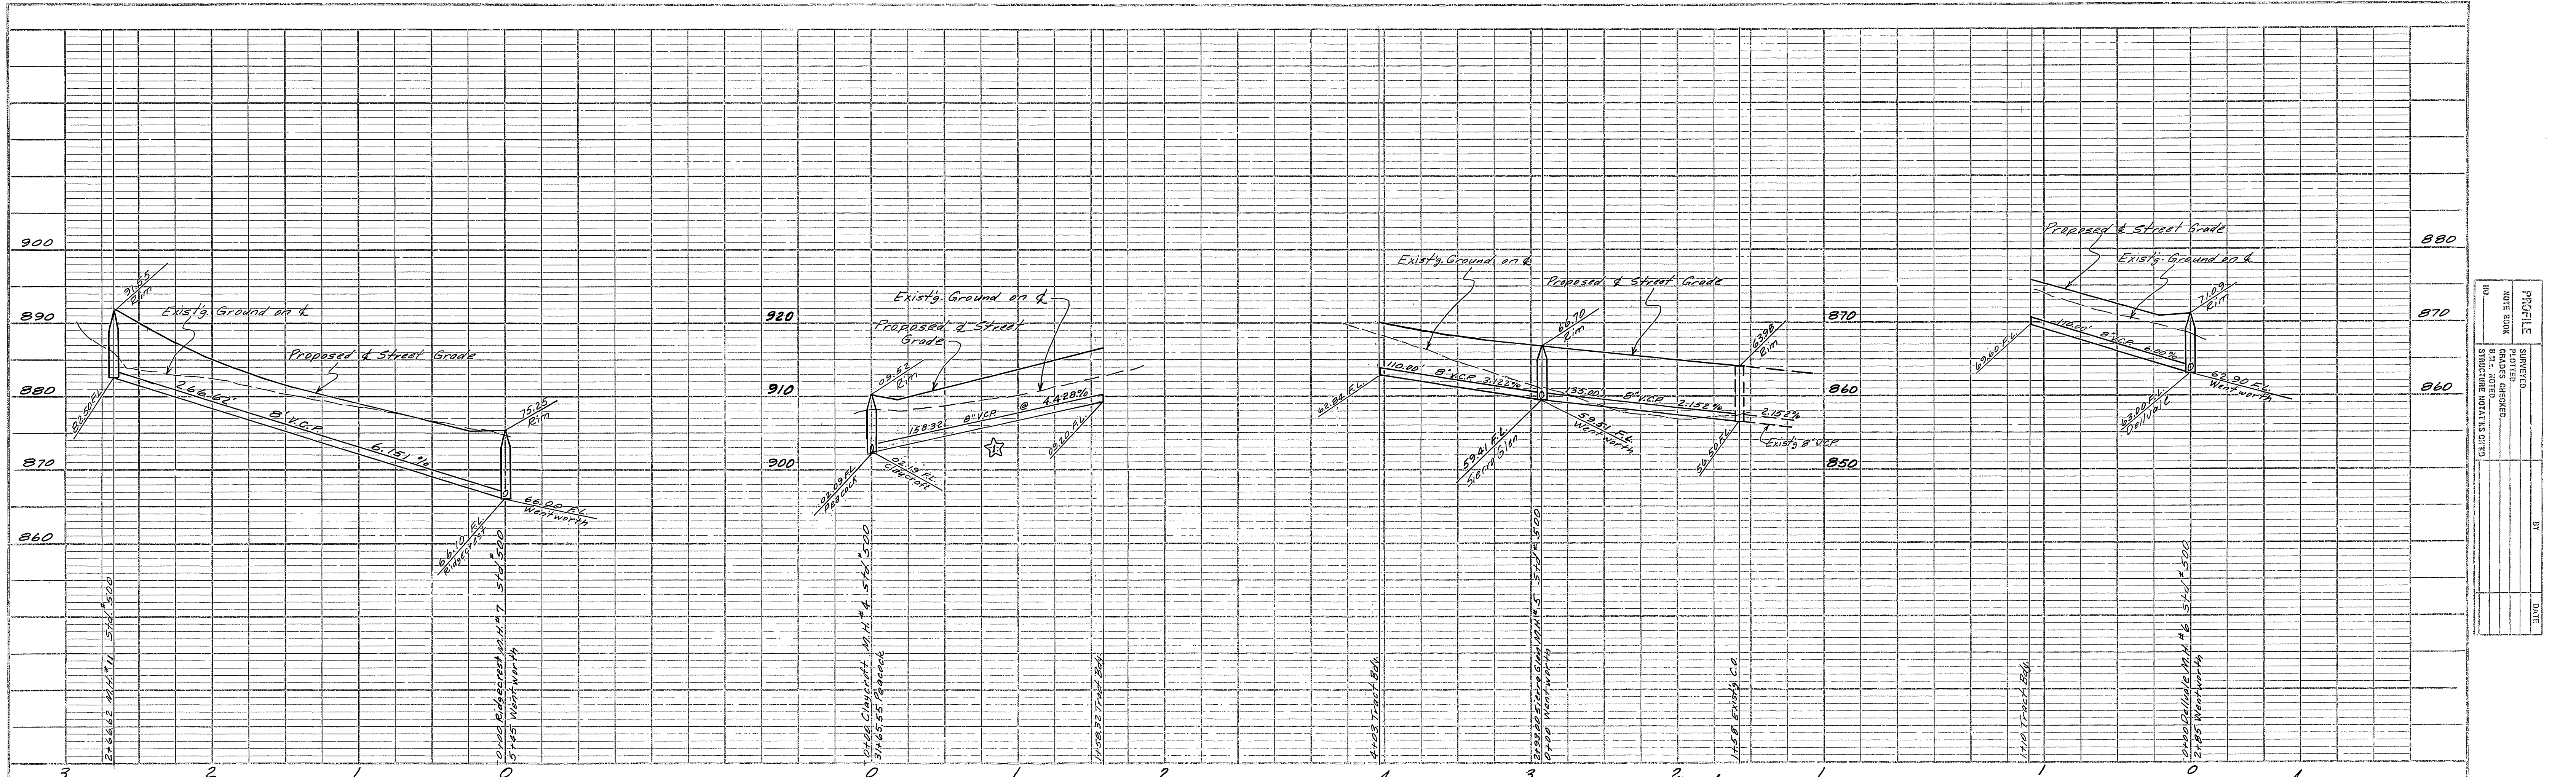

Bench Mark: E.I. 864.04  
 Chiseled 'x' on top of curb 1' E.  
 of West end of the end of exist curb  
 on the South side of Sierra Glen Dr.,  
 approx. 148' W. of intersection Sierra  
 Glen & Peacock.

\* As built 9/17/64 BE.

REVISION		
MARK	DATE	DESCRIPTION
*	8/2/64	Revised Sewer grade on Claycroft ENW Rowley ARJ

ALBERT A. WEBB ASSOCIATES CIVIL ENGINEERS - RIVERSIDE, CALIFORNIA APPROVED: <i>Albert A. Webb</i> DATE 7/27/64 S.E. 2876	
CITY OF RIVERSIDE, CALIFORNIA DEPARTMENT OF PUBLIC WORKS SEWER PLAN & PROFILE of Ridgecrest Dr. - Claycroft Lane Sierra Glen Dr. - Dellvale Place in TRACT No. 2740	
DATE: Oct, 1963 DRAWN: W.J. CHECKED: J.W.W.	SCALE: Vert. 1"=10' Horiz. 1"=50' 63-183 P.B. 4881592
APPROVED BY: <i>[Signature]</i> DIRECTOR OF PUBLIC WORKS DATE: 6-30-64	NO. 5-534 SHEET 3 OF 3

PROFILE	SUBMITTED	BY	DATE
NOTE BOOK	GRADES CHECKED		
NO.	BY: B.A. WEBB		
	STATUS: FINAL		

PLAN	SUBMITTED	BY	DATE
NOTE BOOK	ALBERT A. WEBB		
NO.	BY: B.A. WEBB		
	STATUS: FINAL		