


B.M. 882.90 on capped
 bronze disc in S Spruce
 St. & Kansas Ave.
 F.B. 5-9-29
 Scale Horiz. 1"=40'
 Vert. 1"=8'

B.M. 973.46 F.H. in N.E. curb
 return of Glenhaven
 Ave. & Arroyo Dr.
 F.B. 5-9-30
 Scale Horiz. 1"=40'
 Vert. 1"=8'

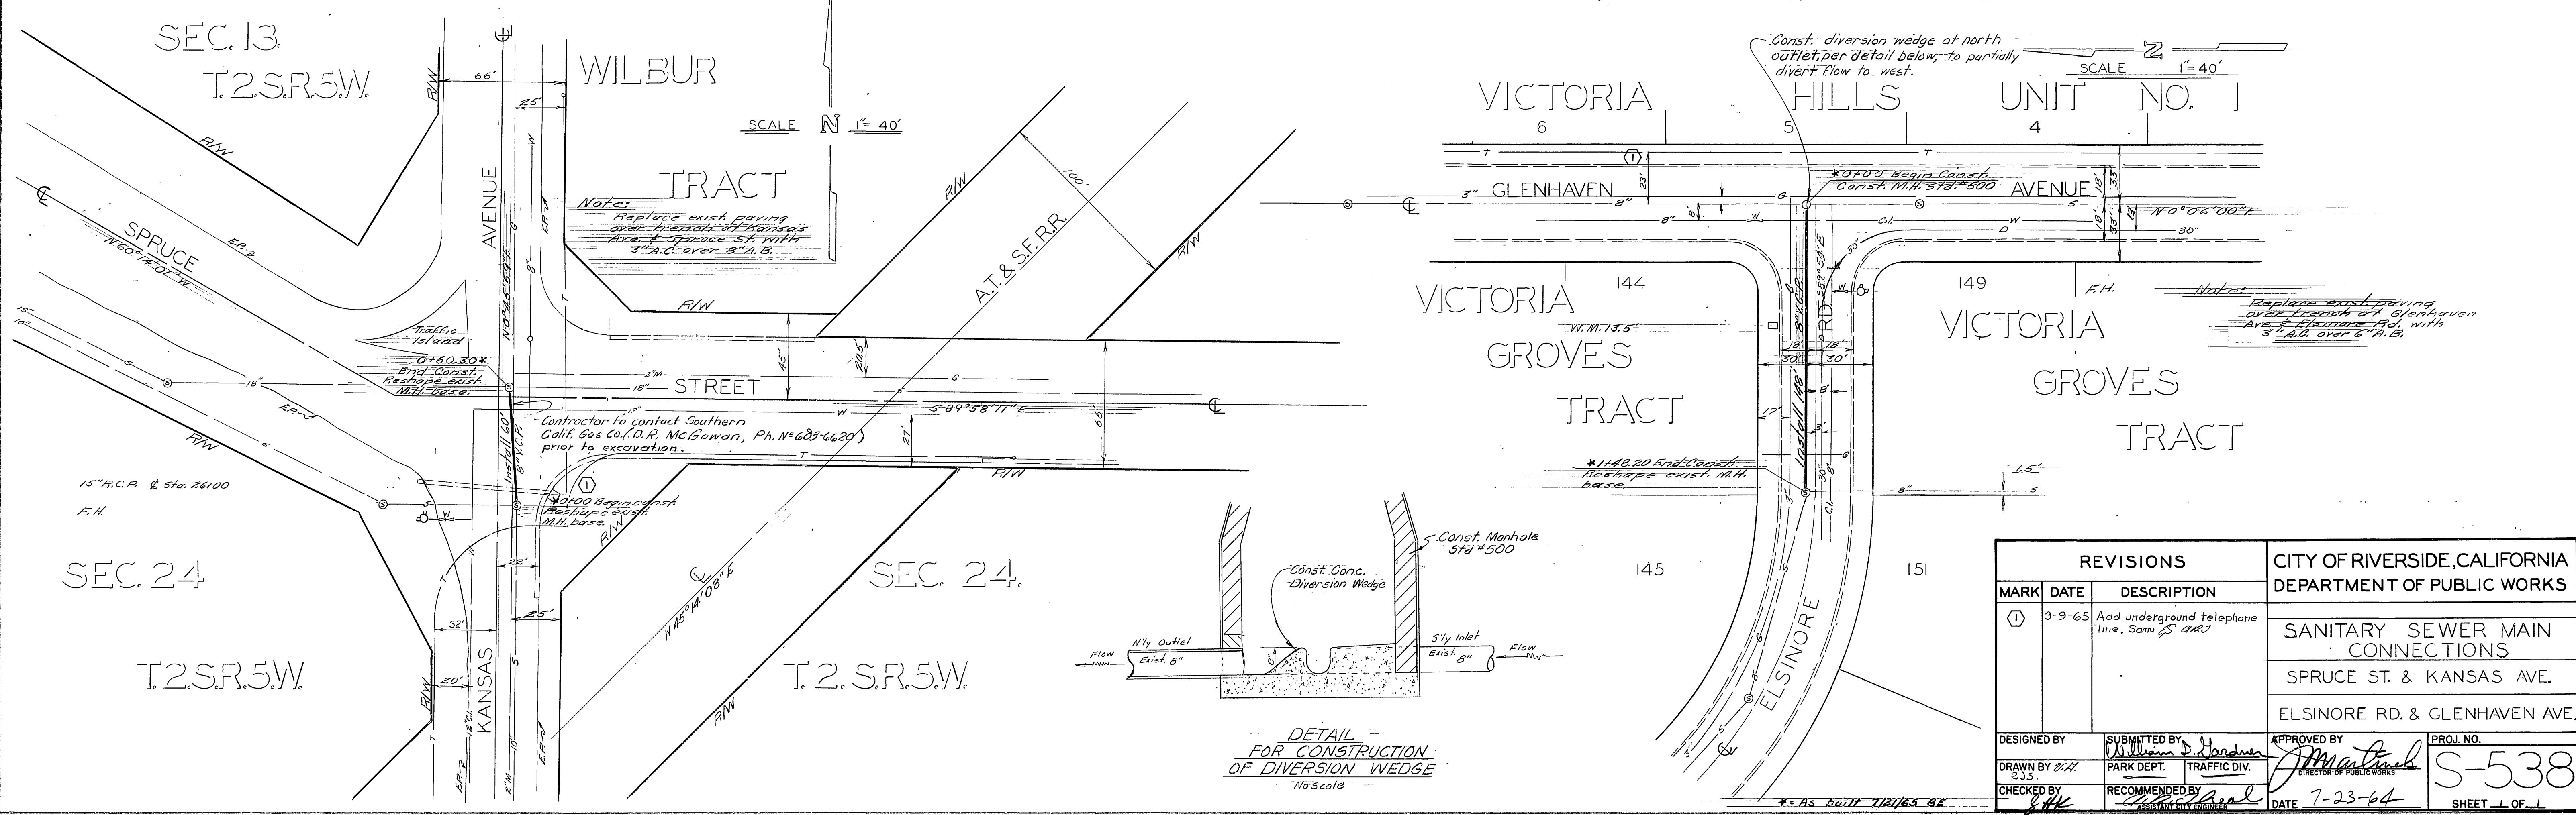

Note: Replace exist paving
 over 4" x 6" x 8" manholes
 Ave. & Spruce St. with
 3" A.C. over 6" x 8" B.

Note: Replace exist paving
 over 4" x 6" x 8" manholes
 Ave. & Glenhaven Rd. with
 3" A.C. over 6" x 8" B.

Contractor to contact Southern
 Calif. Gas Co. (D.R. McGowan, Ph. No. 683-6620)
 prior to excavation.

DETAIL
 FOR CONSTRUCTION
 OF DIVERSION WEDGE
 No scale

REVISIONS		
MARK	DATE	DESCRIPTION
①	3-9-65	Add underground telephone line. Same as above

CITY OF RIVERSIDE, CALIFORNIA DEPARTMENT OF PUBLIC WORKS		
SANITARY SEWER MAIN CONNECTIONS		
SPRUCE ST. & KANSAS AVE.		
ELSINORE RD. & GLENHAVEN AVE.		
DESIGNED BY E.J.S.	SUBMITTED BY William D. Gardner PARK DEPT. TRAFFIC DIV.	APPROVED BY <i>[Signature]</i> DIRECTOR OF PUBLIC WORKS
CHECKED BY <i>[Signature]</i>	RECOMMENDED BY <i>[Signature]</i> ASSISTANT CITY ENGINEER	DATE 7-23-64
PROJ. NO. S-538		SHEET 1 OF 1

PROFILE	SUBMITTED	BY	DATE
NOTE BOOK	PLOTTED		
NO.	GRADES CHECKED		
	STRUCTURE NOTATIONS CHECKED		

PLAN	SUBMITTED	BY	DATE
NOTE BOOK	PLOTTED		
NO.	ALIGNMENT CHECKED		
	R.F. OR W.V. CHECKED		