


PROFILE
Van Buren Blvd
Scale: Hor. 1" = 40'
Vert. 1" = 4'

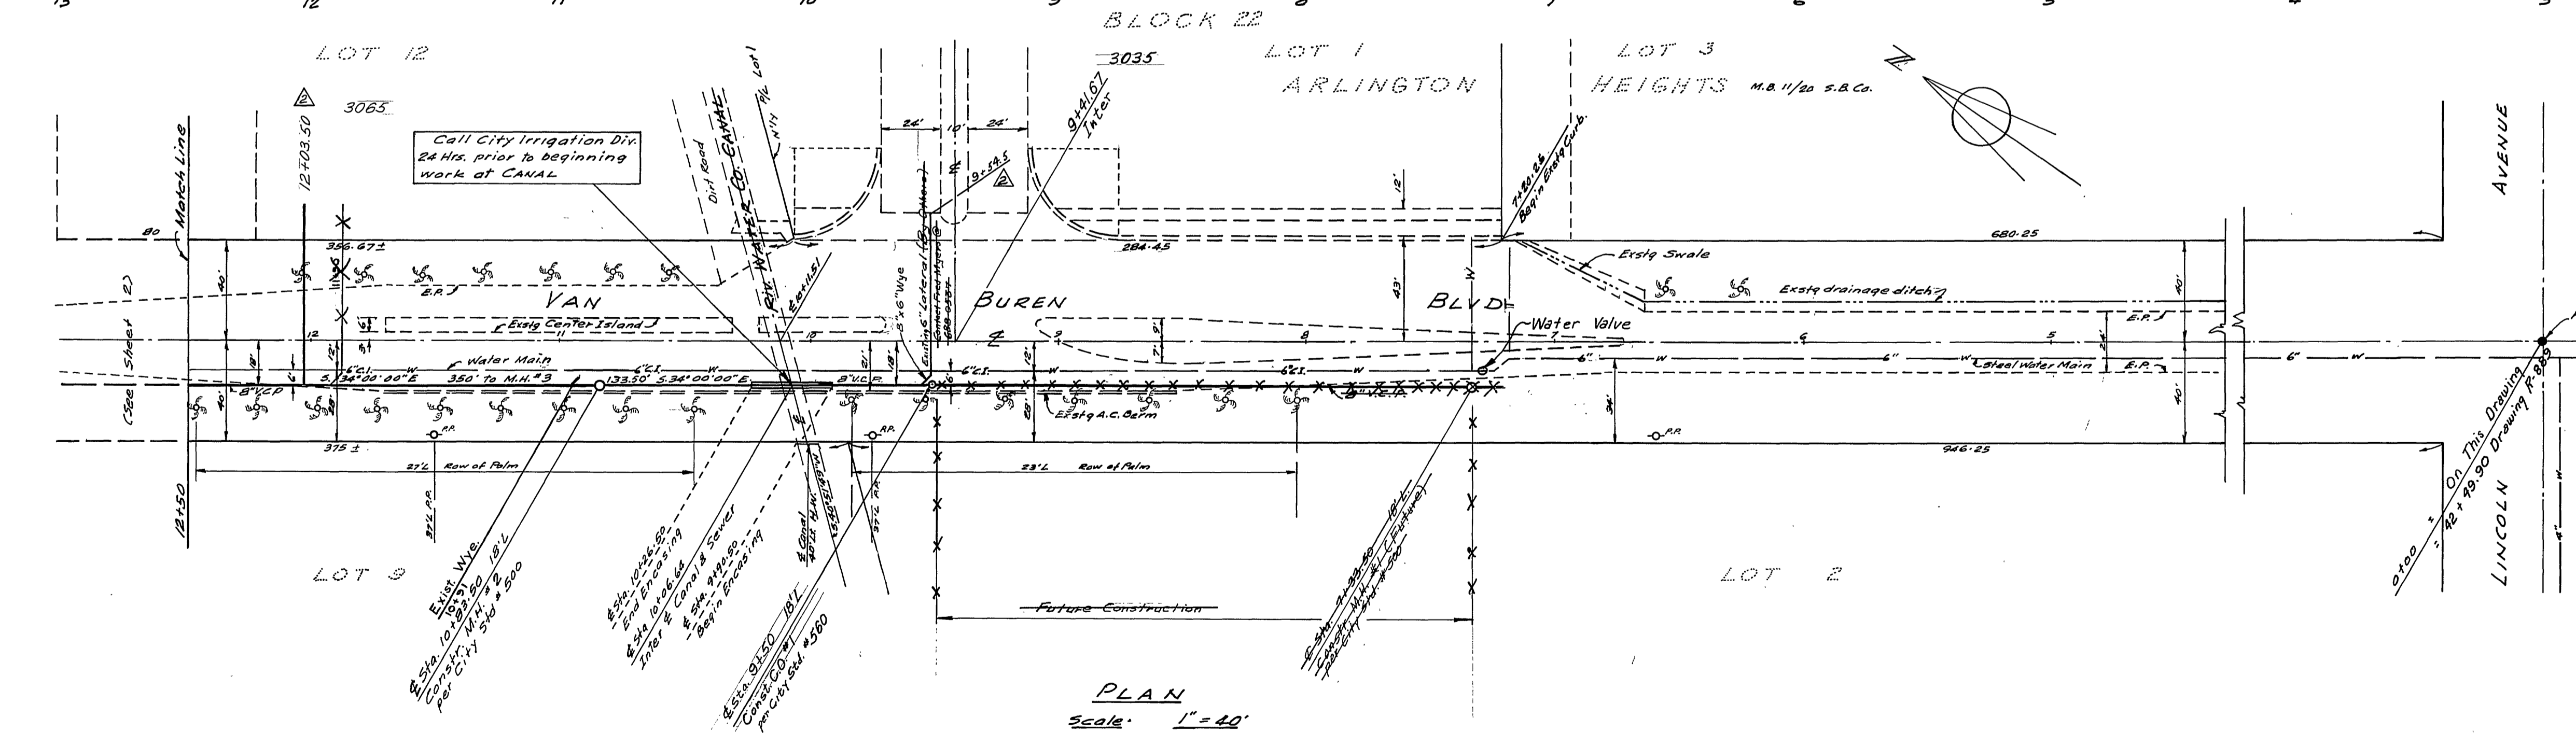

PLAN
Scale: 1" = 40'

- NOTE**
1. Laterals to be Constructed as Part of Van Buren Widening; Project 3073 See Drawing R-889
 2. Const. Lateral At Sta. 11+90 = 54+41 on Drawing R-889.

- GENERAL NOTES:**
1. Construction shall be in accordance with the City of Riverside, Dept of Public Works, Std Specifications #461 & Std Drawings
 2. It shall be the responsibility of the Contractor to clear the Right of Way in accordance with the provisions of law as it affects each utility including irrigation lines and appurtenances and at no cost to the City
 3. Joints in Vitrified Clay Pipe Sewers shall conform to A.S.T.M. Std C-485-60T or the latest revision thereof.
 4. Pipe shall be bedded per Case II, Standard Drawing No. 452, unless otherwise specified on Plan.
 5. Location of Wyes & Laterals to be determined in the field
 6. All stubs & laterals to be constructed in accordance with Std Dwg # 562. Stubs shall be plugged & capped
 7. Excavation & Construction in the vicinity of existing underground utilities shall be done with special care.


5059 ✓

"THIS DRAWING ISSUED FOR LATERAL CONSTRUCTION ONLY."


<p>APPROVED <i>[Signature]</i> IRRIGATION DIVISION Date 6-2-64</p>	<p>HUGH M. GALLAHER Riverside Civil Engineer, California Approved by <i>[Signature]</i> 4-23-64 R.C.E. 12293 Date</p>									
<p>REVISIONS</p> <table border="1" style="width: 100%; border-collapse: collapse;"> <thead> <tr> <th>MARK</th> <th>DATE</th> <th>DESCRIPTION</th> </tr> </thead> <tbody> <tr> <td>Δ</td> <td>10-28-61</td> <td>As Built and Added Laterals per <i>[Signature]</i></td> </tr> <tr> <td>Δ</td> <td>3-21-66</td> <td>AS BUILT LATERALS H.B. <i>[Signature]</i></td> </tr> </tbody> </table>		MARK	DATE	DESCRIPTION	Δ	10-28-61	As Built and Added Laterals per <i>[Signature]</i>	Δ	3-21-66	AS BUILT LATERALS H.B. <i>[Signature]</i>
MARK	DATE	DESCRIPTION								
Δ	10-28-61	As Built and Added Laterals per <i>[Signature]</i>								
Δ	3-21-66	AS BUILT LATERALS H.B. <i>[Signature]</i>								
<p>CITY OF RIVERSIDE DEPARTMENT OF PUBLIC WORKS</p>										
<p>VAN BUREN BLVD. SEWER EXTENSION</p>										
<p>PROJECT NO. 5059</p>										
<p>DESIGNED BY <i>[Signature]</i> DRAWN BY <i>[Signature]</i></p>	<p><i>[Signature]</i> 6-25-64</p>									

BENCHMARK "X" Mark on Hydrant on S'ly side of Indiana Ave, 460' E. of Van Buren Blvd
Elev: 820.52 F.B. 6/1/51

S-539
1 2

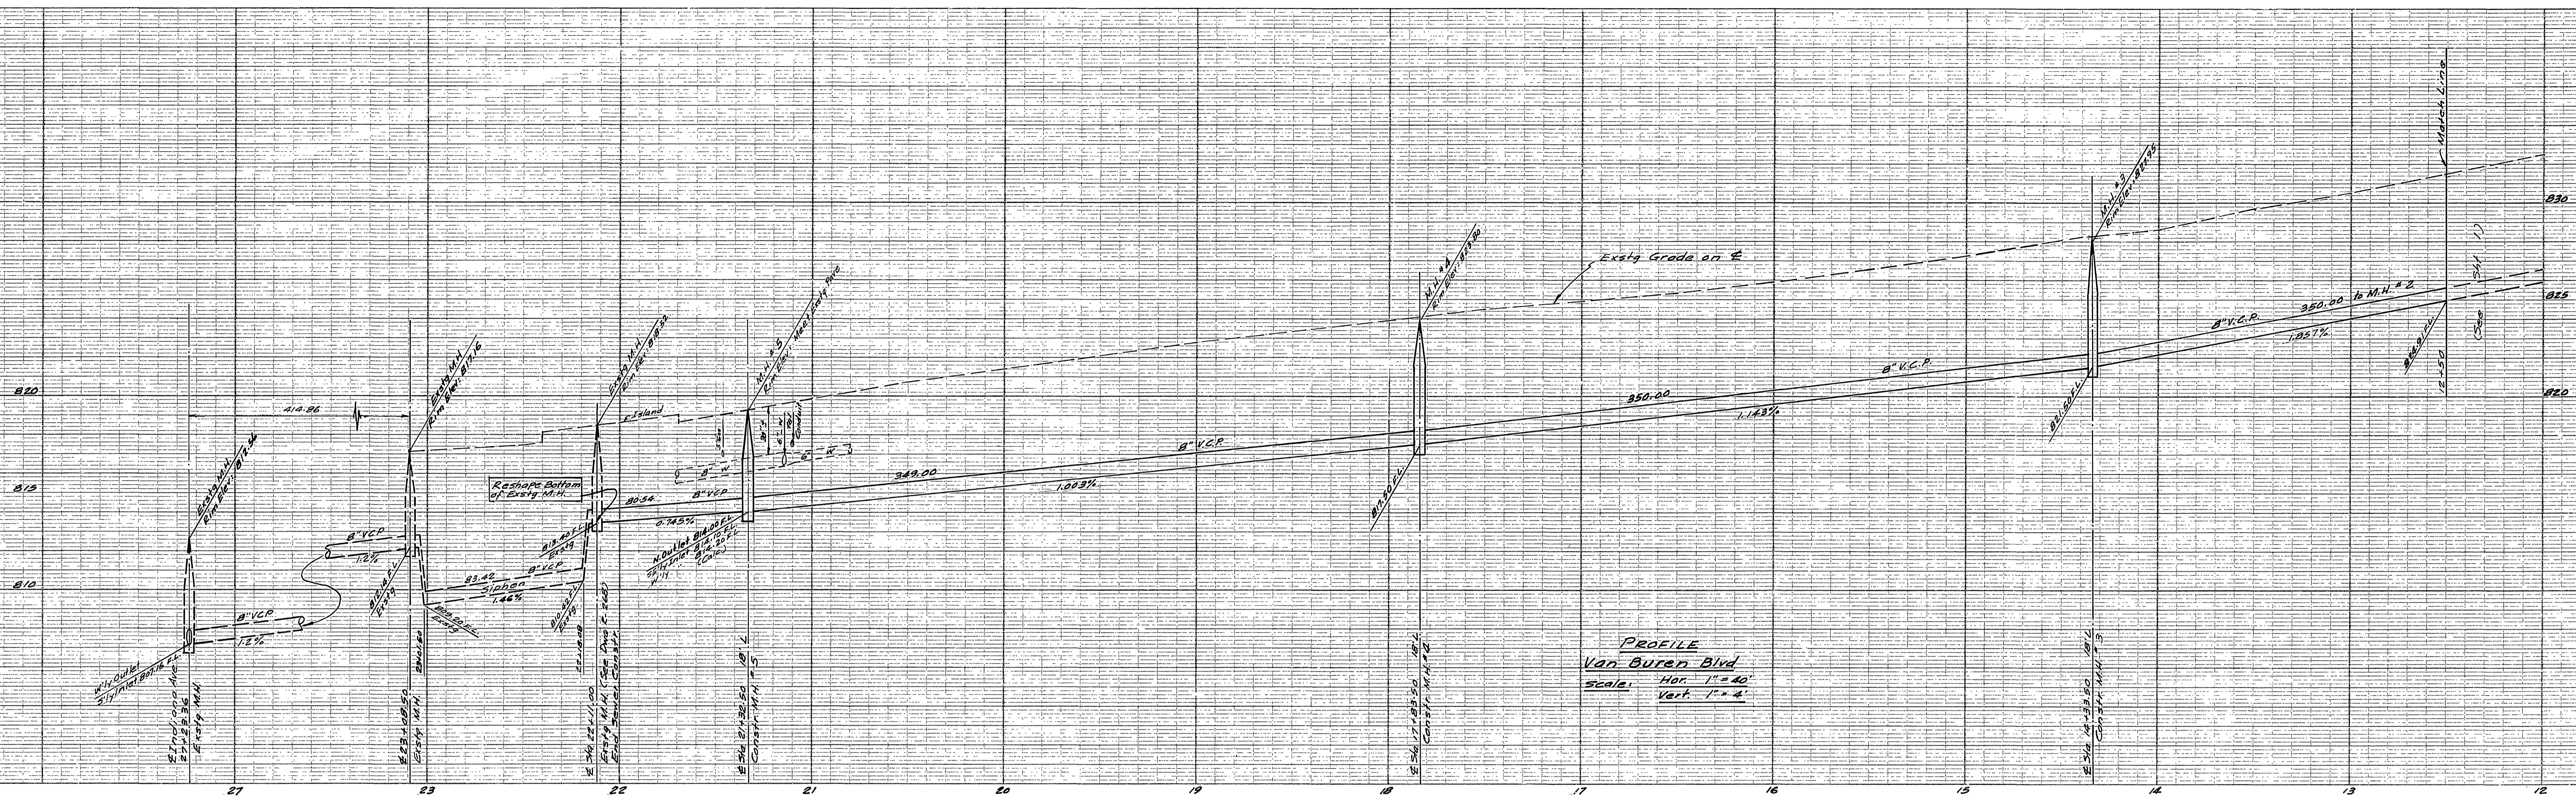

PROFILE
Van Buren Blvd
Scale: Hor. 1" = 40'
Vert. 1" = 4'

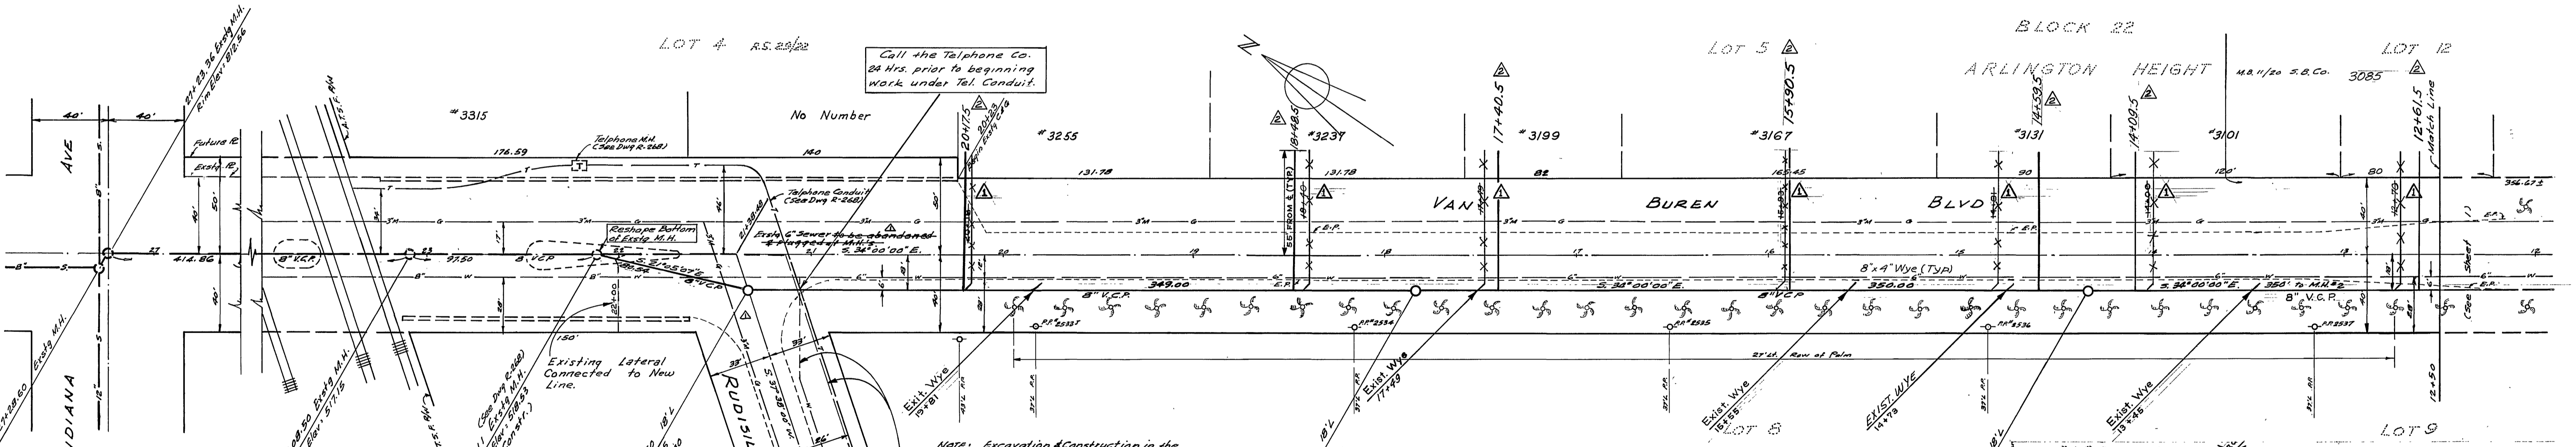

PLAN
Scale: 1" = 40'

- NOTE**
Laterals to be Constructed as Part of Van Buren Widening Project 3073; See Drawing R-889
- Const. Laterals At:
- Sta. 12+70 : Sta. 55+21 on R-889
 - Sta. 14+00 : Sta. 56+51 do
 - Sta. 14+81 : Sta. 57+32 do
 - Sta. 15+93 : Sta. 58+44 do
 - Sta. 17+49 : Sta. 60+00 do
 - Sta. 18+40 : Sta. 60+91 do
 - Sta. 20+18 : Sta. 62+69 do

BENCH MARK: "X" Mark on Hydrant on S 1/2 side of Indiana Ave. 460' E. of Van Buren Blvd Elev. 820.52 F.B. 6/17/51

BLOCK 22
"THIS DRAWING ISSUED FOR LATERAL CONSTRUCTION ONLY."

APPROVED *Hugh M. Gallaher*
IRRIGATION DIVISION
Date 6-2-64

HUGH M. GALLAHER
Civil Engineer
Riverside California
Approved by *John M. Cook*
R.C.E. 14293 Date 4-23-64

CITY OF RIVERSIDE
DEPARTMENT OF PUBLIC WORKS

DESCRIPTION
10-28-64 As Built and Added Laterals. Ref. Drawing R-889
3-2-66 AS BUILT LATERALS HR RCH GSE

VAN BUREN BLVD.
SEWER EXTENSION

PROJECT NO. 5059

S-539

SD
RCH
W&S
6-25-64