

TYPICAL SECTION
IN ROCK EXCAVATION
SCALE: 1"=1'-0"

All Construction shall be in accordance with Standards and Specifications No. 461 of the City of Riverside Department of Public Works. Pipe shall be bedded per Case 1, Standard Drawing No. 452.

It shall be the responsibility of the contractor to clear the Right of Way in accordance with the provisions of law as it affects such utility including irrigation lines and appurtenances, and at no extra cost to the City of Riverside.

BENCH MARK: 8\"/>

REVISIONS		
MARK	DATE	DESCRIPTION
1	7-64	Revision of Sewer Align & Grade per W.B. [Signature]

J. F. DAVIDSON - CIVIL ENGINEER
R.E. NO. 862
RIVERSIDE, CALIFORNIA
APPROVED BY: [Signature] DATE: 4-1-64







CITY OF RIVERSIDE, CALIFORNIA
DEPARTMENT OF PUBLIC WORKS

SEWER PLAN & PROFILE

1"=40' 1"=8'
HORIZ. SCALE VERT. SCALE

DESIGNED BY: CHECKED BY: APPROVED BY: [Signature]
DRAWN BY: RECOMMENDED BY: Director of Public Works
DATE: ASSISTANT CITY ENGINEER: DATE: SHEET 2 OF 2

NO. 5-541

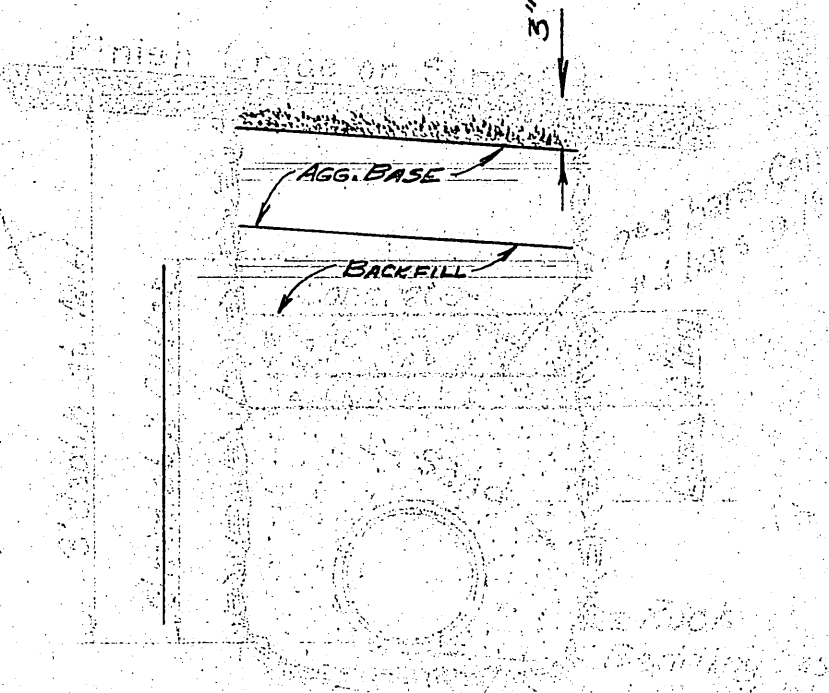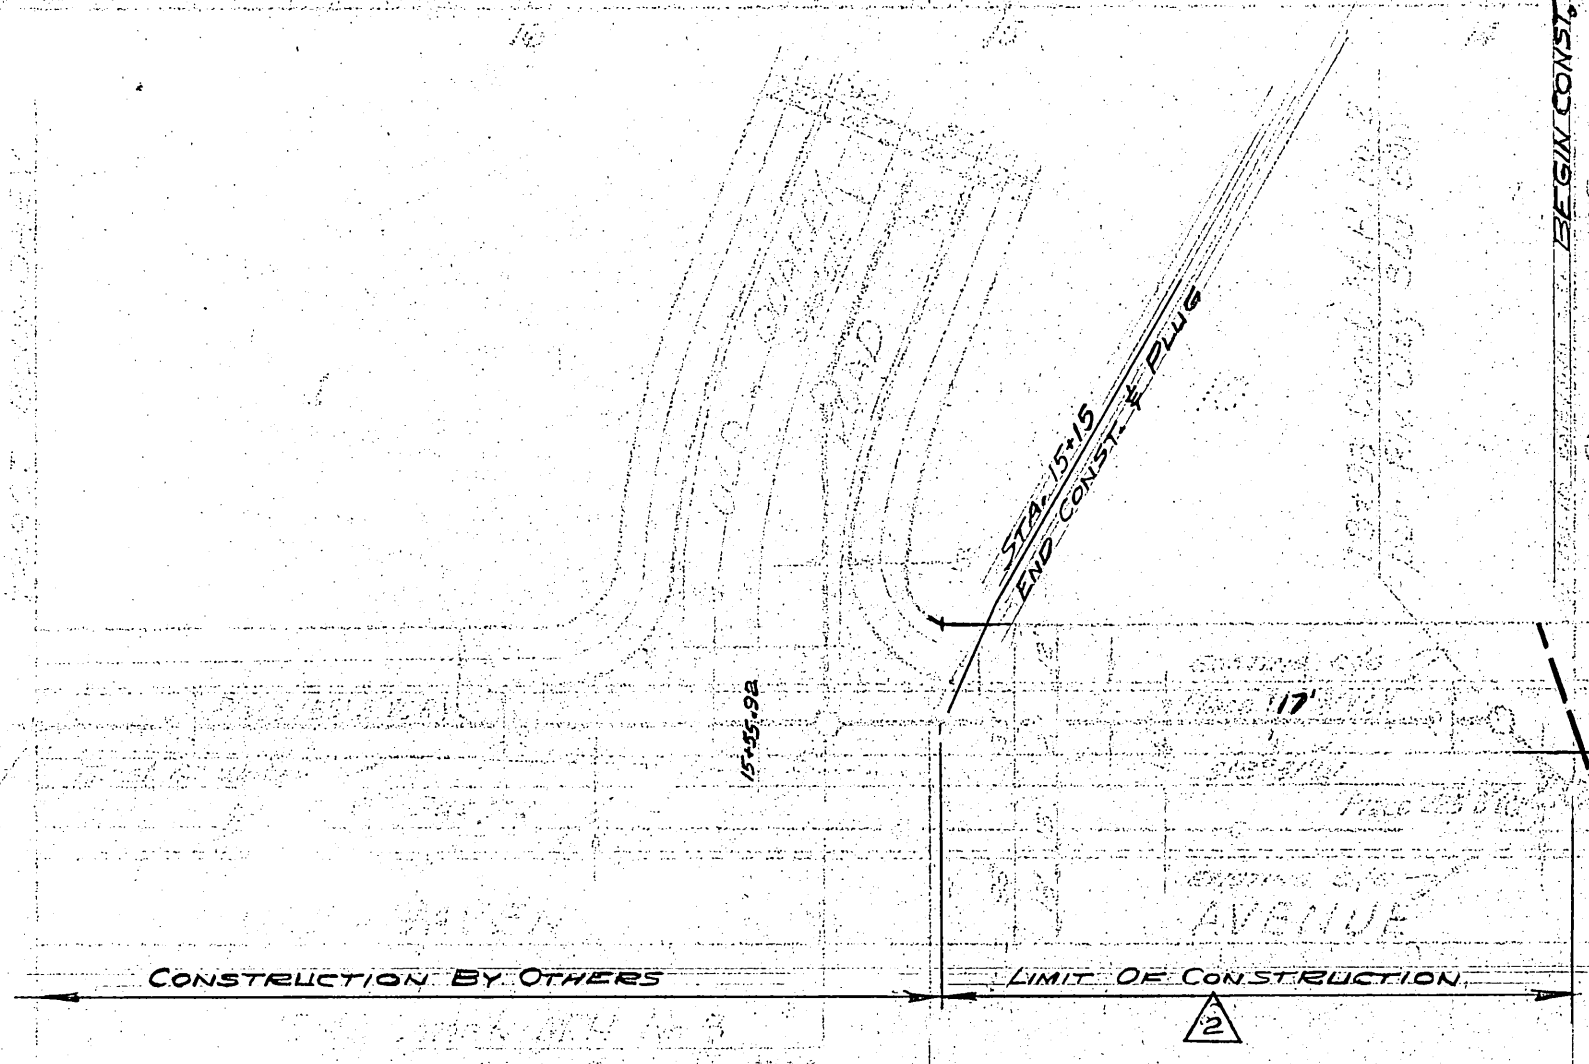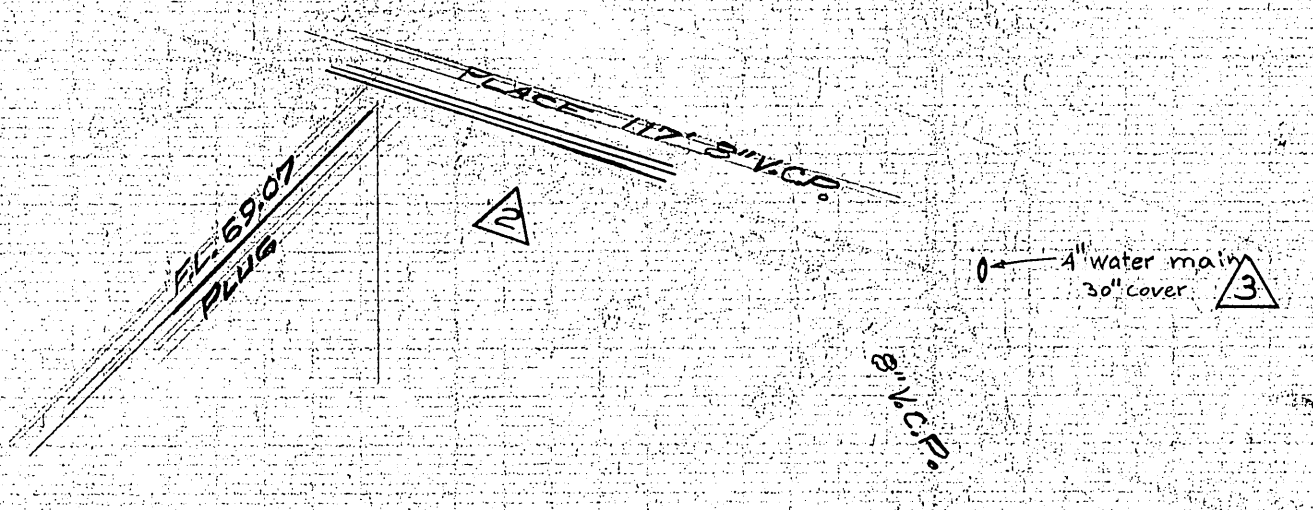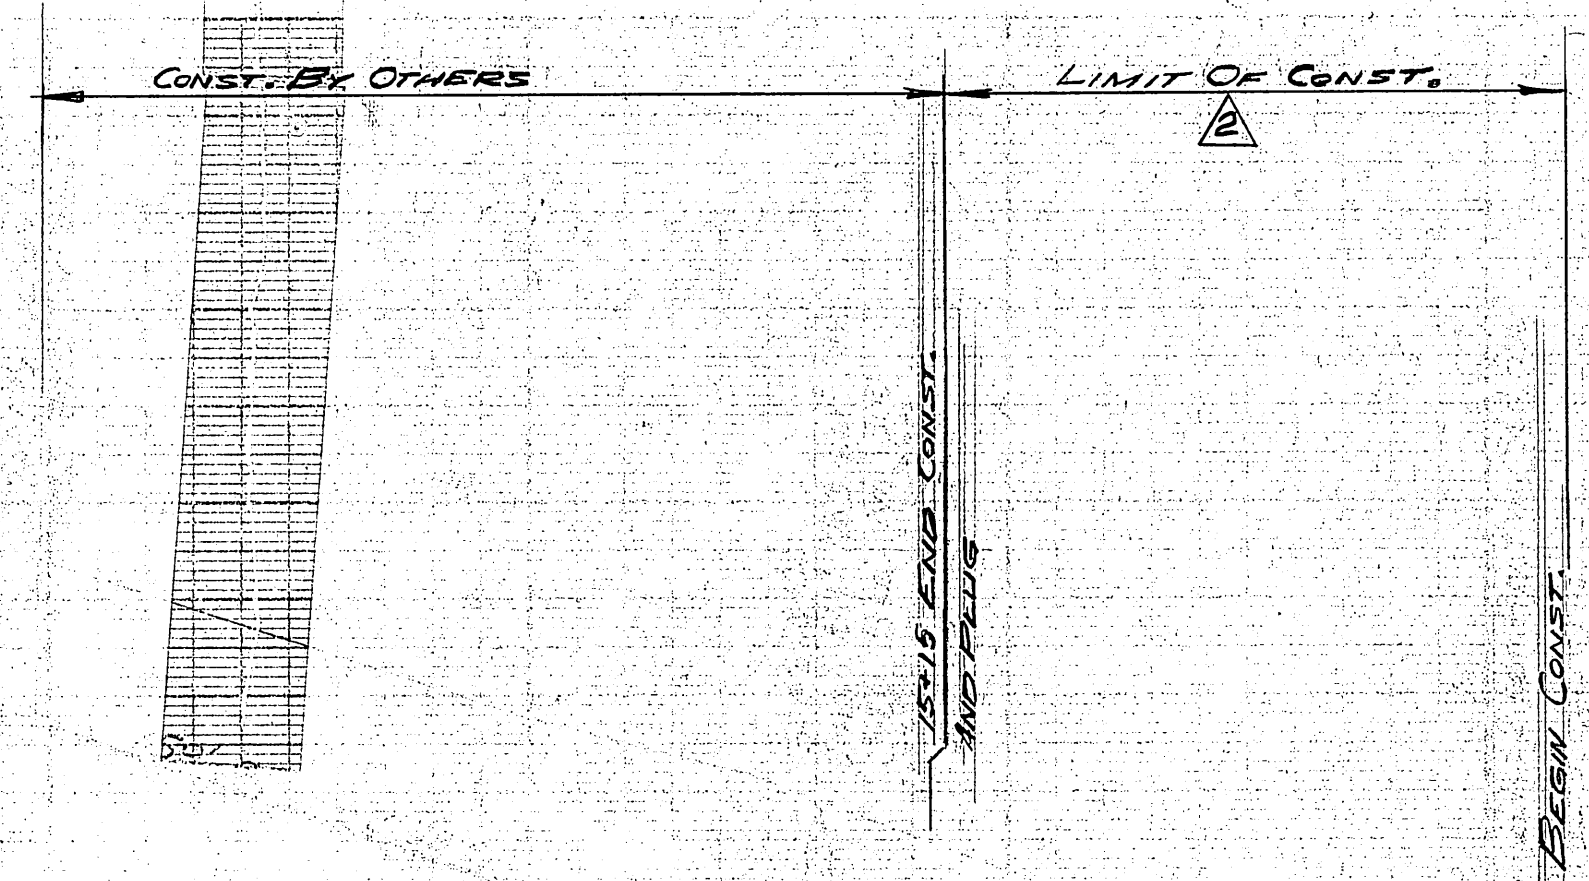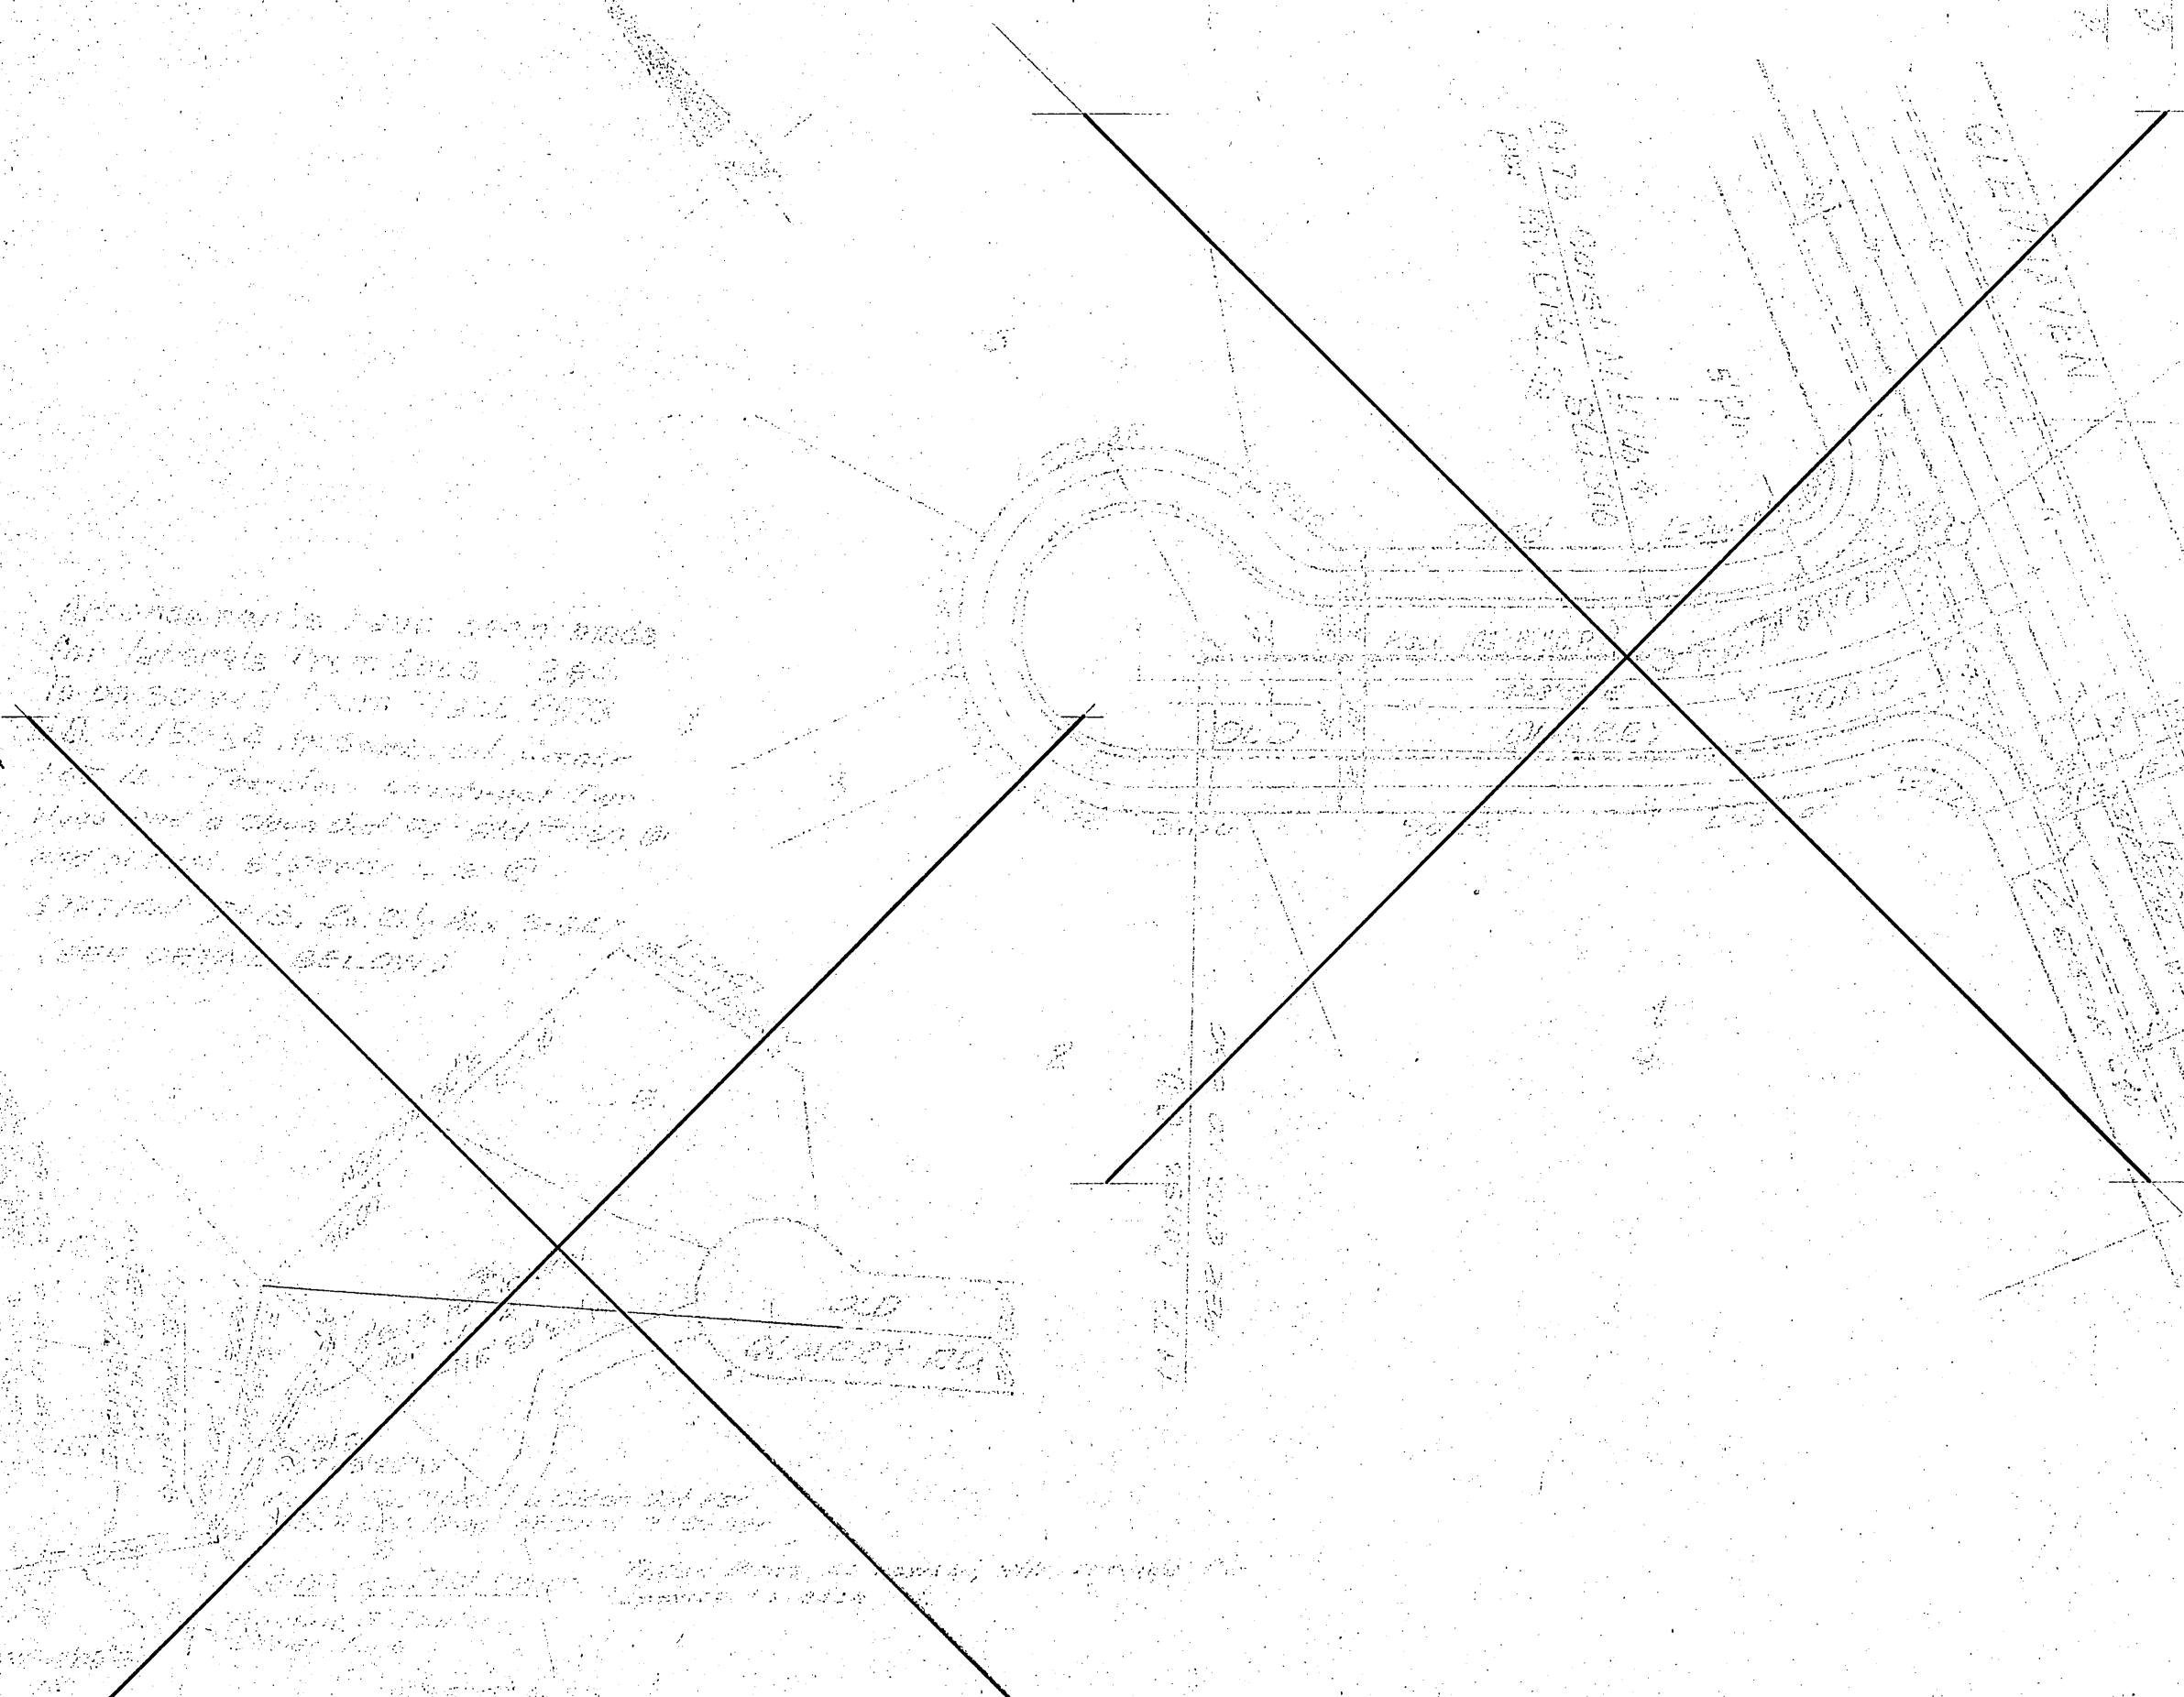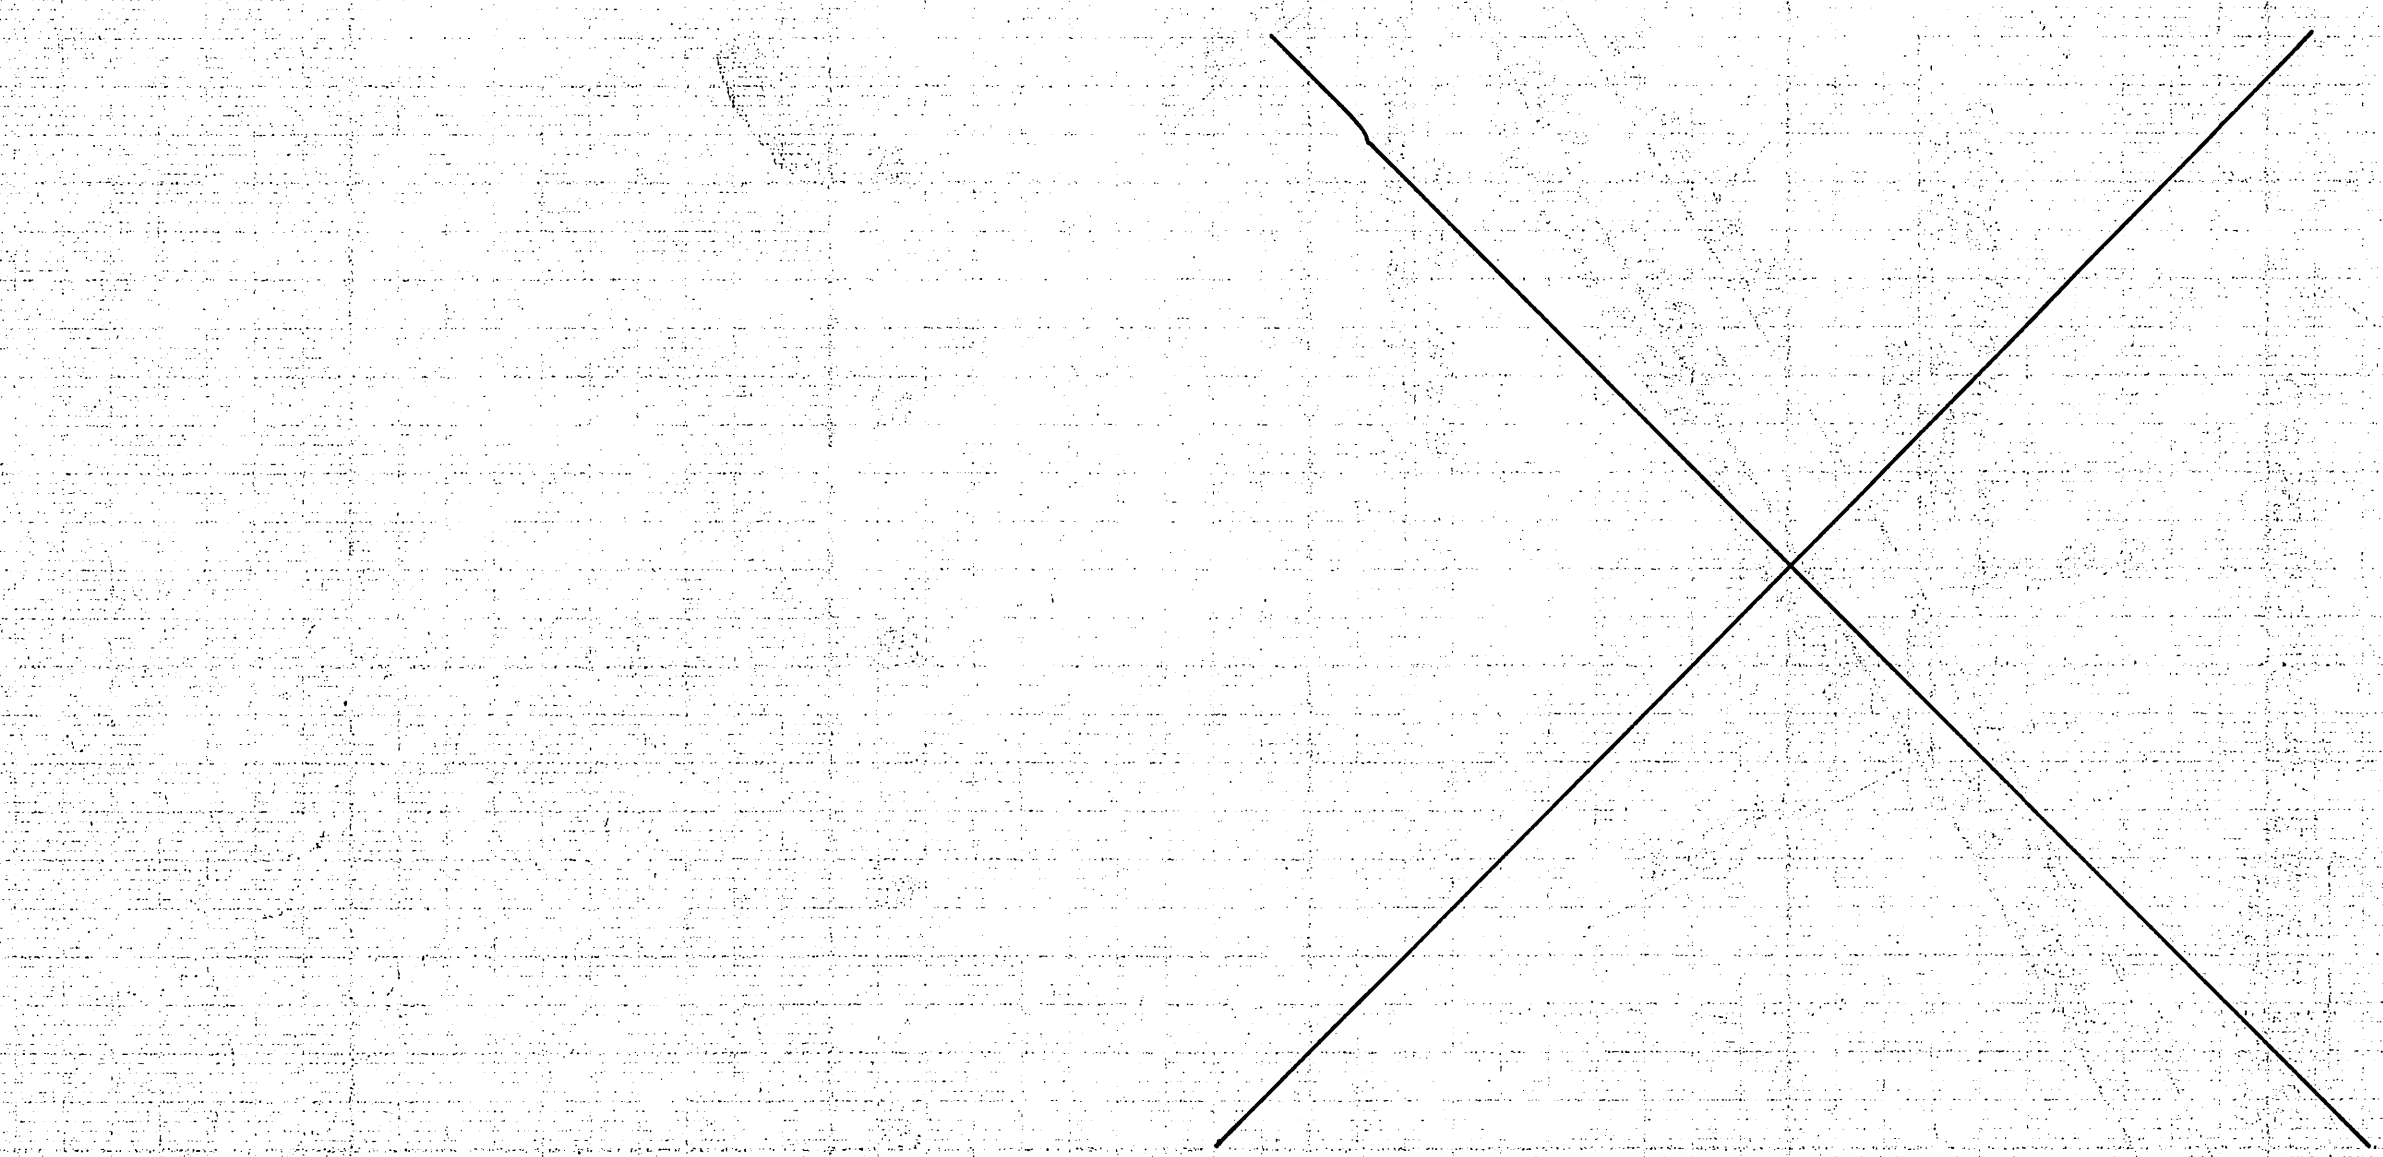

1. ...
2. responsibility
3. ...
4. ...

TRACT 2904
SEWER EXTENSION
GLENHAVEN - NLY OF OLD QUARRY RD
Act. 5066
APPROVED BY
William D. Gardner
8-20-64
5-541-A
1 of 1