


BENCH MARKS:
 P.K. nail in N.E. curb
 return at Sugarloaf
 Dr. & Massachusetts
 Ave. per City P.B. 57,
 page 30. Elev. = 1098.04.
 Lead and Tack on center
 of curb return S.W.
 corner of Massachu-
 setts Ave. & Flanders
 Road. Elev. = 1191.39

SCALE
 HORIZ. 1" = 50'
 VERT. 1" = 10'


- GENERAL NOTES:**
1. Construction shall be in accordance with the City of Riverside, Department of Public Works, Standard Specifications No. 461 and Standard Drawings.
 2. It shall be the responsibility of the contractor to clear the right of way in accordance with the provisions of law as it affects each utility including irrigation lines and appurtenances and at no cost to the City.
 3. Joints in vitrified clay pipe sewers shall conform to ASTM Standard C-425-60I, or the latest revisions thereof.
 4. Pipe shall be bedded per Case II, Std. Dwg. No. 452, unless otherwise specified on plan.
 5. Location of wyes and laterals to be determined in the field.

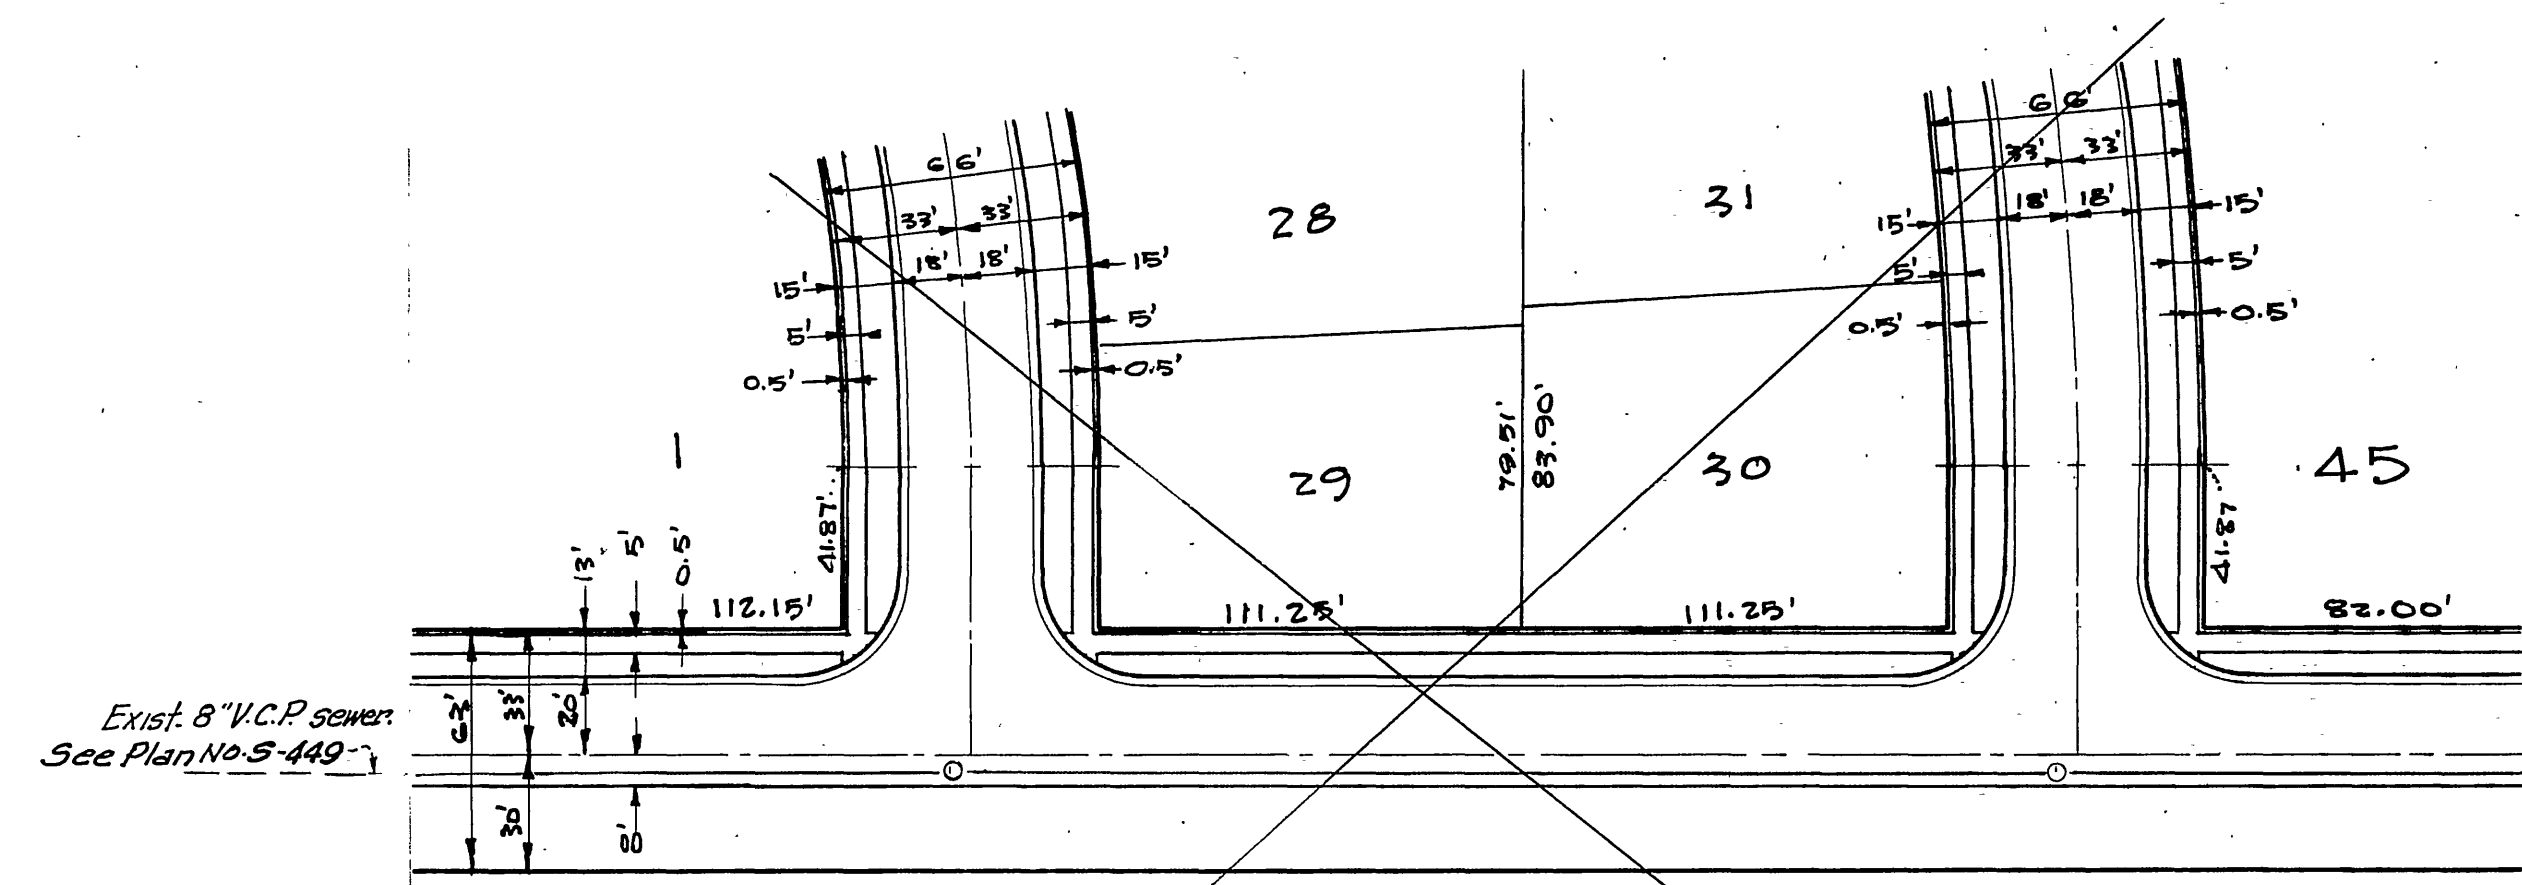

SCALE
 1" = 50'



WALDORF DRIVE

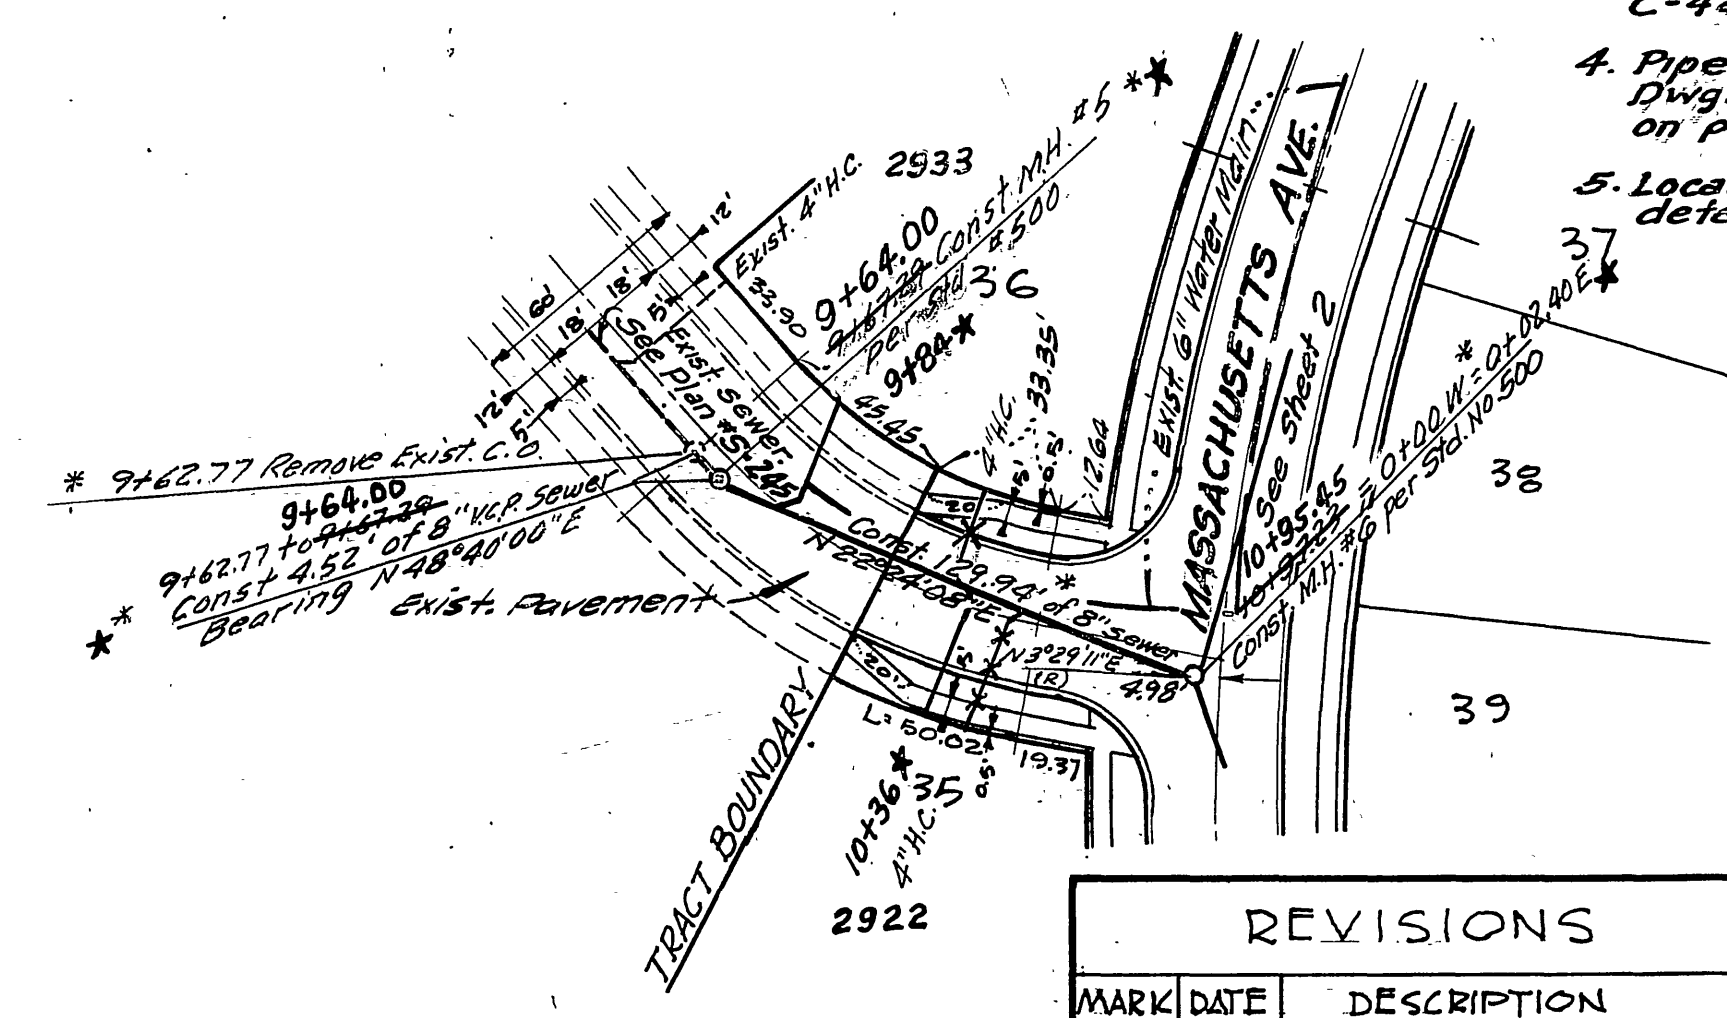

INDEXED HD J.O.120
CRAWLEY & HAWKINS
 SURVEYORS AND ENGINEERS
 RIVERSIDE, CALIFORNIA
 Approved *George O. Crawley* Field by *GO*
 U.C.E. No. 9455 Date *2-3-64*


REVISIONS		CITY OF RIVERSIDE, CALIFORNIA DEPARTMENT OF PUBLIC WORKS
MARK	DATE	
*	11-3-64	Revised Sewer - Waldorf Dr. & Massachusetts Ave. 11/1/64 George O. Crawley

DESIGNED BY	CHECKED BY	APPROVED BY	S-542
DRAWN BY	BY	DIRECTOR OF PUBLIC WORKS	
RECOMMENDED BY	BY	ASSISTANT CITY ENGINEER	DATE 10-1-64


* AS BUILT 2-10-65 H.B.

PROFILE	SURVEYED	BY	DATE
NOTE BOOK	PLOTTED		
	FIELD CHECKED		
	B.M. NOTED		
	STRUCTURE LOCATIONS CHKD		



PLAN	SURVEYED	BY	DATE
NOTE BOOK	PLOTTED		
	FIELD CHECKED		
	BY		

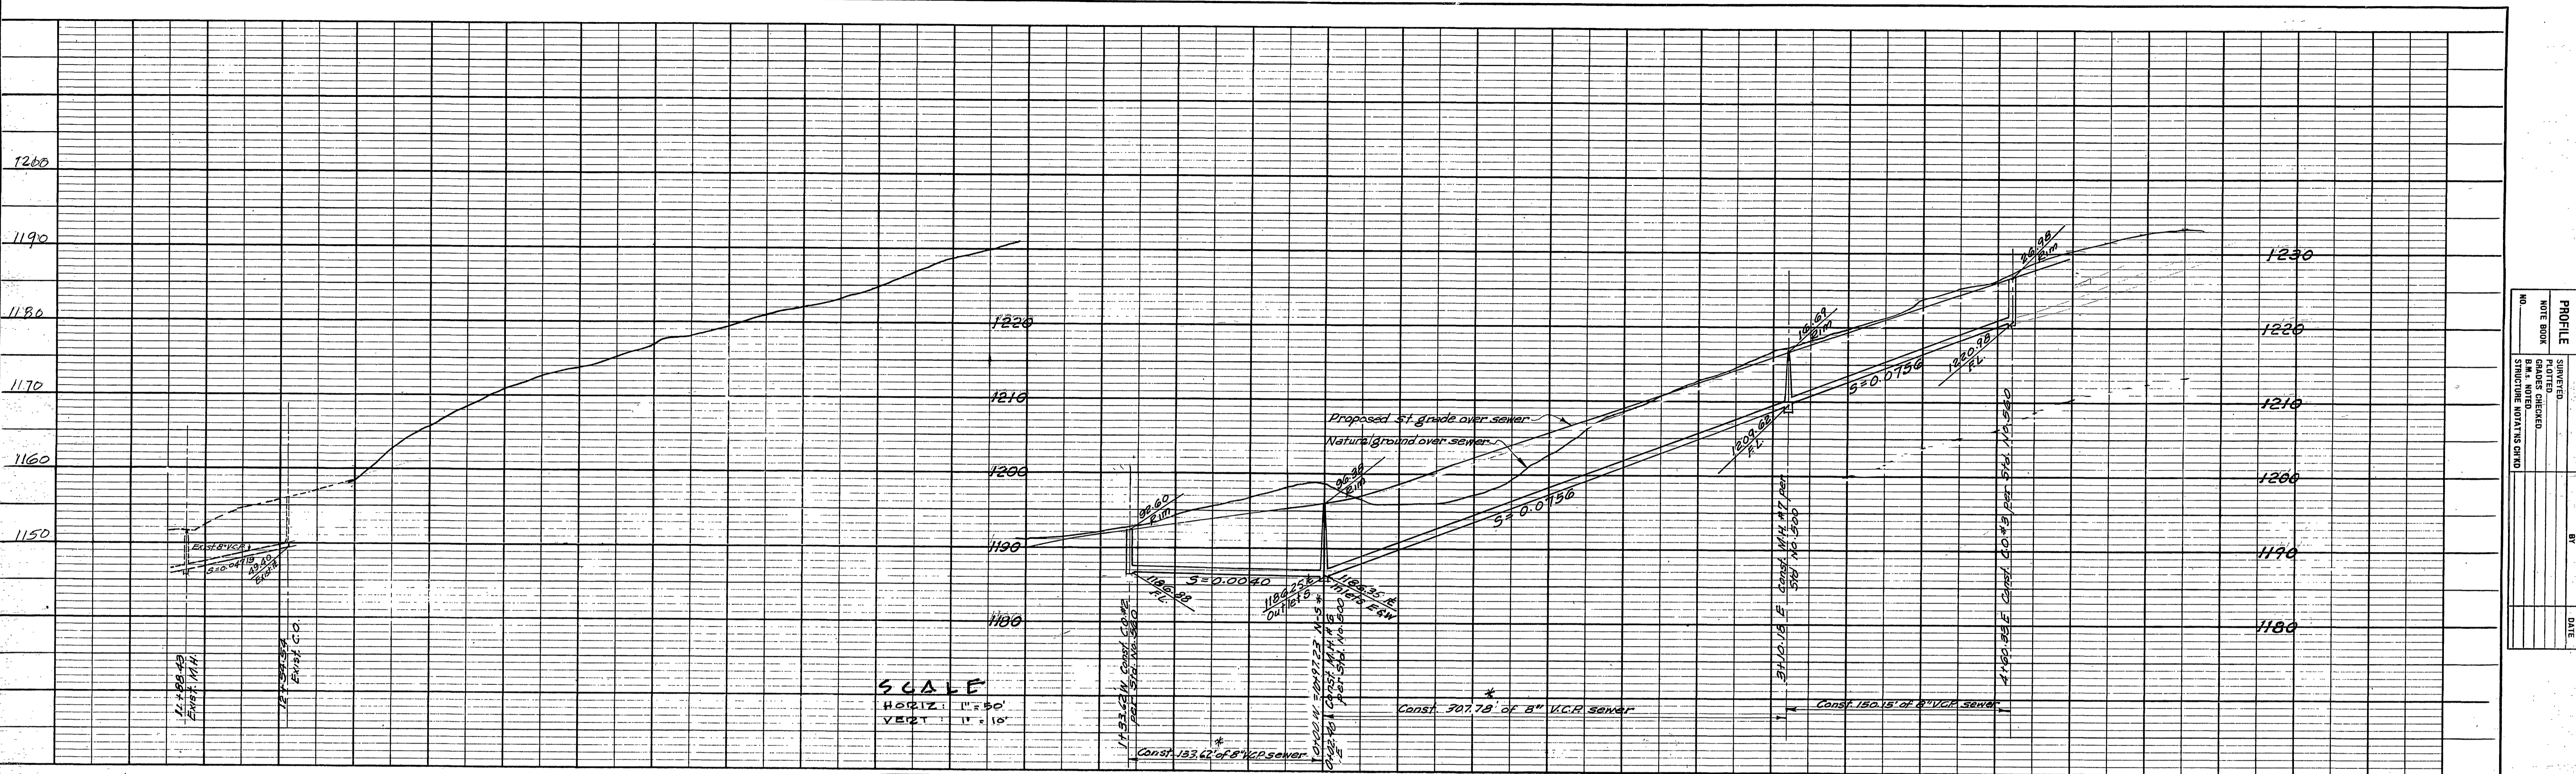

PROFILE	DATE
NO. 1	
NO. 2	
NO. 3	
NO. 100	

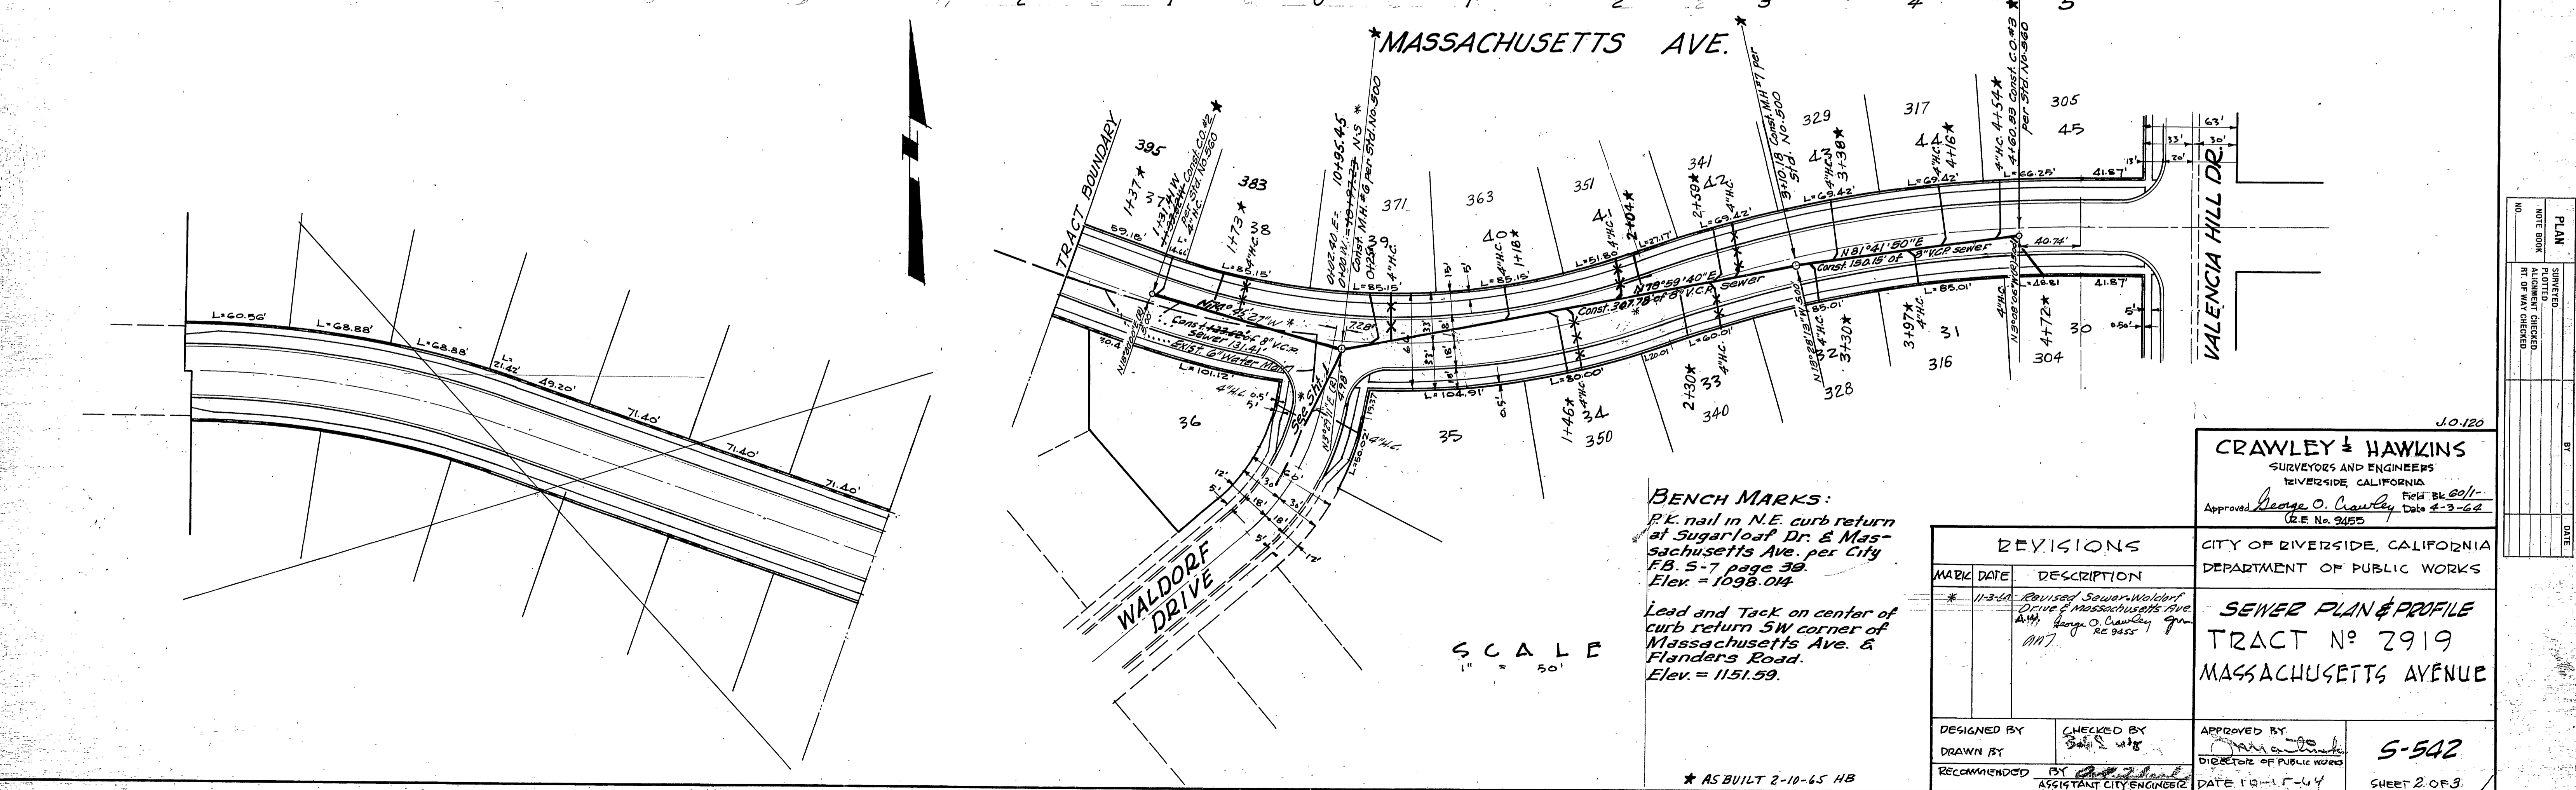

PLAN	DATE
NO. 1	
NO. 2	
NO. 3	
NO. 100	

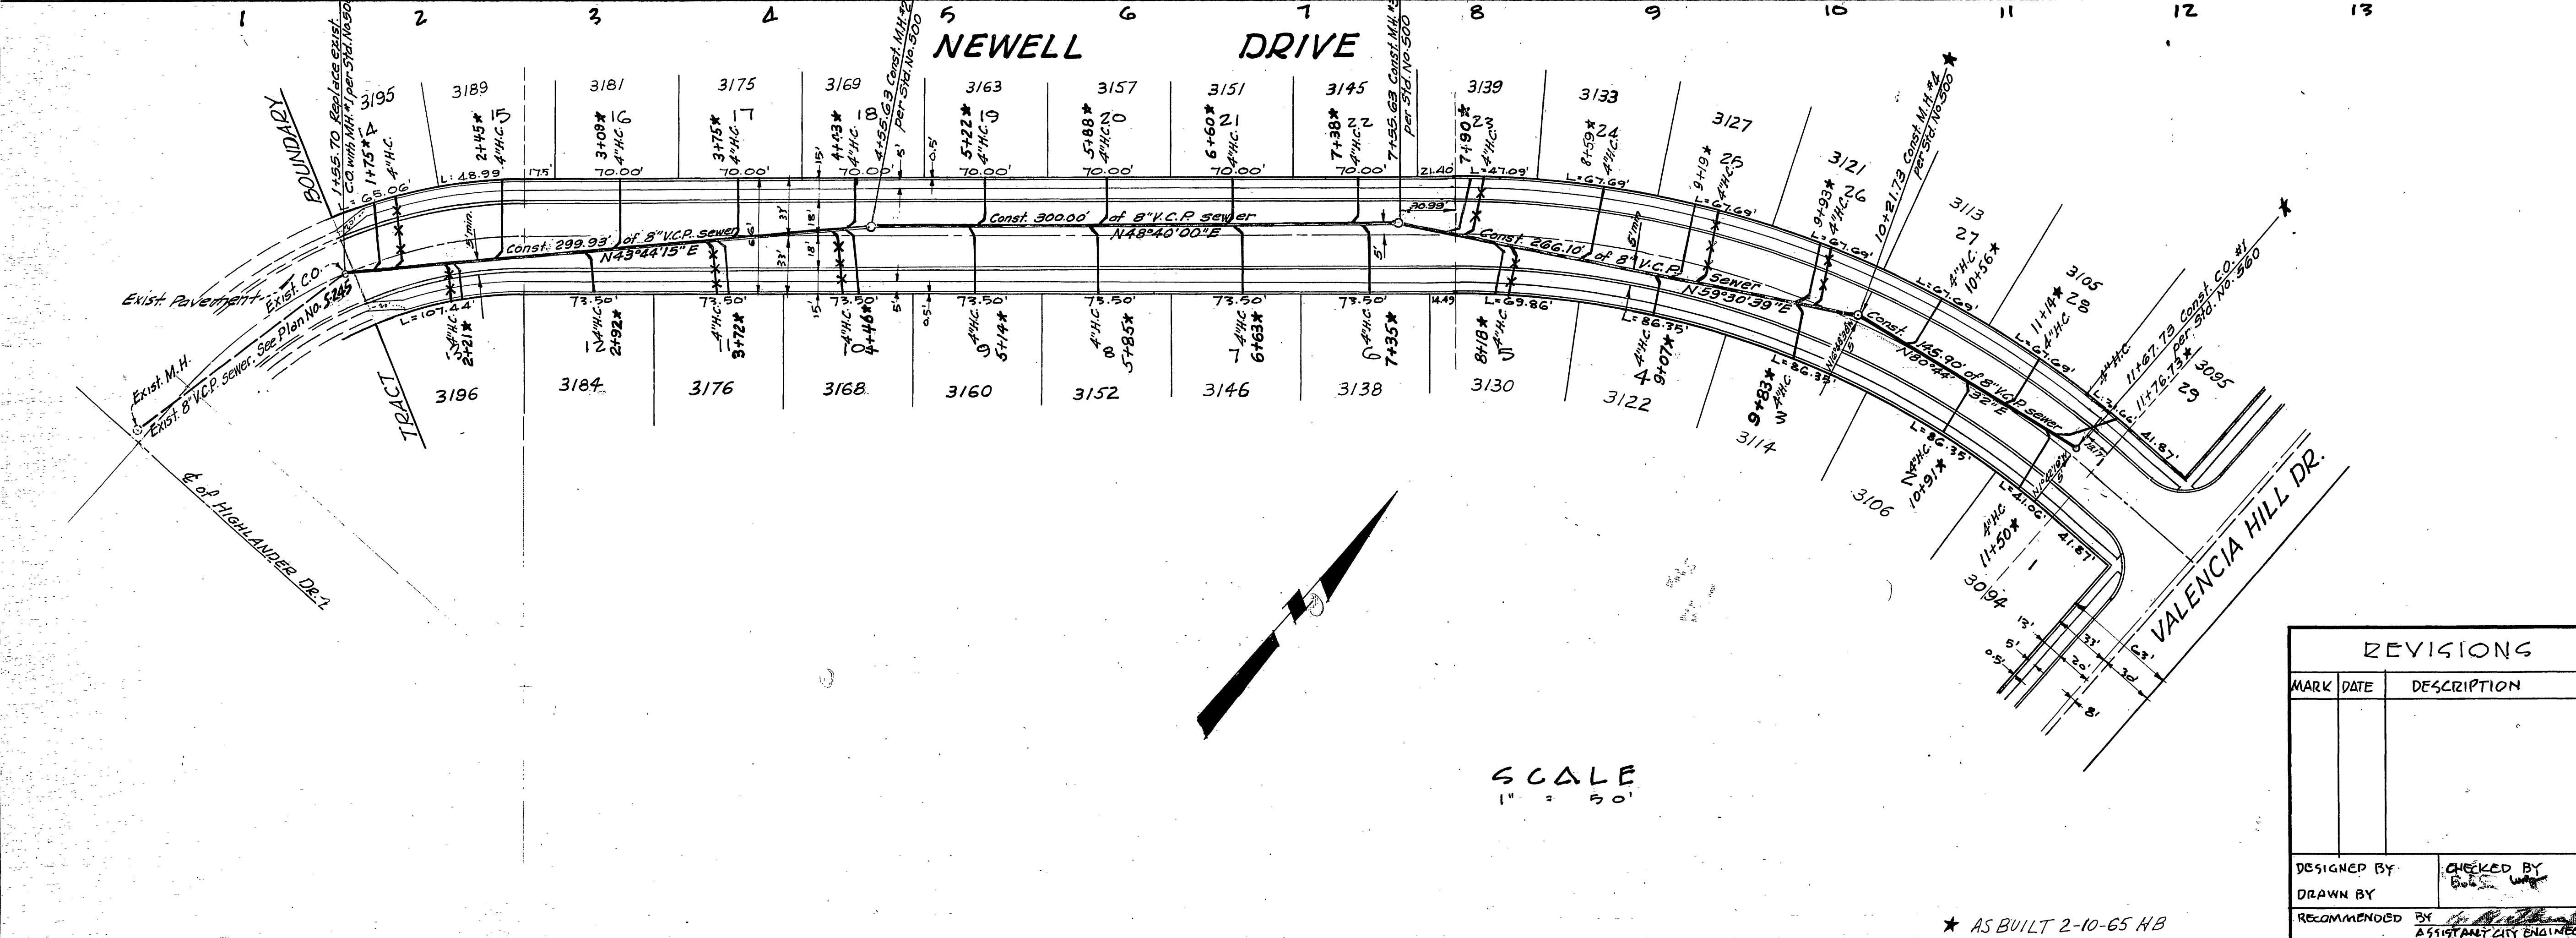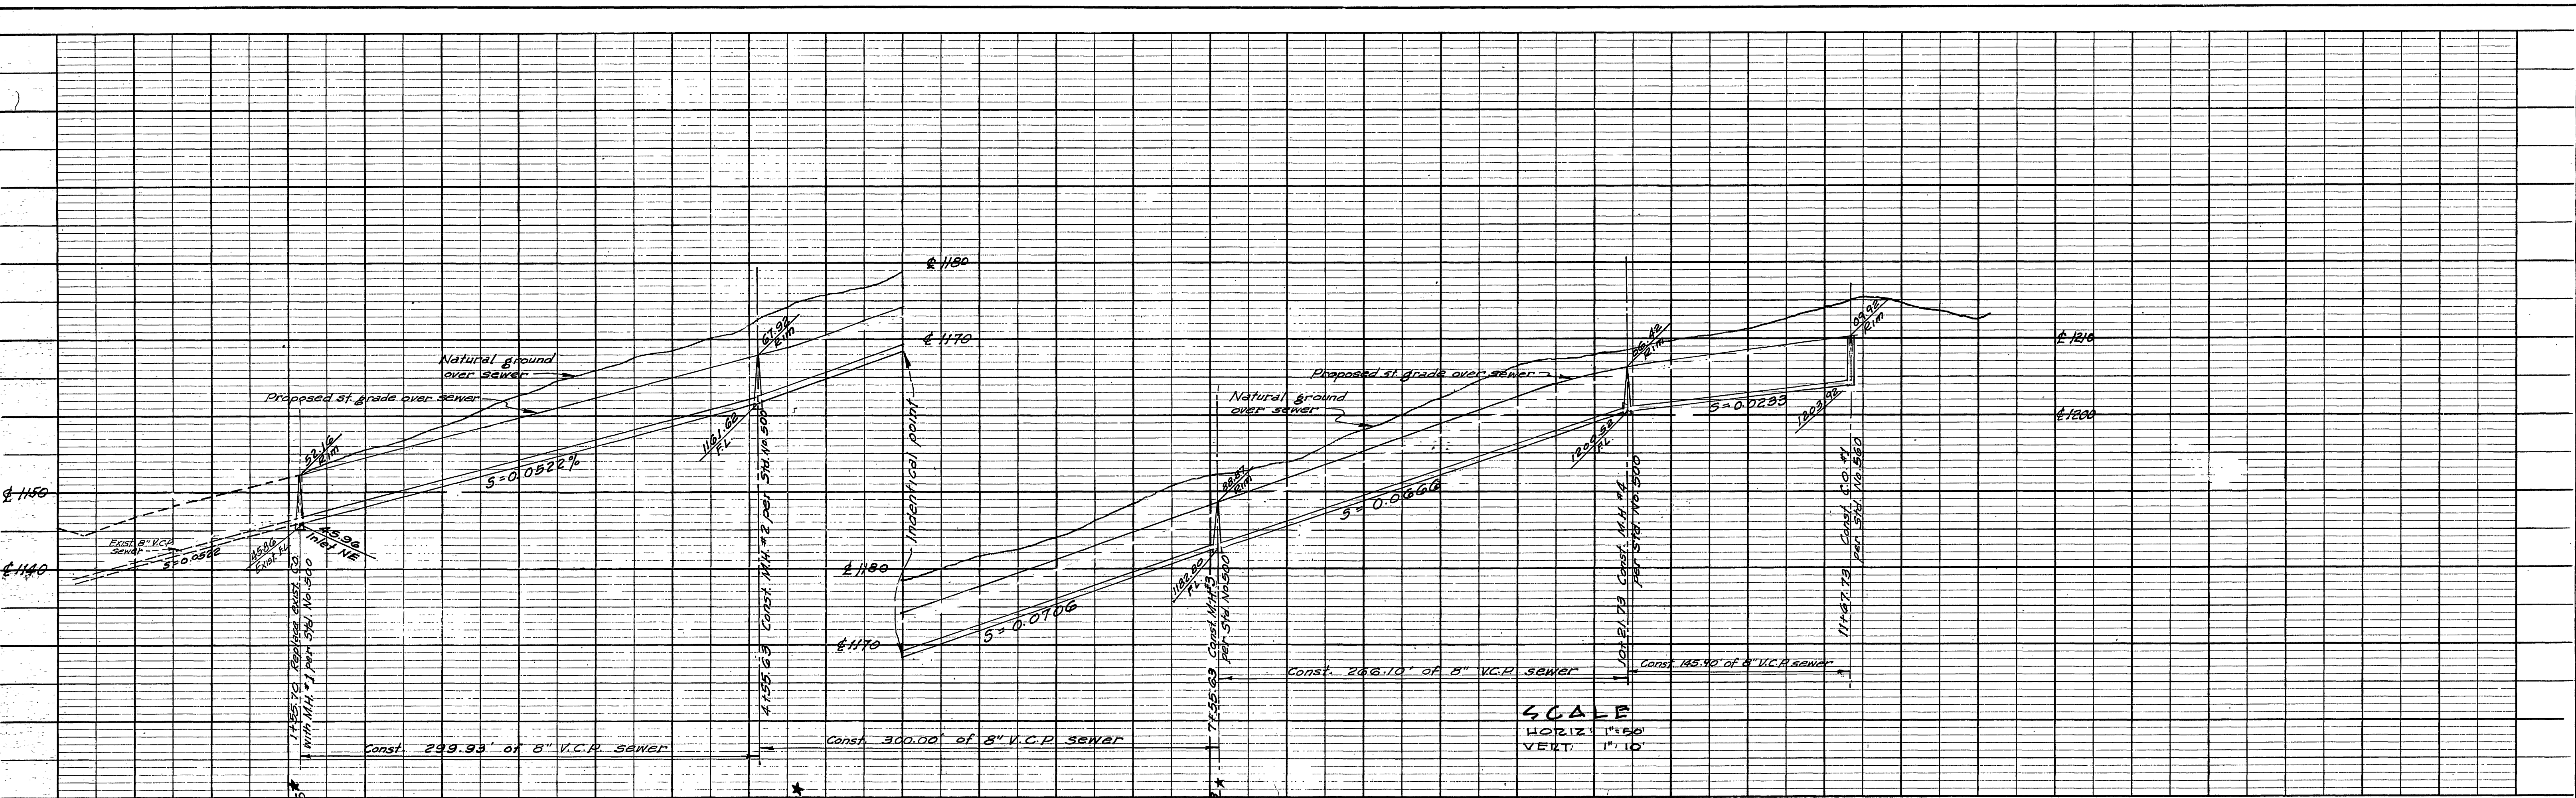

BENCH MARKS:
 P.K. nail in N.E. curb return at
 Sugarloaf Dr. & Massachusetts
 Ave. per City F.B. 3-7 page 38
 Elev. = 1098.014
 Lead and Tack on center of
 curb return S.W. corner at
 Massachusetts Ave. & Flanders
 Road. Elev. = 1151.59.

J.O.120
CRAWLEY & HAWKINS
 SURVEYORS AND ENGINEERS
 RIVERSIDE, CALIFORNIA
 Approved *George O. Crawley* Field Bk. 60
 (P.E. No. 9455) Date 2-3-62

REVISIONS		CITY OF RIVERSIDE, CALIFORNIA DEPARTMENT OF PUBLIC WORKS
MARK	DATE	
DESIGNED BY	CHECKED BY	APPROVED BY
DRAWN BY	<i>G.O.C.</i>	<i>[Signature]</i>
RECOMMENDED BY	<i>[Signature]</i>	DIRECTOR OF PUBLIC WORKS
		DATE 10-12-62

SEWER PLAN & PROFILE
TRACT NO 2919
NEWELL DRIVE

S-542

★ AS BUILT 2-10-65 HB

PROFILE	DATE
SURVEYED	
PLOTTED	
FRAMES CHECKED	
STRUCTURE LOCATIONS CHKD	

PLAN	DATE
SURVEYED	
PLOTTED	
FRAMES CHECKED	
STRUCTURE LOCATIONS CHKD	