


B.M. P.K. NAIL IN LEAD IN CURB OF S.E. CURB
RETURN ON JANE ST. INDIANA AVE. ELEV. 865.875
B.M. P.K. NAIL IN LEAD IN CURB OF S.W. CURB
RETURN ON BARBARA CT. INDIANA AVE. ELEV. 867.577

SCALE: HORIZ. 1" = 50'
VERT. 1" = 5'

F.B. 5-7 49-59

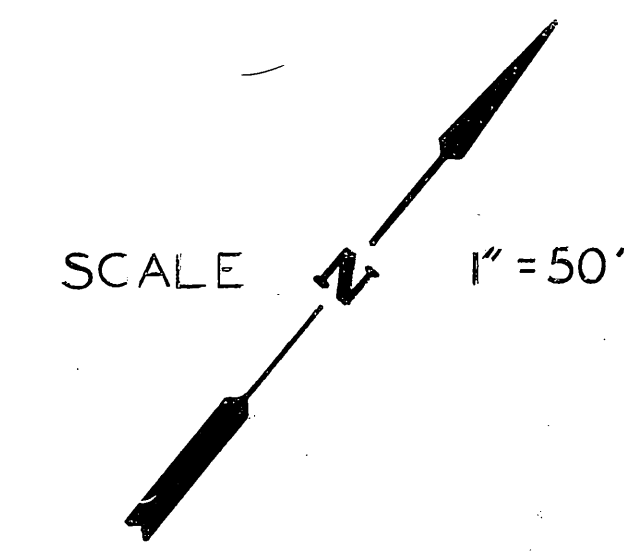

- NOTES
- SEWER LATERALS TO BE LOCATED IN THE FIELD, EXCEPT LATERALS ON THE NORTHERLY SIDE OF INDIANA AVE.
 - THE UPSTREAM END OF THE JANE STREET SEWER SHALL BE LENGTHENED OR SHORTENED AS REQUIRED SO THAT THE LATERAL FOR LOT 20 MAKES A RIGHT ANGLE WITH THE MAIN SEWER.
 - PROVIDE AS LITTLE CLEARANCE AS POSSIBLE FOR THE JANE ST. SEWER WHICH UNDER-CROSSING THE 30" WATER MAIN.
 - PRIVATE DEVELOPER SHALL ABANDON MANHOLES, LATERALS, AND 8" V.C.P. SEWER IN BARBARA COURT AND LAGUNA COURT, INSTALLING STD. 560 CLEANOUT INSIDE CITY R/W. REMOVE MANHOLE FRAMES & COVER AND DELIVER TO CITY YARD. REMOVE MANHOLE RISER RINGS TO DEPTH OF 18" BELOW FINISH GRADE - MINIMUM. SEAL PIPE INLET WITH BRICK & MORTAR, FILL MANHOLE SOLID WITH SAND, AND FLOOD THOROUGHLY FOR COMPACTION.

REVISIONS			CITY OF RIVERSIDE, CALIFORNIA DEPARTMENT OF PUBLIC WORKS	
MARK	DATE	DESCRIPTION		
Δ	2/7/86	ABANDON SEWER IN BARBARA CT. & LAGUNA CT. RE VAC-6-856 BY J.N. DELBOS & ASSOC., P.C. 6/19/65 (EXE. 2/30/86)	BARBARA - JANE SANITARY SEWER DISTRICT BARBARA CT. - LAGUNA CT. JANE ST. - INDIANA AVE. TO A.T. & S.F. RR. INDIANA AVE. - JANE ST. TO 800' W'LY PROJ. NO. 6052	
DESIGNED BY	SUBMITTED BY		APPROVED BY J.L.R. DIRECTOR OF PUBLIC WORKS	
DRAWN BY	PARK DEPT. TRAFFIC DIV.			
CHECKED BY	RECOMMENDED BY			
APPROVED BY			DATE	SHEET
 R.M. Rossi PUBLIC SERVICE DIRECTOR			10-20-60	S-560 SHEET 1 OF 1

★ AS BUILT 6-18-65 HB

PROFILE
SURVEYED
PLOTTED
GRADES CHECKED
STATIONED (NOT IN S.O. CH.)

PLAN
SURVEYED
PLOTTED
ALIGNMENT CHECKED
BY (NOT SHOWN)