

PROFILE	DATE
NO. 1	
DATE	

TRACT 2484 QUANTITY ESTIMATE

8" Vitrifed Clay Pipe	767 LF
4" Vitrifed Clay Pipe	623 LF
Manhole Standard No. 500	3 Ea
Cleanout Standard No. 560	1 Ea
4"x8" Wye	16 Ea
Cleanout (4" V.C.P.)	1 Ea

R/S No 909 QUANTITY ESTIMATE


8" Vitrifed Clay Pipe	124 LF
4" Vitrifed Clay Pipe	60 LF
Manhole Standard No. 500	1 Ea
Cleanout Standard No. 560	1 Ea
4"x8" Wye	2 Ea

BENCH MARK: Elev. 821.77, FB 488/48
Chisled 'x' in curb on West side of Sierra Vista Ave. 206' South of Orion St.

GENERAL NOTES:

1. Construction shall be in accordance with the City of Riverside, Department of Public Works, Standard Specifications No. 461 and Standard Drawings.
2. It shall be the responsibility of the contractor to clear the right of way in accordance with the provisions of the law as it affects each utility including irrigation lines and appurtenances and at no cost to the City.
3. Joints in vitrifed clay pipe sewers shall conform to ASTM standard C-425-60T, or the latest revision thereof.
4. Pipe shall be bedded per Case II, Standard Drawing No. 452, unless otherwise specified on plan.
5. Location of wyes and laterals to be determined in the field.

PLAN	DATE
NO. 1	
DATE	

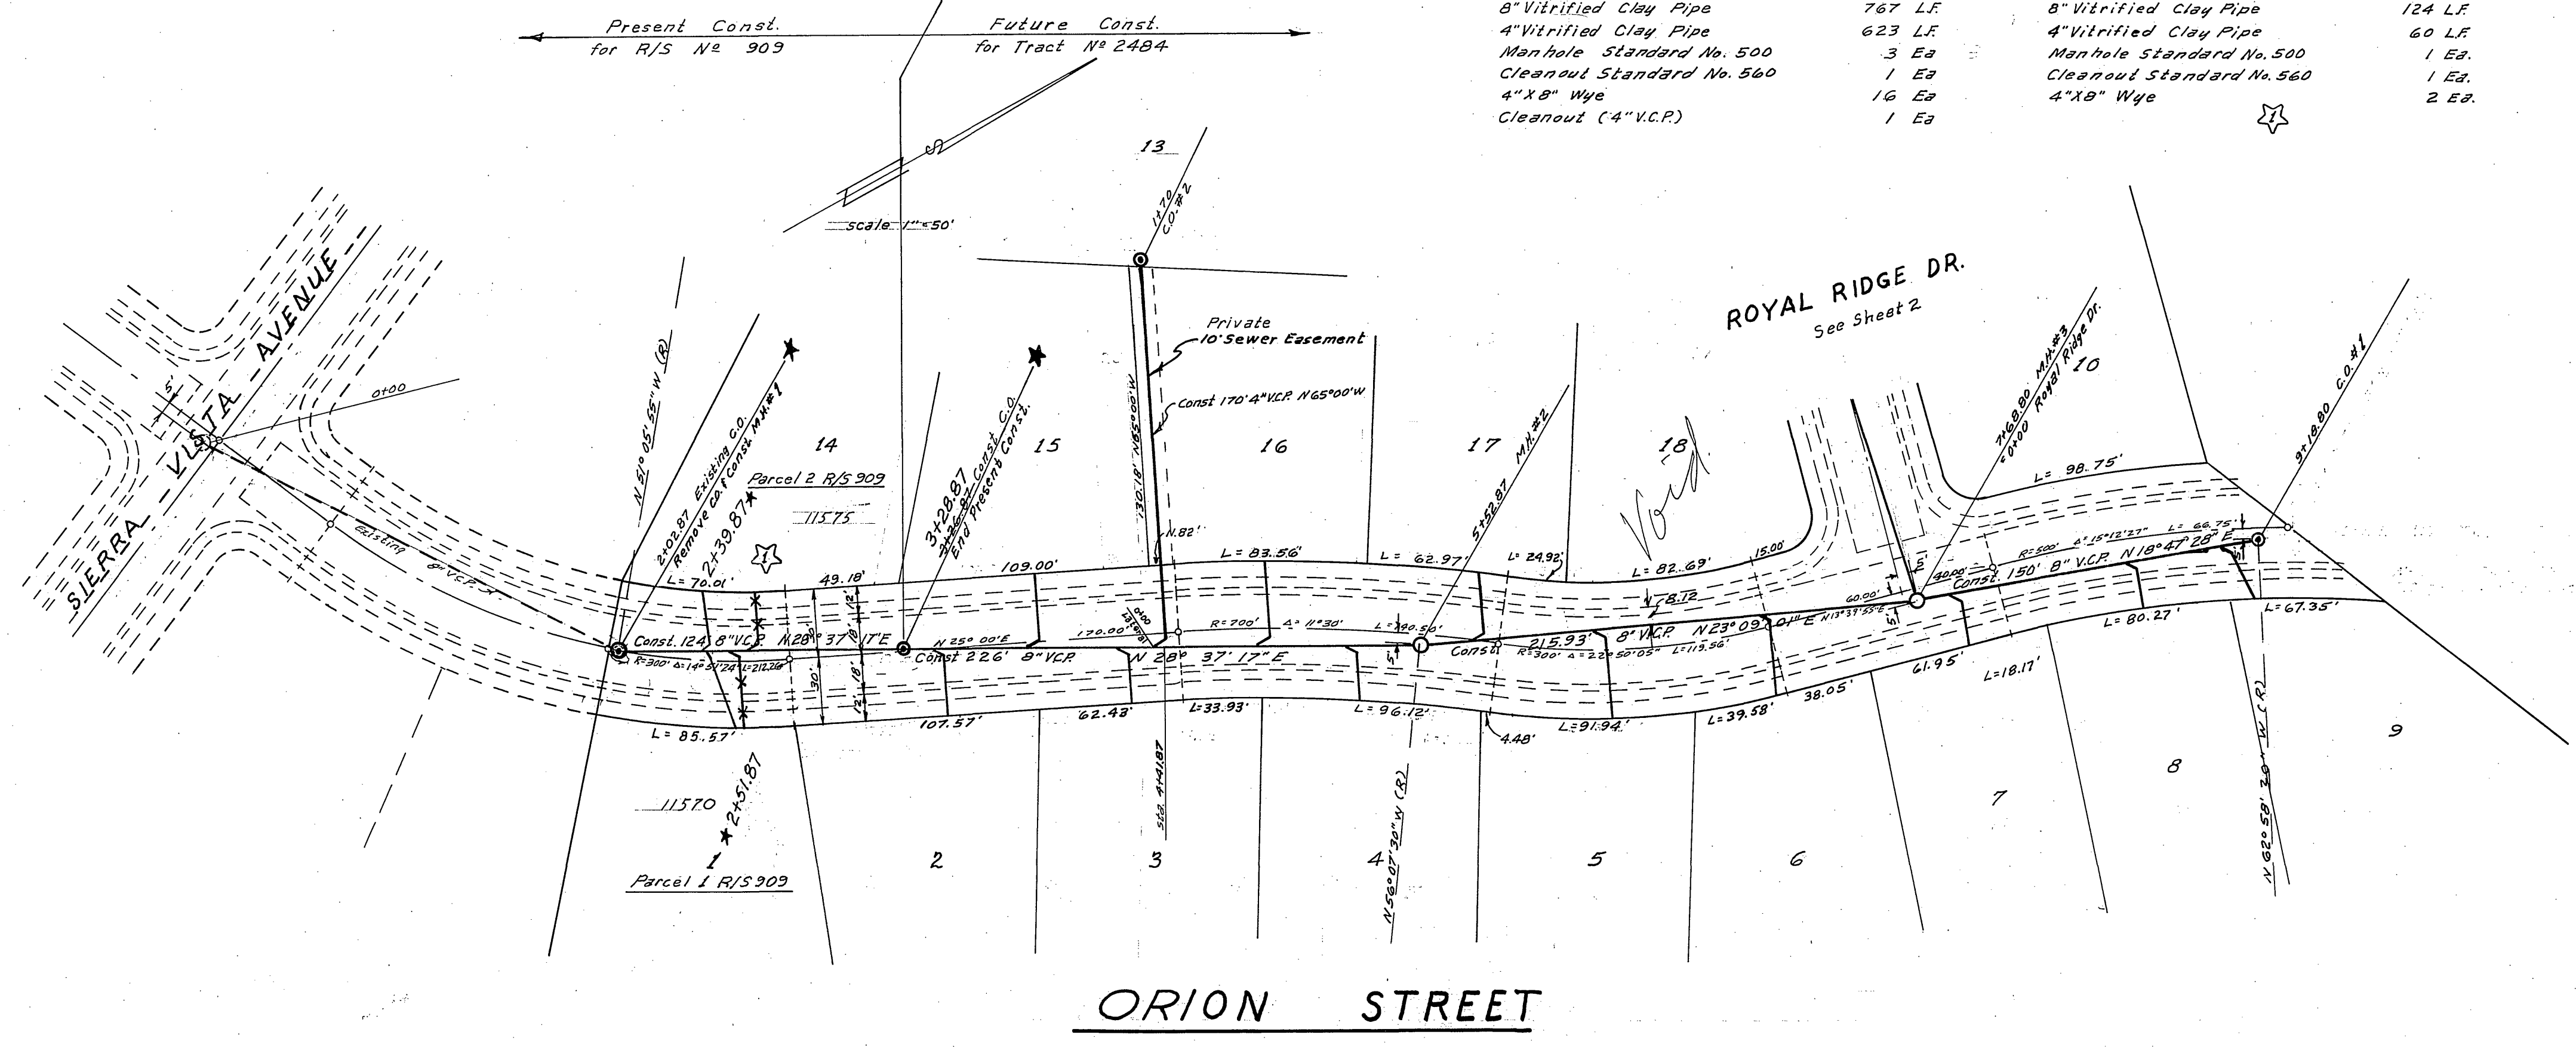


ORION STREET

R/S 909 AS BUILT 2/21/66 GYM/HAS


ALBERT A. WEBB ASSOCIATES
CIVIL ENGINEERS - RIVERSIDE, CALIFORNIA
APPROVED: *Albert Webb* DATE 9/25/64
R/S 909

REVISION		DESCRIPTION	APPROVED BY
MARK	DATE		
☆	5/18/65	Added Present Const for R/S 909 E.N.W. <i>W.B. HAS</i>	<i>Albert Webb</i> DIRECTOR OF PUBLIC WORKS
DATE	Feb 1964	SCALE	1" = 50'
DRAWN	BEL	W.O.	62-175
CHECKED	<i>W.B. HAS</i>	F.B.	
		DATE	2-9-65
		SHEET	1 OF 2
		NO.	S-566

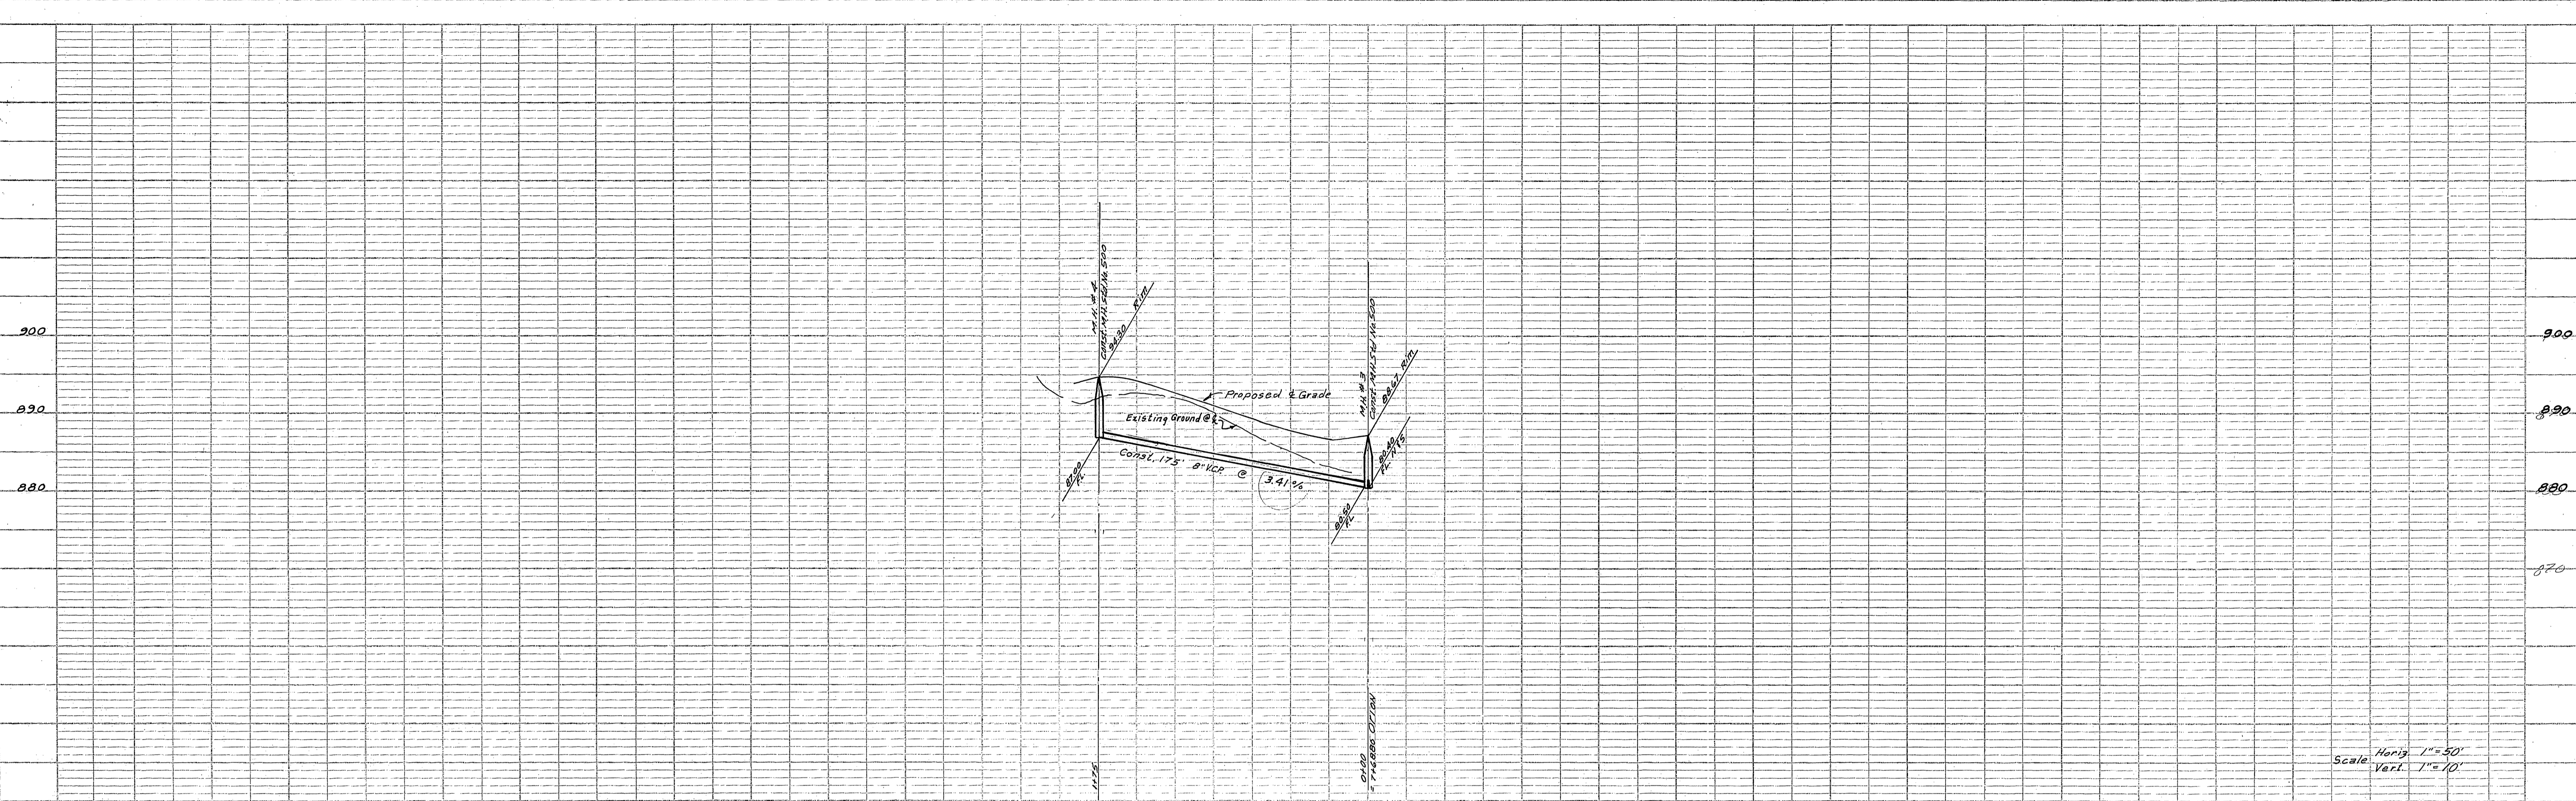

Scale Horiz. 1" = 50'
Vert. 1" = 10'

BENCH MARK: Elev 1321.77 B 489'48
Chisled X in curb on West side of Sierra Vista Ave, 206' South of Orion St.

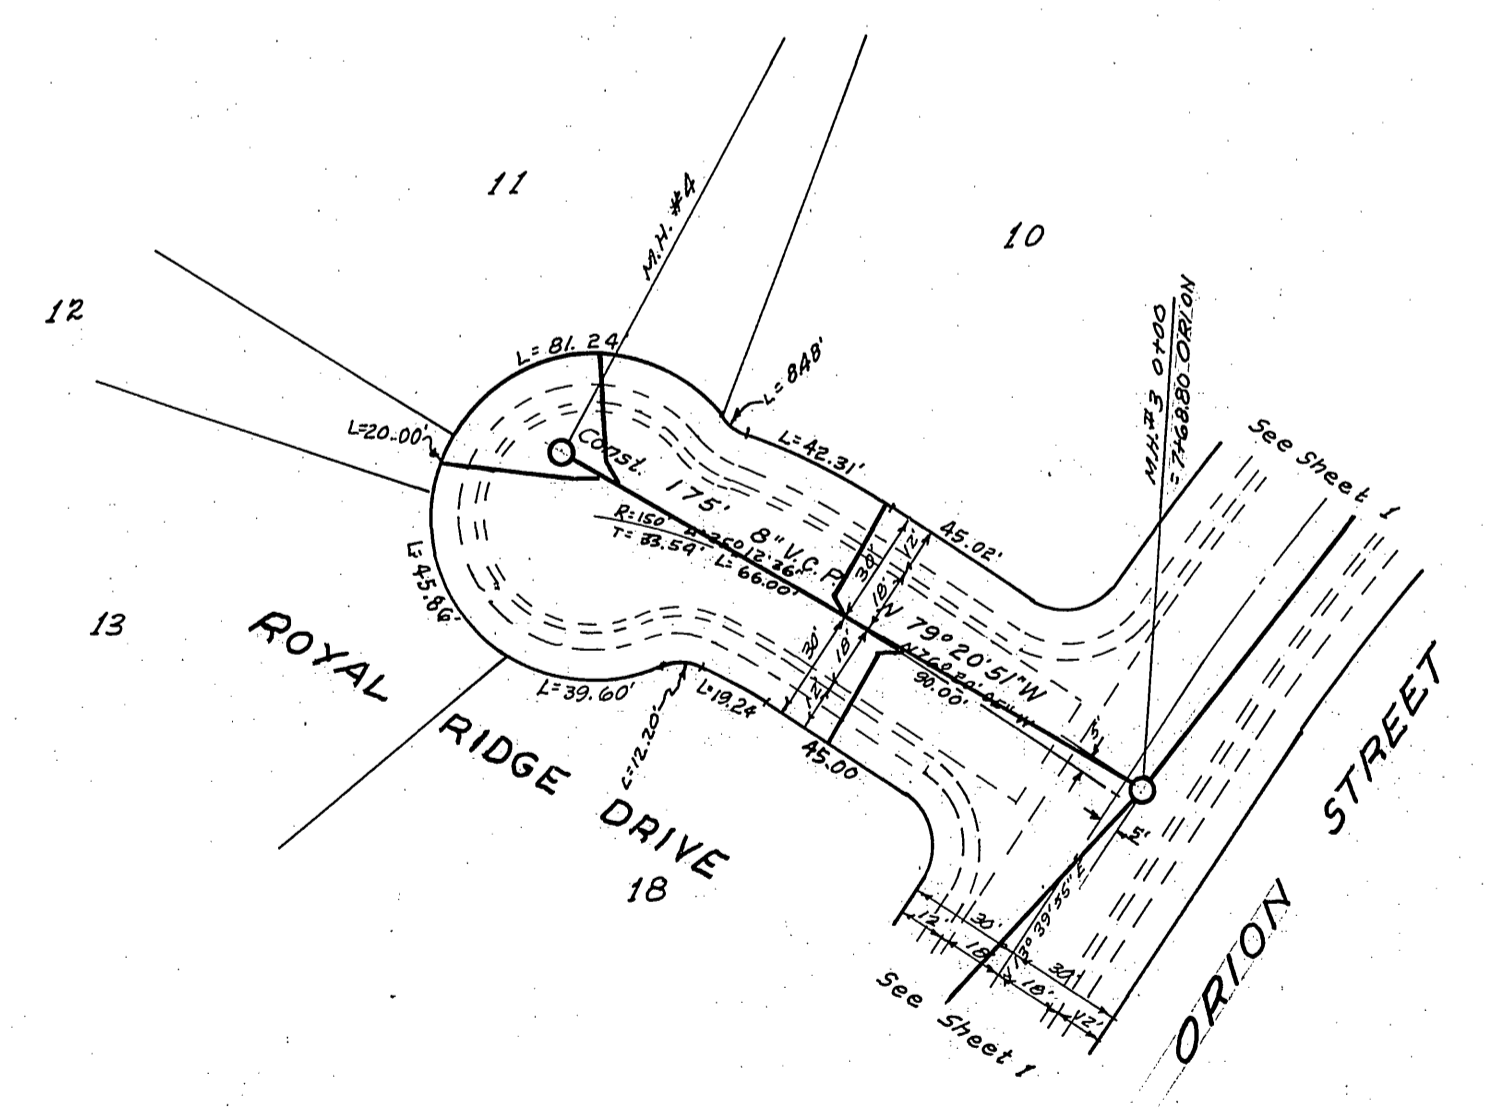

PROFILE	
SUBMITTED	BY
DATE CHECKED	DATE
NO.	

PLAN	
SUBMITTED	BY
DATE CHECKED	DATE
NO.	

ALBERT A. WEBB ASSOCIATES
CIVIL ENGINEERS - RIVERSIDE, CALIFORNIA
APPROVED *Earl N. Webb* DATE 6/25/64
S.E. 3876

REVISION		DESCRIPTION
MARK	DATE	

CITY OF RIVERSIDE, CALIFORNIA
DEPARTMENT OF PUBLIC WORKS
SEWER PLAN & PROFILE
ROYAL RIDGE DRIVE
TRACT No. 2484

DATE June 1964	SCALE 1" = 50'	APPROVED BY <i>Earl N. Webb</i>	NO. 5-566
DRAWN BEL	W.D. 62-175	DIRECTOR OF PUBLIC WORKS	
CHECKED <i>W. B. S.</i>	F.B. 488	DATE 2-9-65	SHEET 2 OF 2