



SCALES
 HOR. 1"=40'
 VERT. 1"=4'
 FB S-11

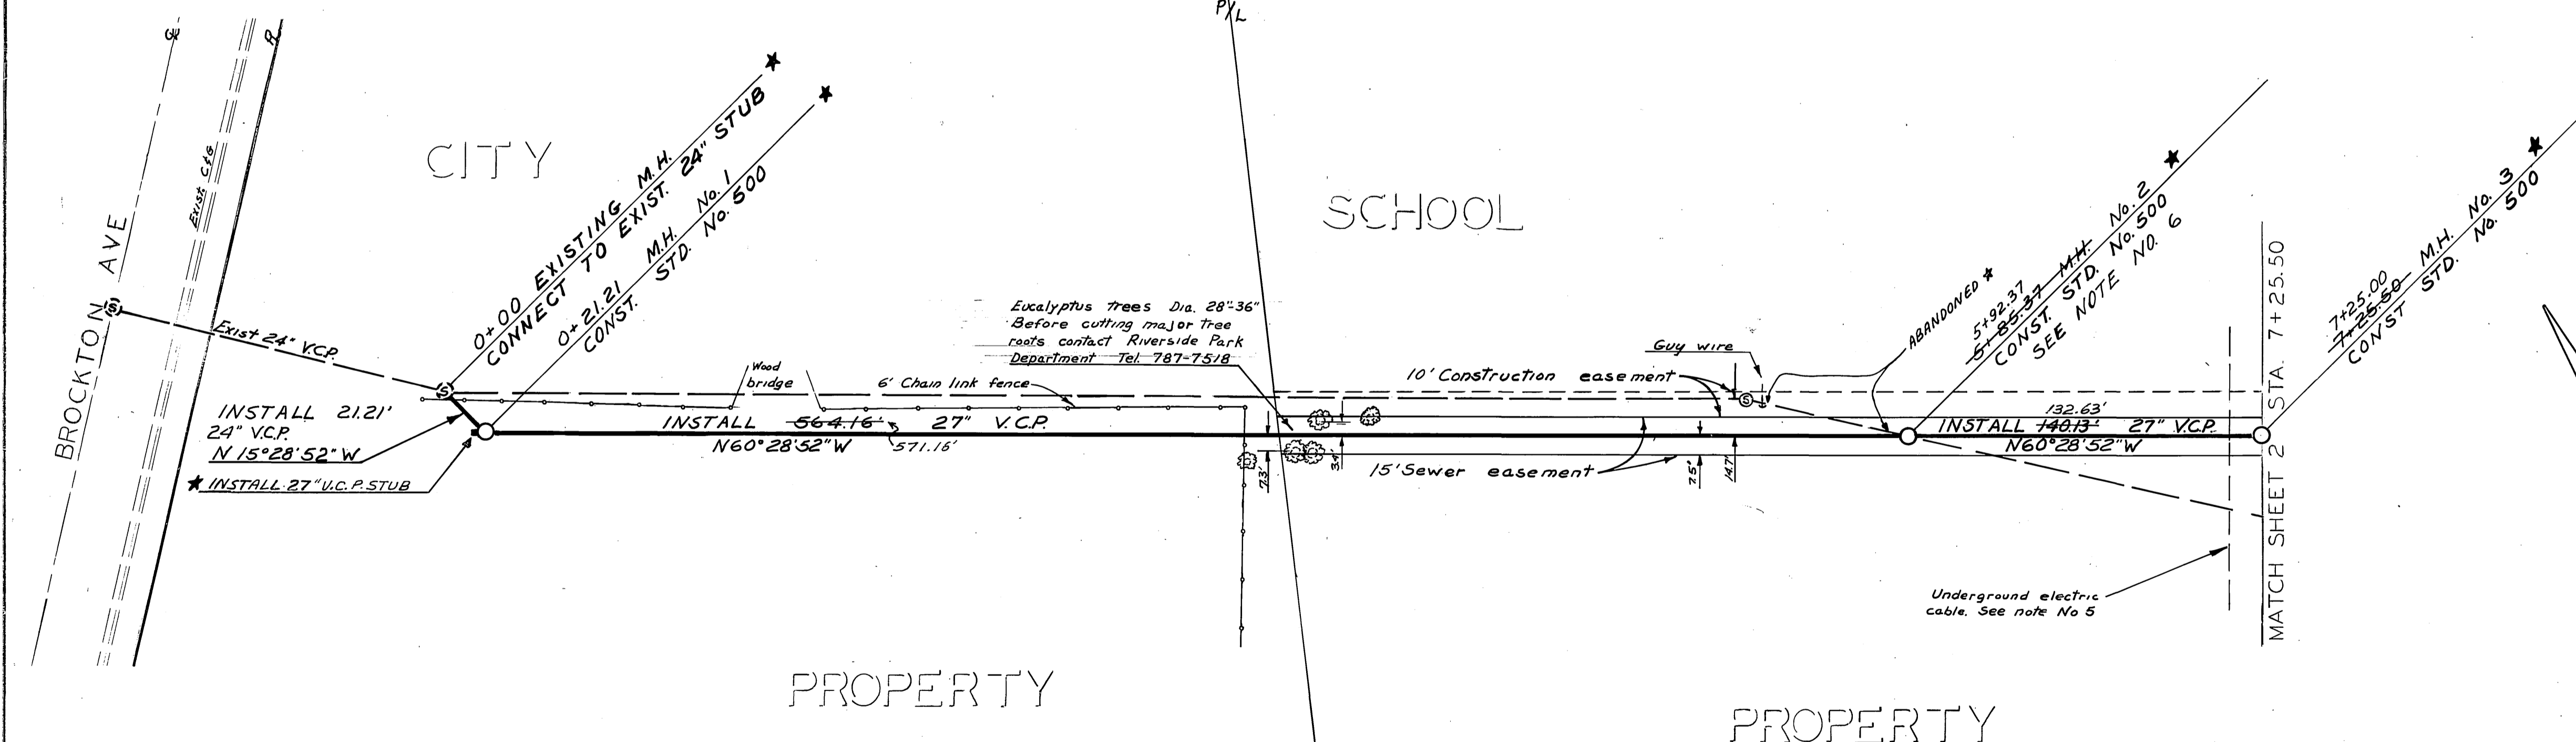

- GENERAL NOTES**
1. CONTRACTOR TO SAVE ALL SOD REMOVED DURING CONSTRUCTION. REPLACE AFTER BACKFILLING.
 2. ALL FENCES AND OTHER OBSTRUCTIONS REMOVED DURING CONSTRUCTION TO BE REPLACED IN KIND AS DIRECTED. NO EXTRA PAYMENT.
 3. CONTRACTOR TO BE RESPONSIBLE FOR ANY REPAIRS NECESSARY TO ALL ATHLETIC FIELDS AND FACILITIES DAMAGED DURING CONSTRUCTION OPERATIONS. ALL REPAIRS TO BE MADE TO THE SATISFACTION OF THE RIVERSIDE JUNIOR COLLEGE DISTRICT.
 4. ALL MANHOLES WITHIN ATHLETIC FIELDS AND TRACK FACILITIES TO BE LEFT 10' BELOW EXISTING GROUND SURFACE AND COVERED AS DIRECTED IN THE FIELD.
 5. CONTACT RIVERSIDE JUNIOR COLLEGE DISTRICT FOR LOCATION OF SPRINKLER PIPES AND UNDERGROUND ELECTRIC CABLES BETWEEN STA. 3+20 AND STA. 23+50.
 6. CONSTRUCT MANHOLES AT INTERSECTIONS OF EXISTING AND PROPOSED SEWERS. SHAPE MANHOLE BASE AS DIRECTED IN THE FIELD.
 7. TOP 10' OF BACKFILL IN ATHLETIC FIELDS AND TRACK AREA TO BE REPLACED EQUIVALENT TO EXISTING MATERIAL.
 8. EXACT HORIZONTAL LOCATION OF EXISTING UTILITY LINES IS NOT KNOWN. THE CONTRACTOR SHALL BE RESPONSIBLE FOR LOCATING EXISTING LINES DURING EXCAVATION OPERATIONS TO PREVENT DAMAGE.

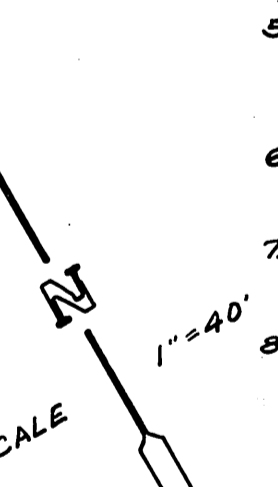

REVISIONS			CITY OF RIVERSIDE, CALIFORNIA DEPARTMENT OF PUBLIC WORKS	
MARK	DATE	DESCRIPTION		
			VICTORIA TRUNK RELIEF SEWER UNIT NO. 1	
DESIGNED BY GHC	SUBMITTED BY G. E. Robertson	APPROVED BY <i>[Signature]</i>	PROJ. NO. 5061	
DRAWN BY BE	PARK DEPT.	TRAFFIC DIV.	S-582	
CHECKED BY	RECOMMENDED BY <i>[Signature]</i>	DATE 5-19-65	SHEET 1 OF 5	


* AS BUILT 10-18-65 HB

PROFILE

NO.	SUBMITTED	BY	DATE
	NOTED		
	GRADES CHECKED		
	STRUCTURE NOTATIONS CHECKED		



PLAN

NO.	SUBMITTED	BY	DATE
	NOTED		
	ALIGNMENT CHECKED		
	ITM. OF WAY CHECKED		

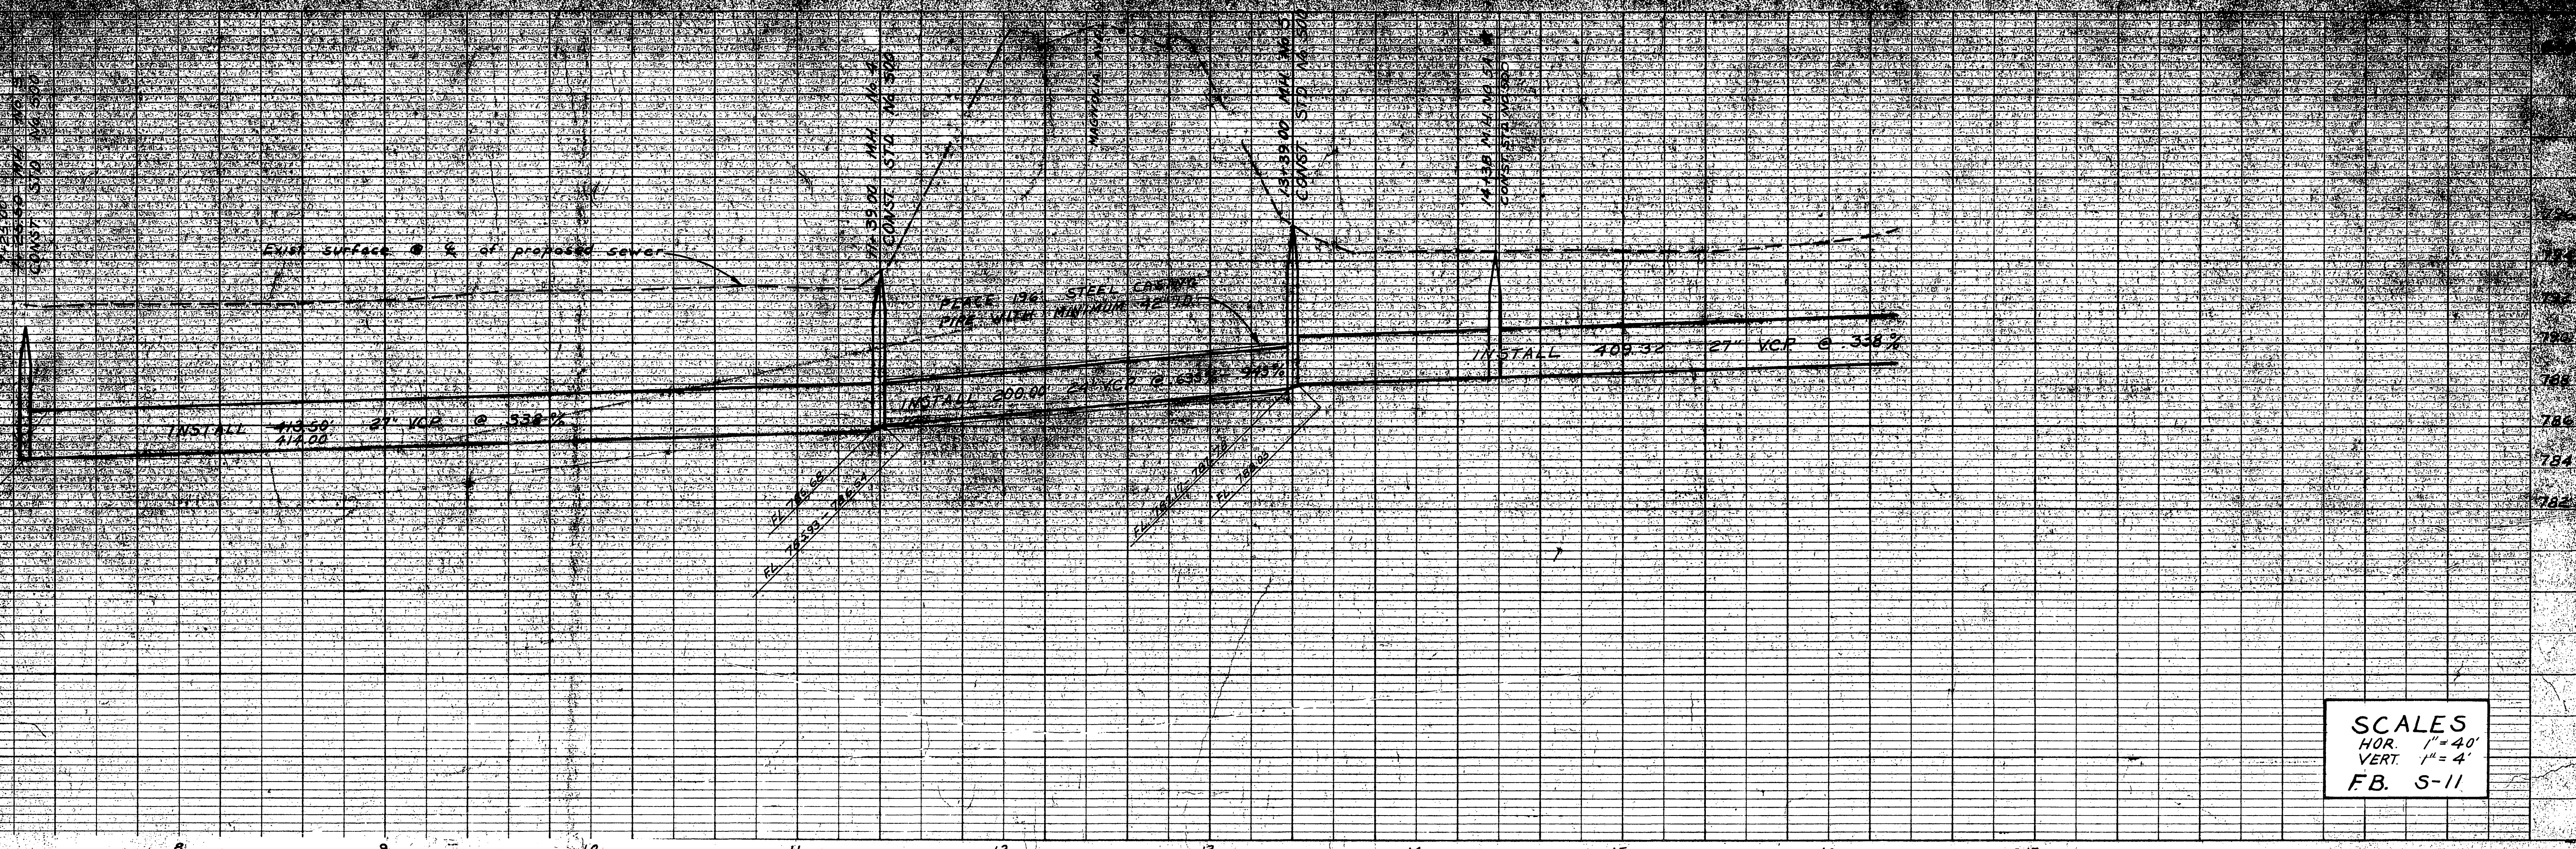


SCALES
 HOR. 1" = 40'
 VERT. 1" = 4'
 F.B. 5-11


NOTES
 1. See sheet 1 for general notes.

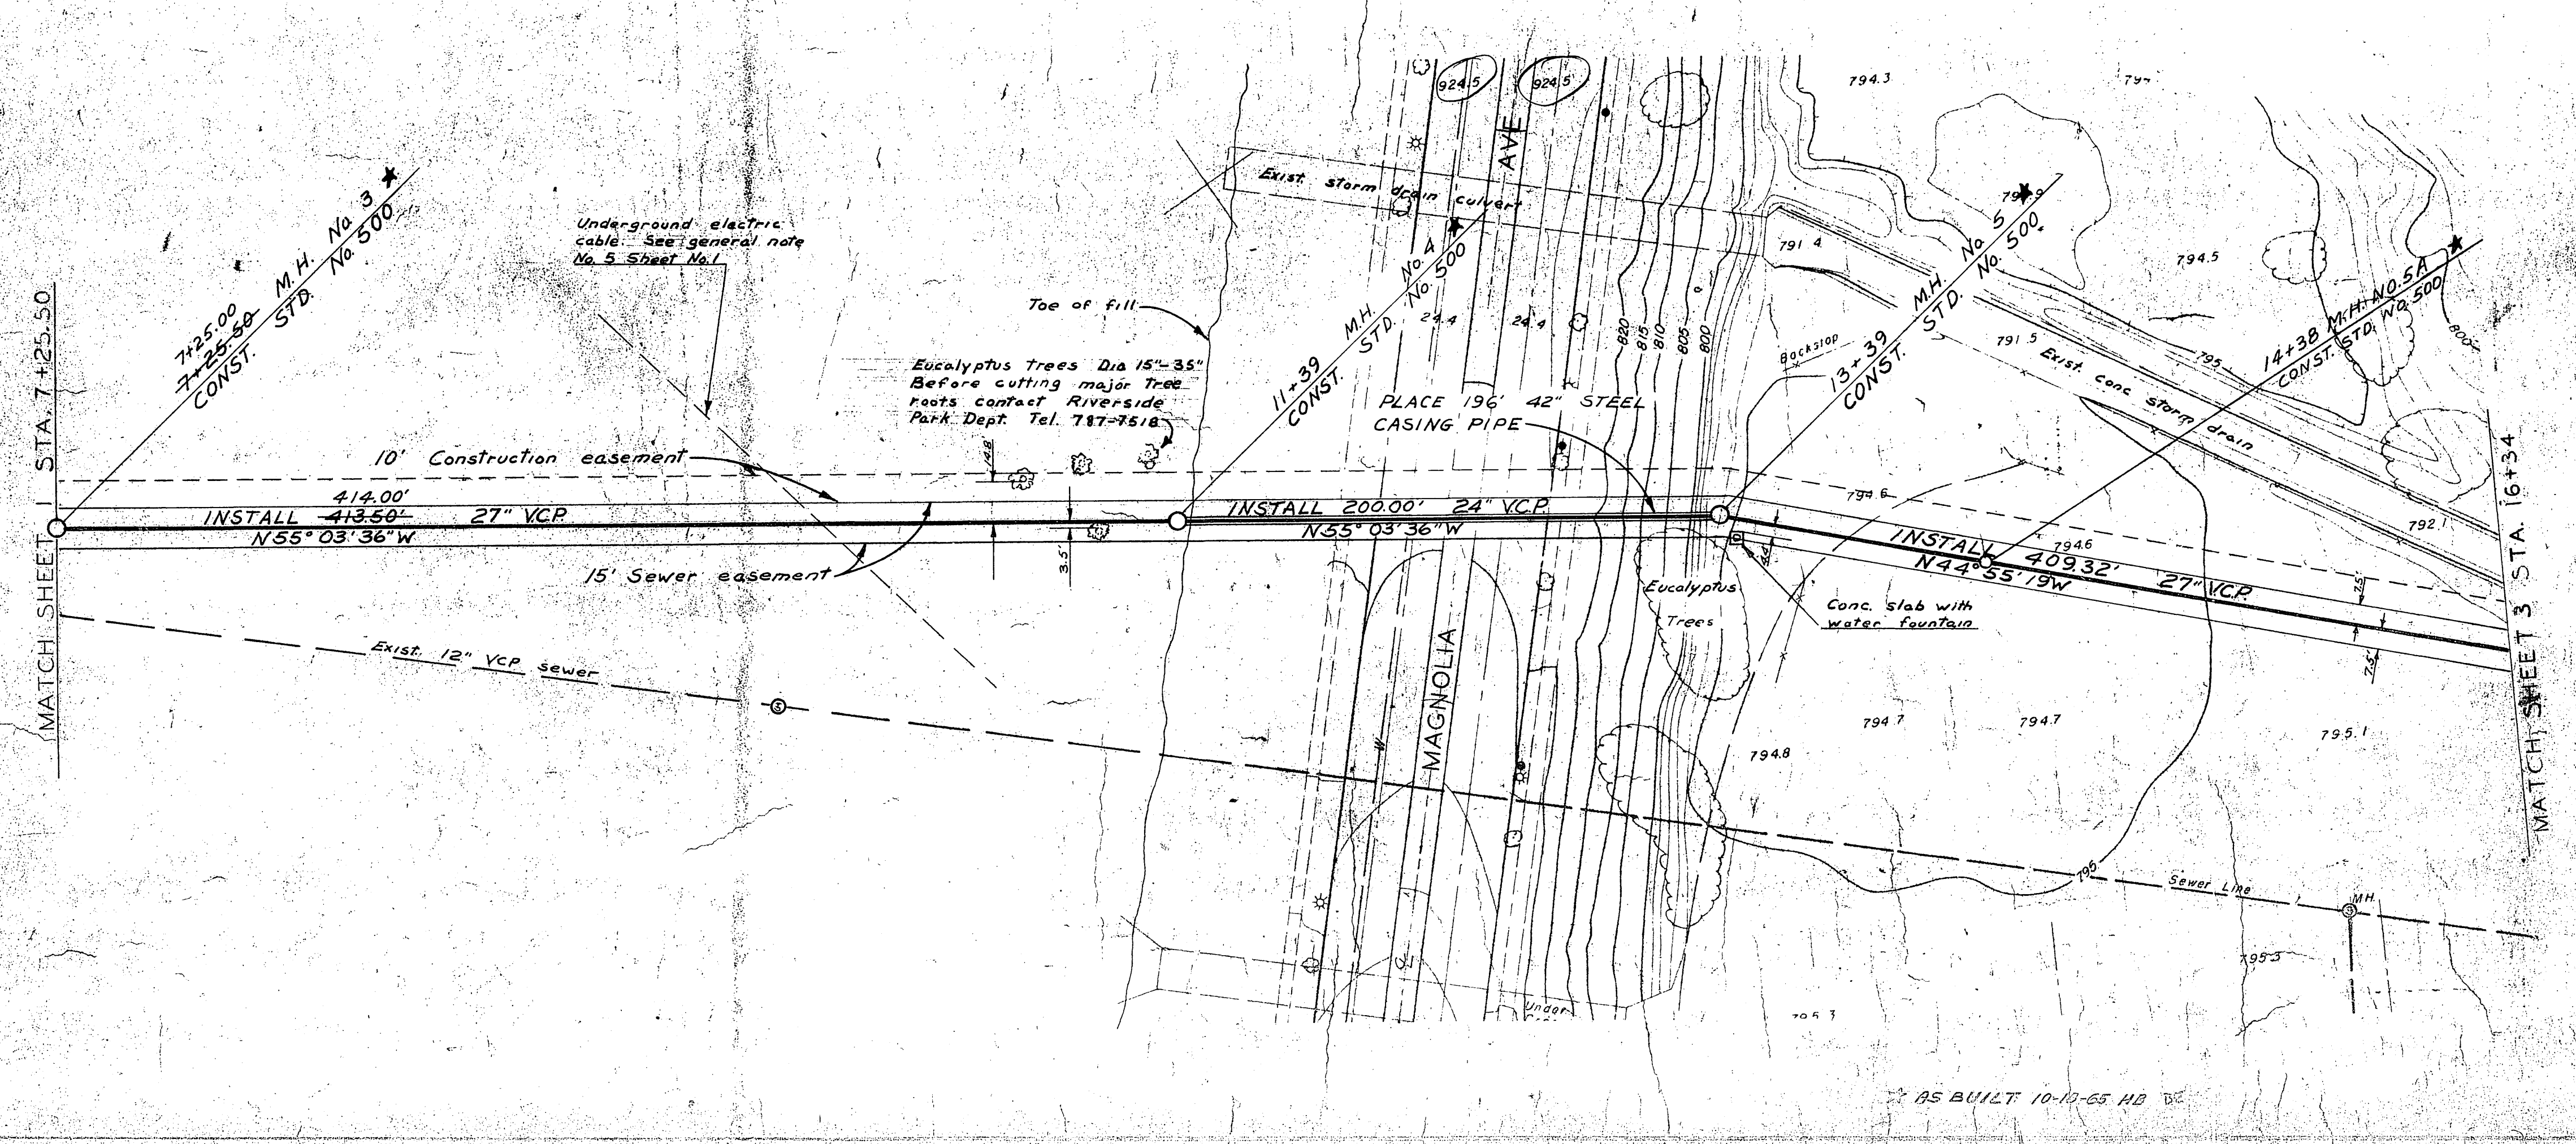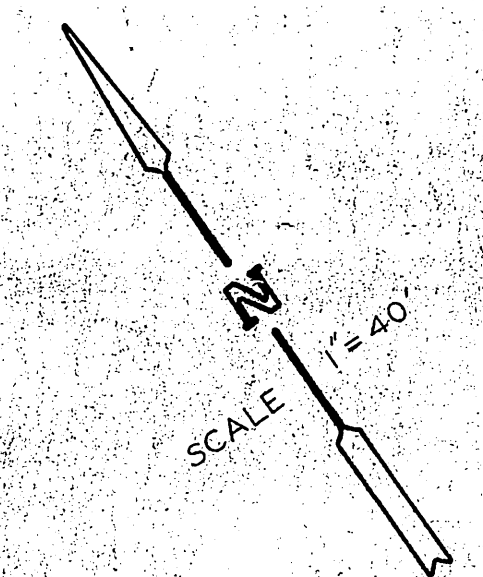


REVISIONS		CITY OF RIVERSIDE, CALIFORNIA DEPARTMENT OF PUBLIC WORKS	
MARK	DATE	DESCRIPTION	
			VICTORIA TRUNK RELIEF SEWER UNIT NO. 1
DESIGNED BY:	SUBMITTED BY:	APPROVED BY:	PROJ. NO. 5061
DRAWN BY B.E.	PARK DEPT. TRAFFIC DIV.	<i>[Signature]</i>	S-582
CHECKED BY:	REVISIONS:	DATE: 5-19-65	SHEET 2 OF 5

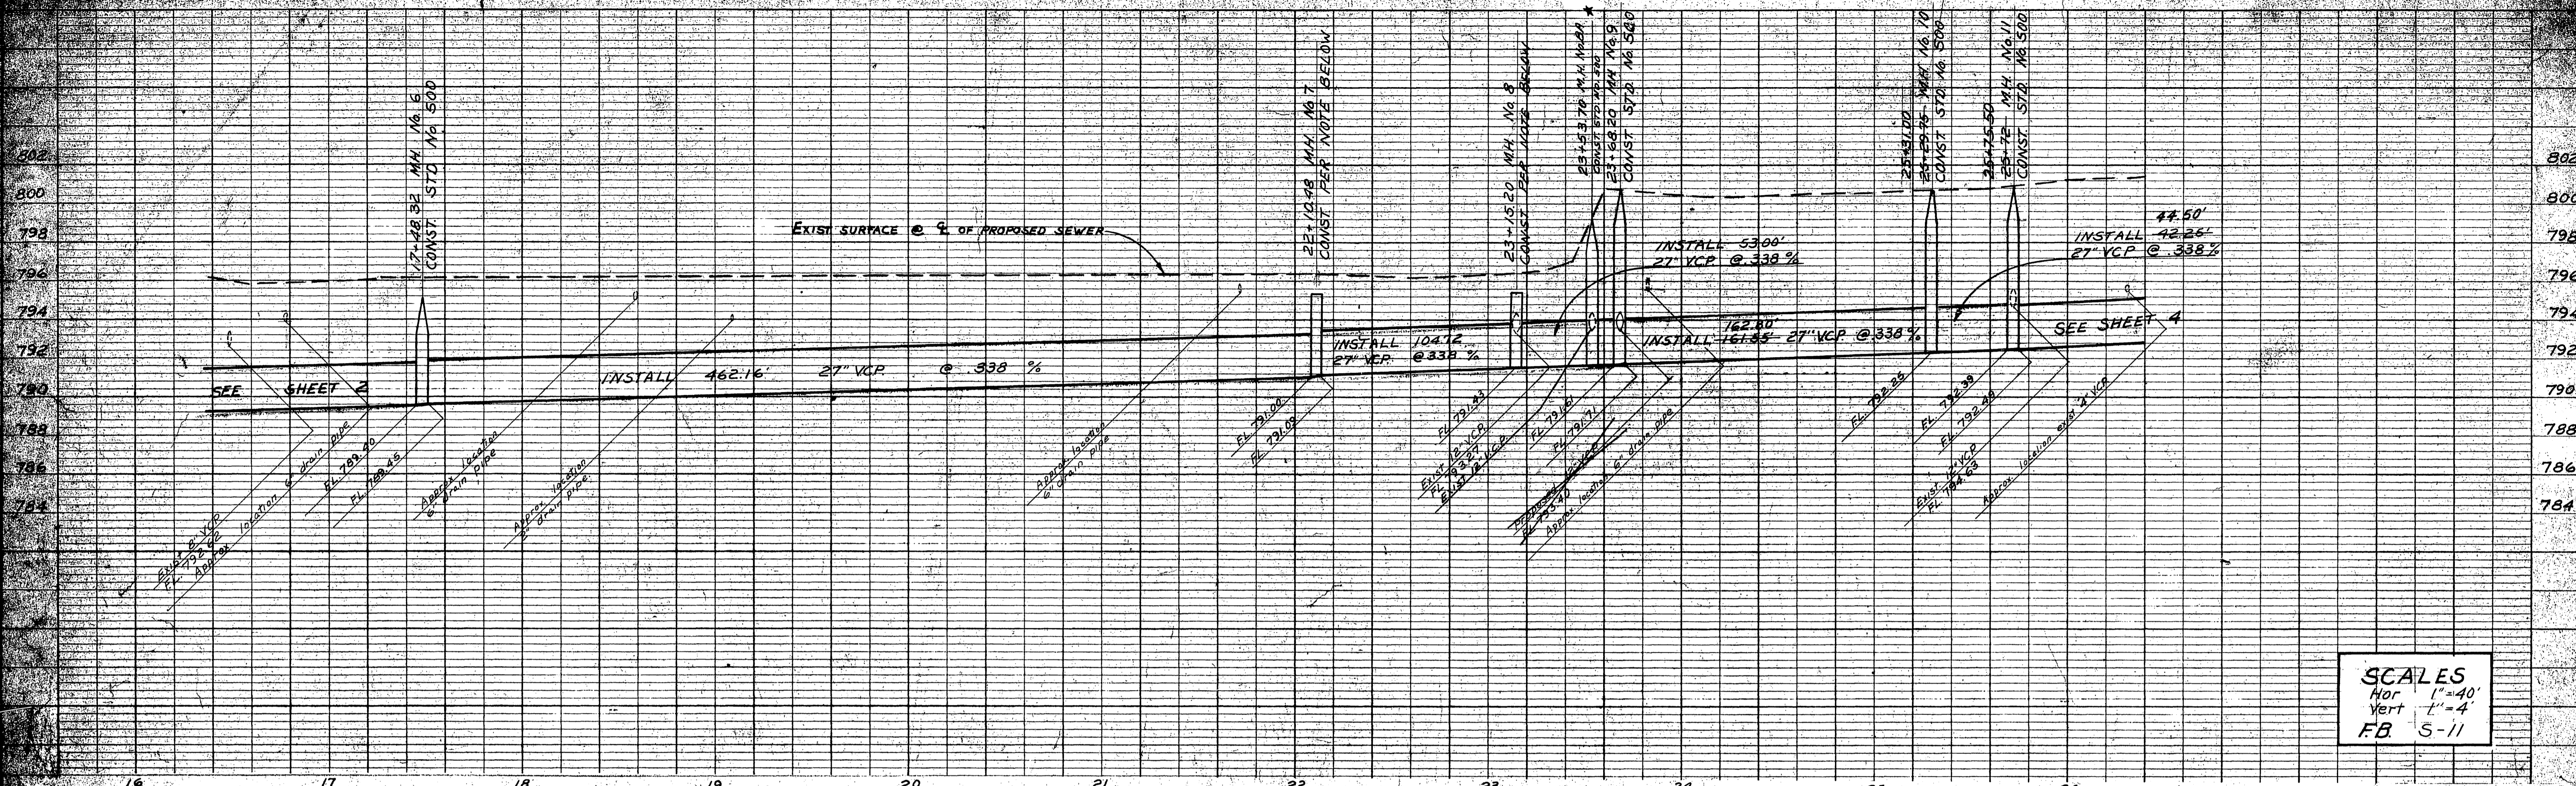

SCALES
 Hor 1"=40'
 Vert 1"=4'
 FB 5-11

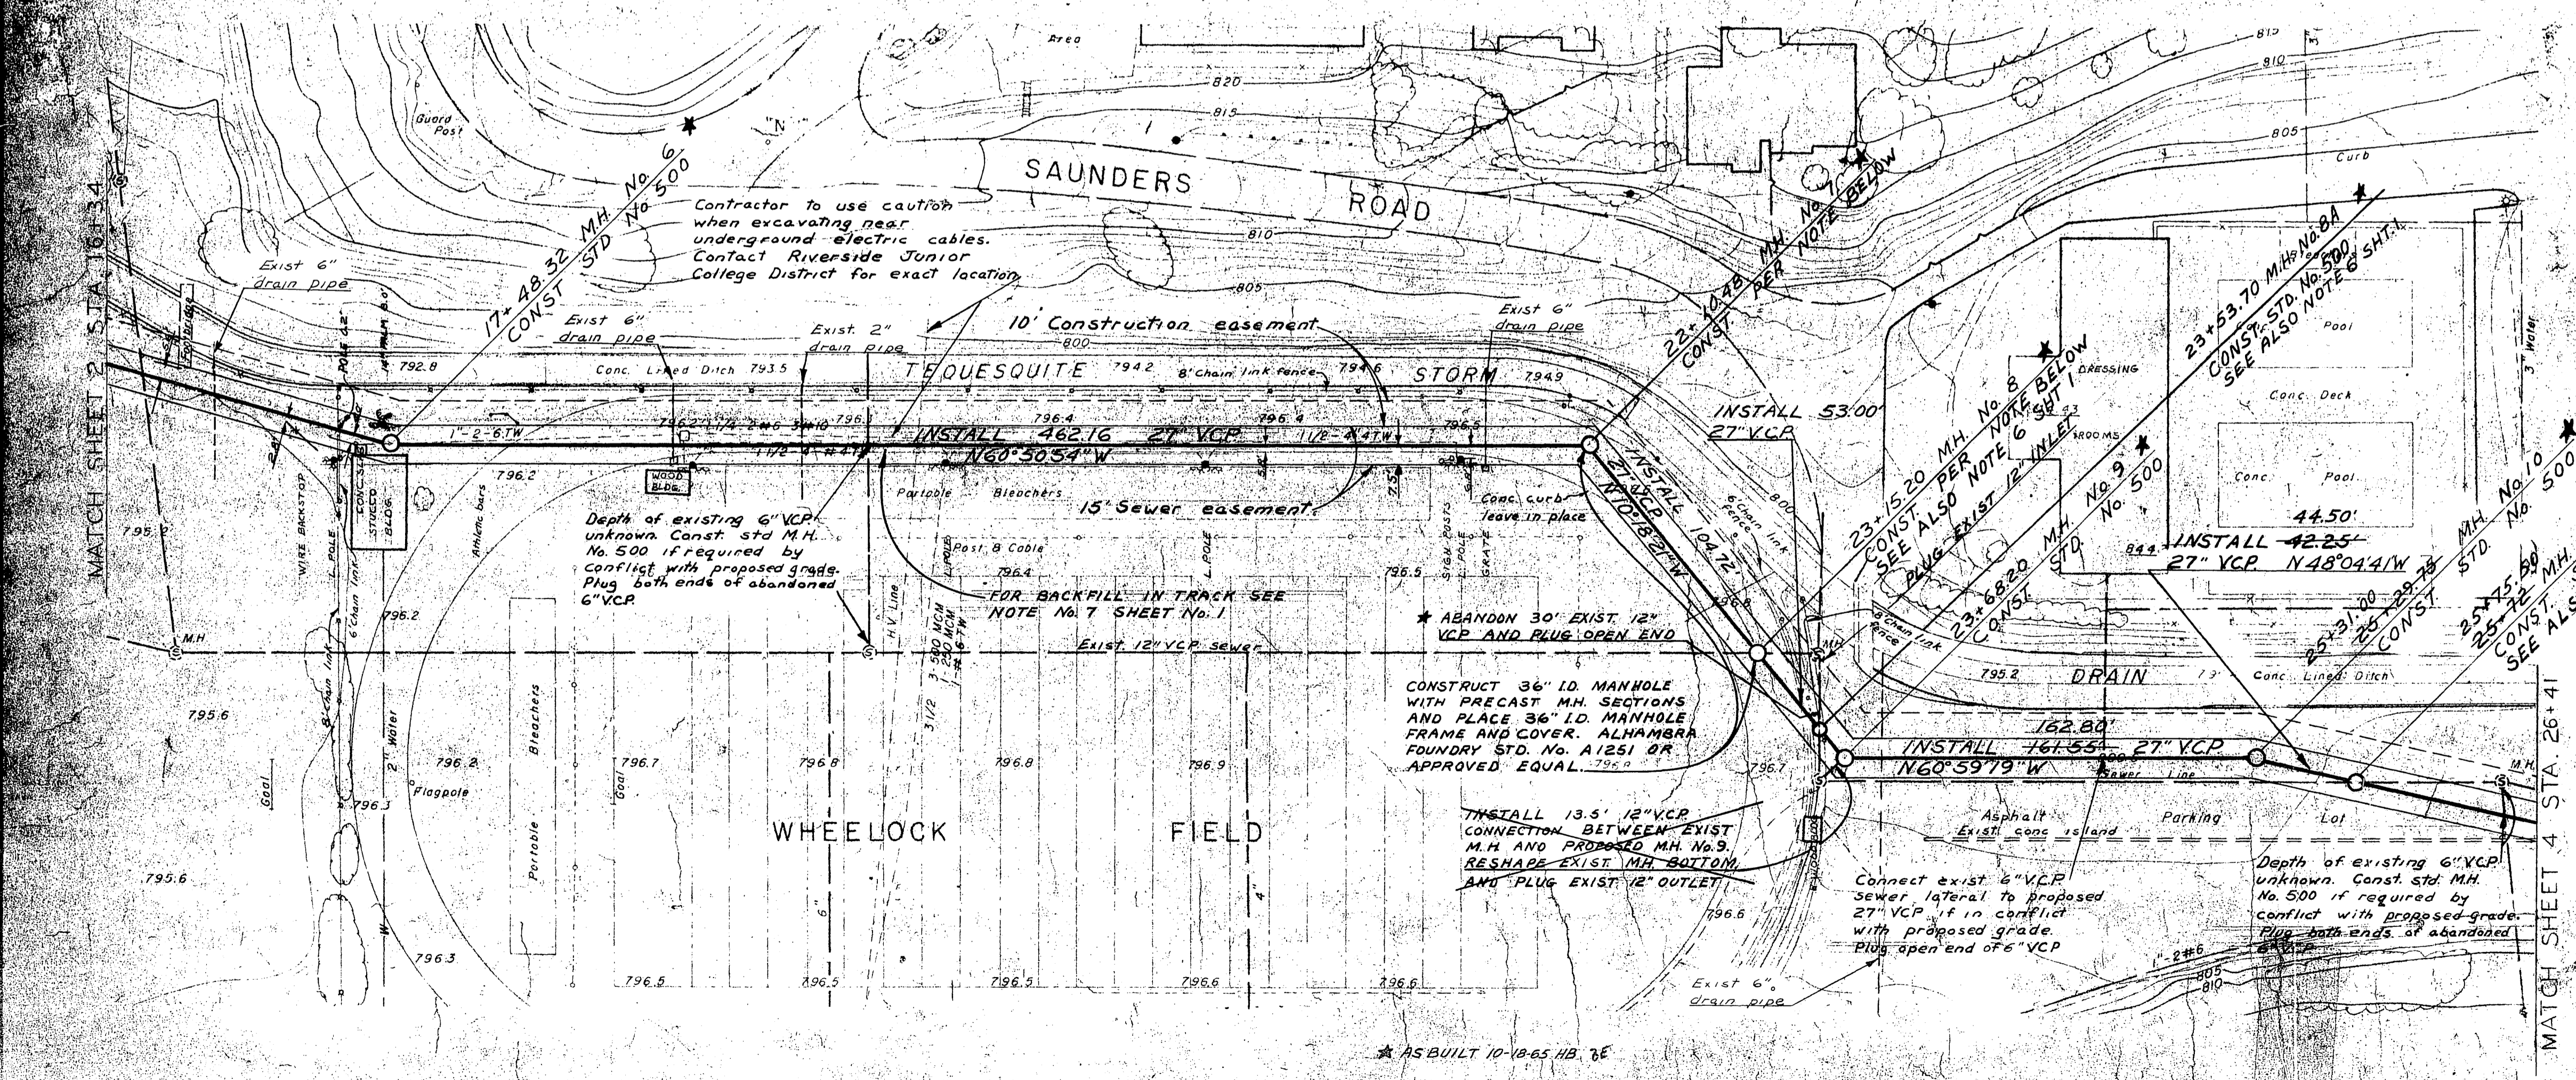


NOTES
 1. See sheet No. 1 for general notes.

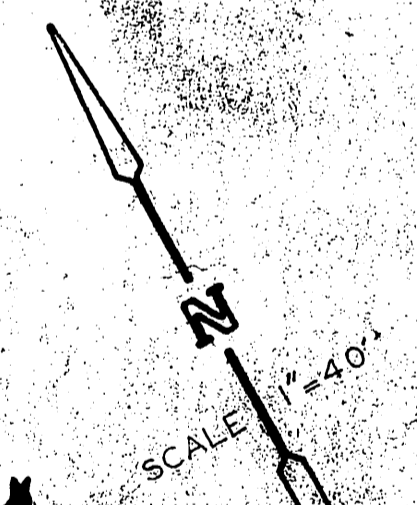



REVISIONS		CITY OF RIVERSIDE, CALIFORNIA DEPARTMENT OF PUBLIC WORKS	
MARK	DATE	DESCRIPTION	
		VICTORIA TRUNK RELIEF SEWER UNIT NO. 1	
DESIGNED BY E.E.	SUBMITTED BY E. Robertson	APPROVED BY [Signature]	PROJ. NO. 5061
DRAWN BY B.E.	PARK DEPT. TRAFFIC DIV.	DIRECTOR OF PUBLIC WORKS	S-582
CHECKED BY	RECOMMENDED BY	DATE: 5-19-65	SHEET 3 OF 5

AS BUILT 10-18-65 HB, 7E

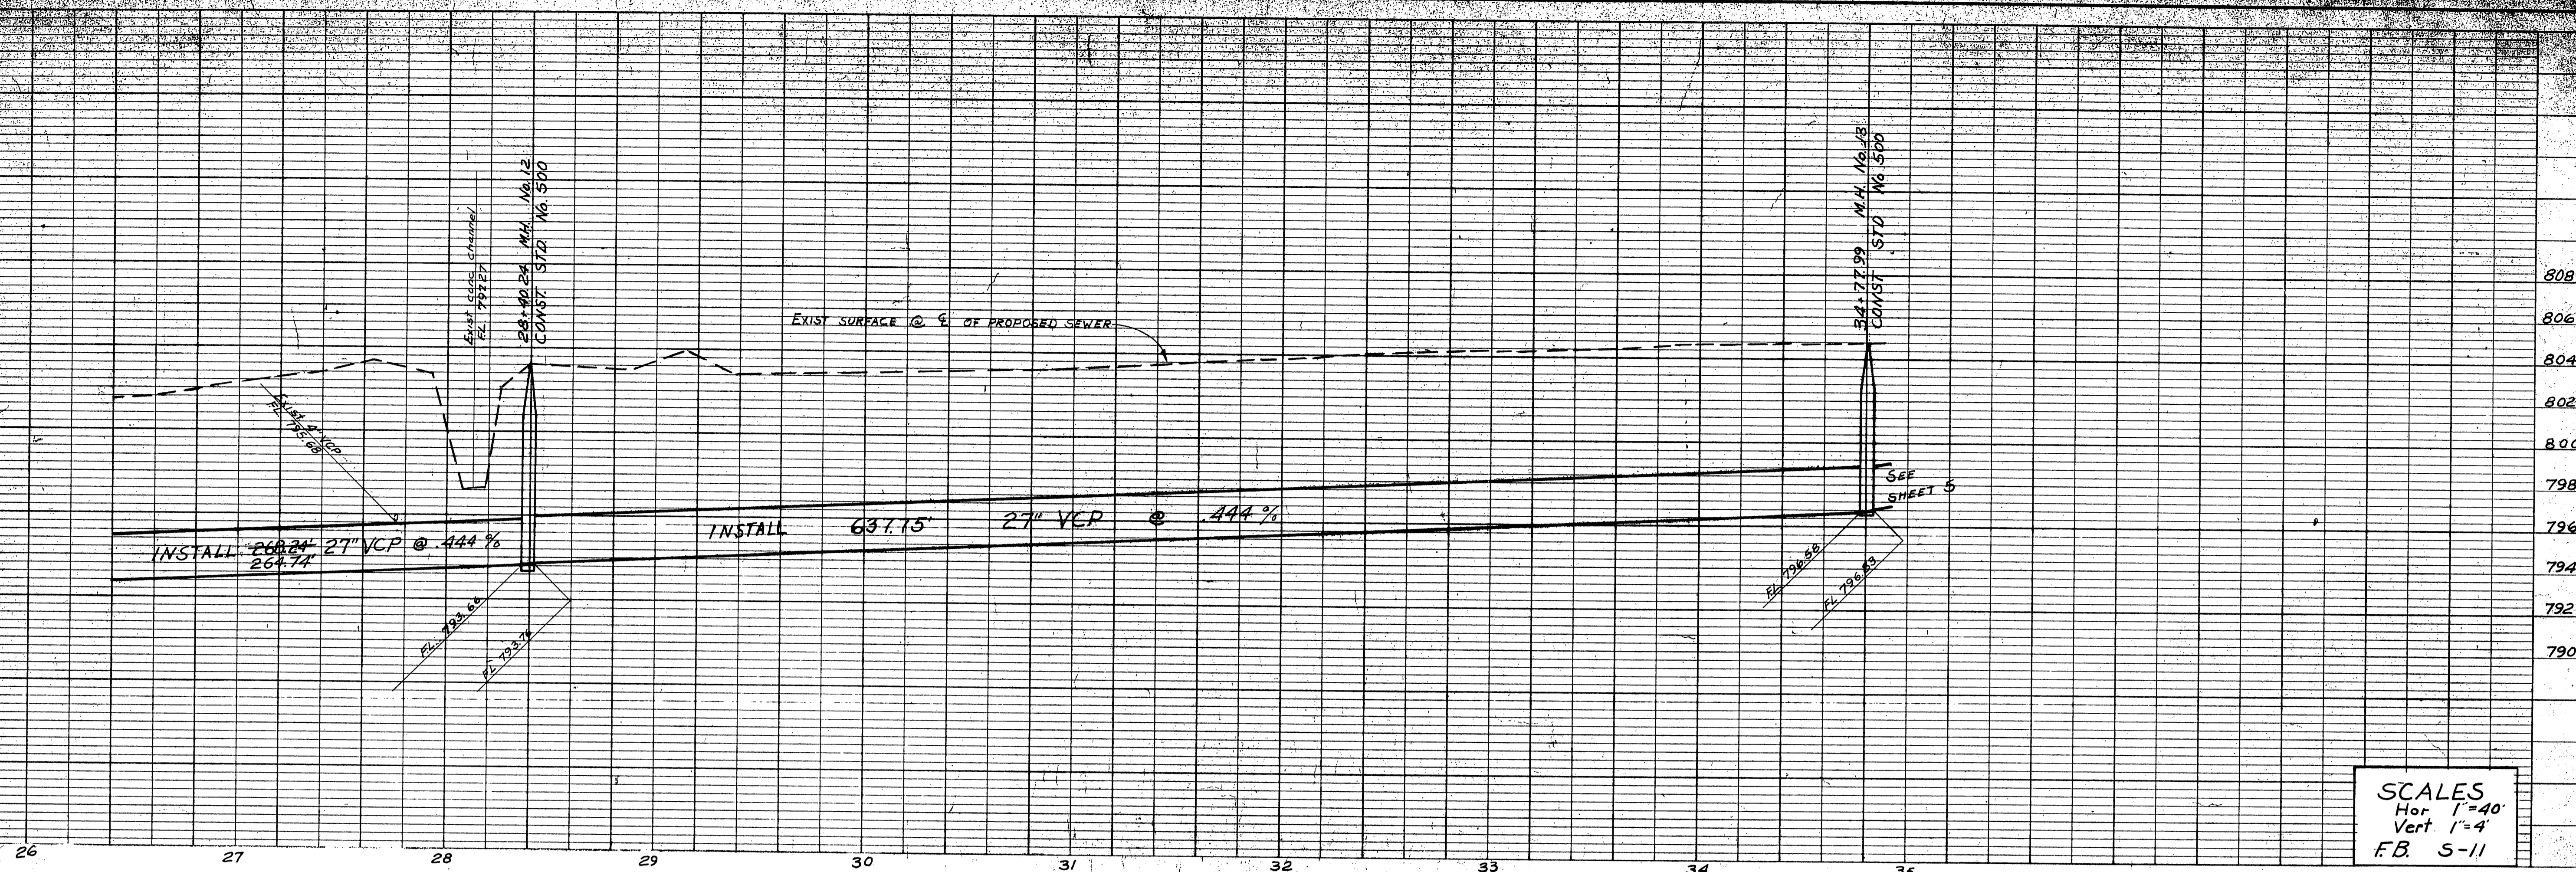


SCALES
 Hor 1"=40'
 Vert 1"=4'
 FB S-11


NOTES
 1. See sheet 1 for general notes.

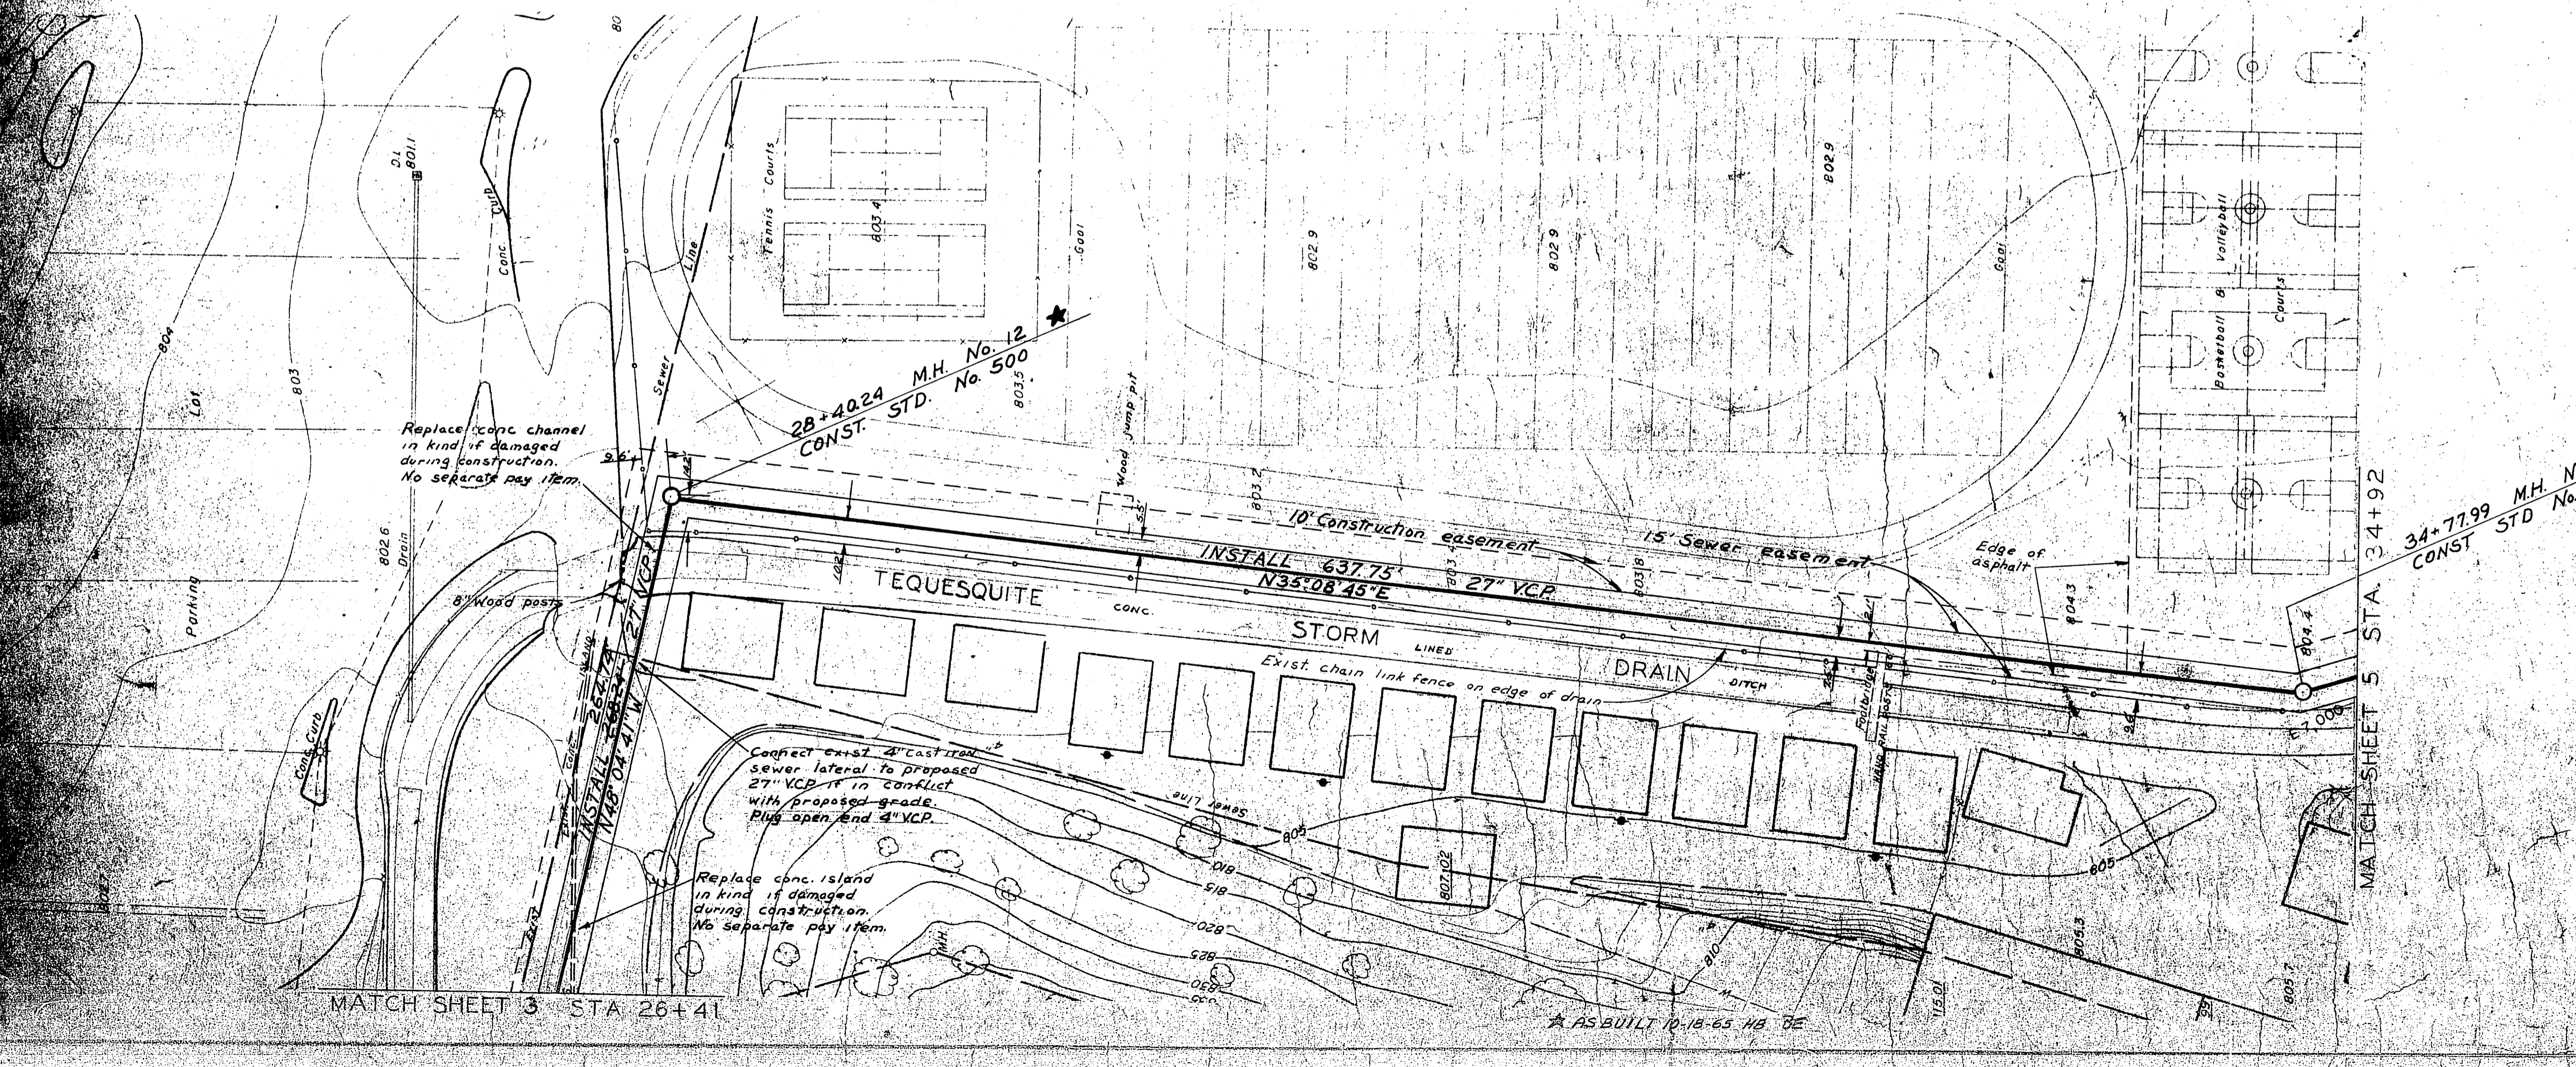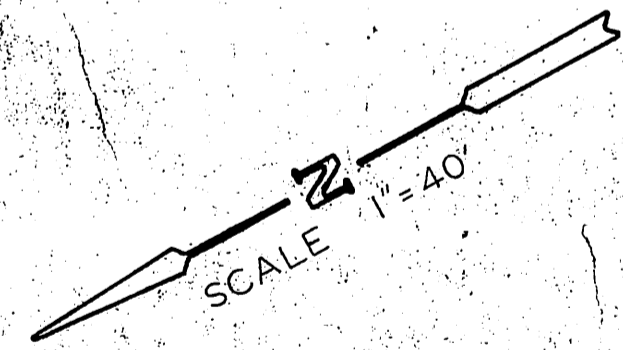


REVISIONS		CITY OF RIVERSIDE, CALIFORNIA DEPARTMENT OF PUBLIC WORKS	
MARK	DATE	DESCRIPTION	
			VICTORIA TRUNK RELIEF SEWER UNIT NO. 1
DESIGNED BY <i>RE</i>	SUBMITTED BY <i>RE</i>	APPROVED BY <i>[Signature]</i> DIRECTOR OF PUBLIC WORKS	PROJ. NO. 526/ S-582
DRAWN BY <i>RE</i>	PARK DEPT. TRAFFIC DIV.	CHECKED BY <i>[Signature]</i>	DATE 5-19-68
SHEET 4 OF 5			

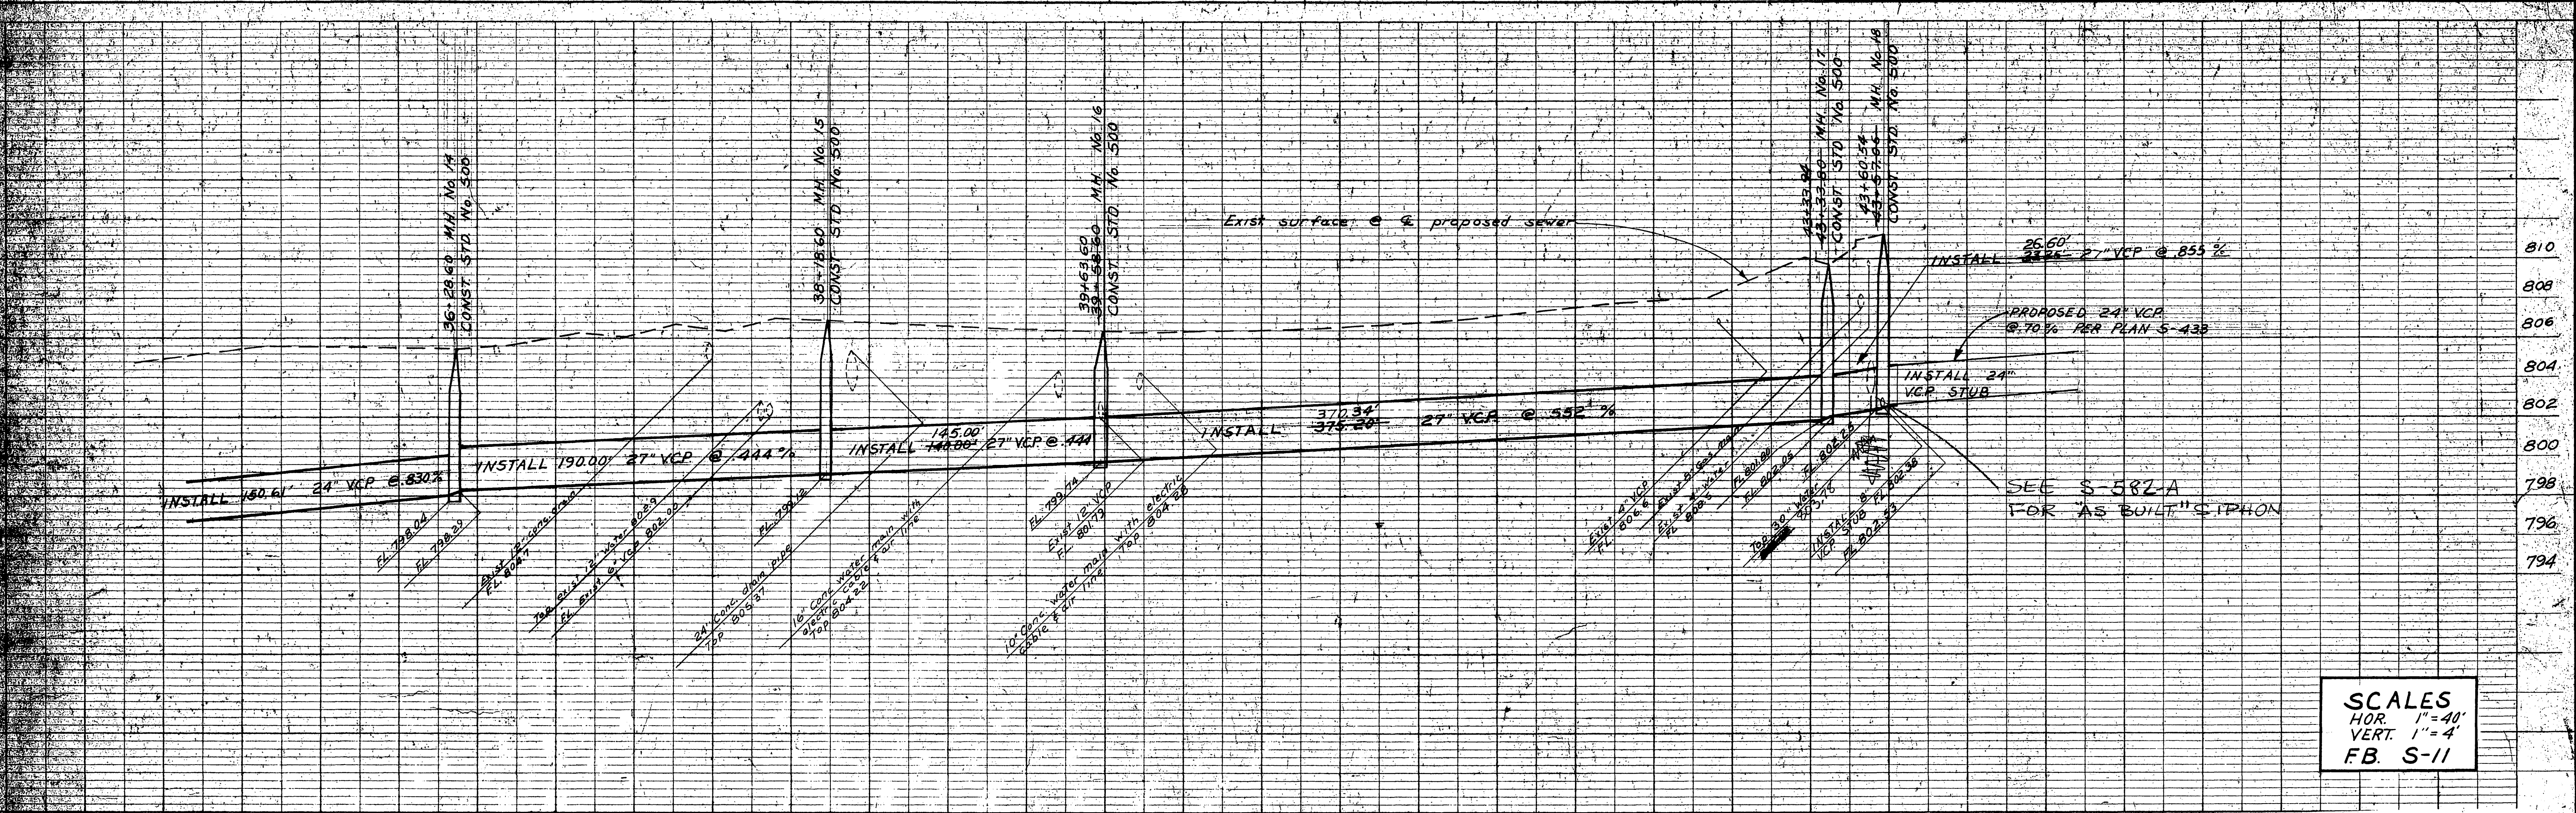

SCALES
 HOR. 1"=40'
 VERT. 1"=4'
 FB. S-11


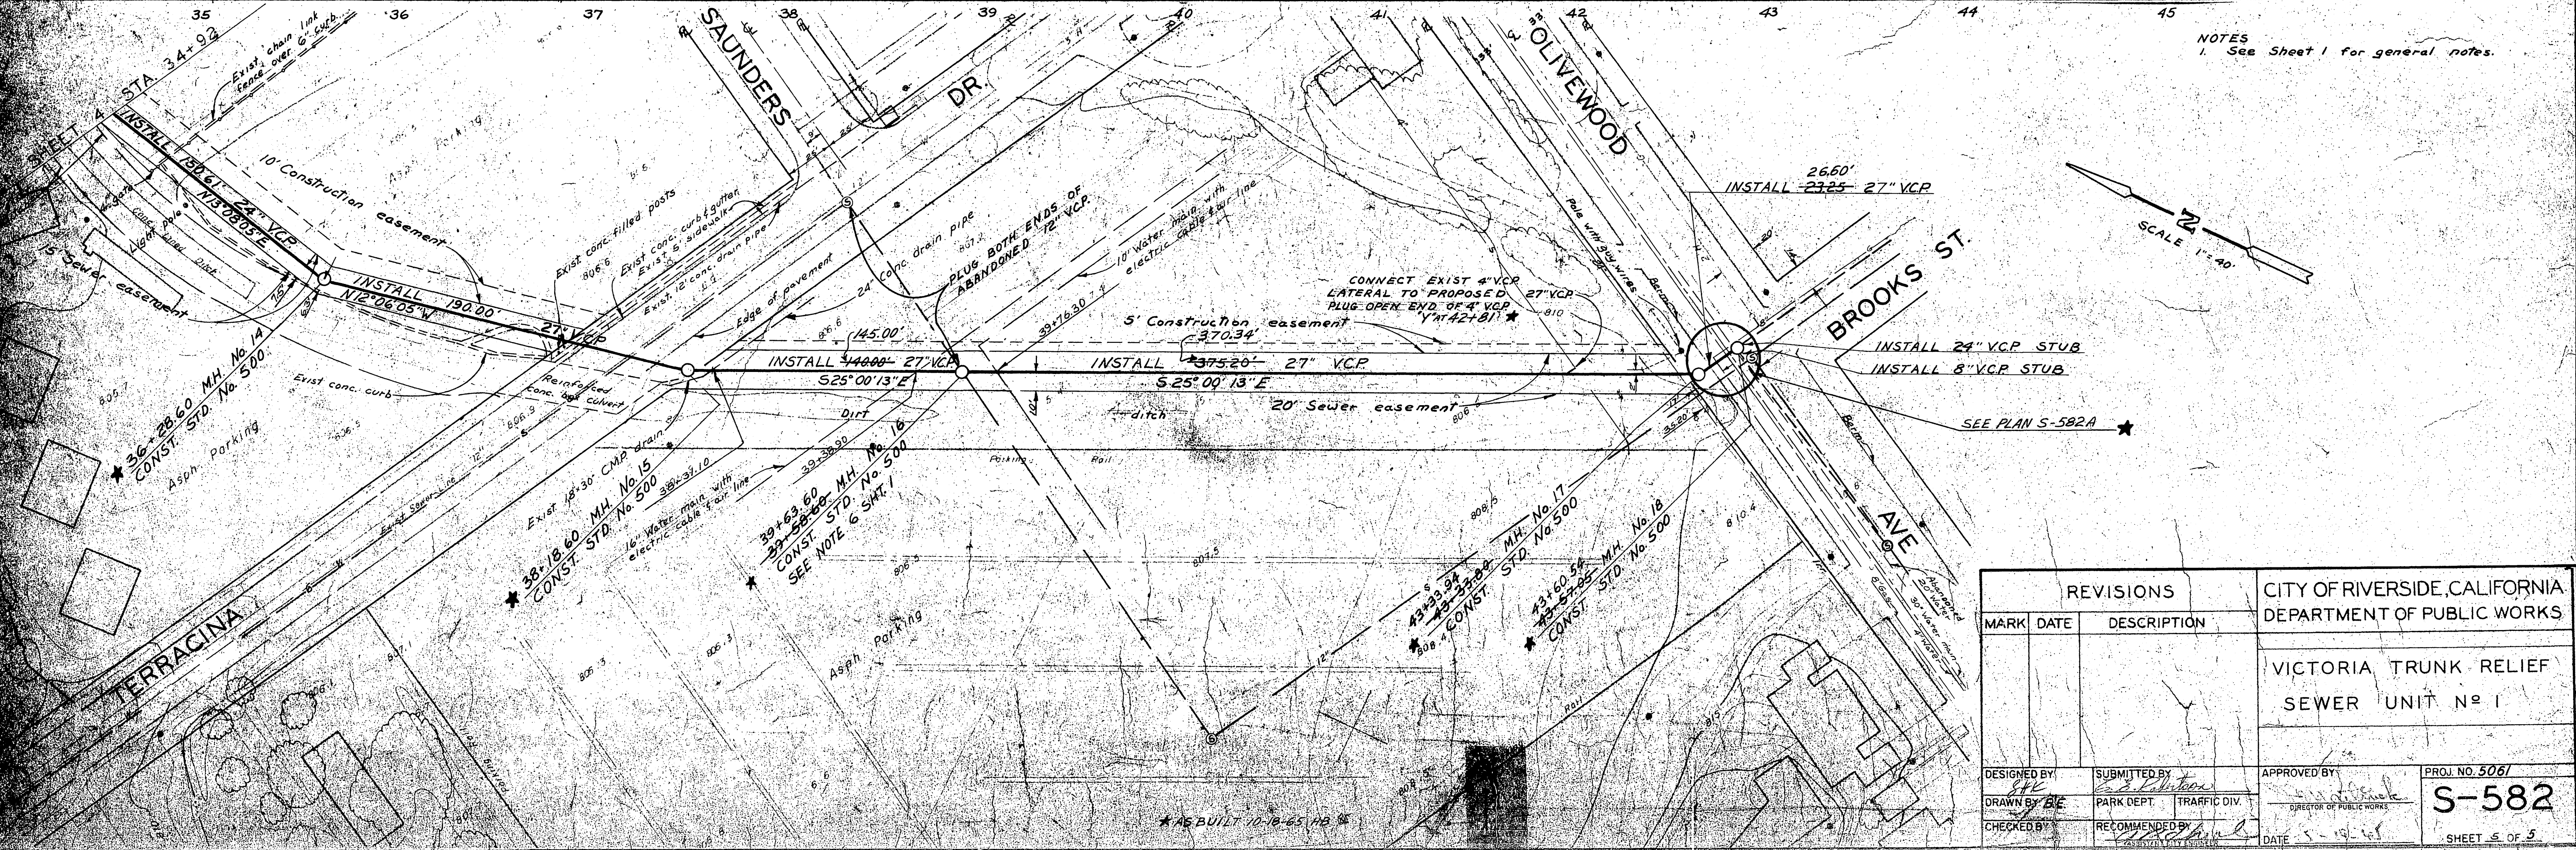


NOTES
 1. See Sheet 1 for general notes.

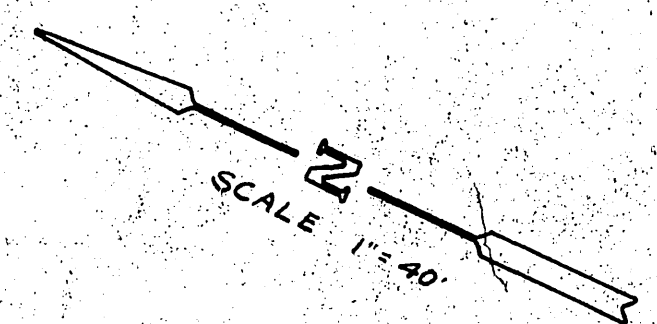

REVISIONS			CITY OF RIVERSIDE, CALIFORNIA DEPARTMENT OF PUBLIC WORKS	
MARK	DATE	DESCRIPTION		
			VICTORIA TRUNK RELIEF SEWER UNIT NO. 1	
DESIGNED BY	SUBMITTED BY	APPROVED BY	PROJ. NO. 5061	
DRAWN BY	PARK DEPT.	TRAFFIC DIV.	S-582	
CHECKED BY	RECOMMENDED BY	DATE	SHEET 5 OF 5	

RIVERSIDE, CALIFORNIA

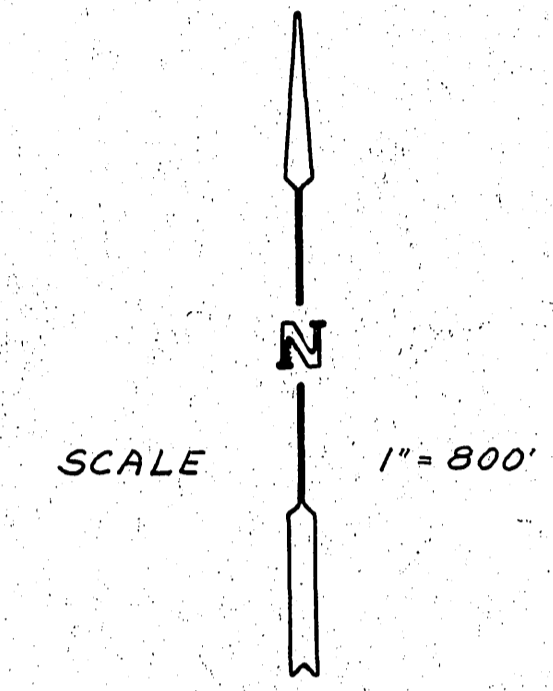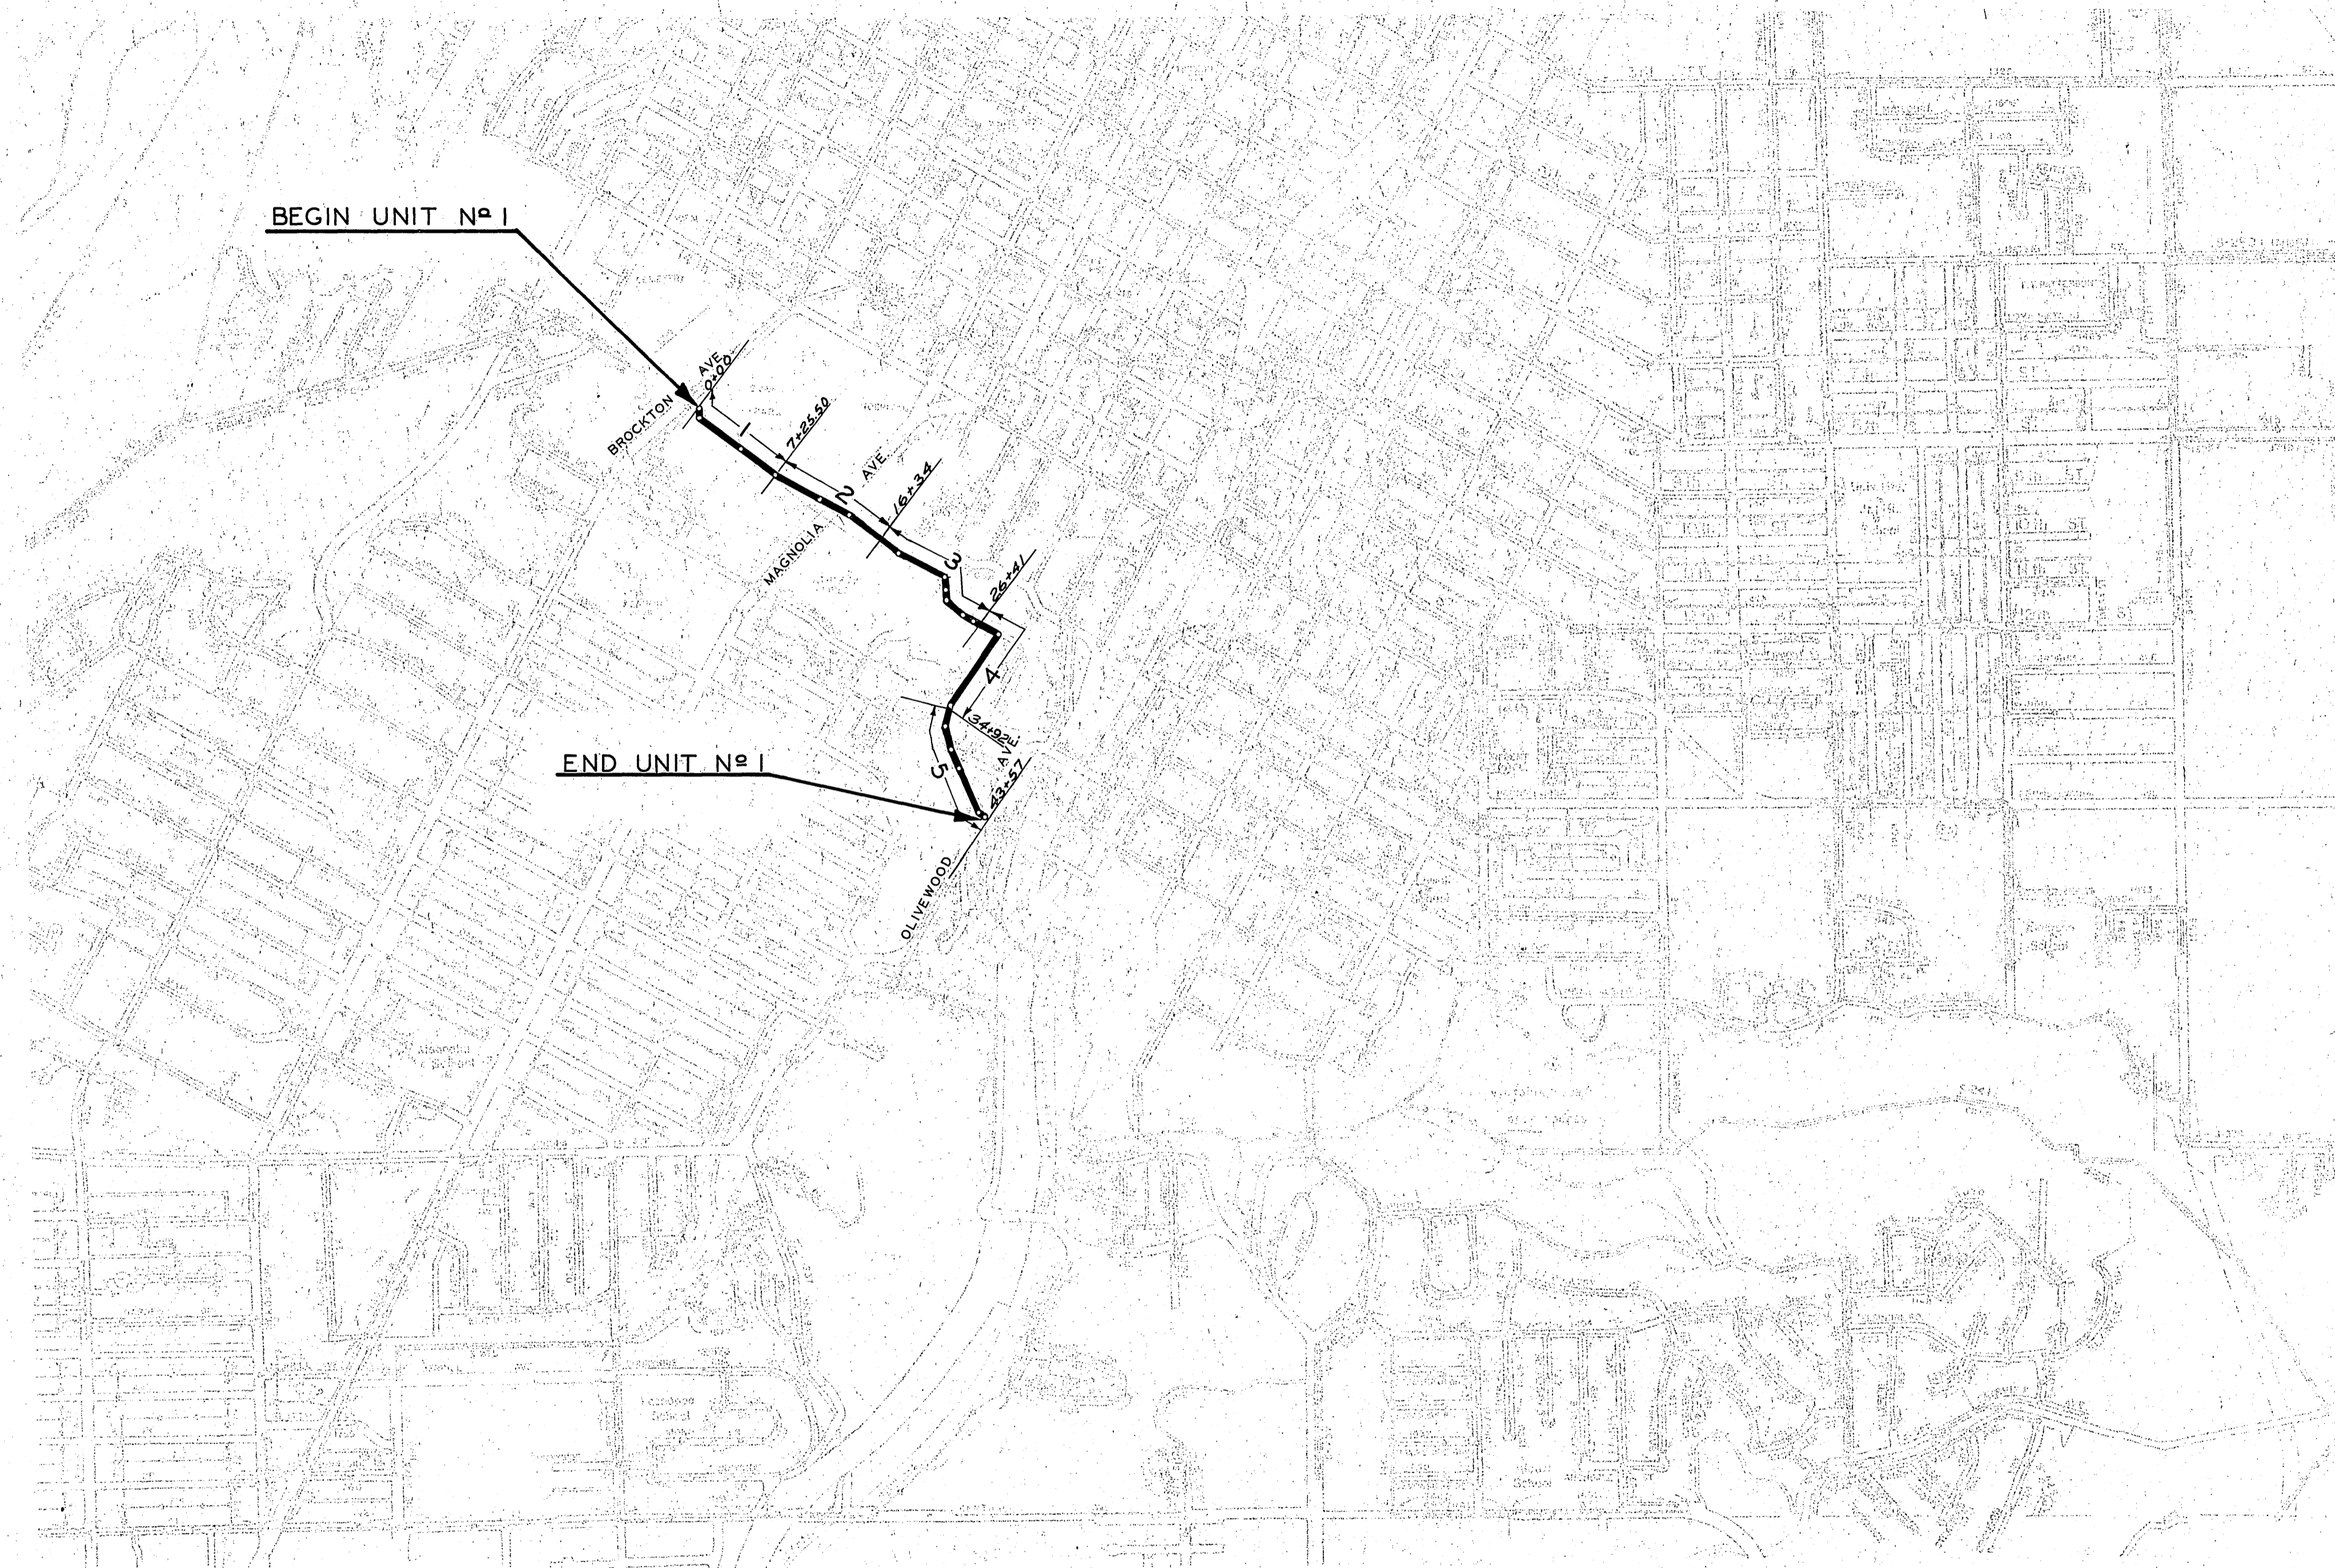


VICINITY MAP
VICTORIA TRUNK RELIEF SEWER
UNIT No 1

S-582
[Signature]

S-582

RIVERSIDE, CALIFORNIA

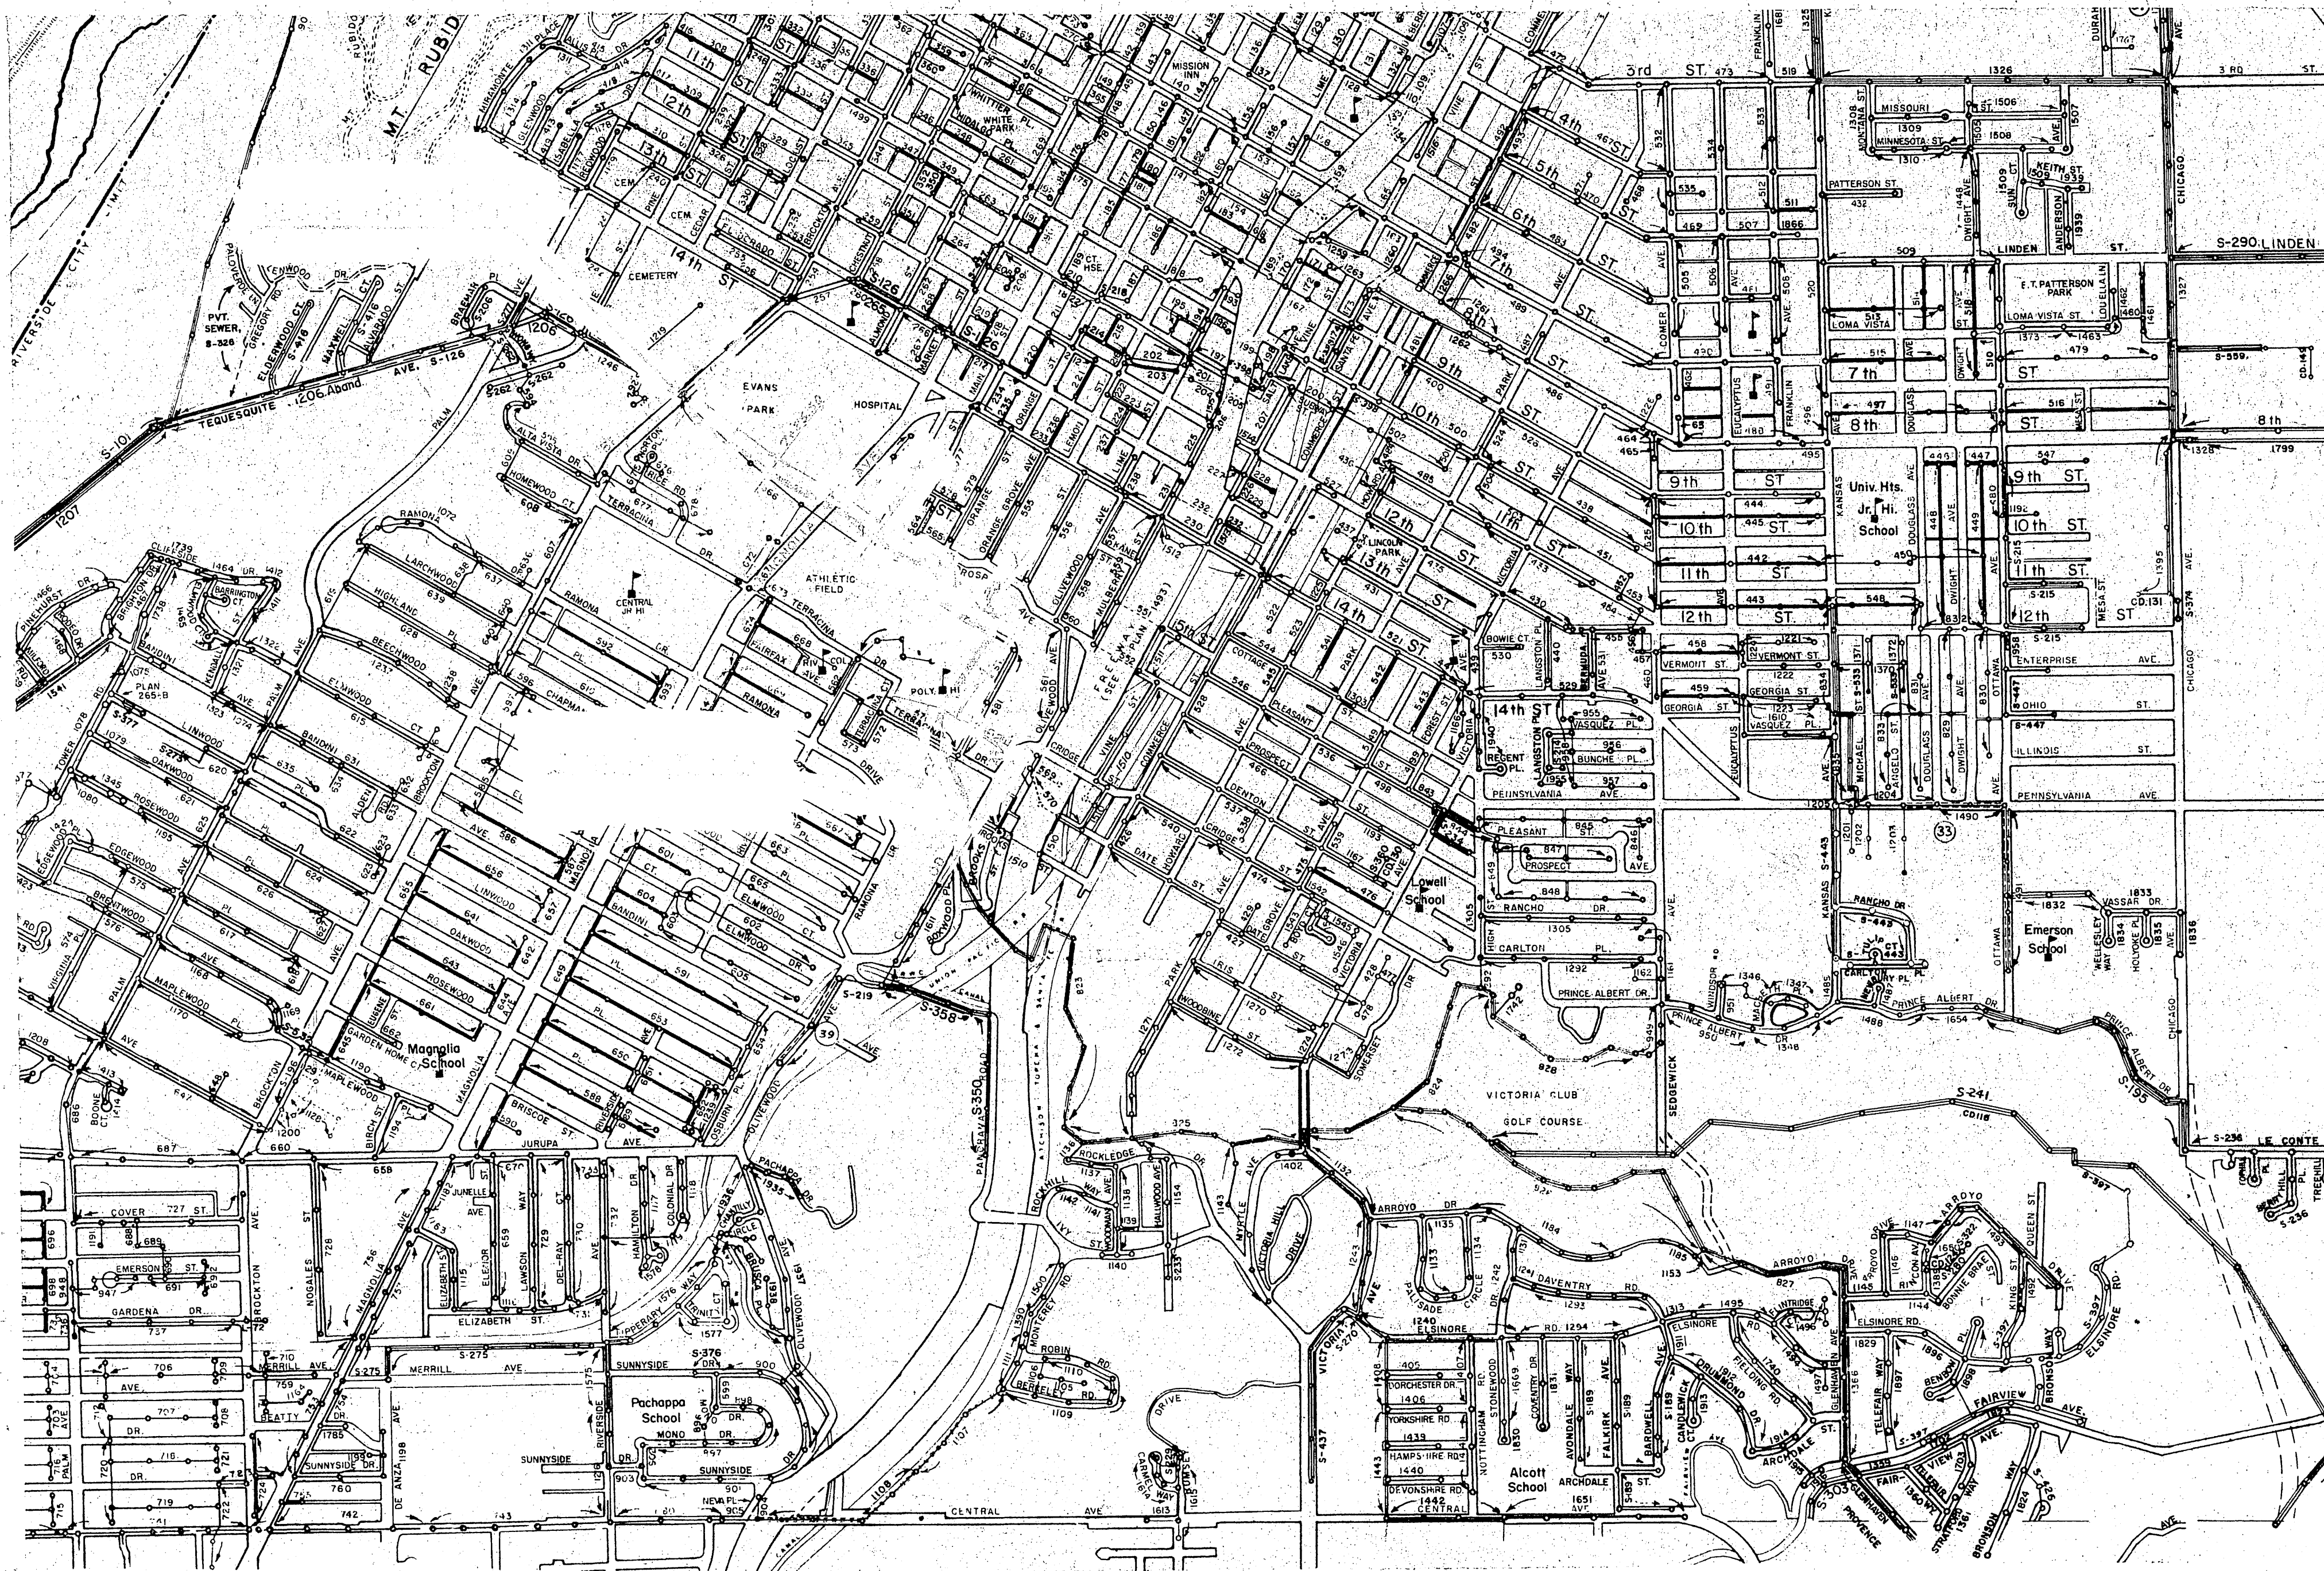


VICINITY MAP



VICTORIA TRUNK RELIEF SEWER

UNIT NO. 1

808
807
806
805
804
803
802
801
800
799
798

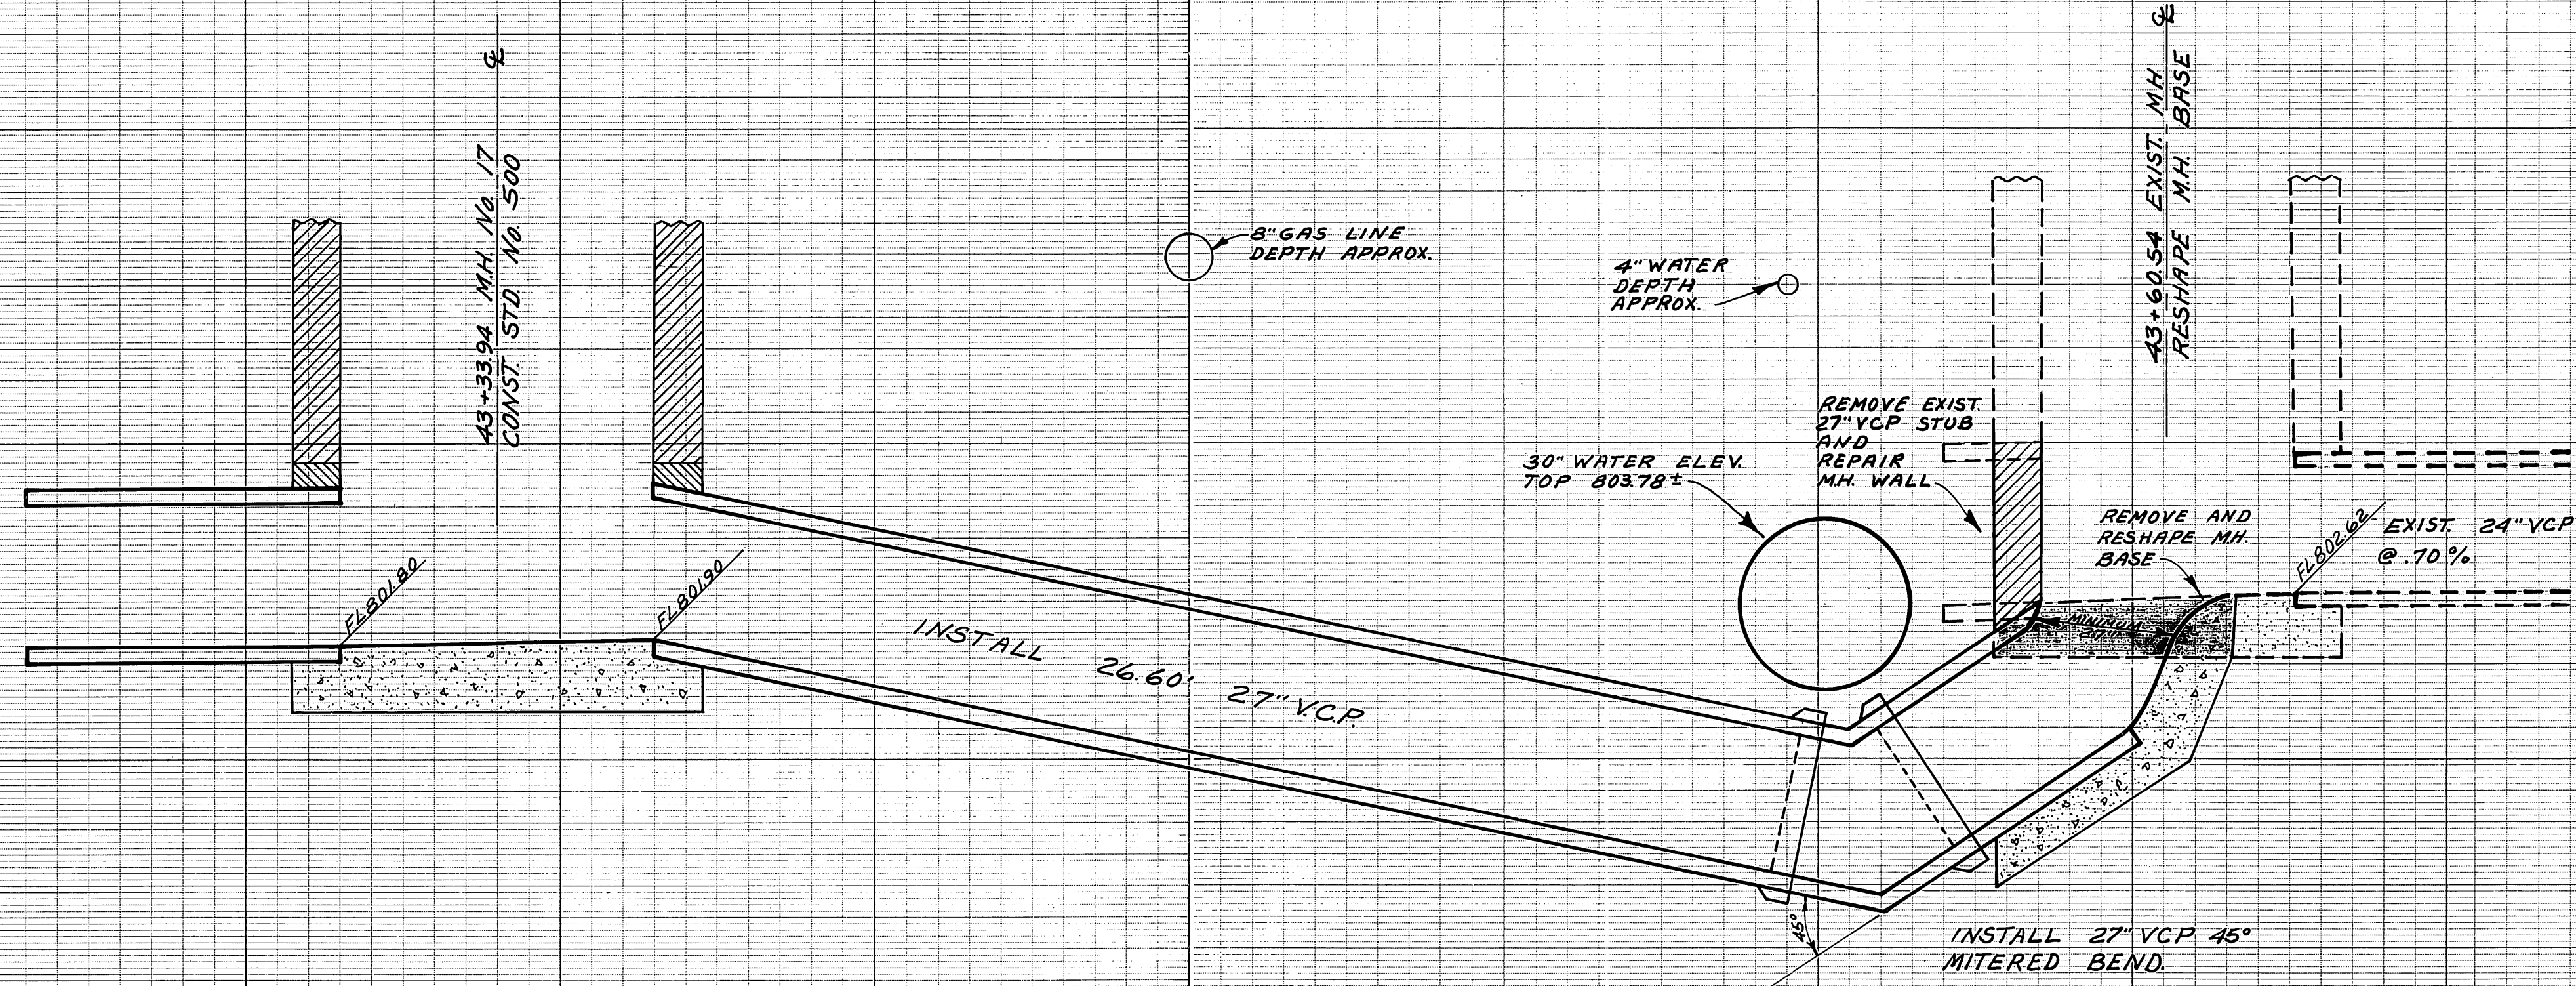


SCALES
HOR. & VERT.
1" = 2'

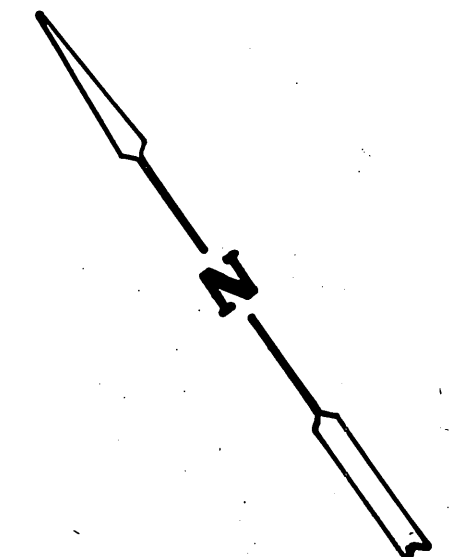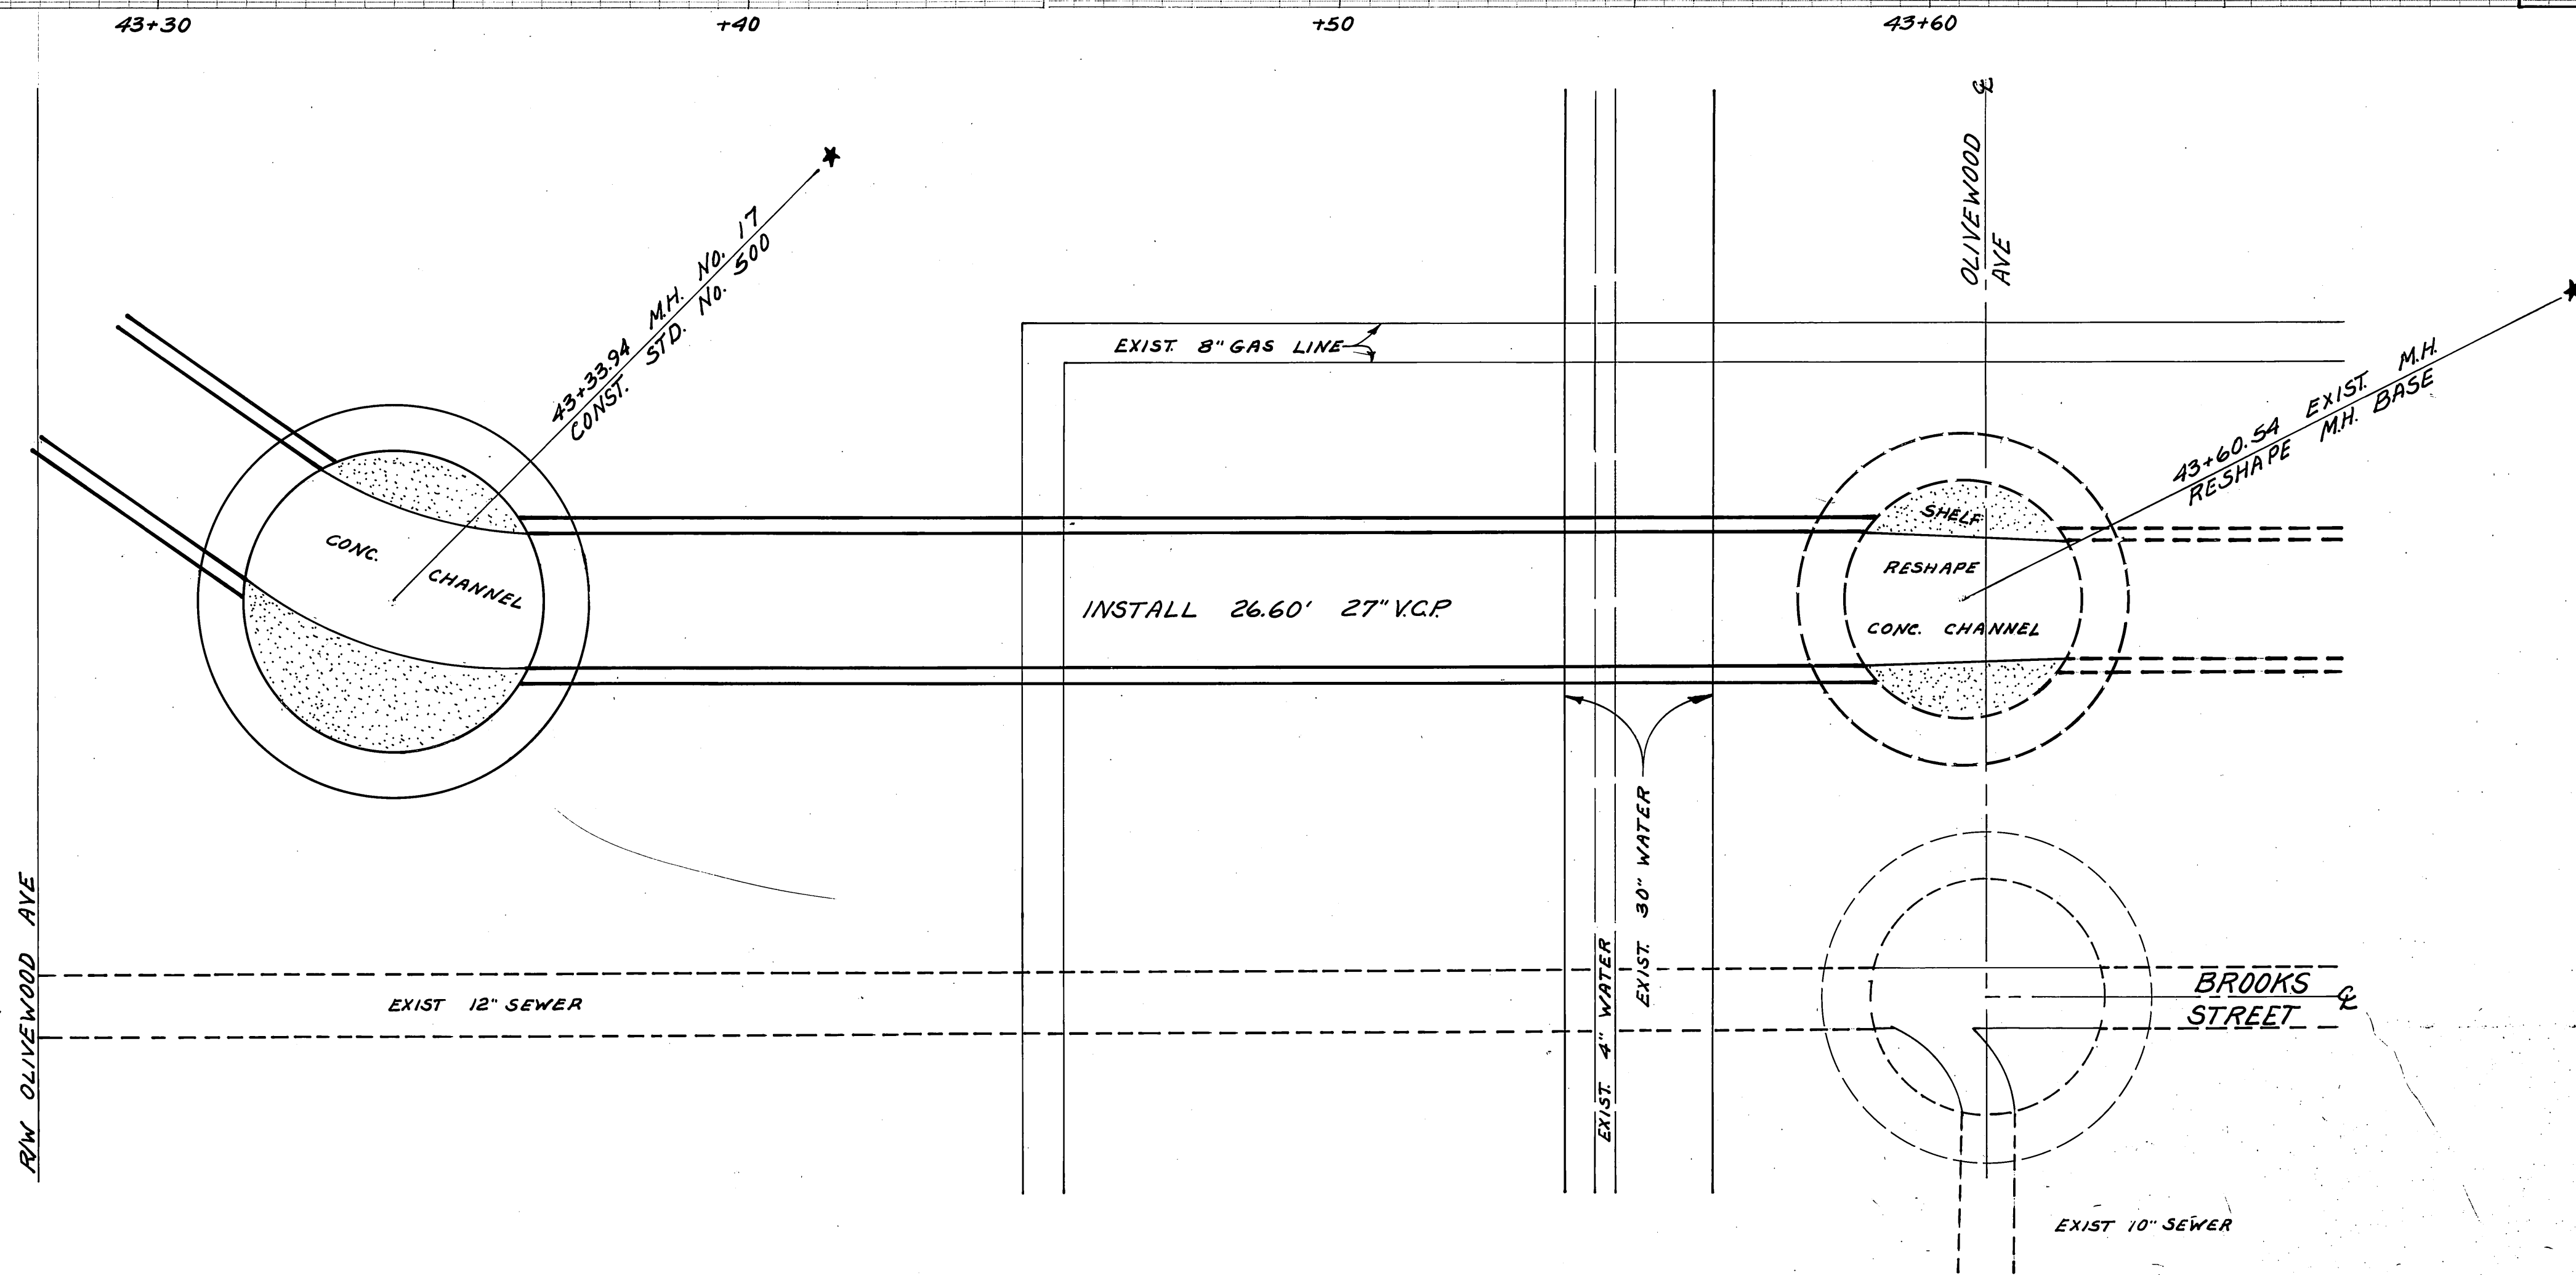


★ AS BUILT 10-18-65 HB 2E

CITY OF RIVERSIDE, CALIFORNIA DEPARTMENT OF PUBLIC WORKS				VICTORIA TRUNK RELIEF SEWER SIPHON		PROJECT NO. 5061
APPROVED BY	DATE	APPROVED BY	DATE	SHEET 1 OF 1		FILE NO.
DESIGNED BY	REVISIONS	APPR.	DATE	HORIZ. SCALE: 1" = 2'		
DRAWN BY		CHECKED BY		VERT. SCALE: 1" = 2'		

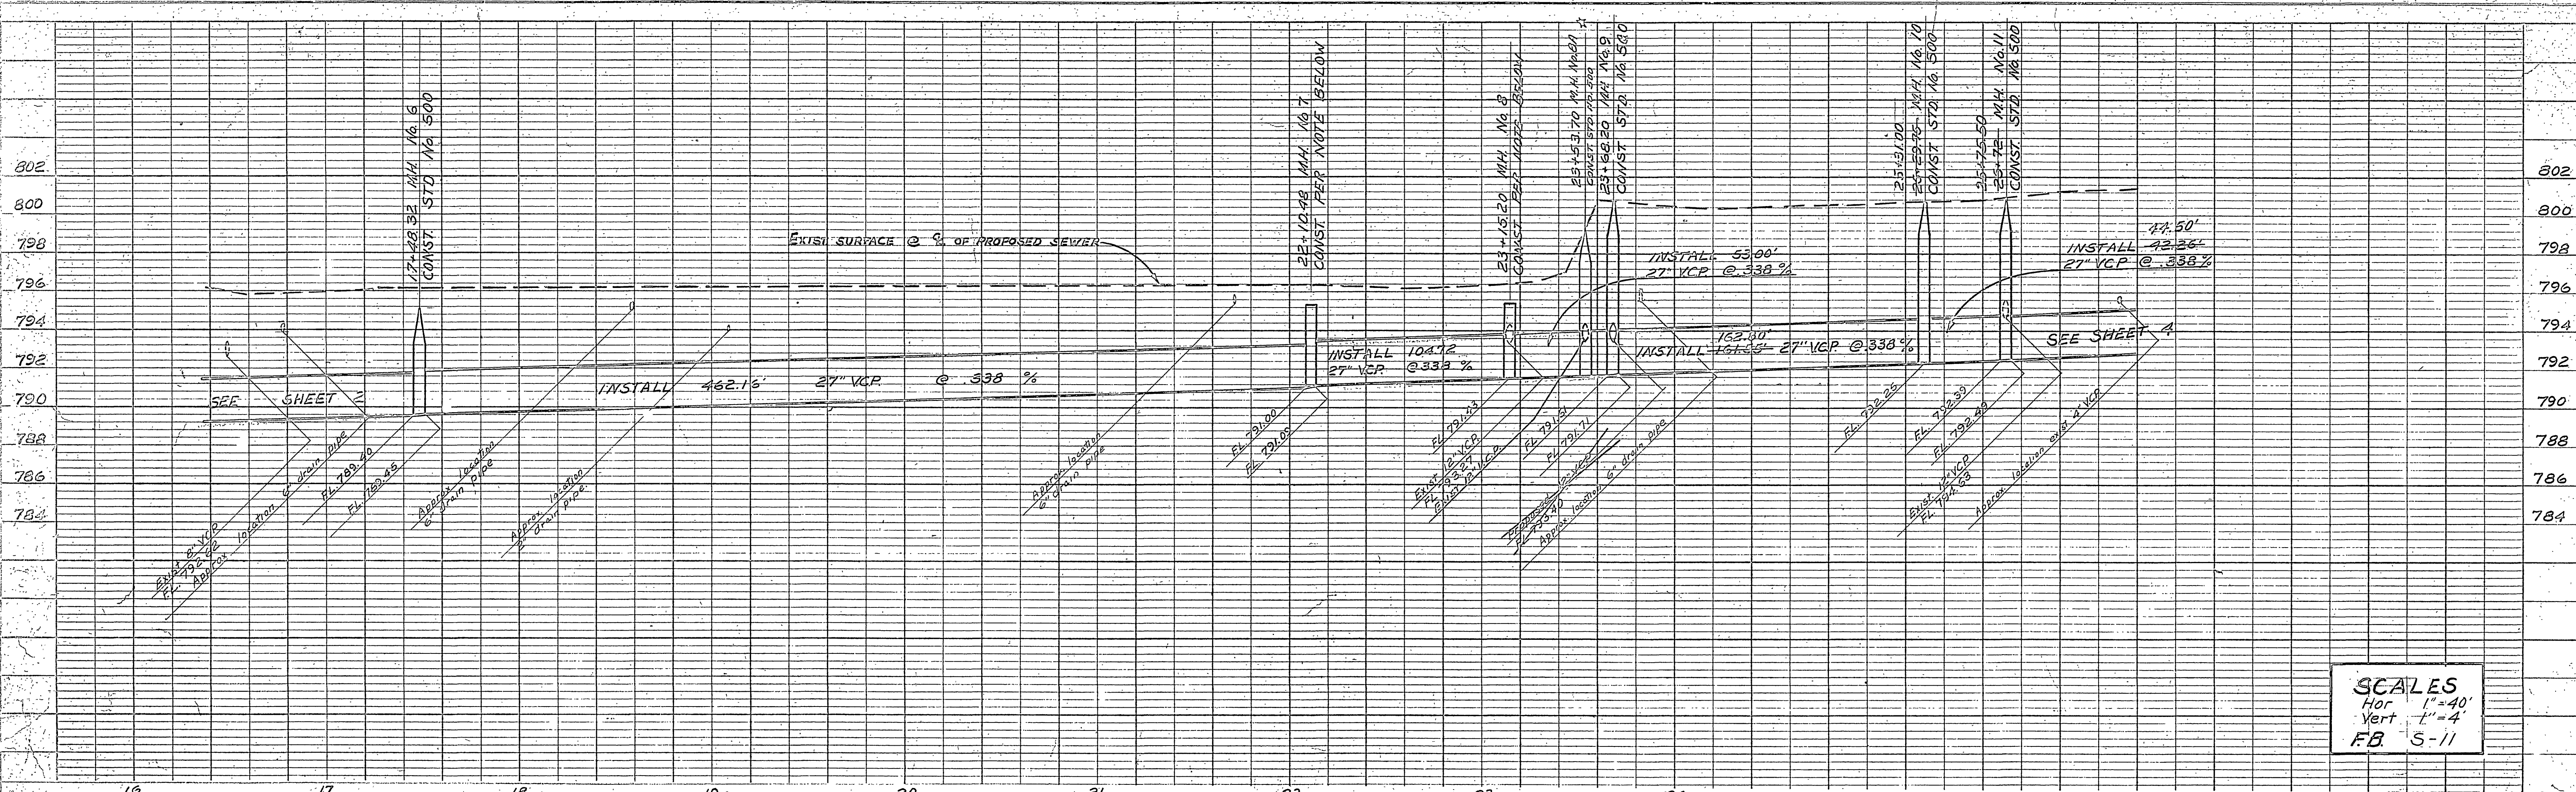


SCALES
 Hor 1"=40'
 Vert 1"=4'
 FB 5-11

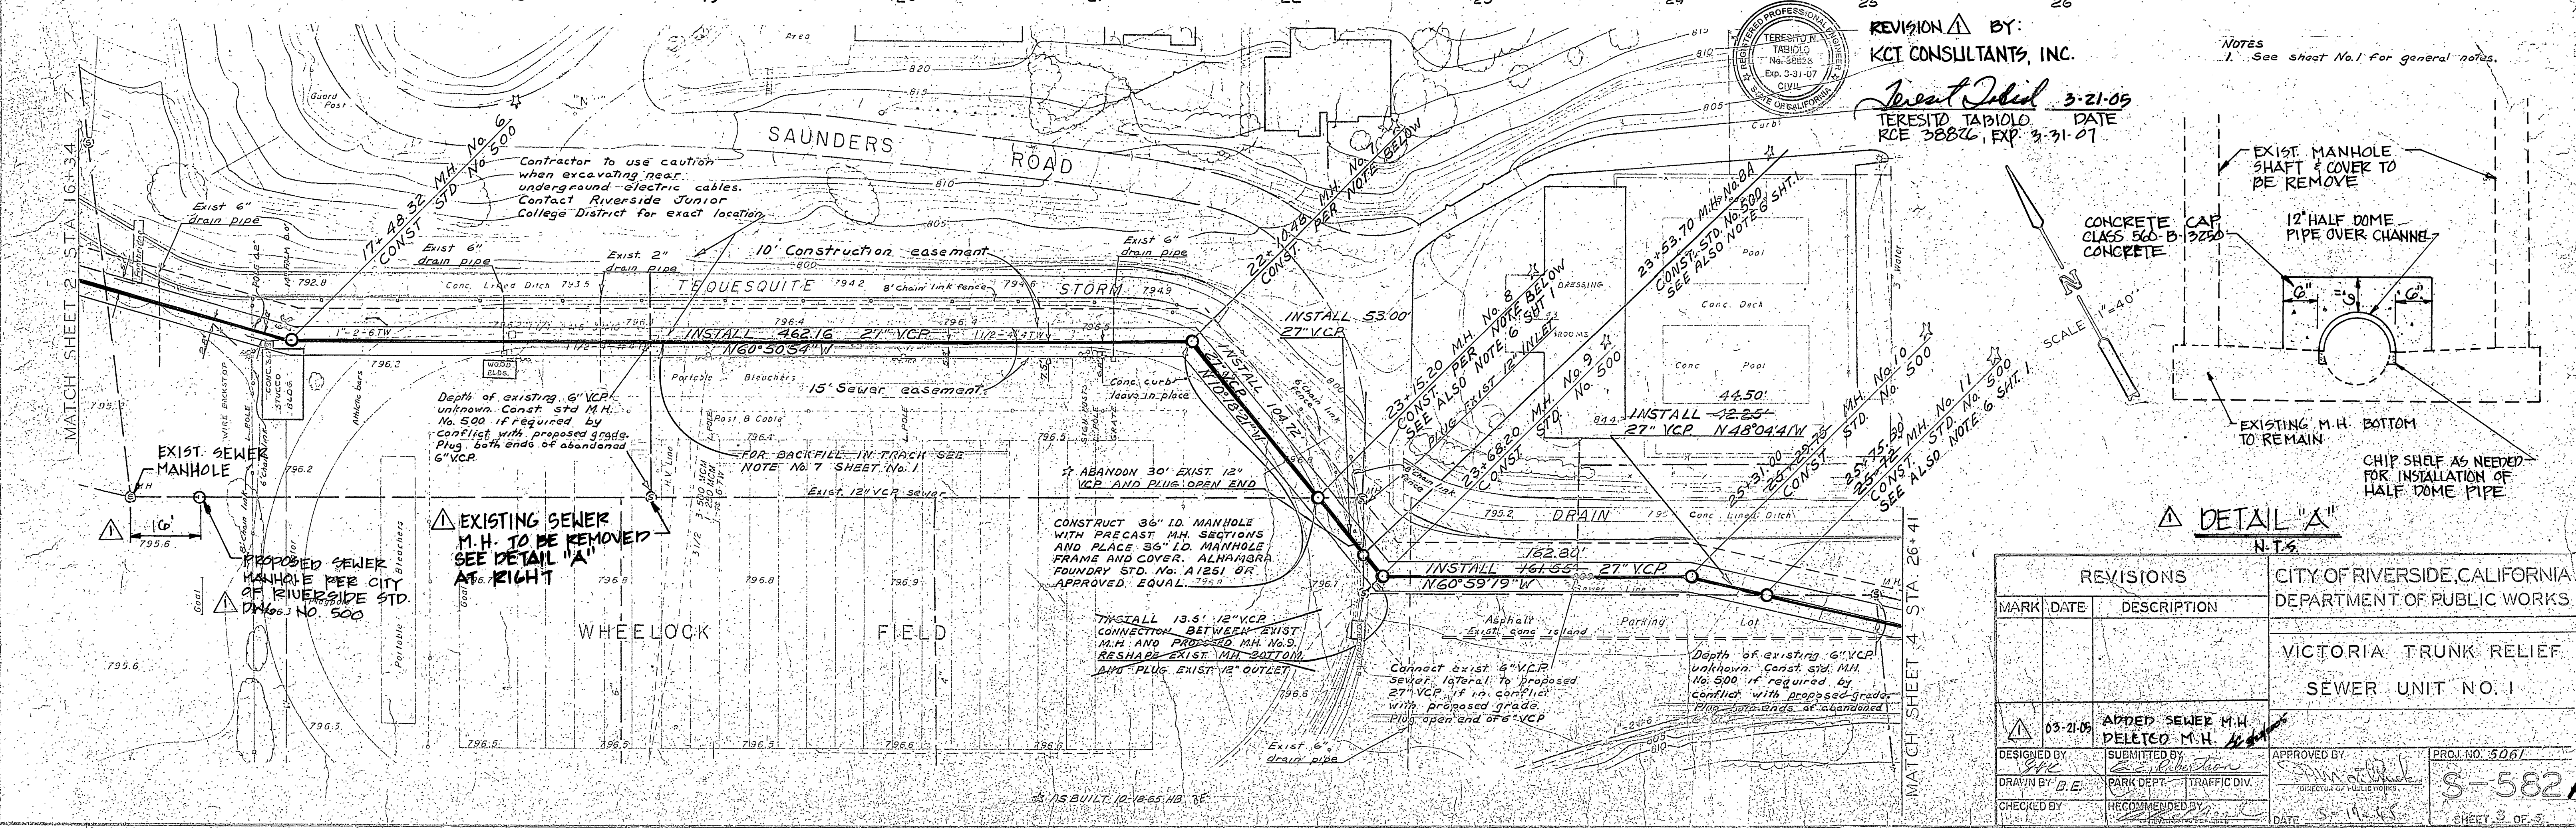

REVISION Δ BY:
 KCT CONSULTANTS, INC.

Teresita Tapiolo 3-21-05
 TERESITA TAPIOLO DATE
 RCE 38826, EXP. 3-31-07

Notes
 1. See sheet No. 1 for general notes.

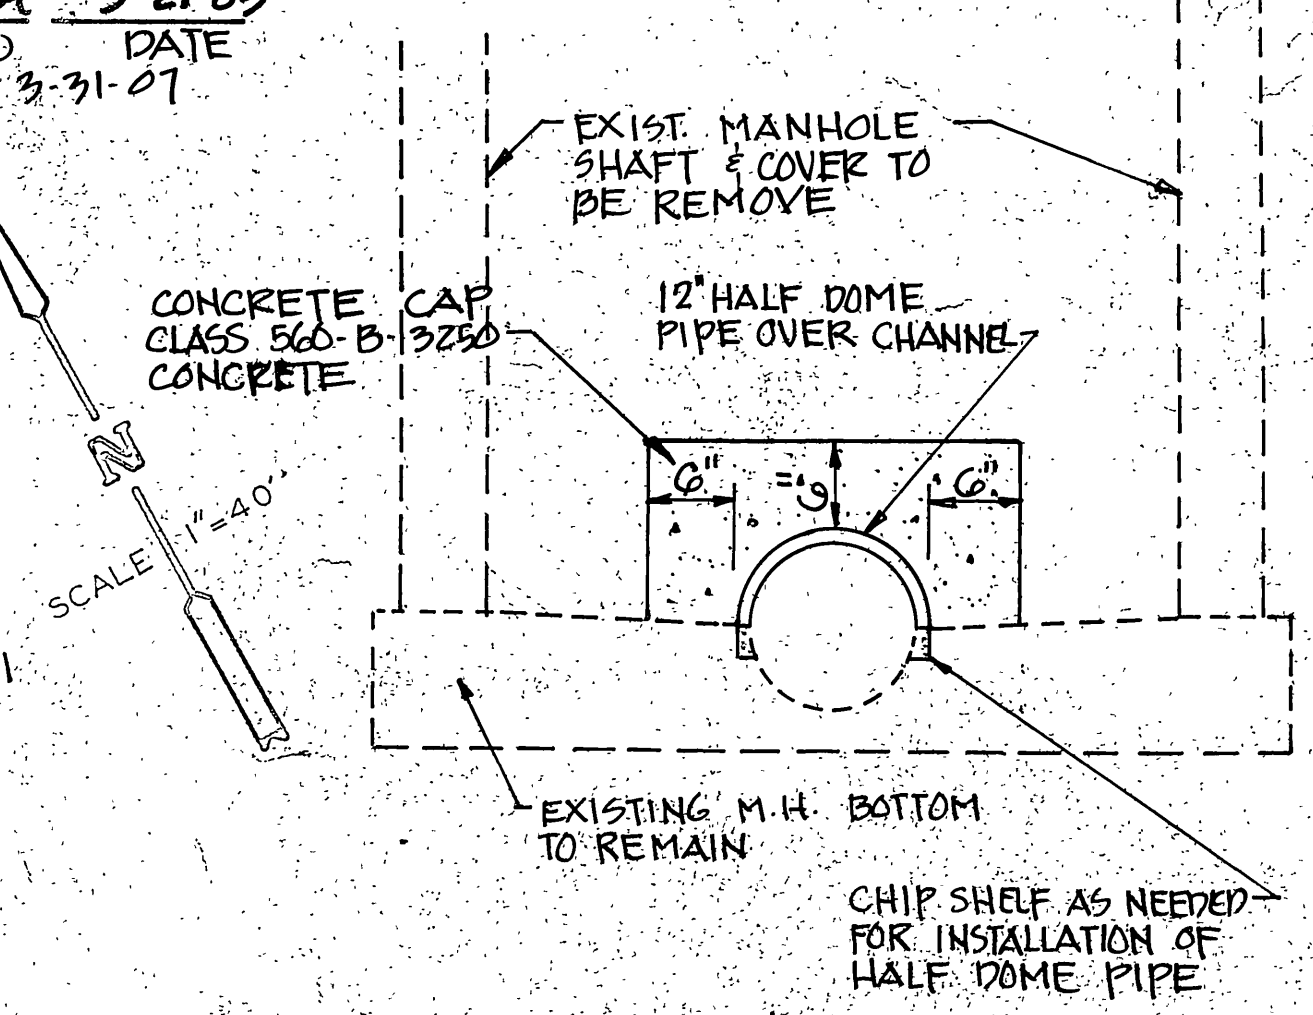

REVISIONS

MARK	DATE	DESCRIPTION
Δ	03-21-05	ADDED SEWER M.H. DELETED M.H. 25+43.70

CITY OF RIVERSIDE, CALIFORNIA
 DEPARTMENT OF PUBLIC WORKS

VICTORIA TRUNK RELIEF
 SEWER UNIT NO. 1

DESIGNED BY: *B.E.* SUBMITTED BY: *B.E.* APPROVED BY: *[Signature]* PROJ. NO. 506
 DRAWN BY: *B.E.* PARK DEPT. TRAFFIC DIV. DATE: 3-11-05
 CHECKED BY: *[Signature]* RECOMMENDED BY: *[Signature]* **S-582AA** SHEET 3 OF 5