


Scale: Horiz. 1" = 50'
Vert. 1" = 10'

BENCH MARK: Elev 818.81; F.B. 55916
Brass cap in 2" I.P. & Central @ 13+31.03

GENERAL NOTES:

1. Construction shall be in accordance with the City of Riverside, Department of Public Works, Standard Specifications No. 461 and Standard Drawings.
2. It shall be the responsibility of the contractor to clear the right of way in accordance with the provisions of the law as it affects each utility, including irrigation lines and appurtenances and at no cost to the City.
3. Joints in vitrified clay pipe sewer shall conform to ASTM Standard C-425-60T, or the latest revision thereof.
4. Pipe shall be bedded per Case II, Standard Drawing No. 452 unless otherwise specified on plan.

NOTICE TO CONTRACTOR: The existence and location of any underground utility pipes or structures shown on these plans are obtained by a search of the available records. To the best of our knowledge, there are no existing utilities, except as shown on these plans. The Contractor is required to take due precautionary measures to protect the utility lines shown and any other lines not of record or not shown on these plans.

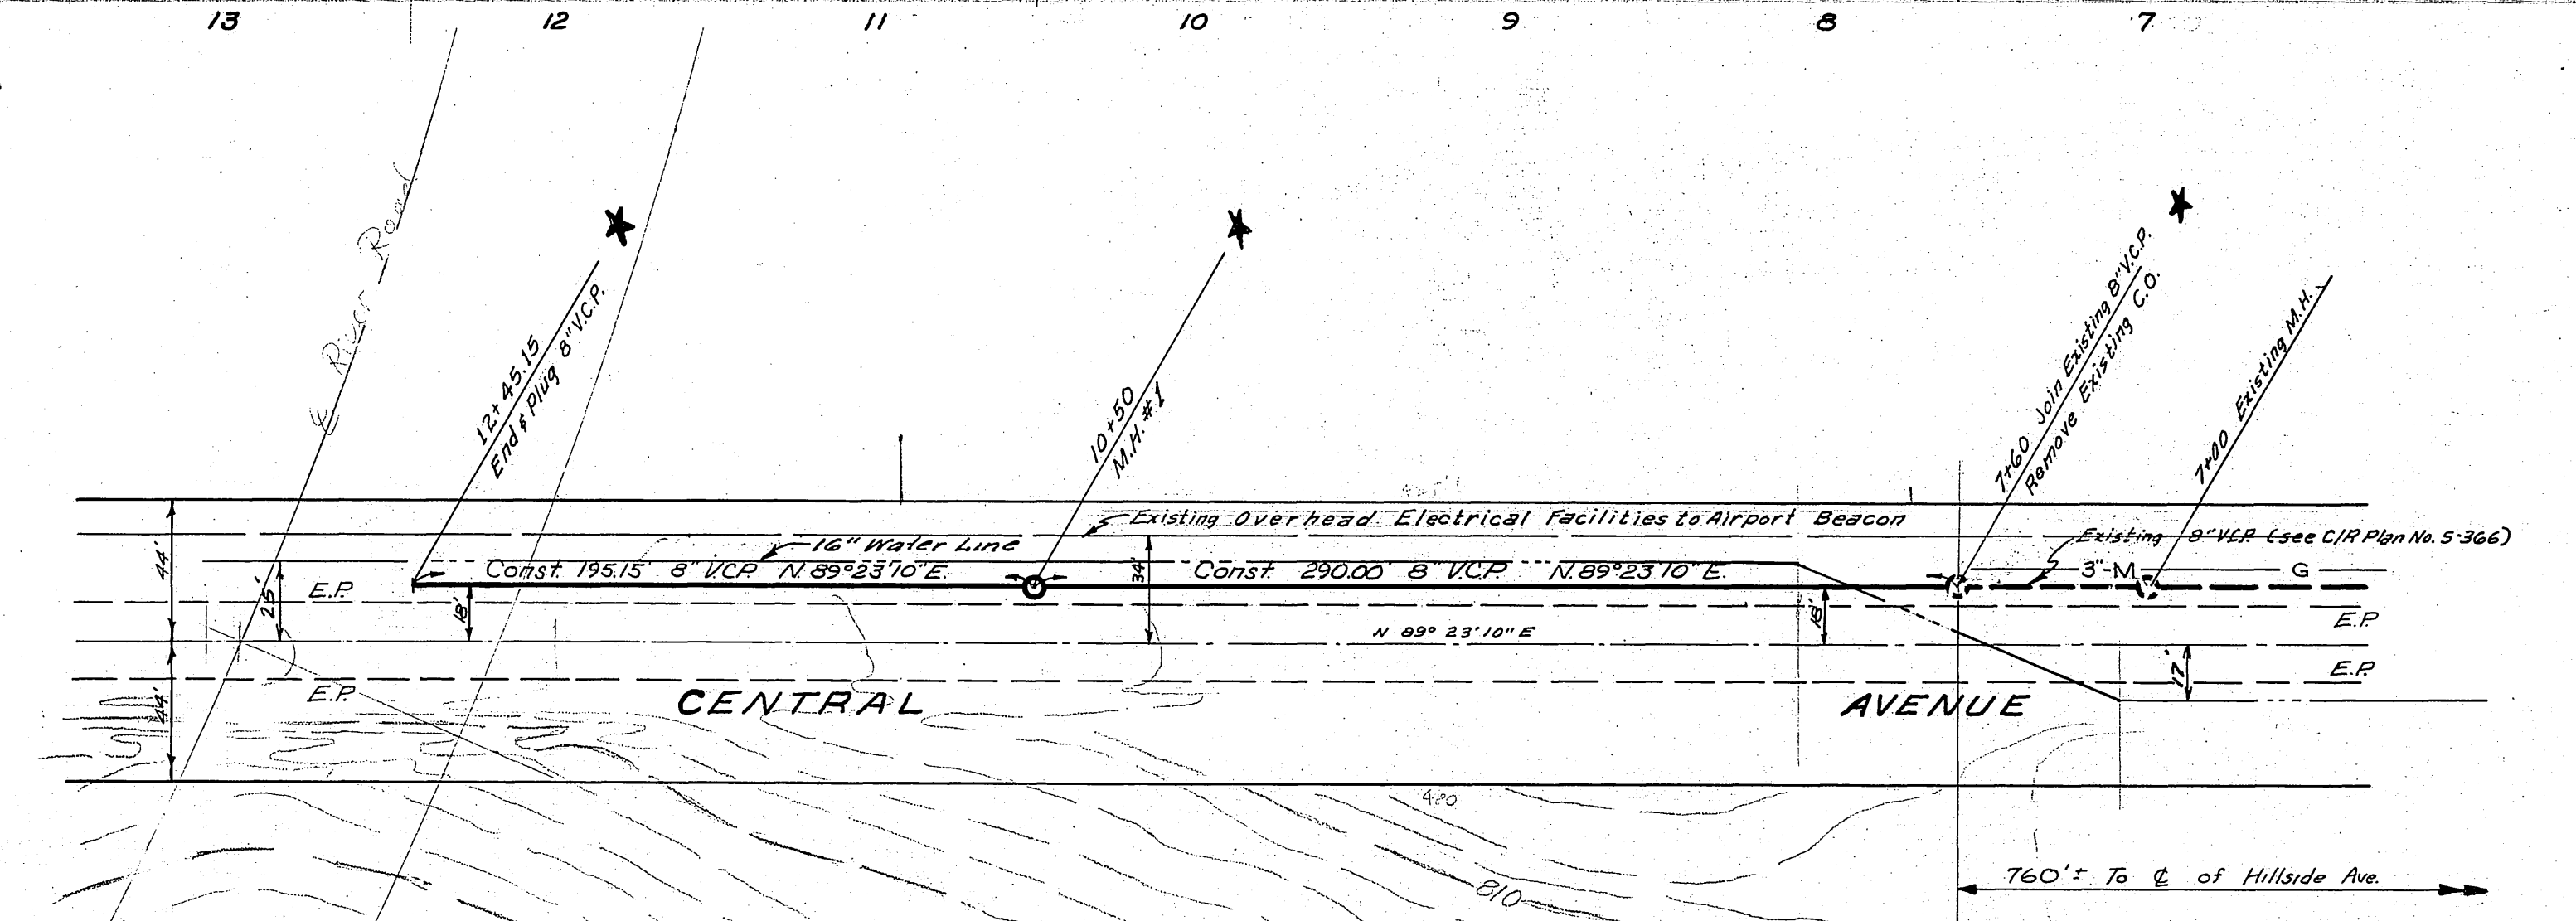

QUANTITY ESTIMATE
8" Vitrified Clay Pipe 485 L.F.
Manhole Standard Dwg. No. 500 1 Ea.

★ AS BUILT 7-19-65 HB

INDEXED R R
SEWER PLAN & PROFILE

CENTRAL AVENUE

TRACT 3025 SEWER EXTENSION

REC
S.E.L.
Date 11/6/64

Bob [Signature]
Emil N. Miller
2-8-65
S-590
1 1

DWG. No. 64-174-B

NO.	DATE	BY

NO.	DATE	BY