


ENGINEER'S NOTE
 Top of M.H. Elevations to be determined
 by Field Engineer if not shown on Profile.

BENCH MARKS

City B.M. - Pk. Spike & Load in Sky end of Wly H.W. at Monroe St & California Ave	Elev. 759.23
City B.M. - RR Spike in RR #4030704 NWly Cor Colorado Av. & Jackson St	Elev. 750.32
T.B.M. - Wly end of Ely H.W. at Sky OHOT	Elev. 747.97

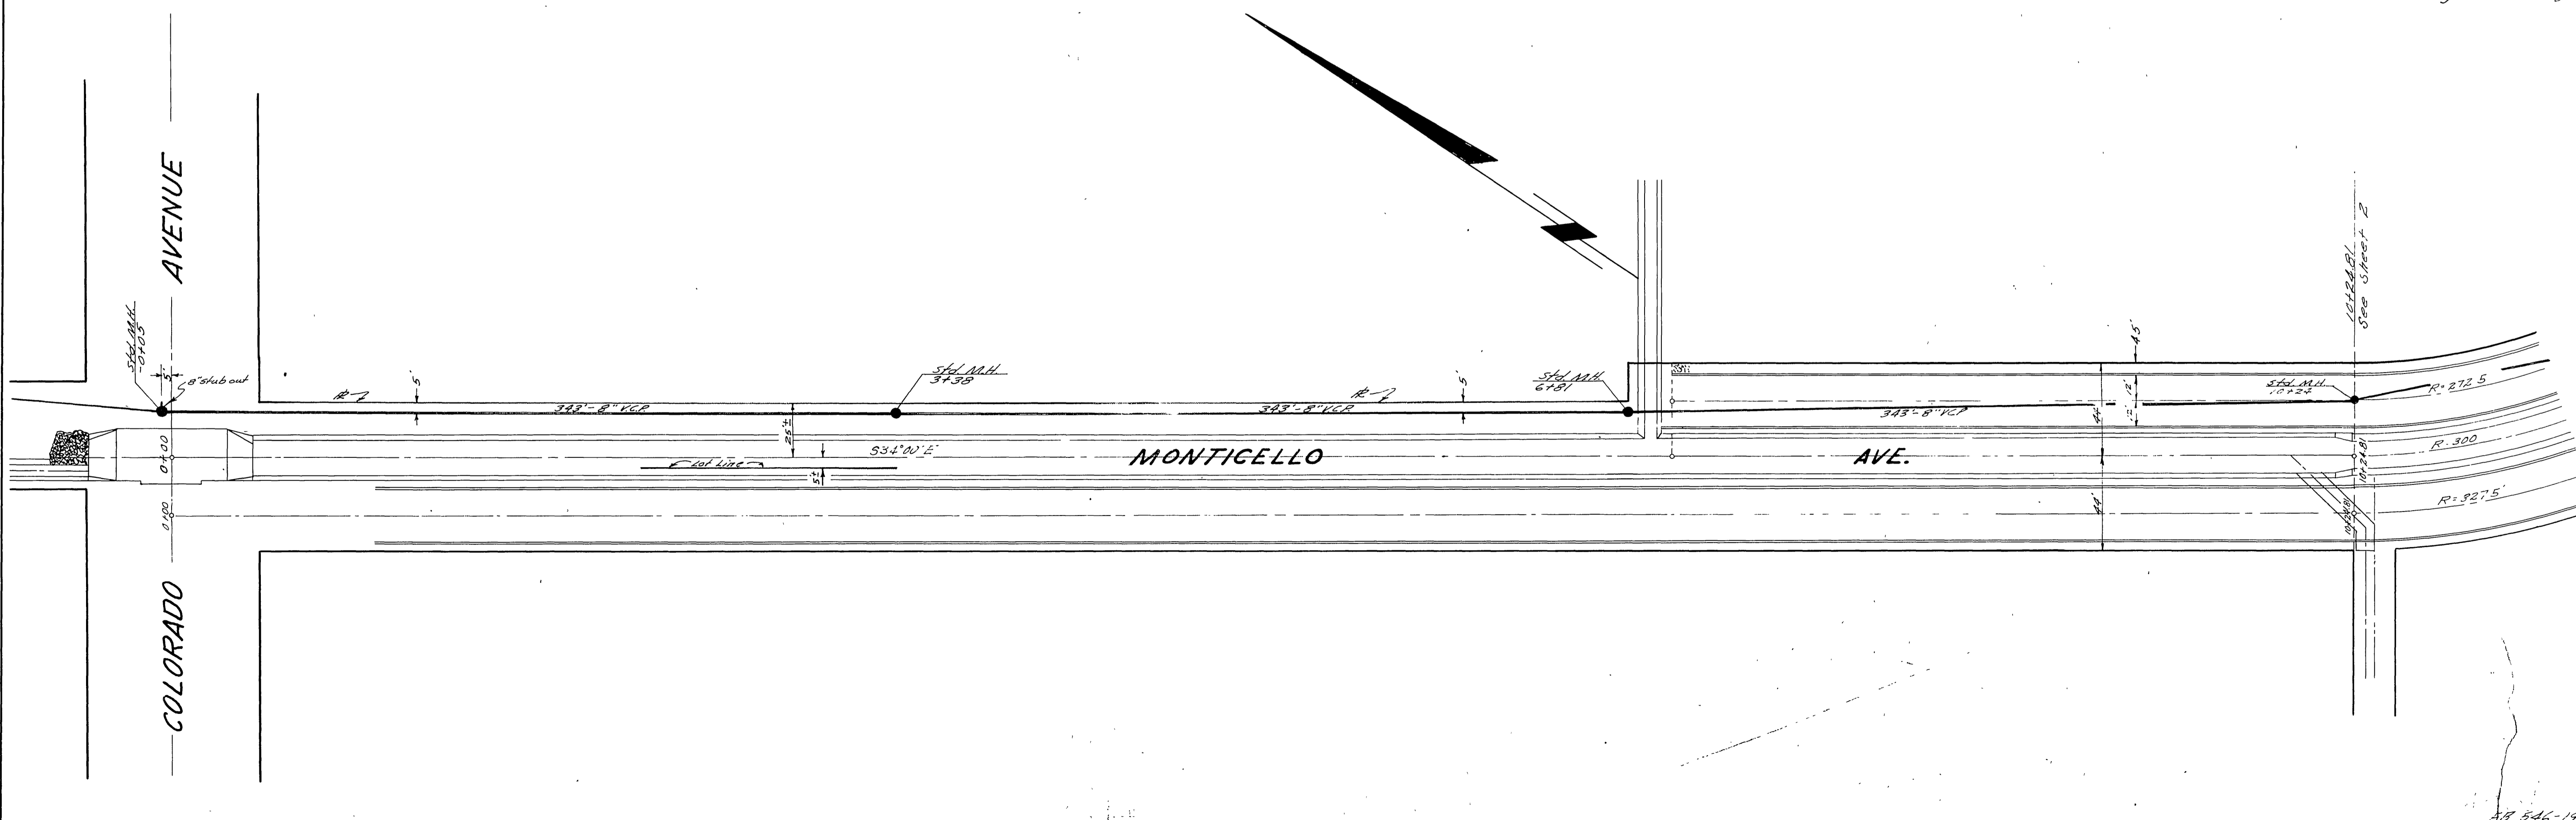

J.F. DAVIDSON-CIVIL ENGINEER
 RE No 862
 RIVERSIDE, CALIFORNIA
 APPROVED BY *[Signature]* DATE 3/6/66

CITY OF RIVERSIDE, CALIFORNIA
 DEPARTMENT OF PUBLIC WORKS

SEWER PLAN & PROFILE
MONTICELLO AVE.

VILLA d' ESTE #2
 HORIZ SCALE 1"=40' VERT SCALE 1"=4'



APPROVED BY *[Signature]*
 Director of Public Works

DATE March 22, 1966

NO. S-5A
 SHEET 1 OF 2

FB 546-6

FB 546-19

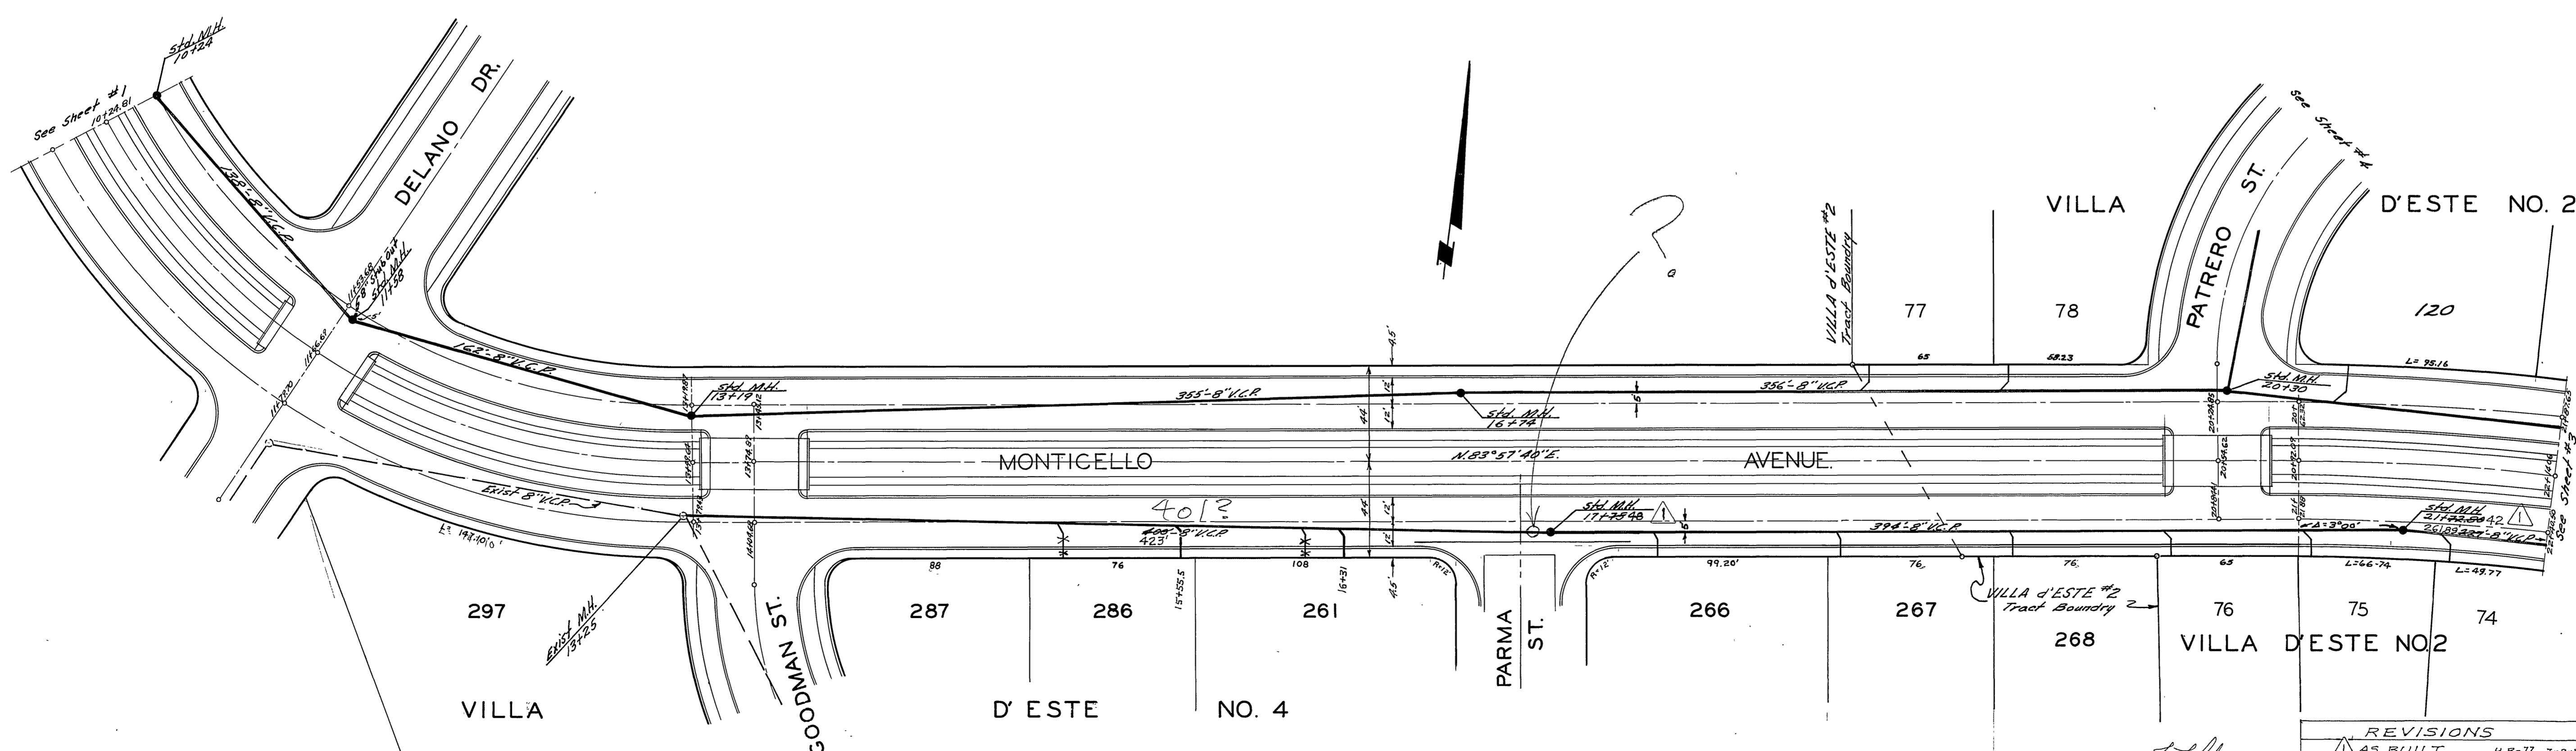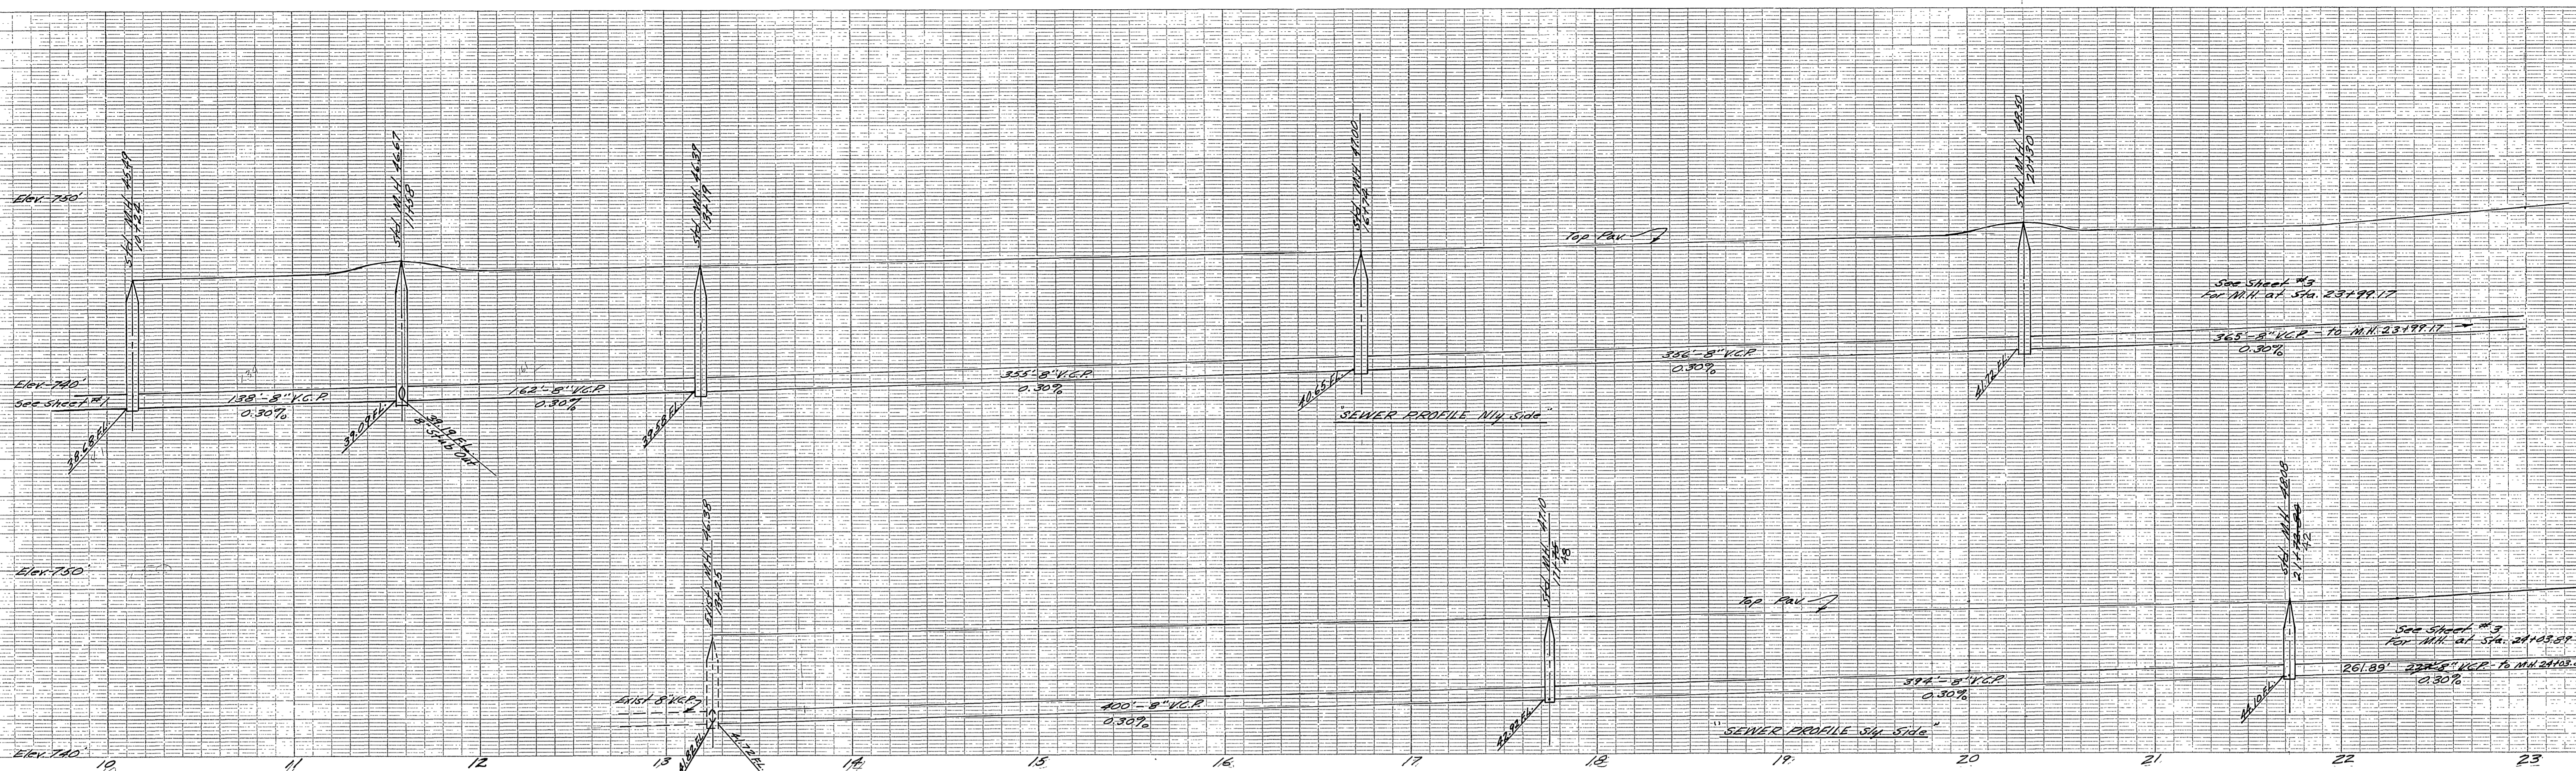

J.F. DAVIDSON - CIVIL ENGINEER
 R.E. No 862
 RIVERSIDE, CALIFORNIA
 APPROVED BY *Jim Davidson* DATE 3/6/56

CITY OF RIVERSIDE, CALIFORNIA
 DEPARTMENT OF PUBLIC WORKS

SEWER PLAN & PROFILE
MONTICELLO AVE.

VILLA D'ESTE #2 & 4



HORIZ. SCALE 1"=40' VERT. SCALE 1"=4'

REVISIONS	
AS BUILT	H.B. 7-2-55
ADDED NO. 4	B.L.O.W. 9-12-58
	F.B. 5-6-19



APPROVED BY *John Montello*
 Director of Public Works

NO. S-5A
 DATE 3-22-56 SHEET 2 OF 8

Revision Approved *J. Holley* Date *3/6/56*
 Acting City Engineer

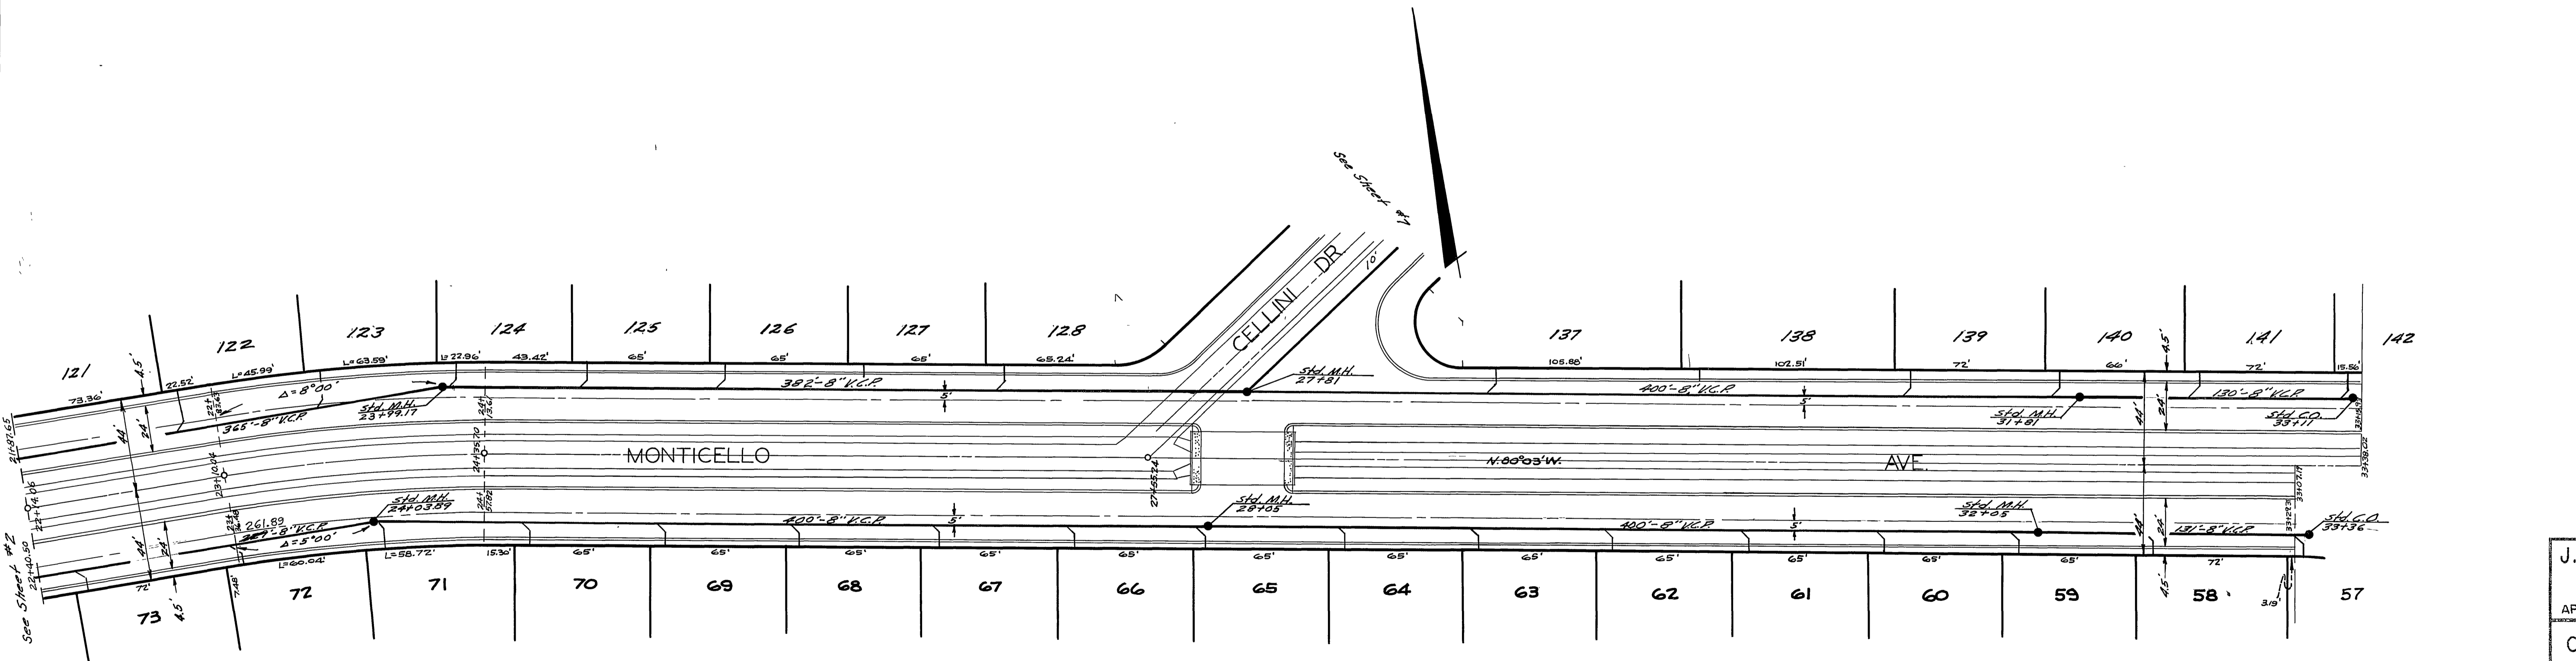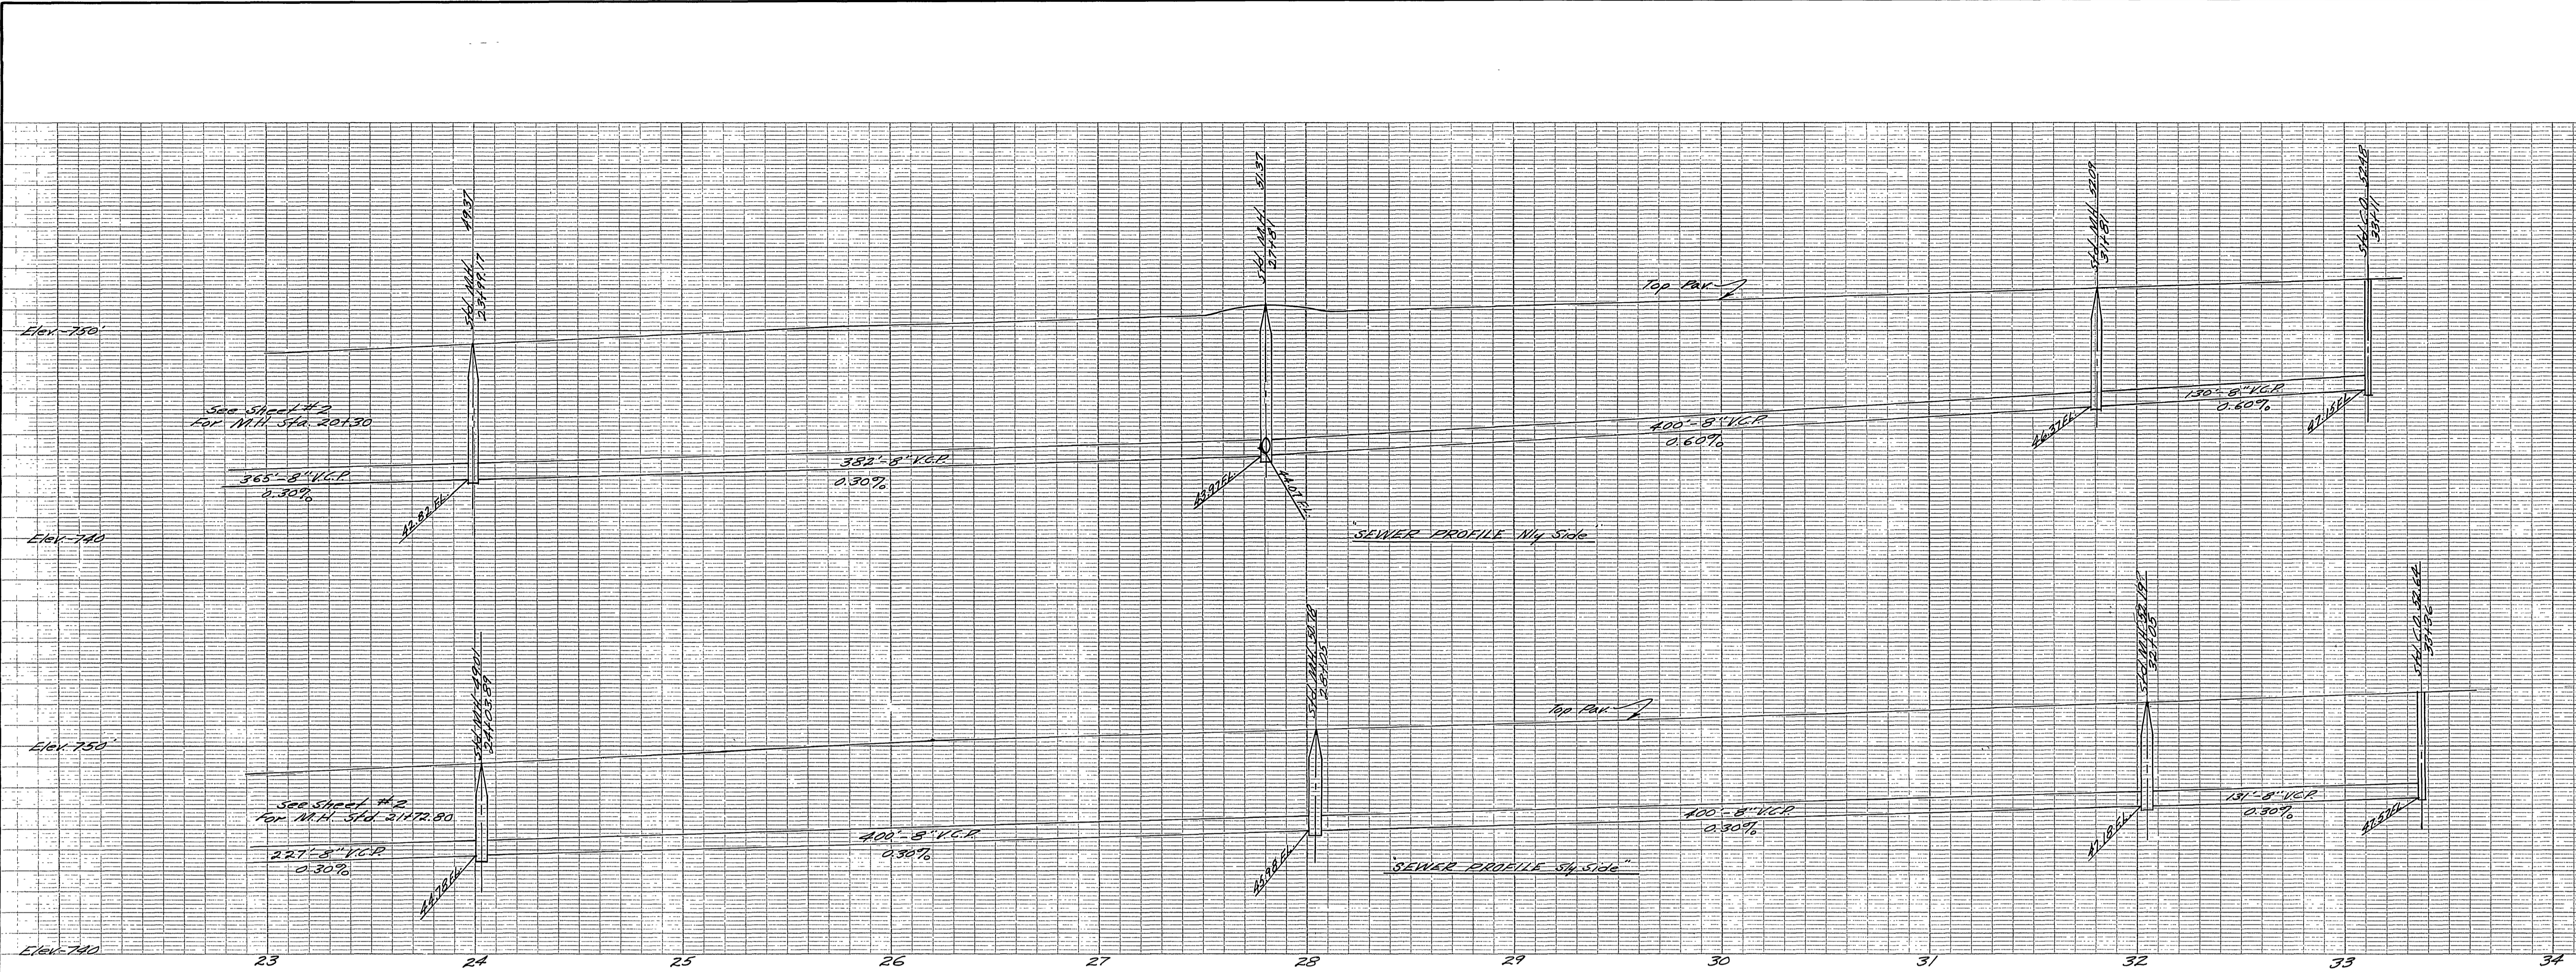

J.F. DAVIDSON-CIVIL ENGINEER
 R.E. No 862
 RIVERSIDE, CALIFORNIA
 APPROVED BY *[Signature]* DATE 3/16/56
 CITY OF RIVERSIDE, CALIFORNIA
 DEPARTMENT OF PUBLIC WORKS
 SEWER PLAN & PROFILE
 MONTICELLO AVE.
 VILLA d' ESTE #2
 HORIZ. SCALE 1"=40' VERT. SCALE 1"=4'
 APPROVED BY *[Signature]*
 Director of Public Works
 DATE 3-22-56
 NO. S-5A
 SHEET 3 OF 8

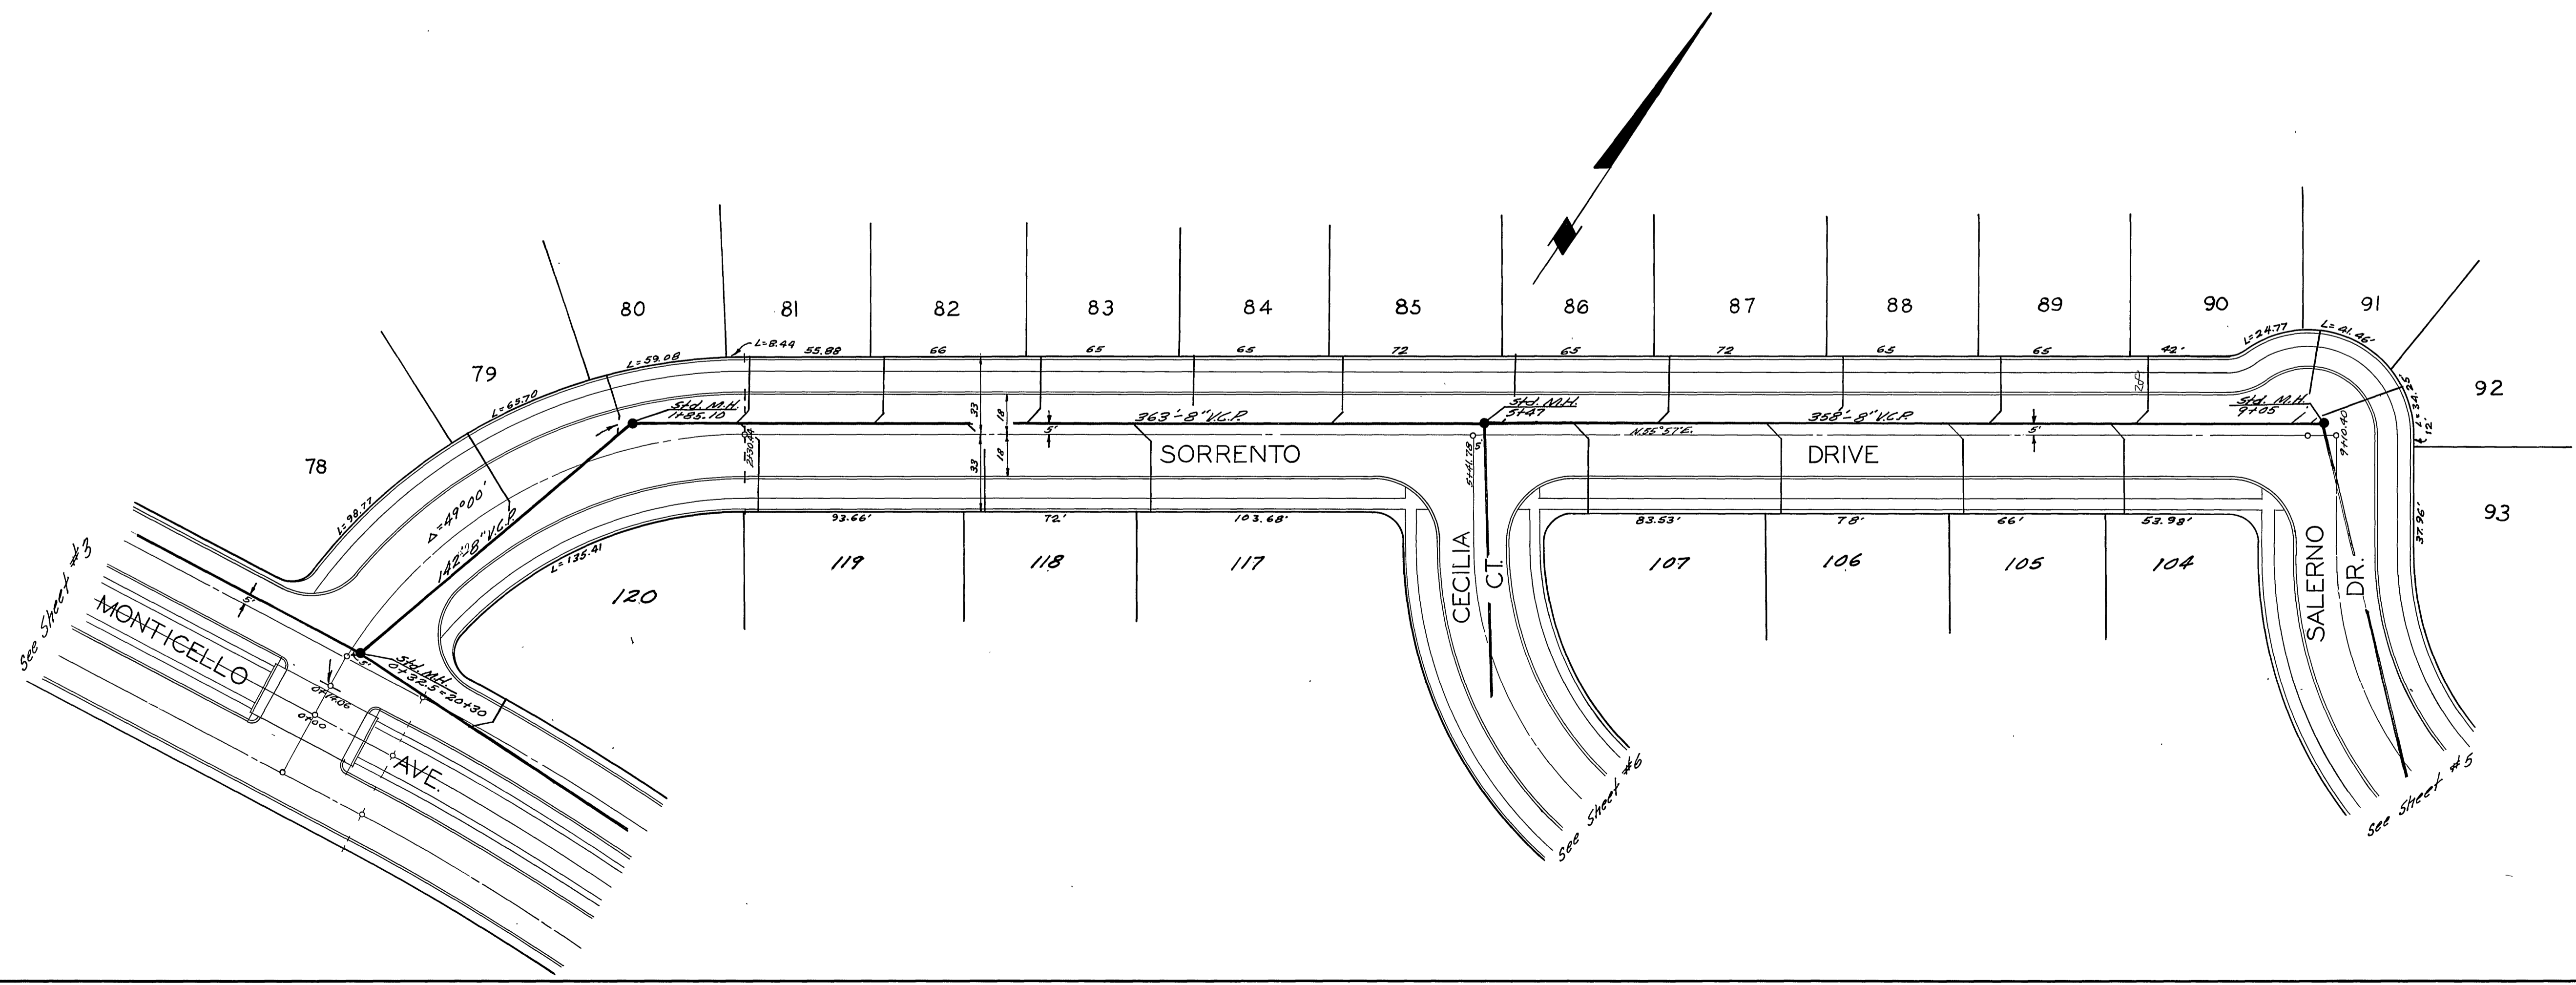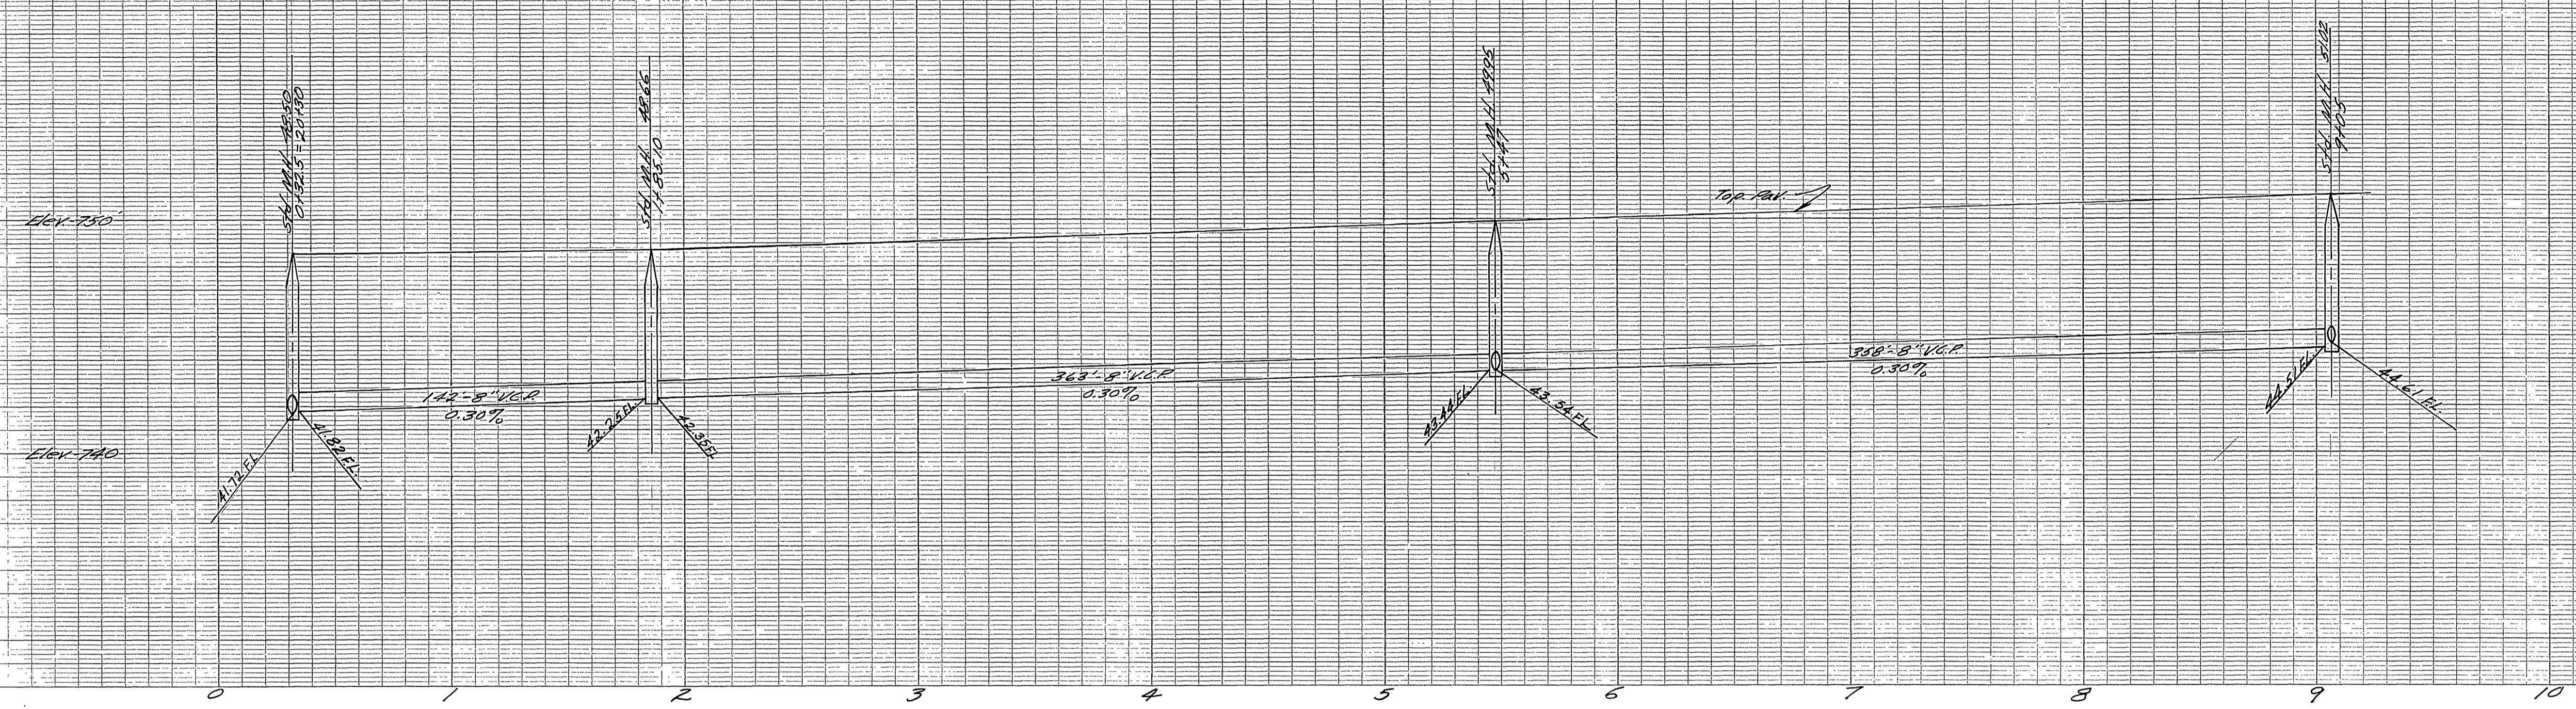

J.F. DAVIDSON - CIVIL ENGINEER
 R.E. No. 862
 RIVERSIDE, CALIFORNIA
 APPROVED *Jim Davidson* DATE 3/6/56





CITY OF RIVERSIDE, CALIFORNIA
 DEPARTMENT OF PUBLIC WORKS

SEWER PLAN & PROFILE
SORRENTO DRIVE



VILLA D'ESTE #2
 HORIZ. SCALE 1" = 40' VERT. SCALE 1" = 4'

APPROVED BY *[Signature]*
 Director of Public Works
 DATE 3-22-56

NO. S-5A
 SHEET 4 OF 8

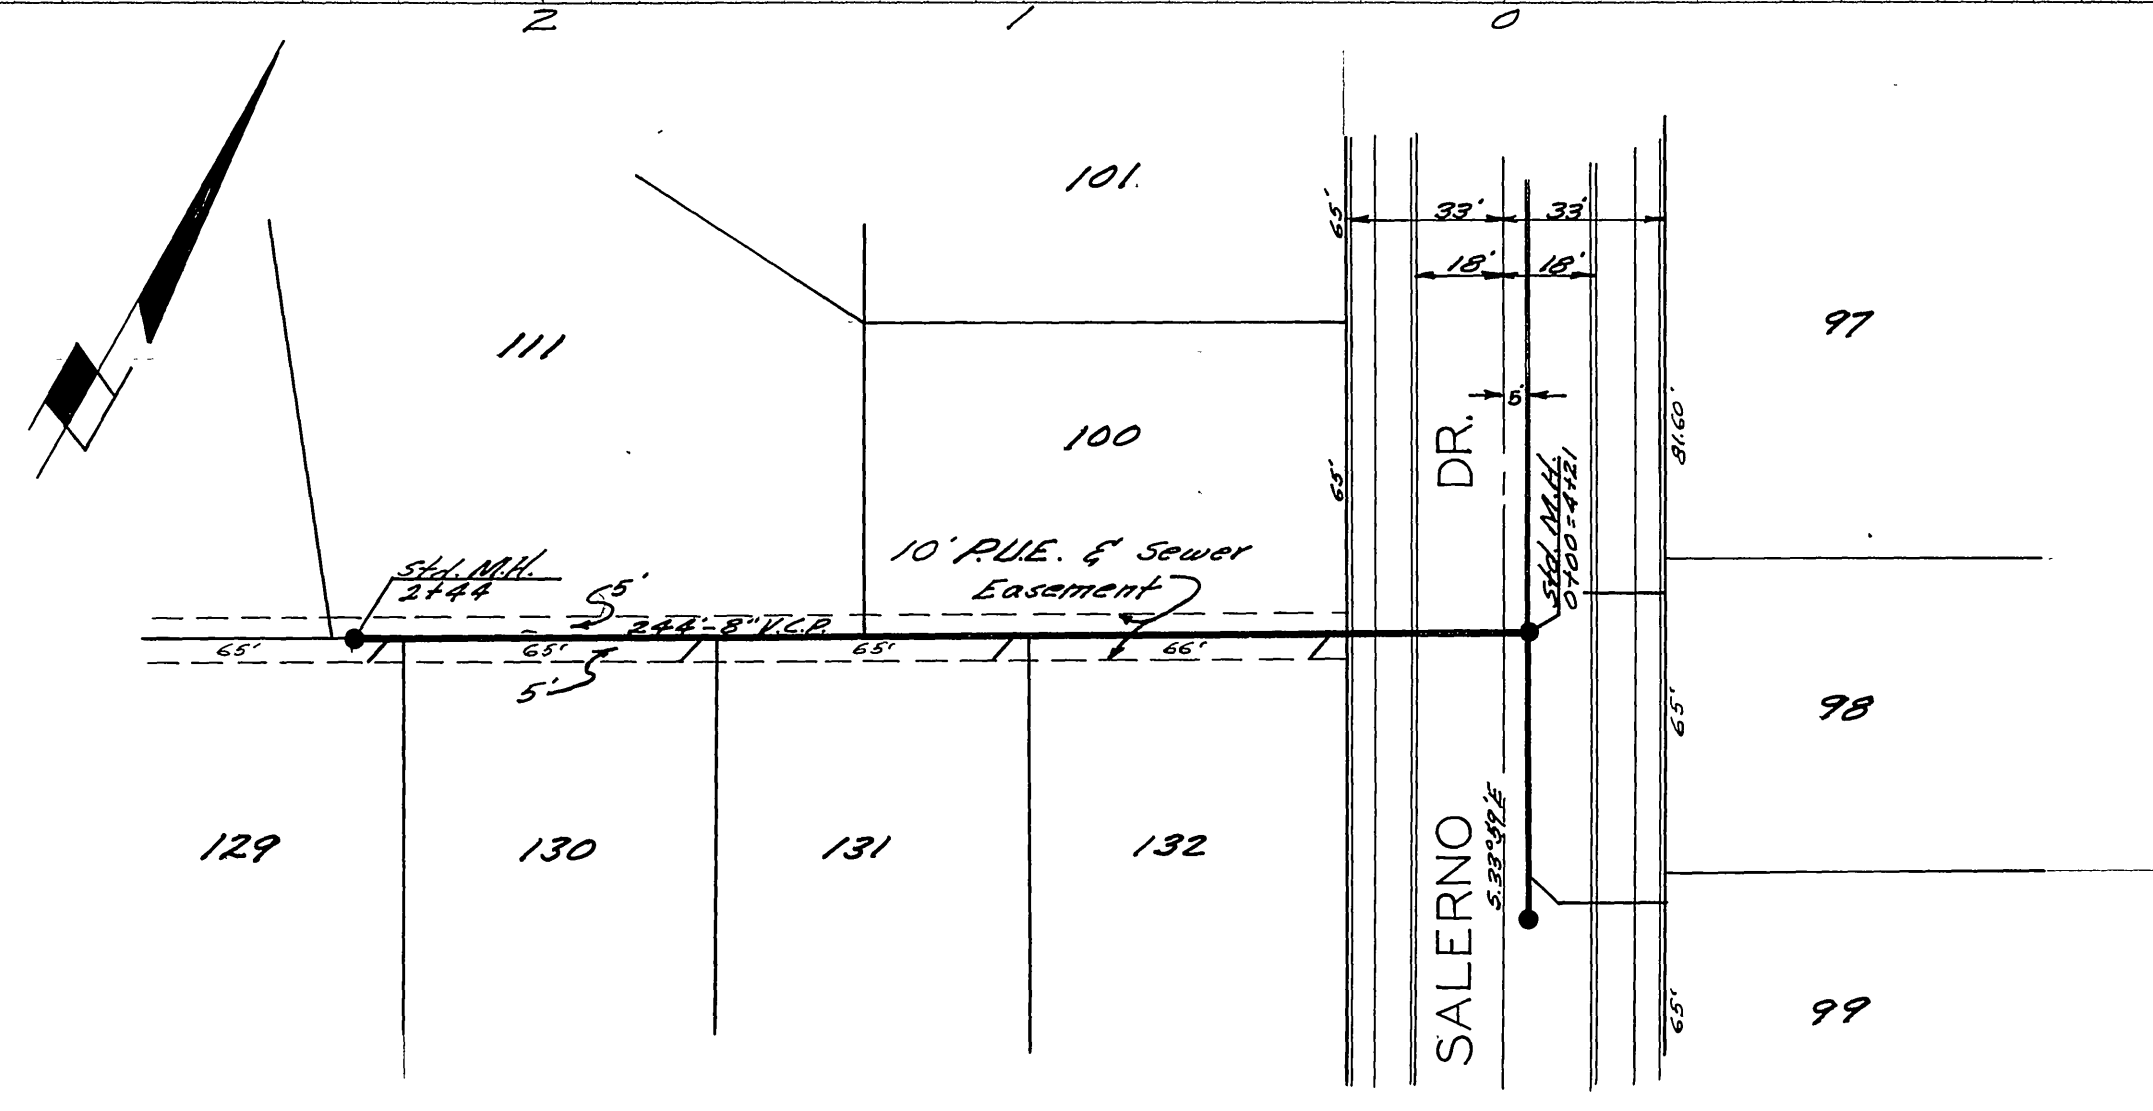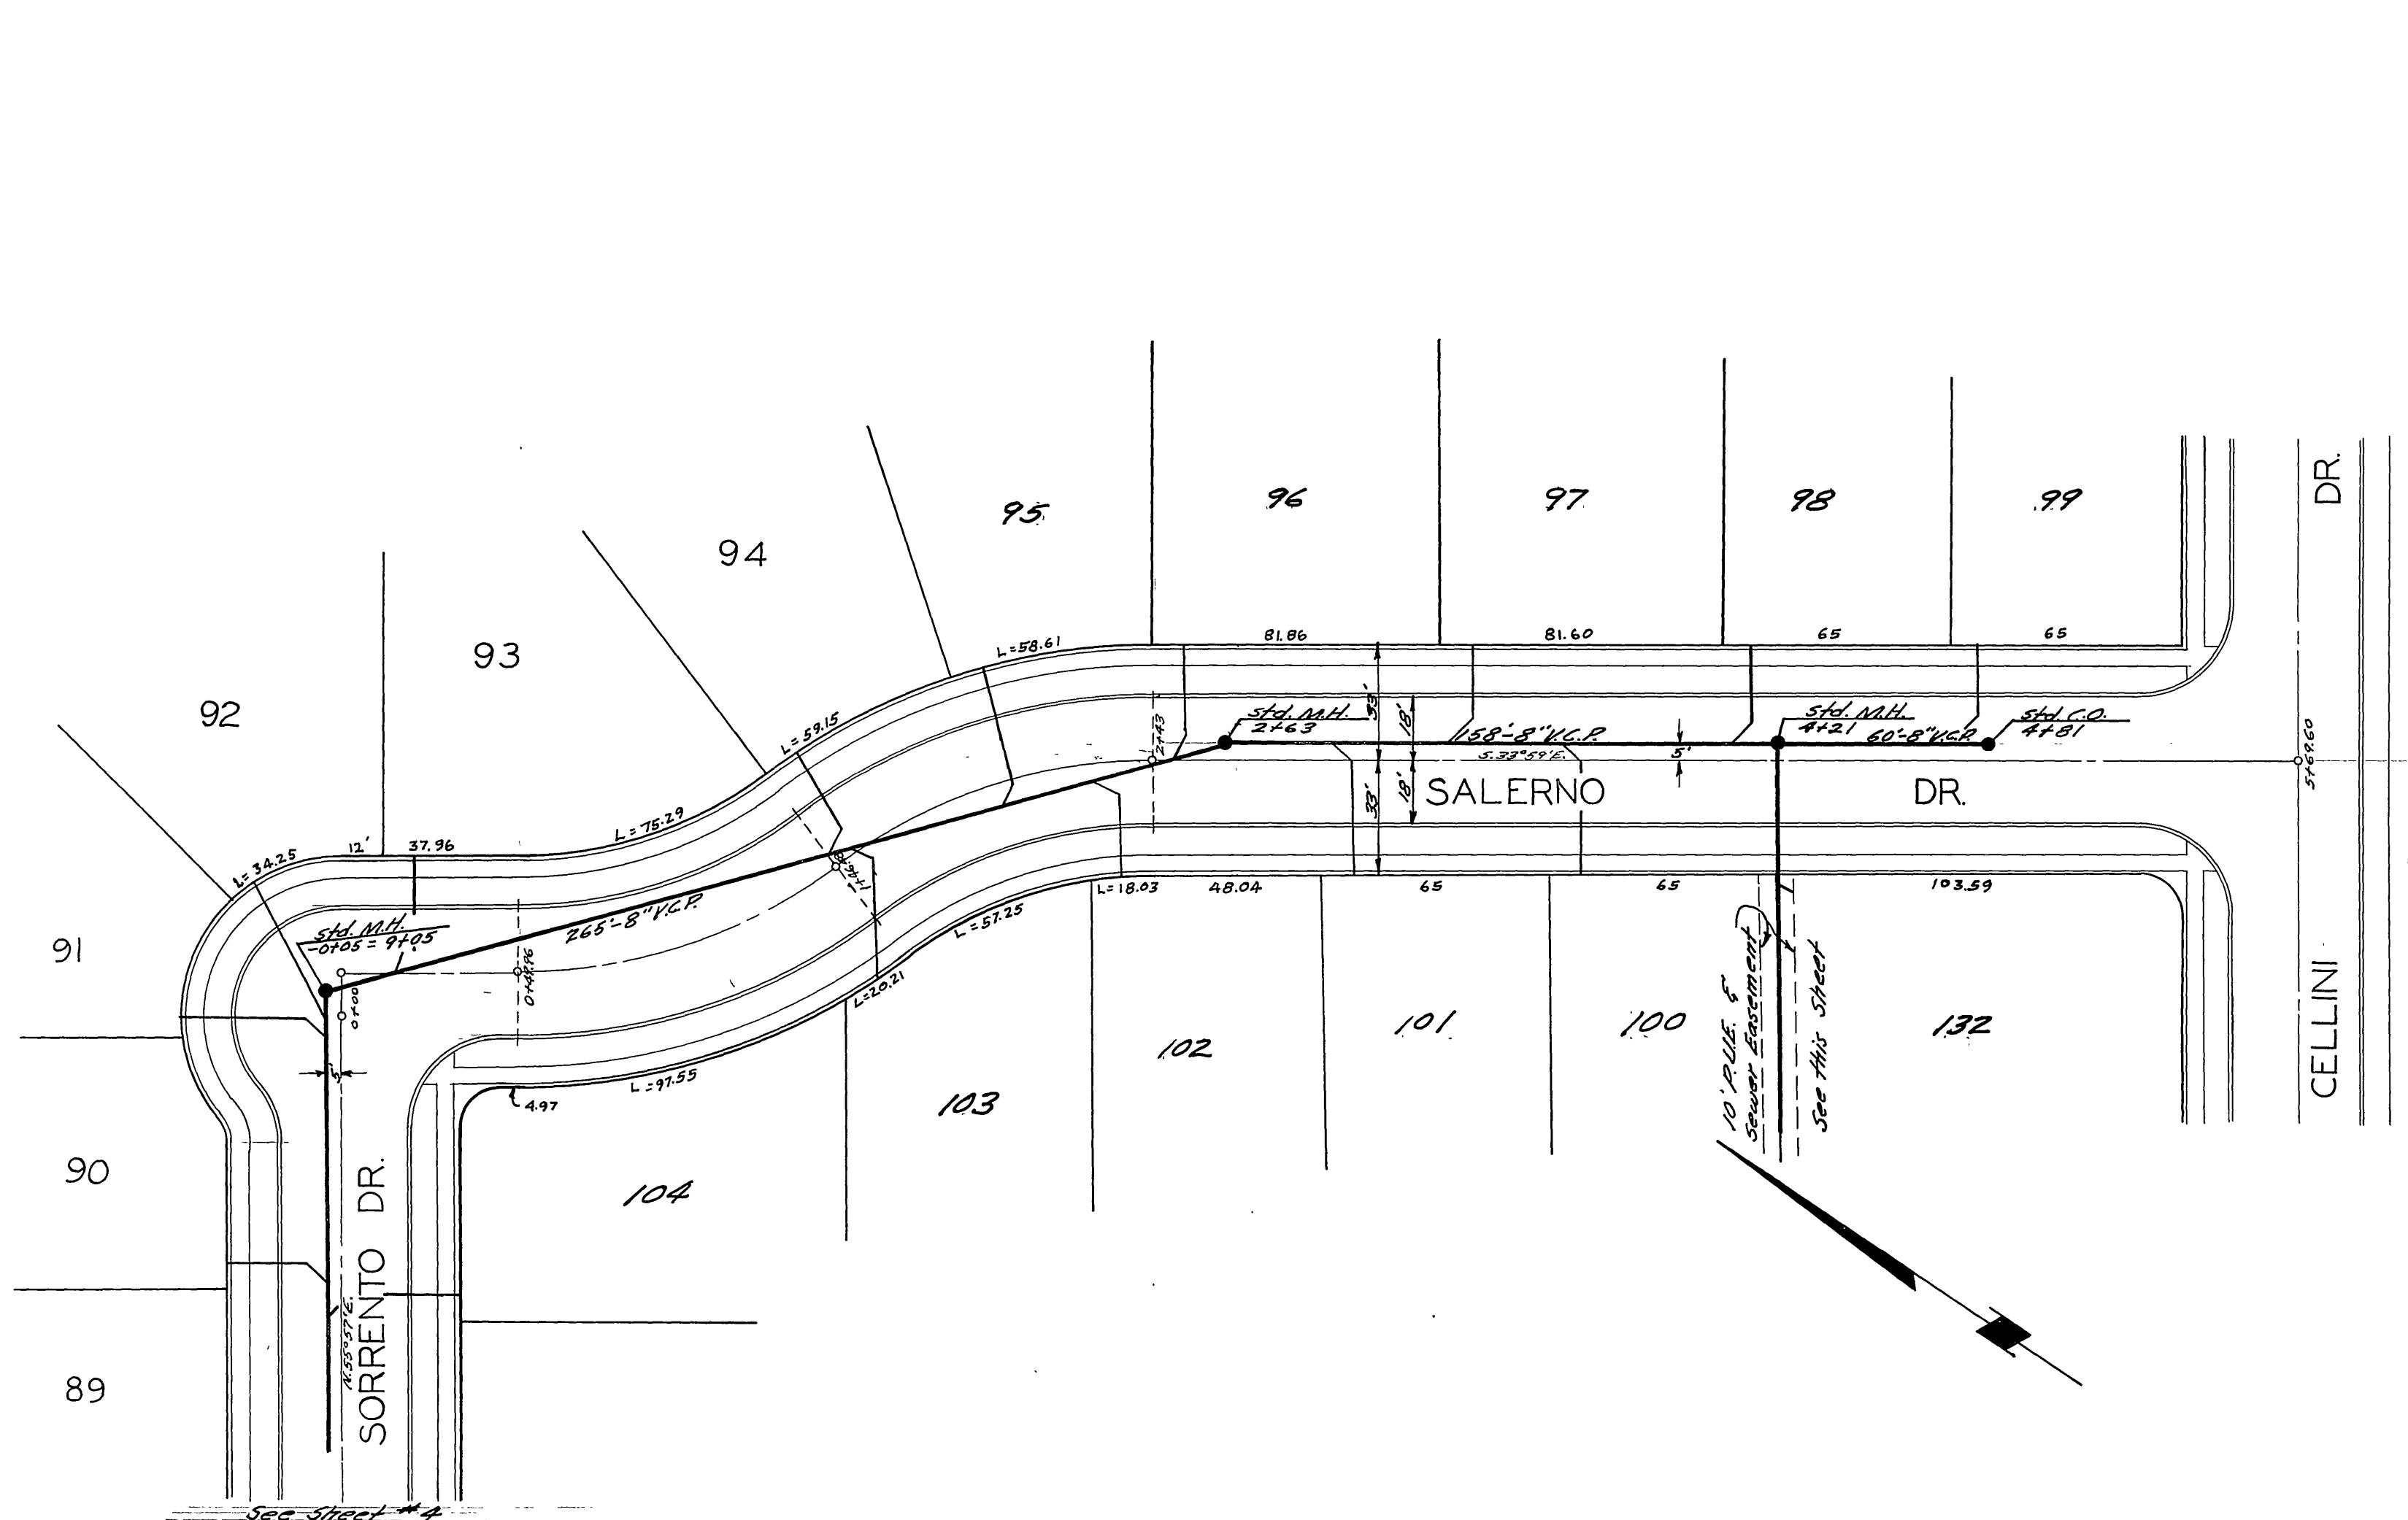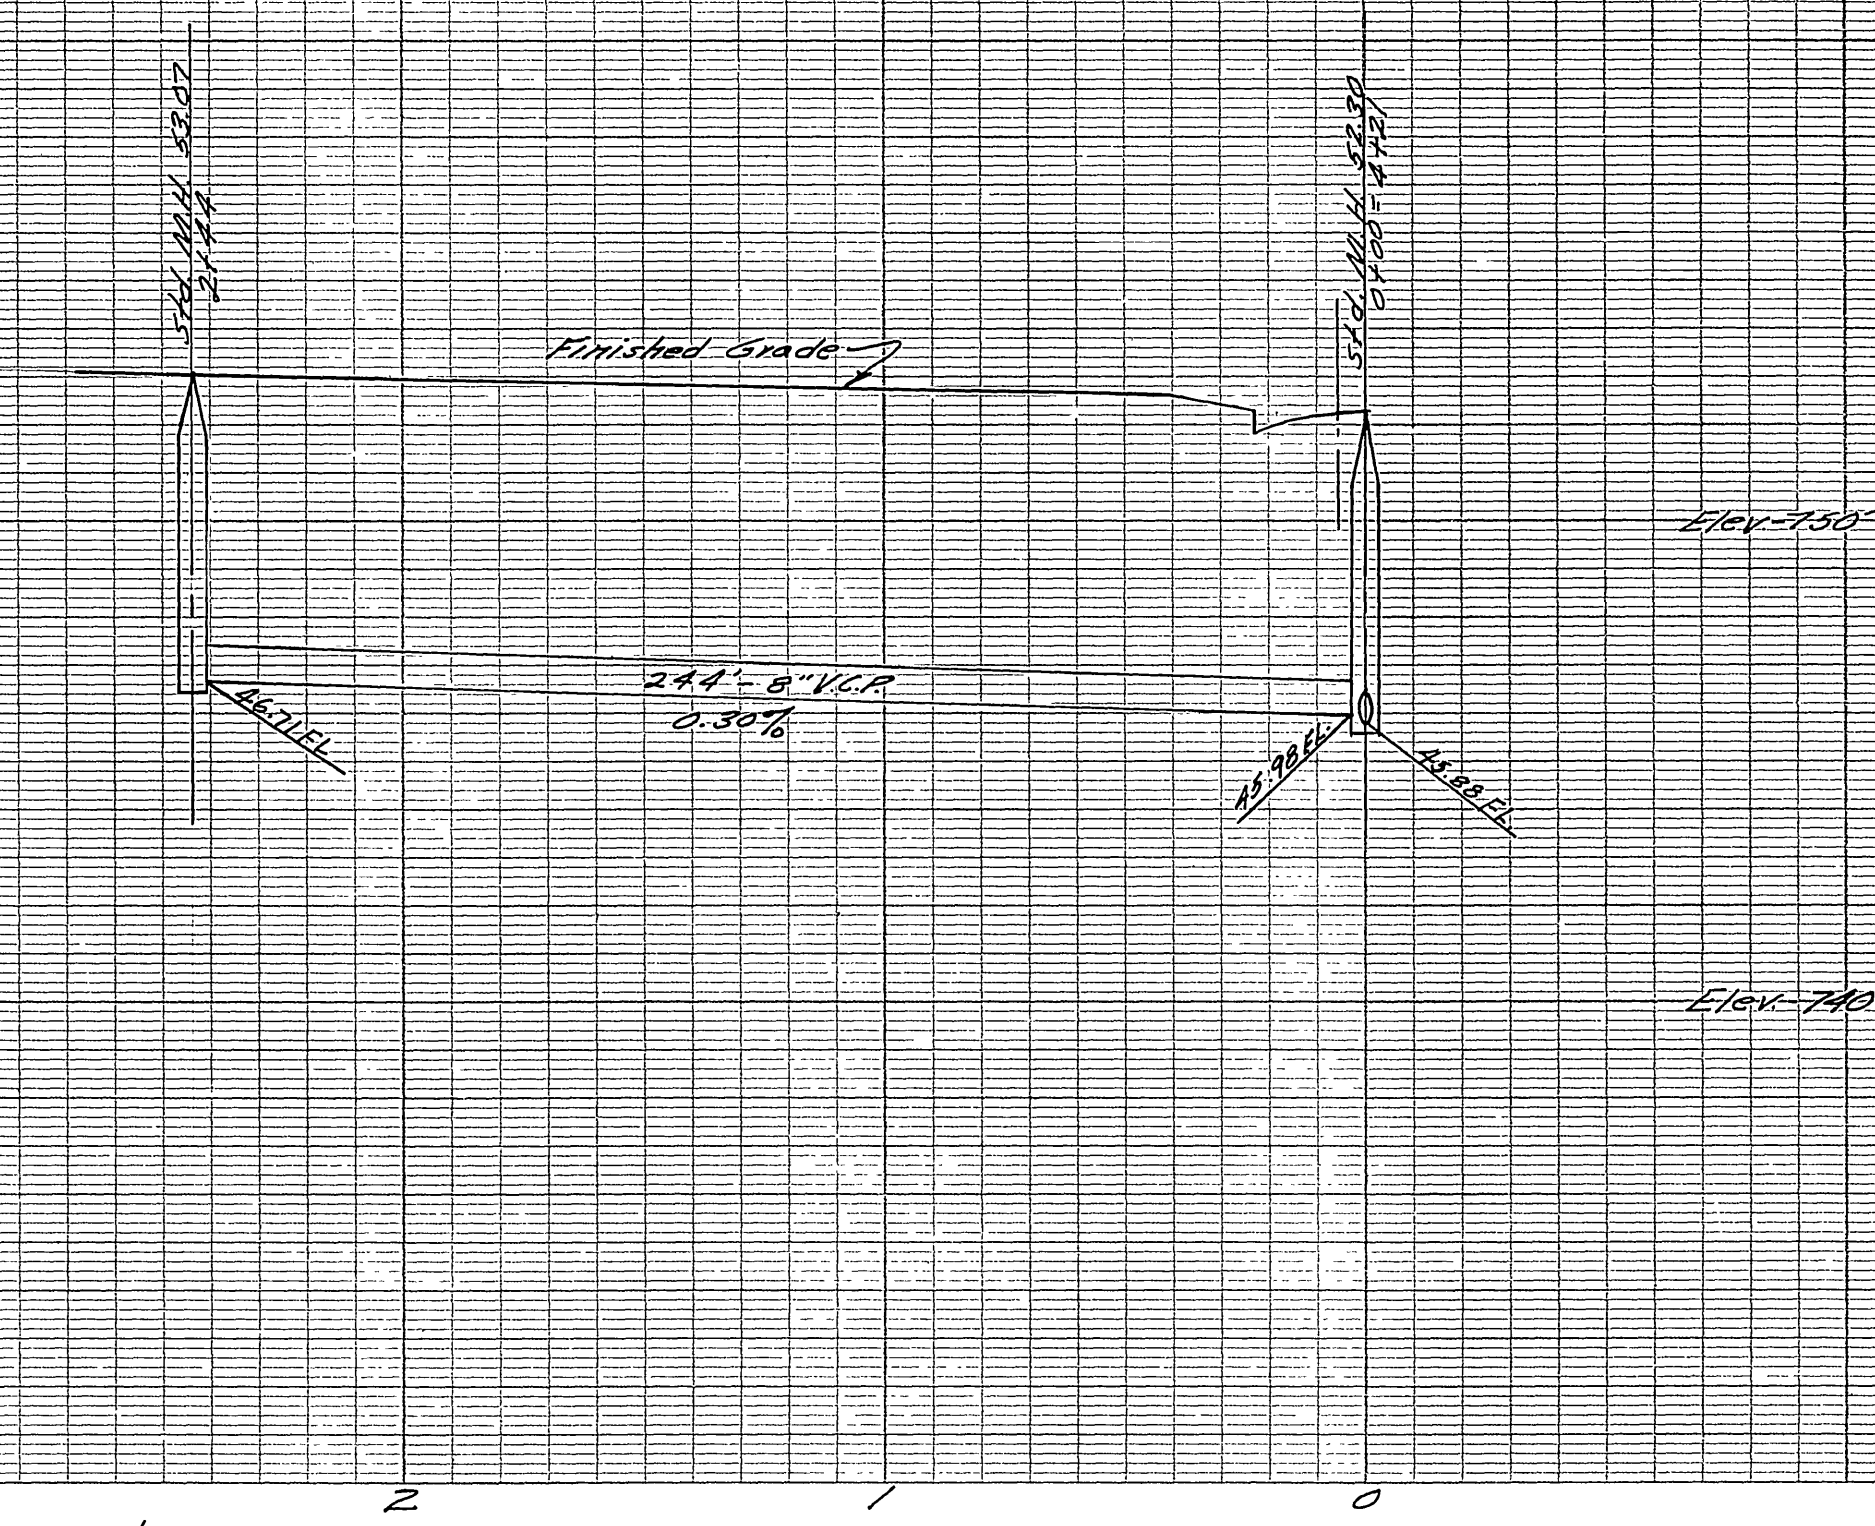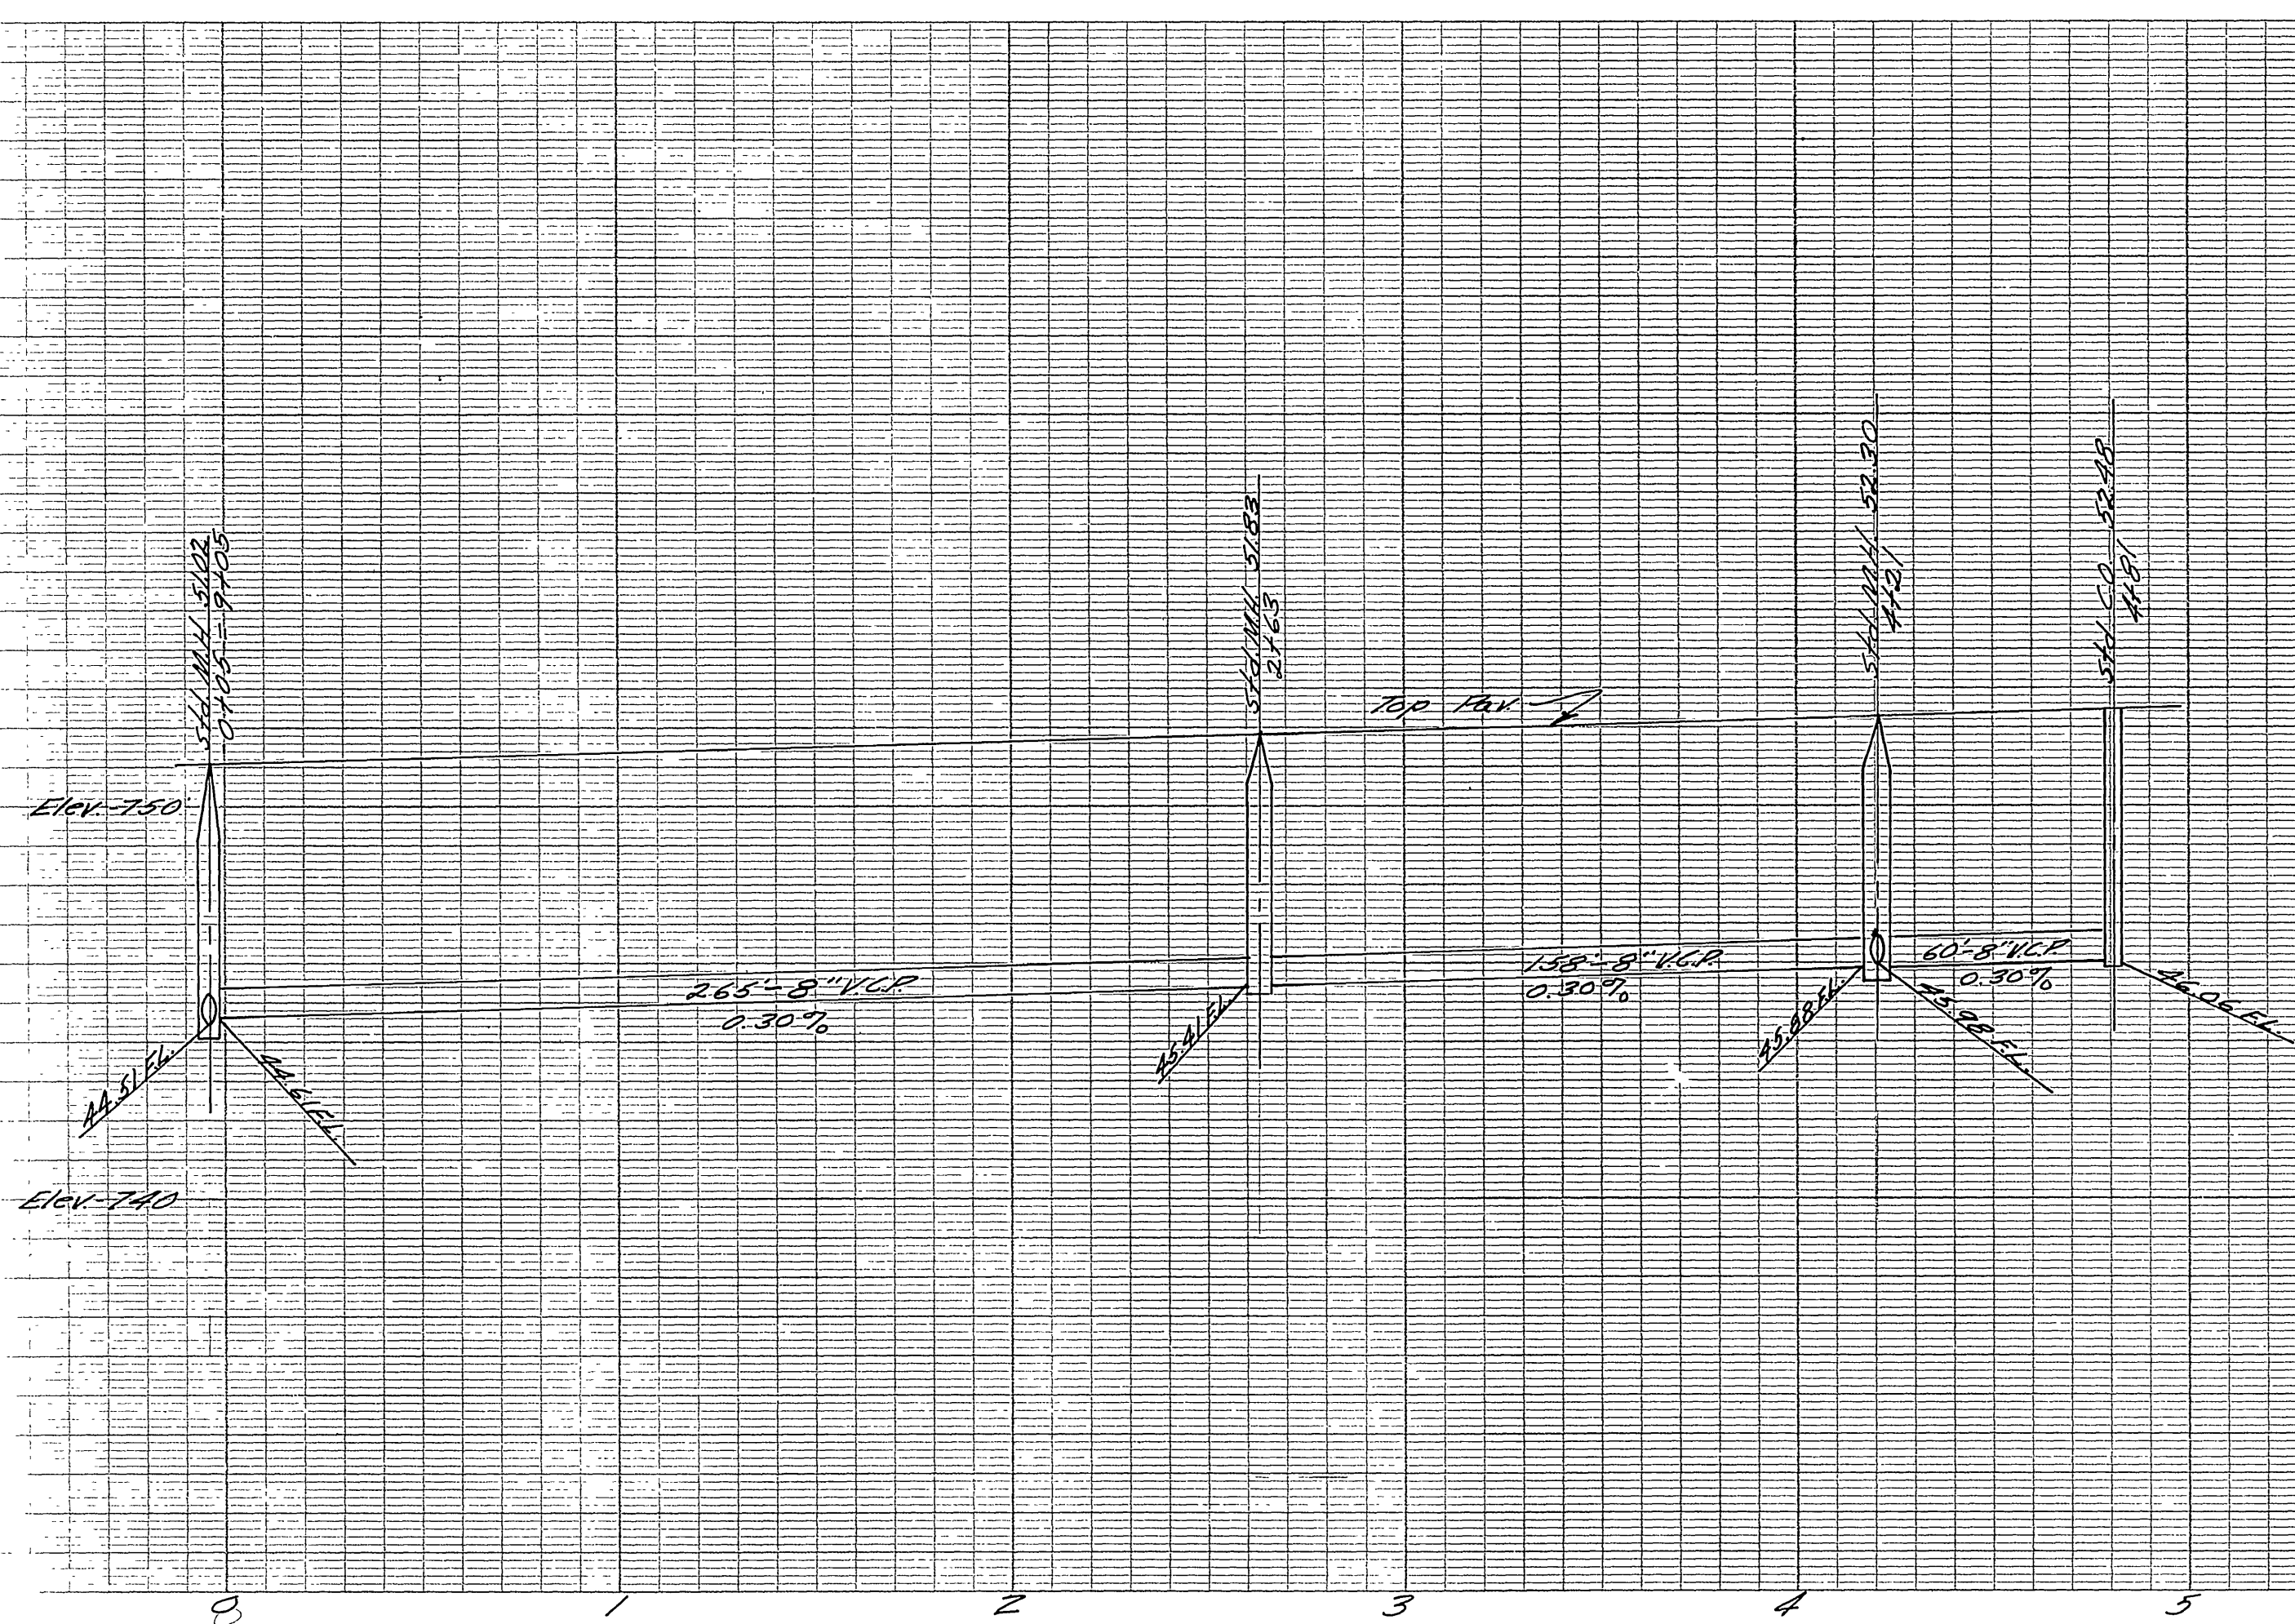

J.F. DAVIDSON-CIVIL ENGINEER
 R.E. No 862
 RIVERSIDE, CALIFORNIA
 APPROVED BY *Gun Daughan* DATE 3/6/56
 CITY OF RIVERSIDE, CALIFORNIA
 DEPARTMENT OF PUBLIC WORKS
 SEWER PLAN & PROFILE
 SALERNO DR. & EASEMENT
 VILLA D'ESTE #2
 HORIZ. SCALE 1"=40' VERT. SCALE 1"=4'
 APPROVED BY *J.F. Davidson*
 Director of Public Works
 DATE 3-22-56 NO. S-5A SHEET 5 OF 8

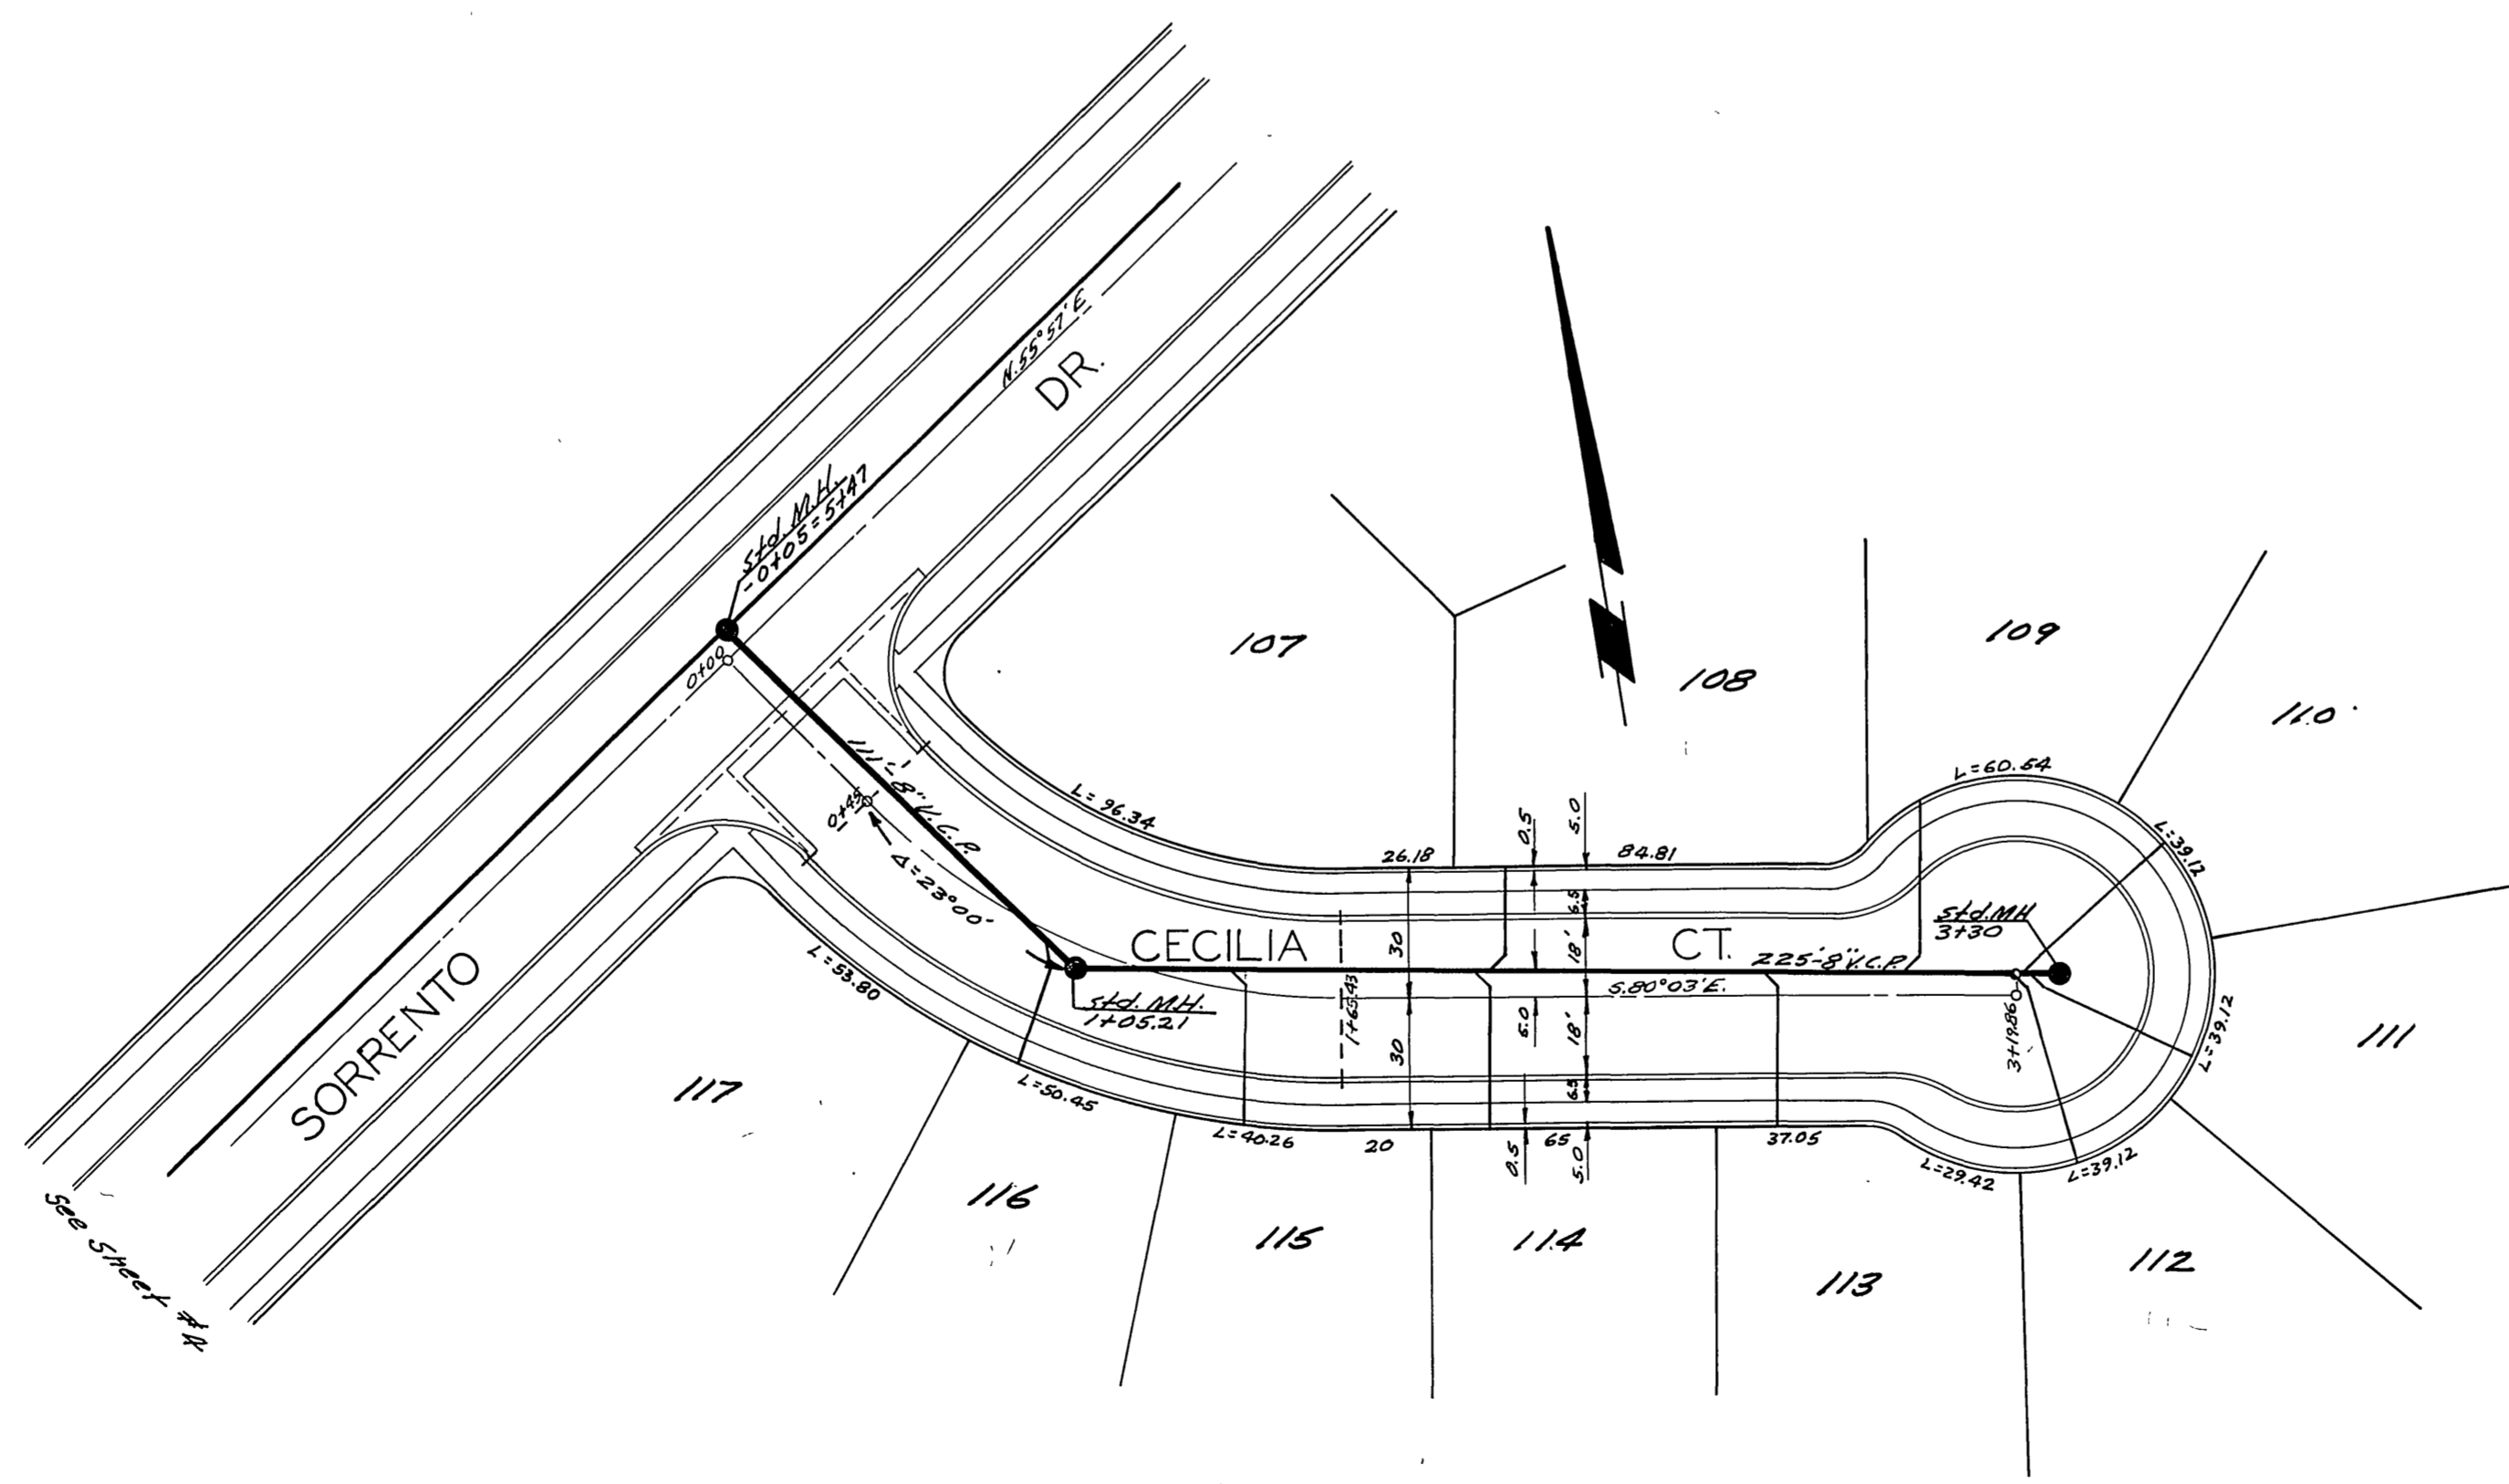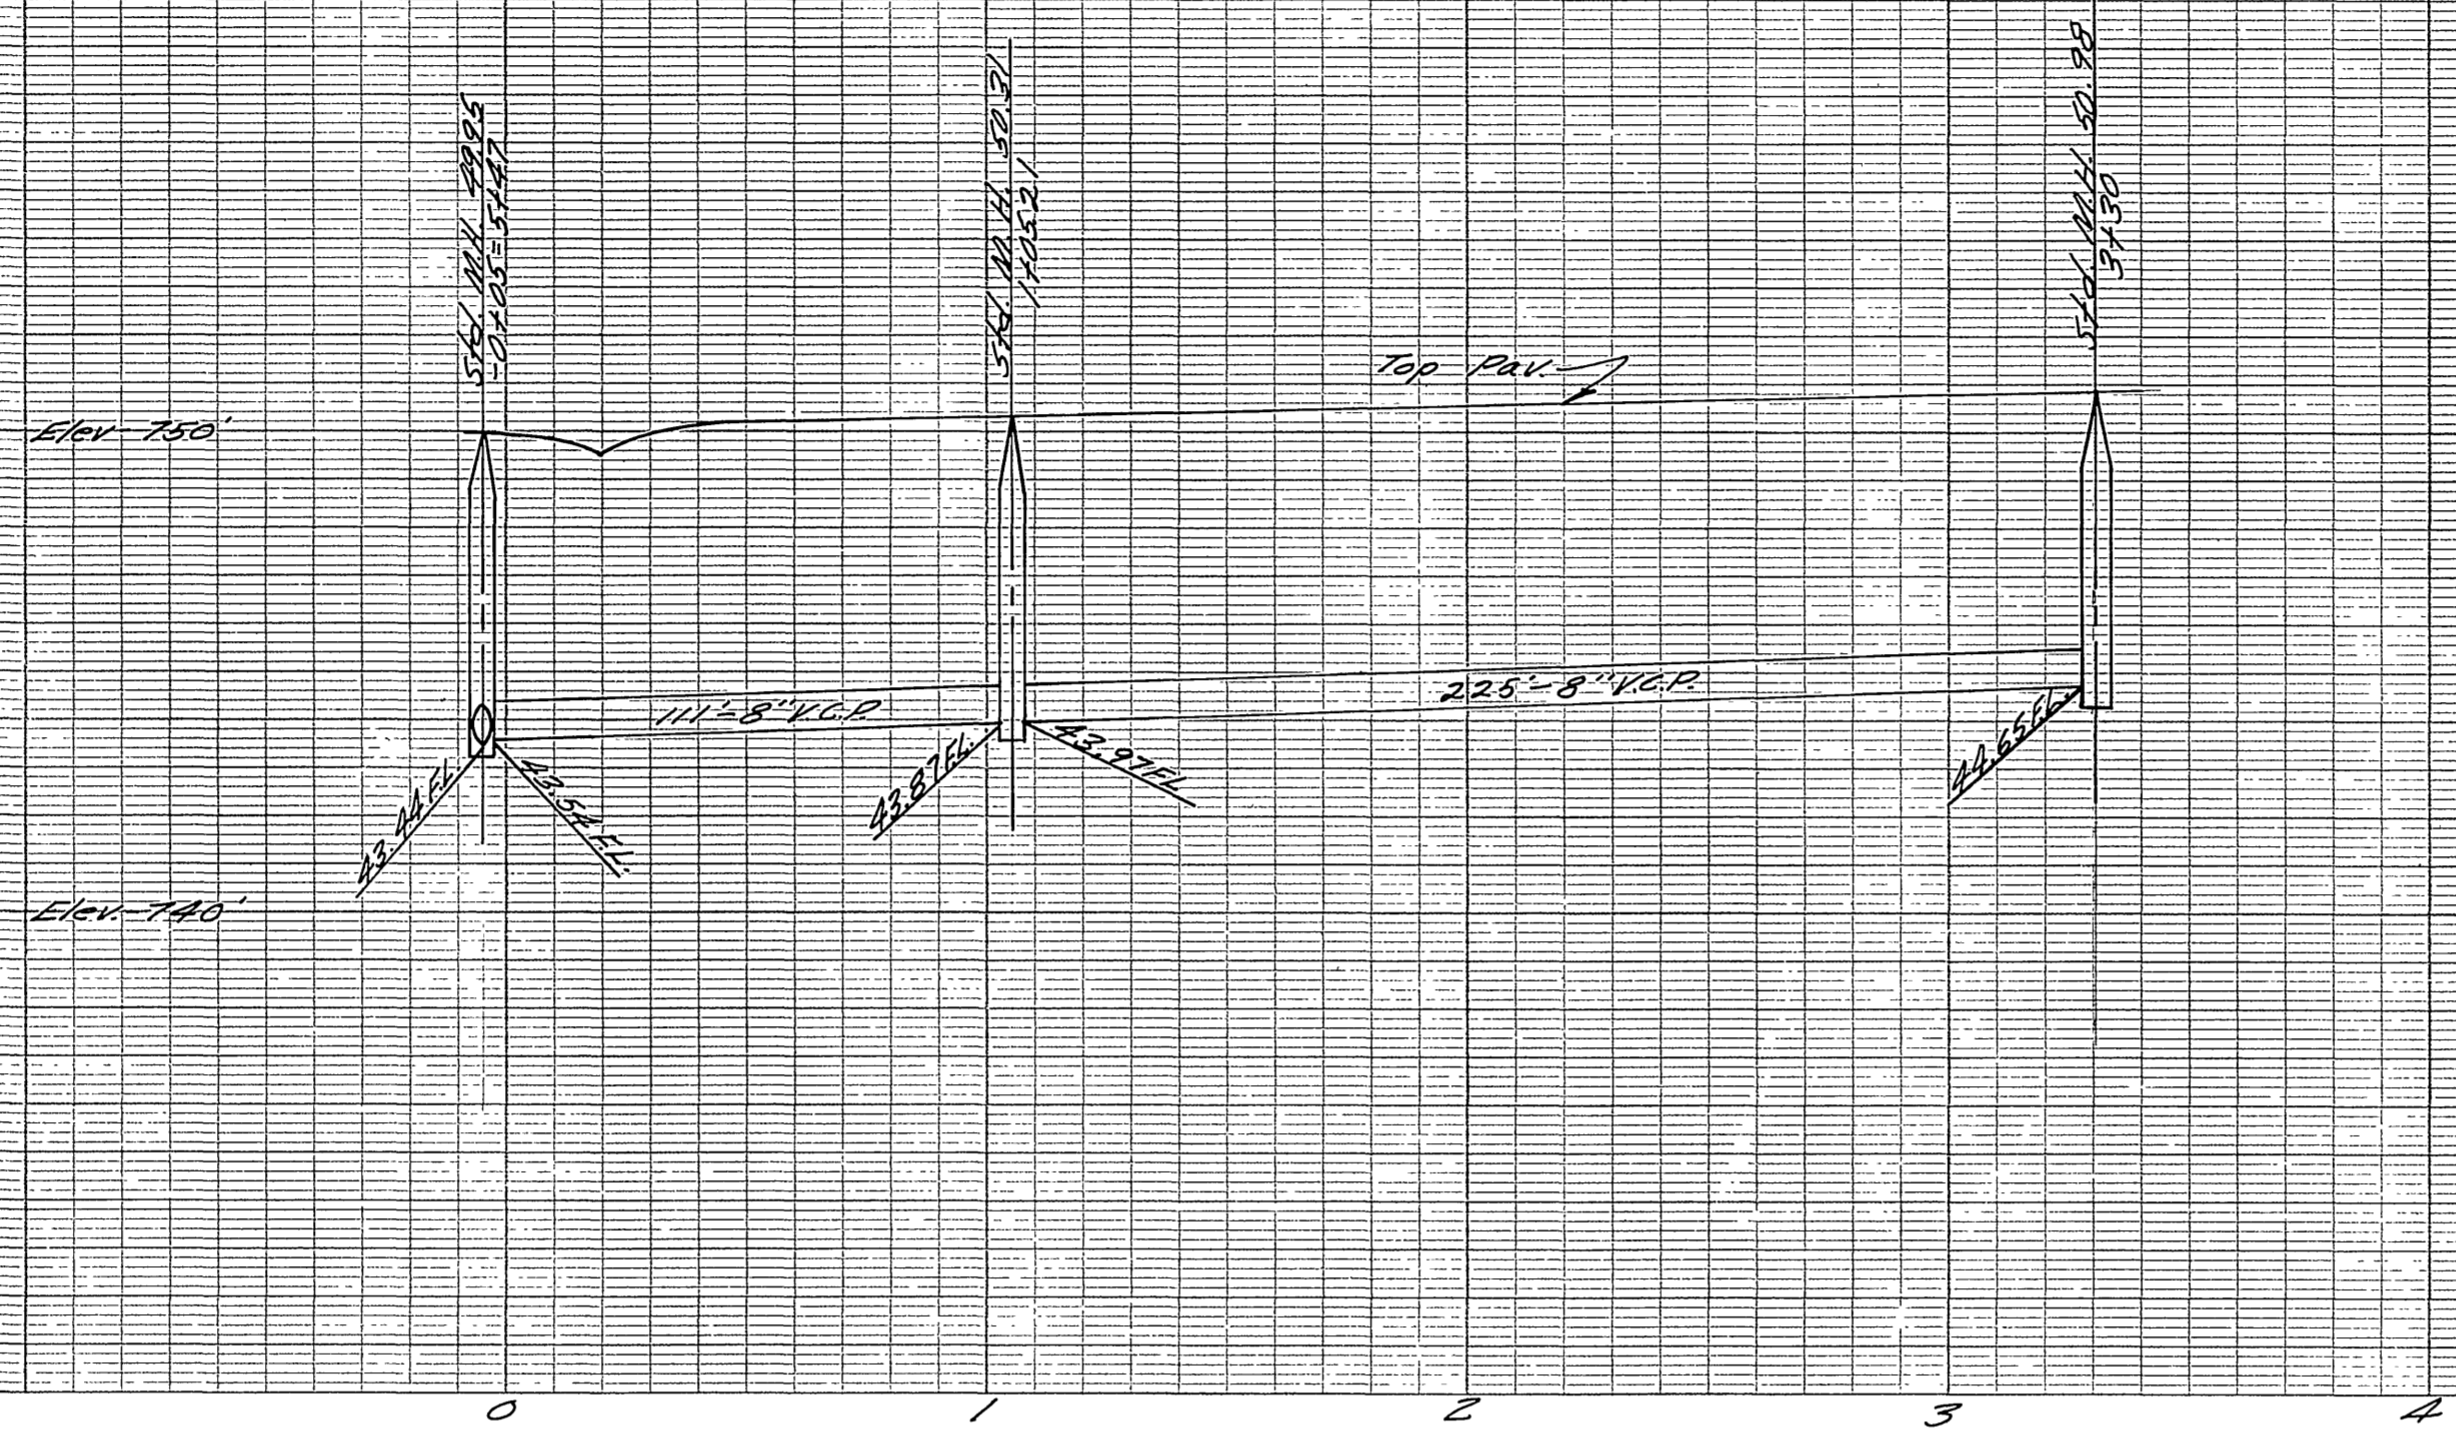



J.F. DAVIDSON-CIVIL ENGINEER
 RE. No. 352
 RIVERSIDE, CALIFORNIA
 APPROVED BY *J.F. Davidson* DATE 3/1/56

CITY OF RIVERSIDE, CALIFORNIA
 DEPARTMENT OF PUBLIC WORKS

SEWER PLAN & PROFILE
 CECILIA COURT
 VILLA D'ESTE #2
 HORIZ. SCALE 1"=40' VERT. SCALE 1"=4'




APPROVED BY *J.F. Davidson*
 Director of Public Works
 DATE 3-22-56

NO. 5-5A
 SHEET 6 OF 8

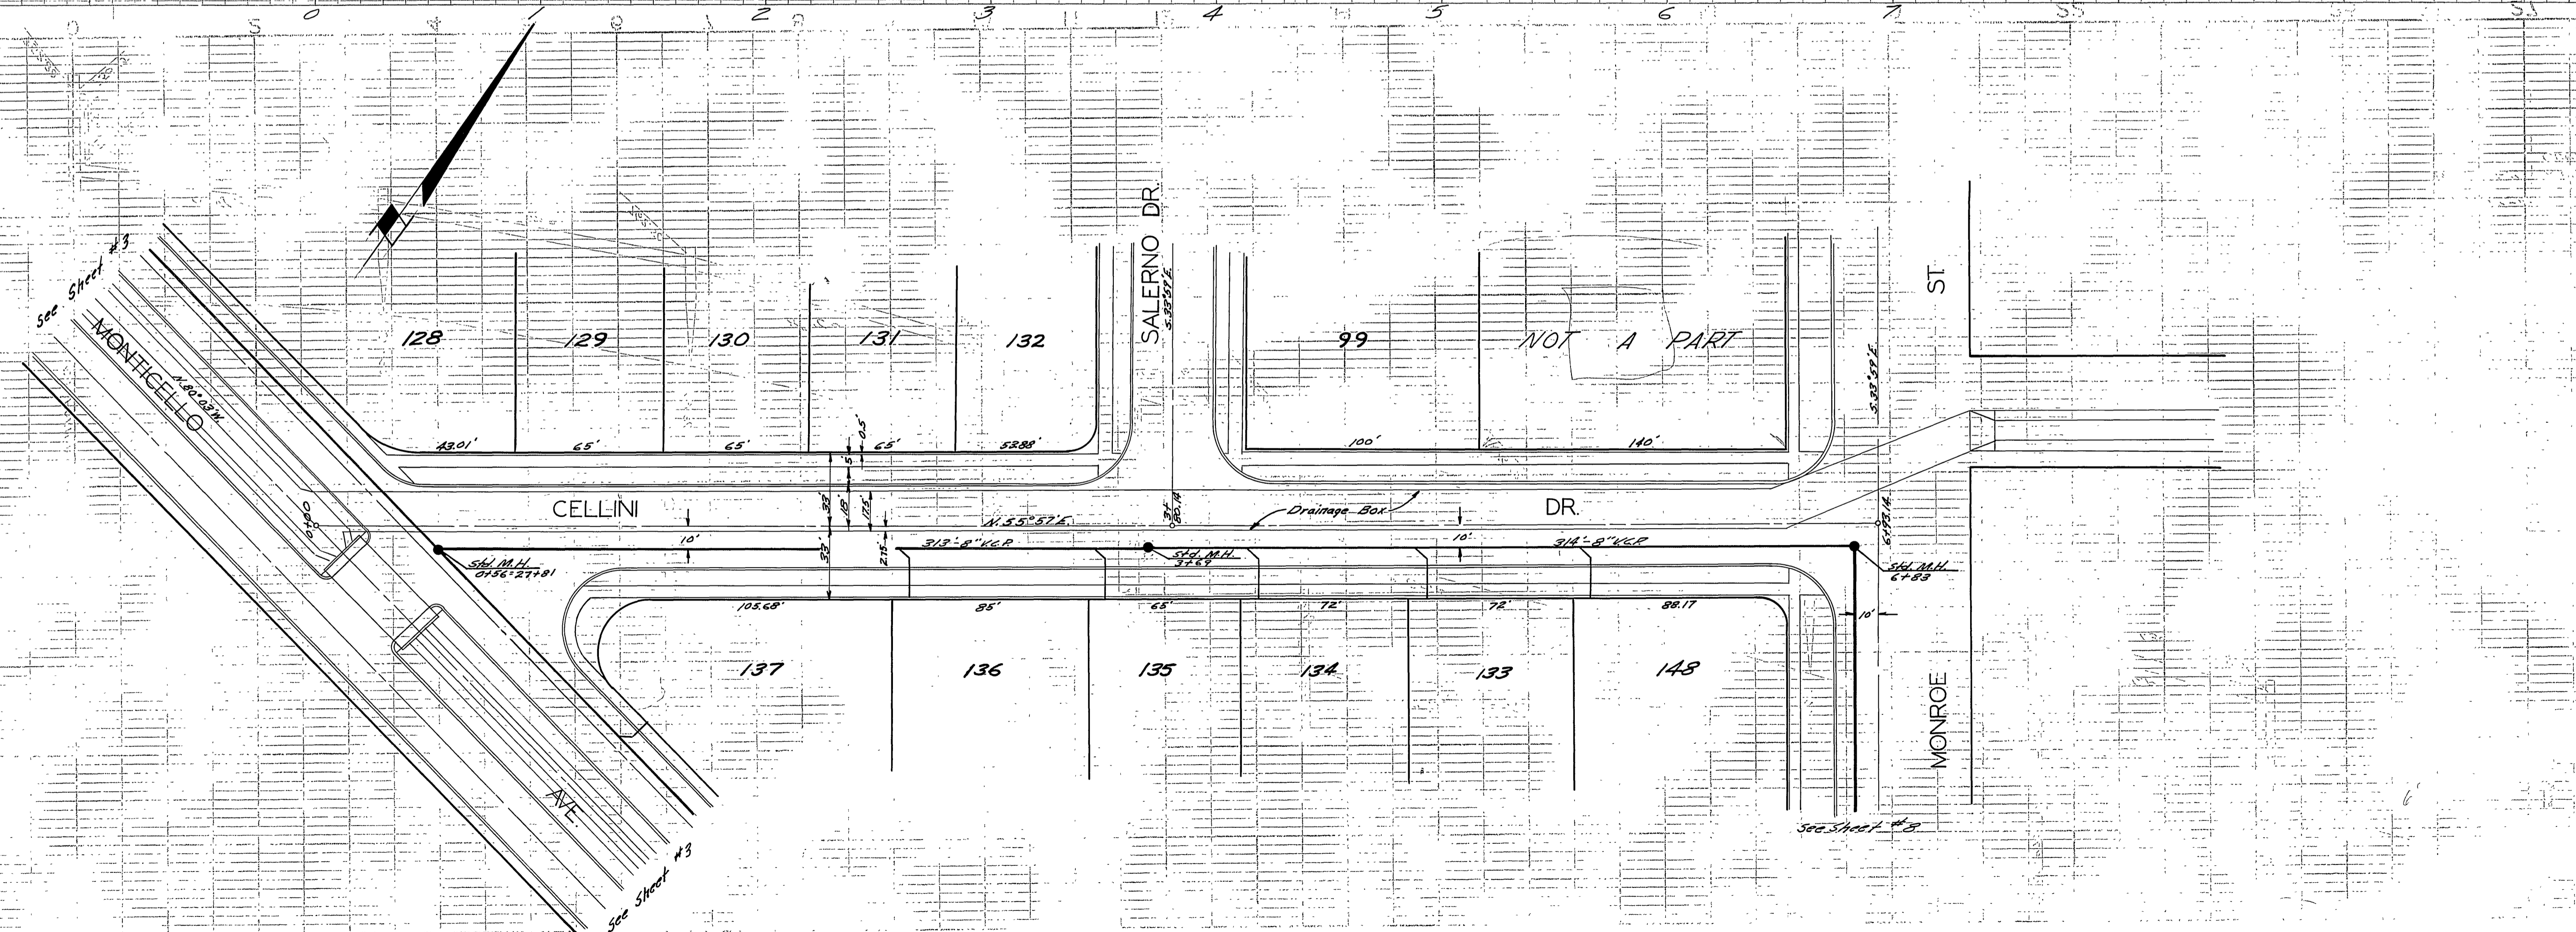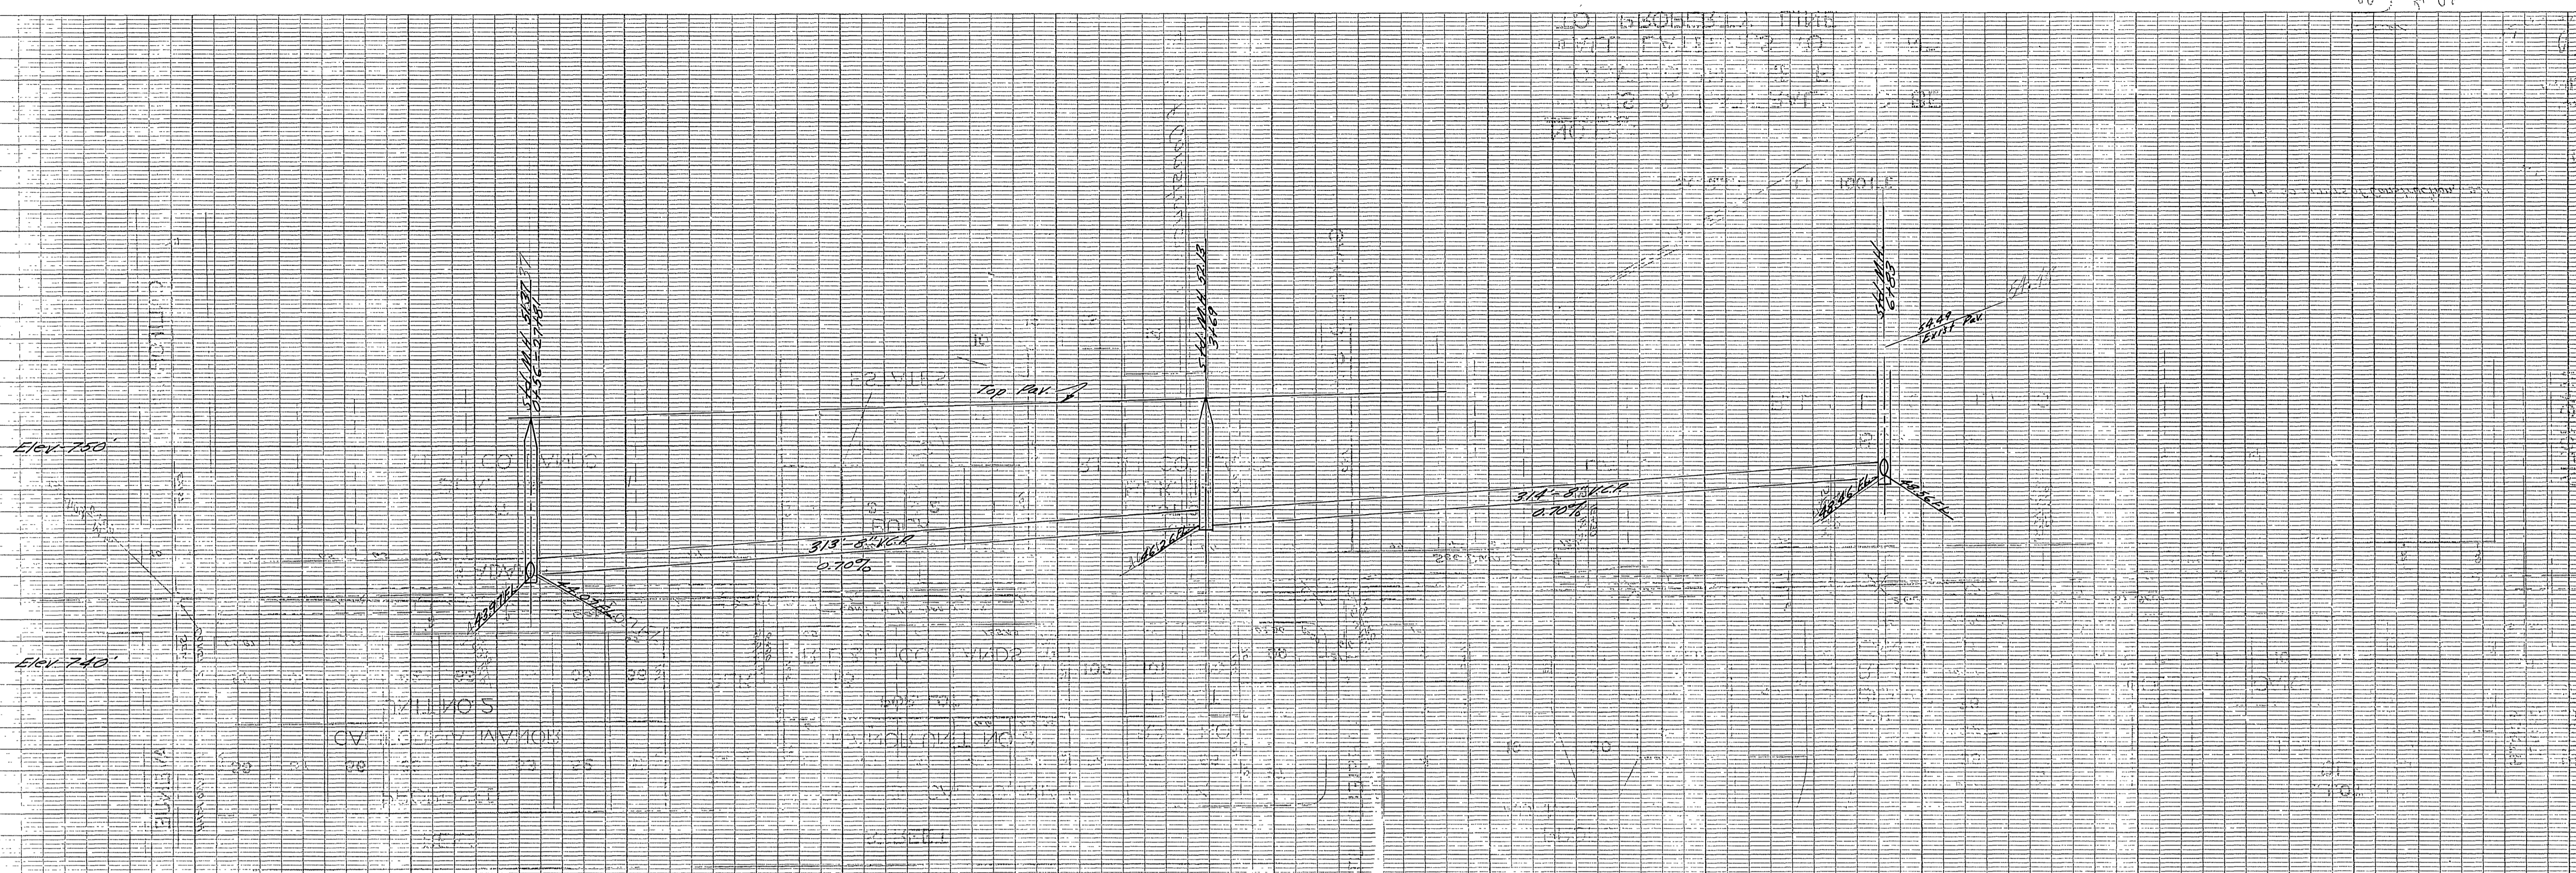

J.F. DAVIDSON - CIVIL ENGINEER
 R.E. No 862
 RIVERSIDE, CALIFORNIA
 APPROVED BY *Jim Faudon* DATE 3/6/56
 CITY OF RIVERSIDE, CALIFORNIA
 DEPARTMENT OF PUBLIC WORKS
 SEWER PLAN & PROFILE
 CELLINI DRIVE
 VILLA d'ESTE #2
 HORIZ SCALE 1/4" = 40' VERT. SCALE 1/4" = 4'
 APPROVED BY *J.F. Davidson*
 Director of Public Works
 DATE 3-22-56
 NO. S-5A
 SHEET 2 OF 8

13 12 11 10 9 8 7 6 5 4 3 2

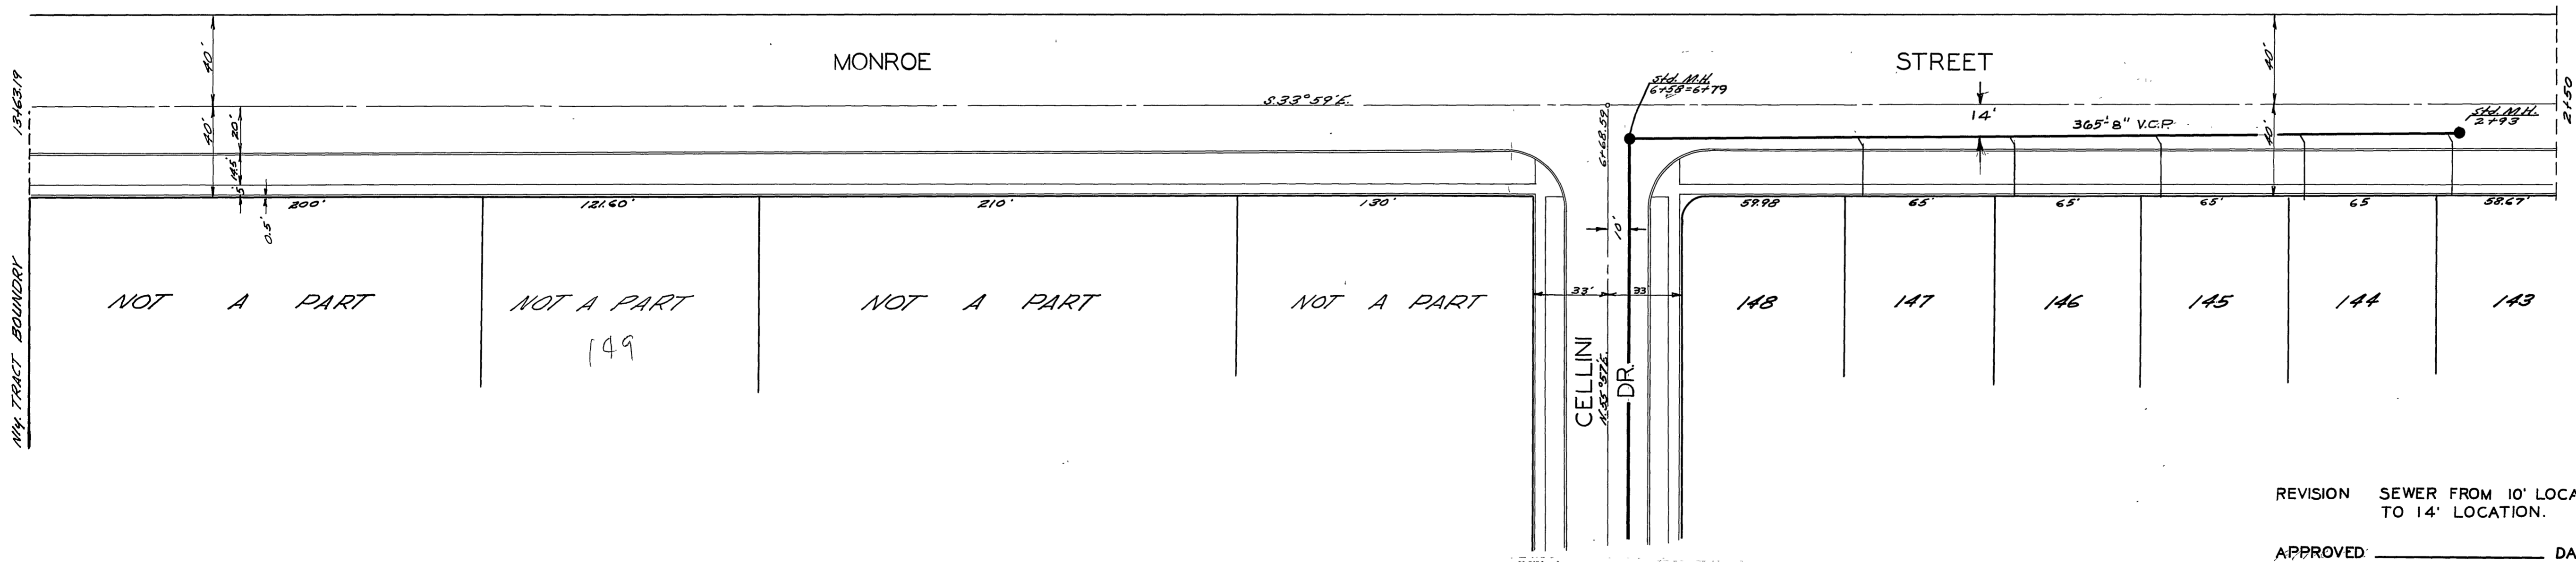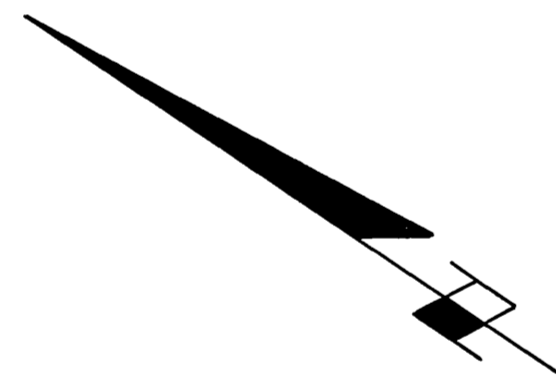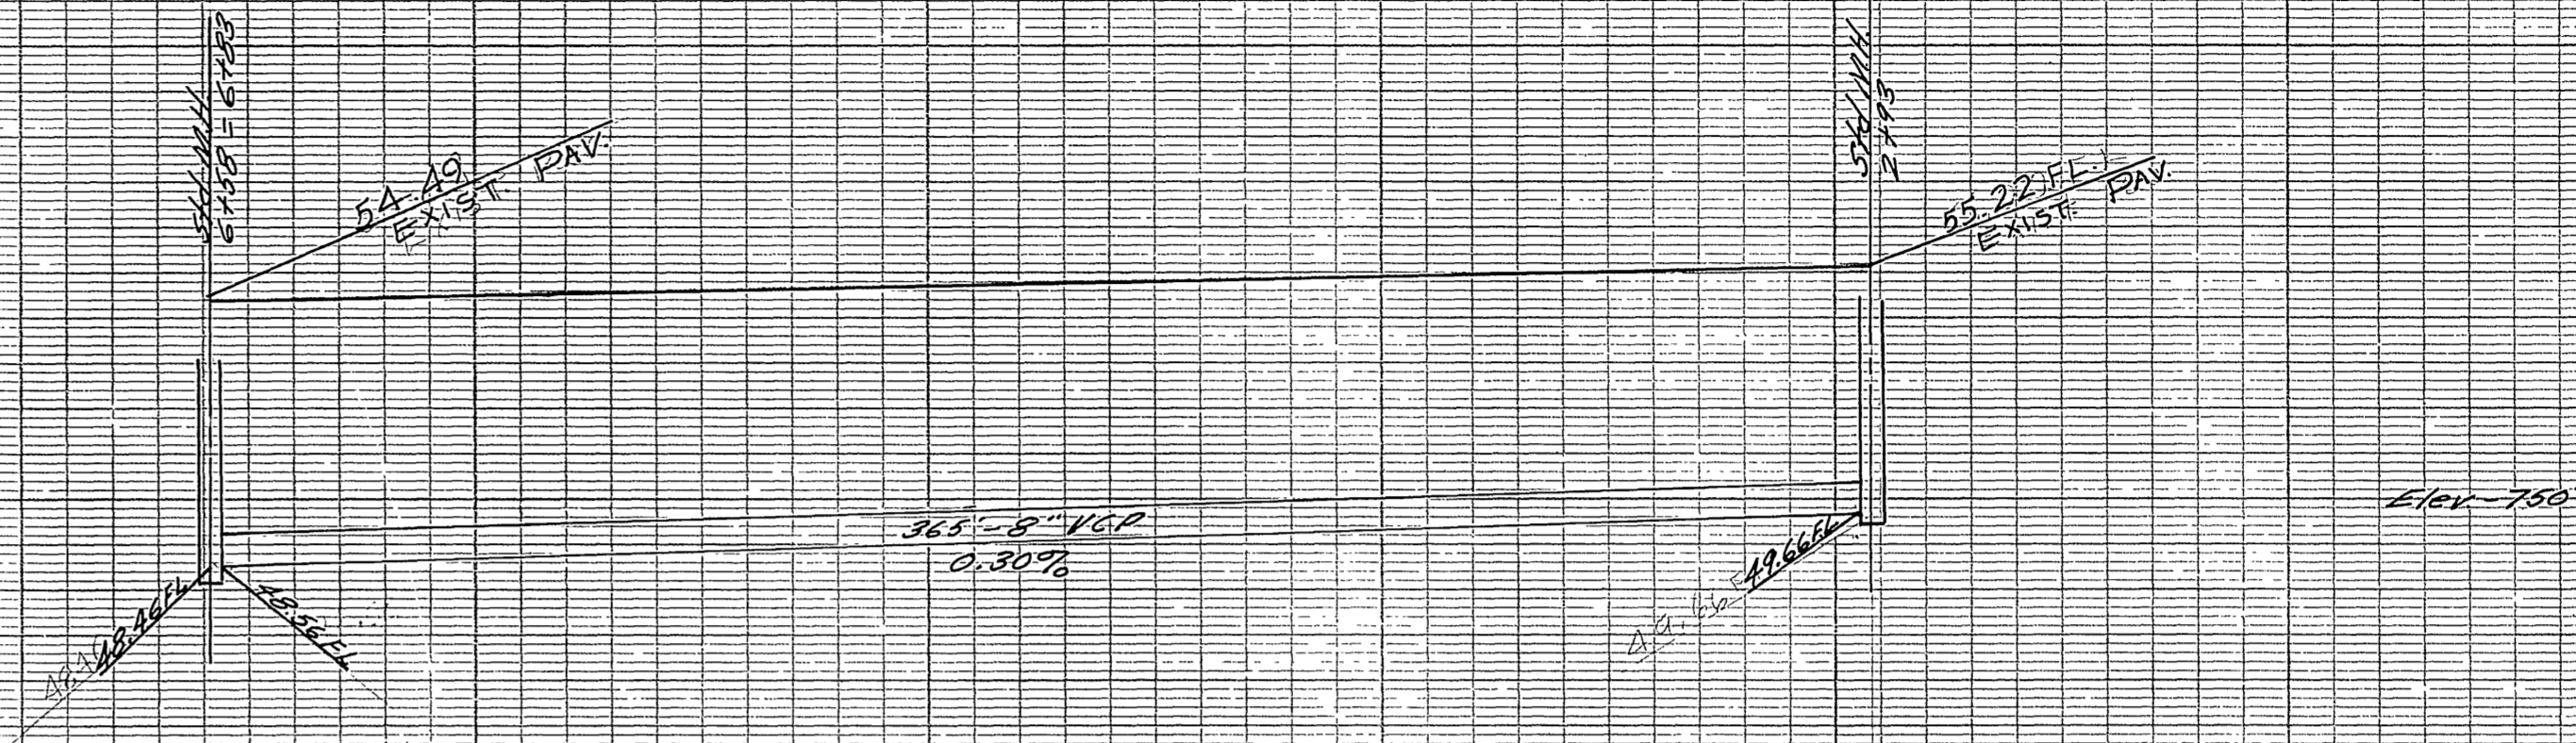

REVISION SEWER FROM 10' LOCATION
TO 14' LOCATION.

APPROVED _____ DATE _____
DIRECTOR OF PUBLIC WORKS

J.F. DAVIDSON - CIVIL ENGINEER
R.E. No. 862
RIVERSIDE, CALIFORNIA
APPROVED BY *Jim Davidson* DATE *3/6/56*

CITY OF RIVERSIDE, CALIFORNIA
DEPARTMENT OF PUBLIC WORKS

SEWER PLAN & PROFILE
MONROE STREET

VILLA D'ESTE #2
HORIZ. SCALE 1" = 40' VERT. SCALE 1" = 4'

APPROVED BY *Jim Davidson* NO. *5-5A*
Director of Public Works
DATE *3-22-56* SHEET *8* OF *8*

FB 546-6A