


PROFILE	
NO.	DATE
BY	
DATE	
BY	
DATE	
BY	
DATE	

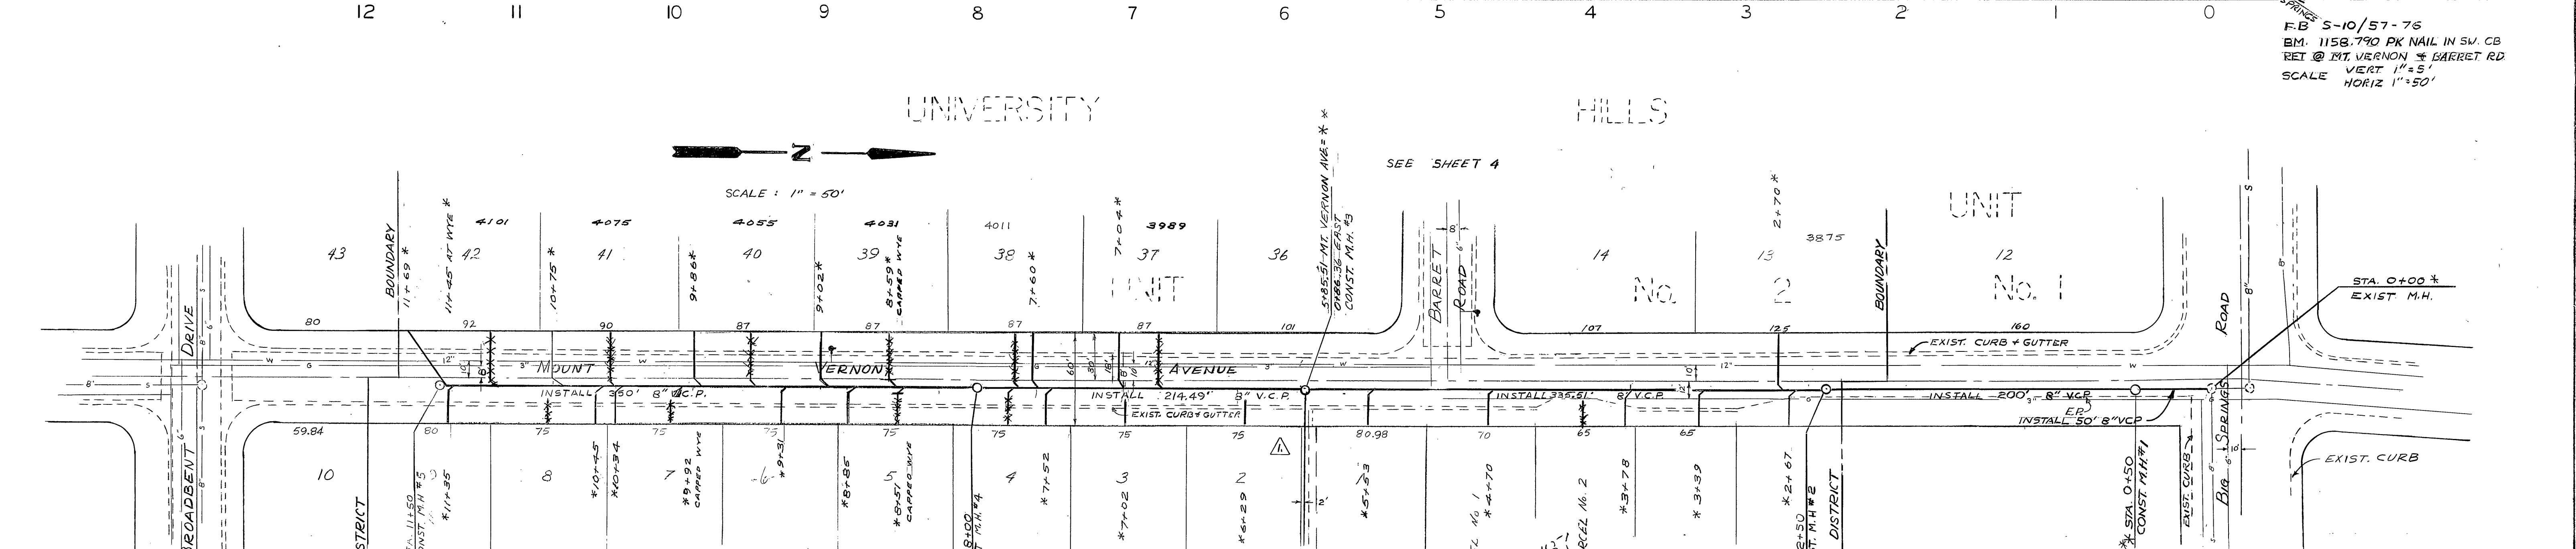


PLAN	
NO.	DATE
BY	
DATE	
BY	
DATE	
BY	
DATE	

F.B. 5-10/57-75  
 B.M. 1158.790 PK NAIL IN SW. CB  
 RET @ MT. VERNON & BARRET RD  
 VERT 1"=5'  
 SCALE HORIZ 1"=50'


NOTES:  
 1. ALL MANHOLES EXCEPT M.H.#6 SHALL BE CONSTRUCTED PER STD. DWG. NO. 500.  
 2. WYES AND LATERALS TO BE LOCATED IN THE FIELD.

REVISIONS		CITY OF RIVERSIDE, CALIFORNIA DEPARTMENT OF PUBLIC WORKS	
MARK	DATE	DESCRIPTION	
Δ	11-14-66	REVISED SEWER ALIGNMENT O.D.L. 11/15/66	REVISOR
		HAVENHURST - HAVERFORD SANITARY SEWER DISTRICT MOUNT VERNON AVENUE	
DESIGNED BY RRS	SUBMITTED BY <i>[Signature]</i>	APPROVED BY <i>[Signature]</i>	PROJ. NO. 6058
DRAWN BY Ron F. Ock	PARK DEPT. TRAFFIC DIV.	DIRECTOR OF PUBLIC WORKS	S-608
CHECKED BY <i>[Signature]</i>	RECOMMENDED BY <i>[Signature]</i>	DATE 6-8-66	SHEET 1 OF 5

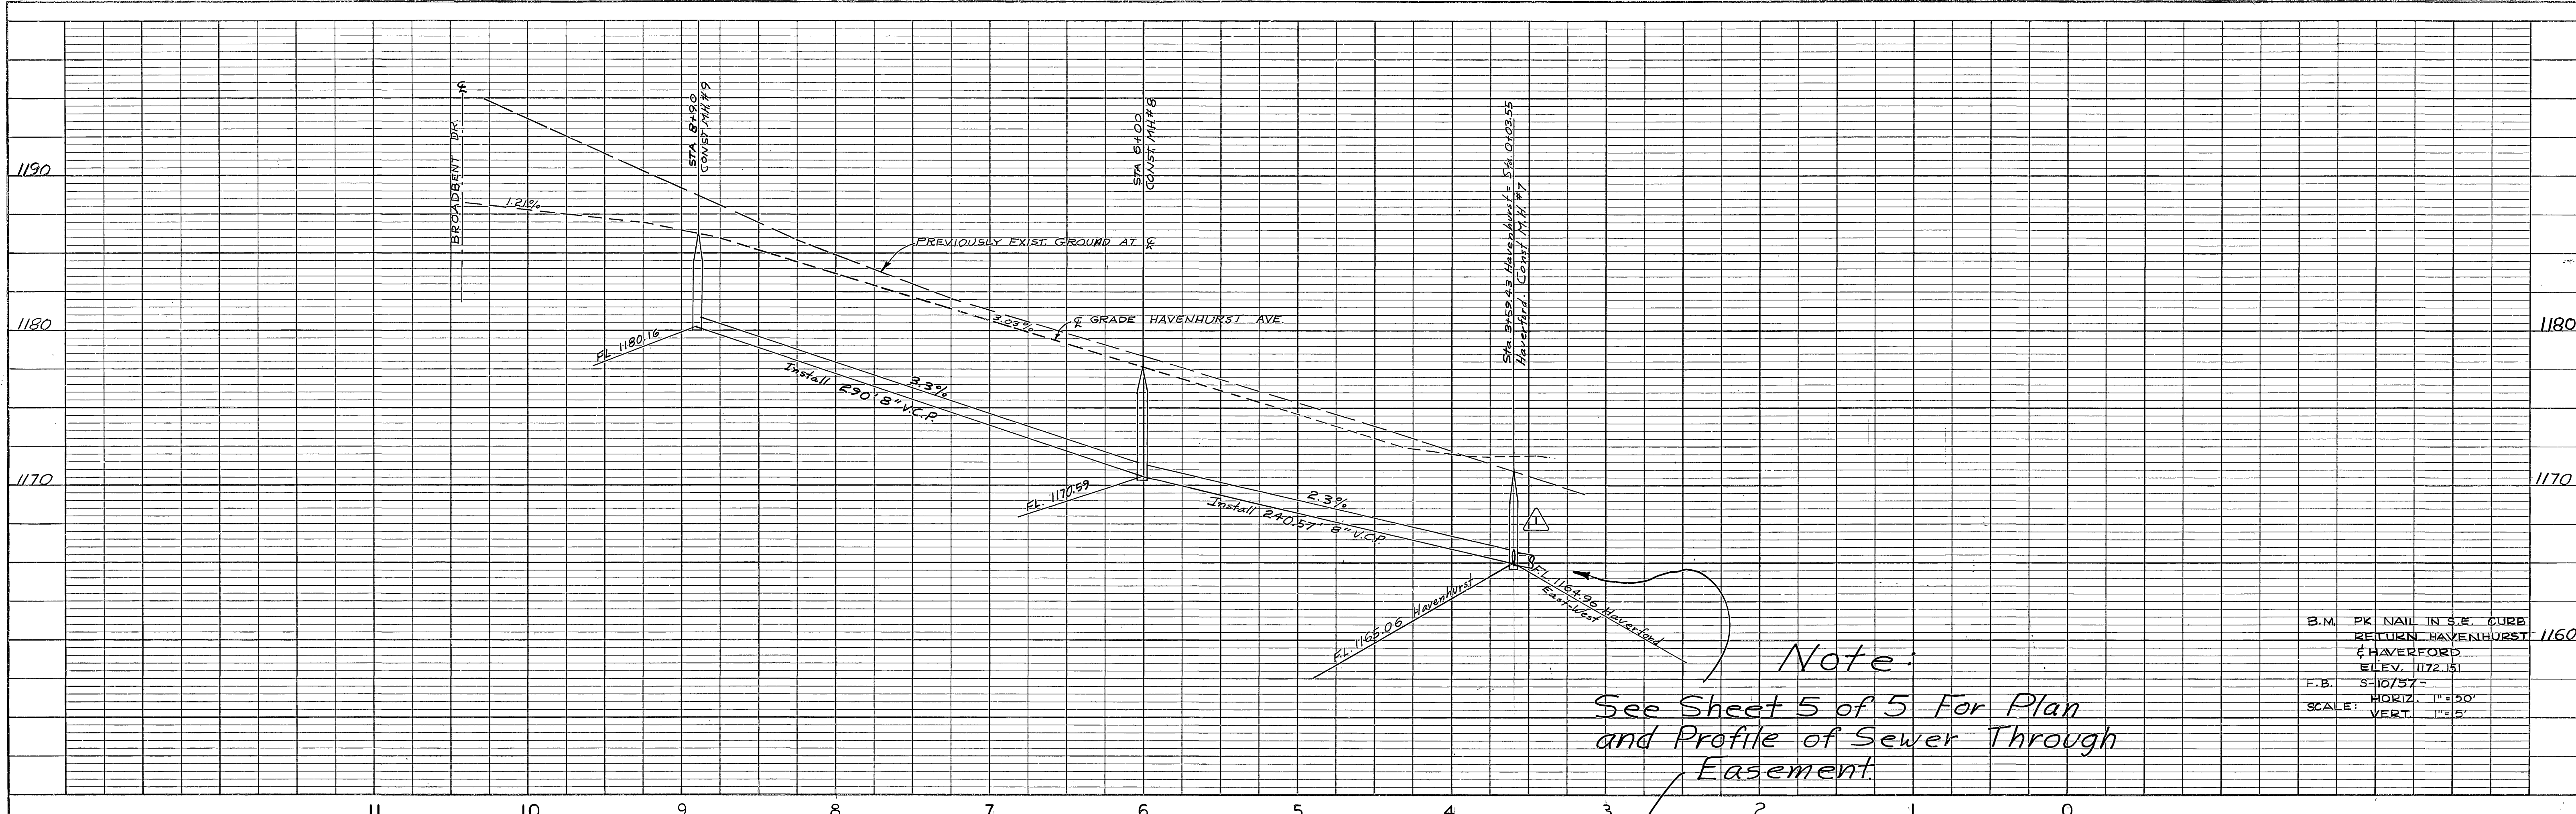

Note:  
 See Sheet 5 of 5 For Plan  
 and Profile of Sewer Through  
 Easement.



B.M. PK NAIL IN S.E. CURB  
 RETURN HAVENHURST 1160  
 HAVERFORD  
 ELEV. 1172.51  
 F.B. S-10/57-  
 SCALE: HORIZ. 1"=50'  
 VERT. 1"=5'

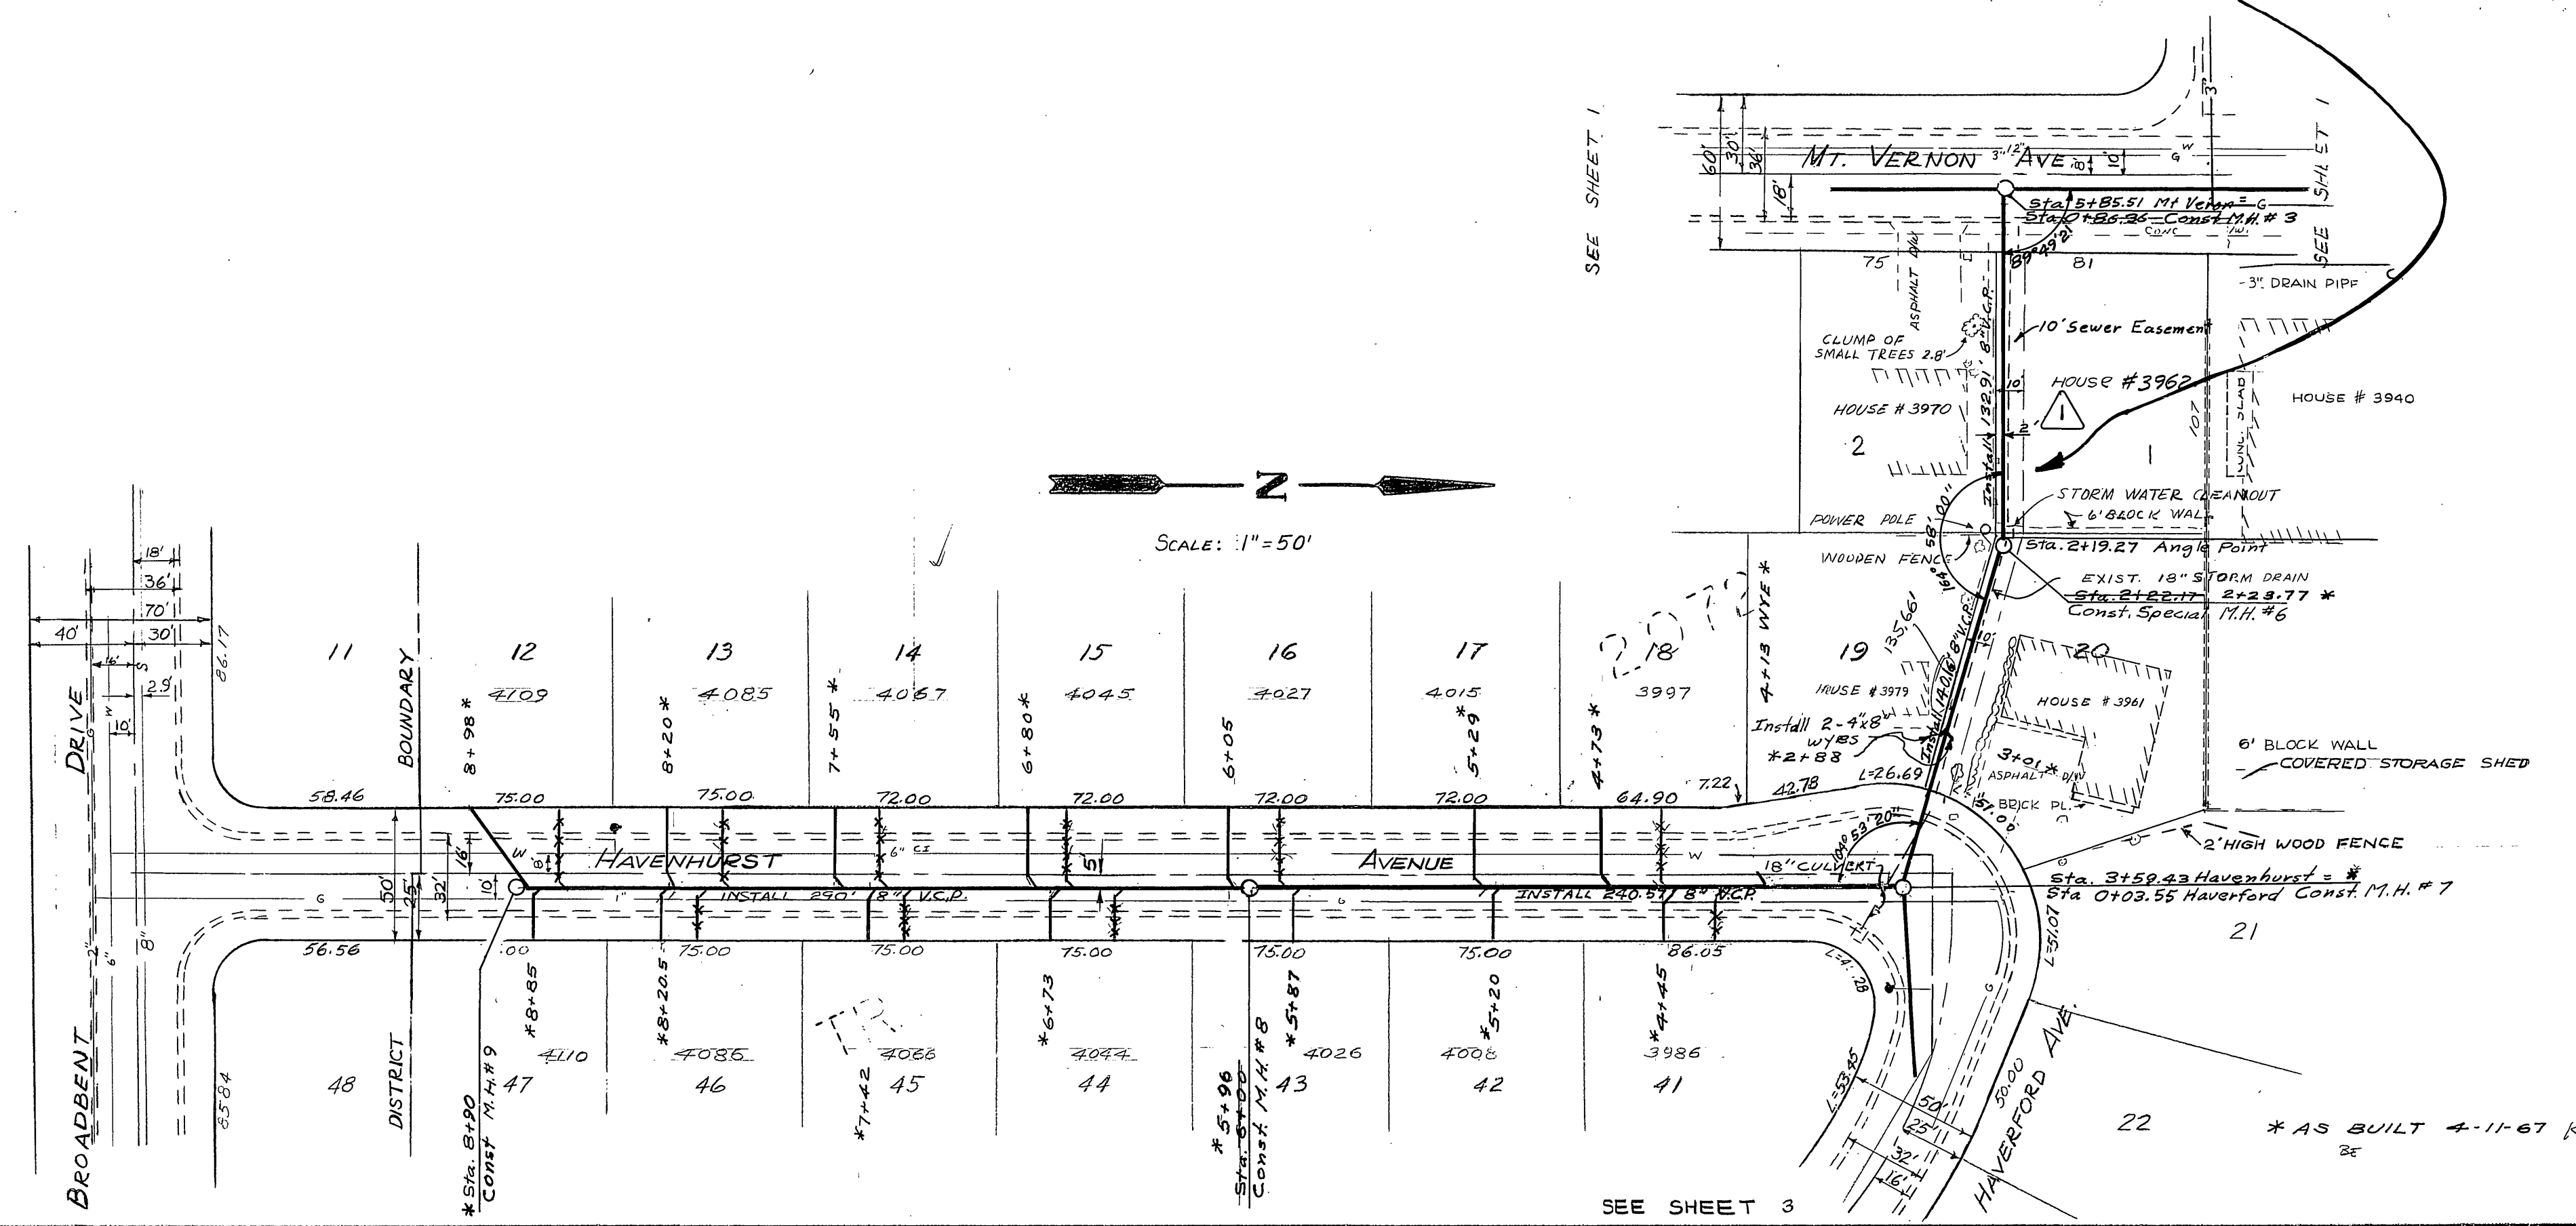

REVISIONS			CITY OF RIVERSIDE, CALIFORNIA DEPARTMENT OF PUBLIC WORKS	
MARK	DATE	DESCRIPTION	REVISED	
1	10-14-66	Revised Sewer Alignment D.S. HALL'S JRM	HAVENHURST - HAVERFORD SANITARY SEWER DISTRICT	
			HAVENHURST AVE.	
DESIGNED BY R.S.	SUBMITTED BY Charles E. Robertson	APPROVED BY <i>[Signature]</i> DIRECTOR OF PUBLIC WORKS	PROJ. NO. 6058	
DRAWN BY D.C.K.	PARK DEPT. TRAFFIC DIV.		S-608	
CHECKED BY HALL	RECOMMENDED BY [Signature]	DATE 6-9-66	SHEET 2 OF 5	

PROFILE		BY	DATE
SURVEYED	PLOTTED		
CHECKED	CHECKED		
NOTE BOOK	BY M. NOTED		
NO.	STRUCTURE NOTATIONS CHECKED		

PLAN		BY	DATE
SURVEYED	PLOTTED		
CHECKED	CHECKED		
NOTE BOOK	BY M. NOTED		
NO.	STRUCTURE NOTATIONS CHECKED		

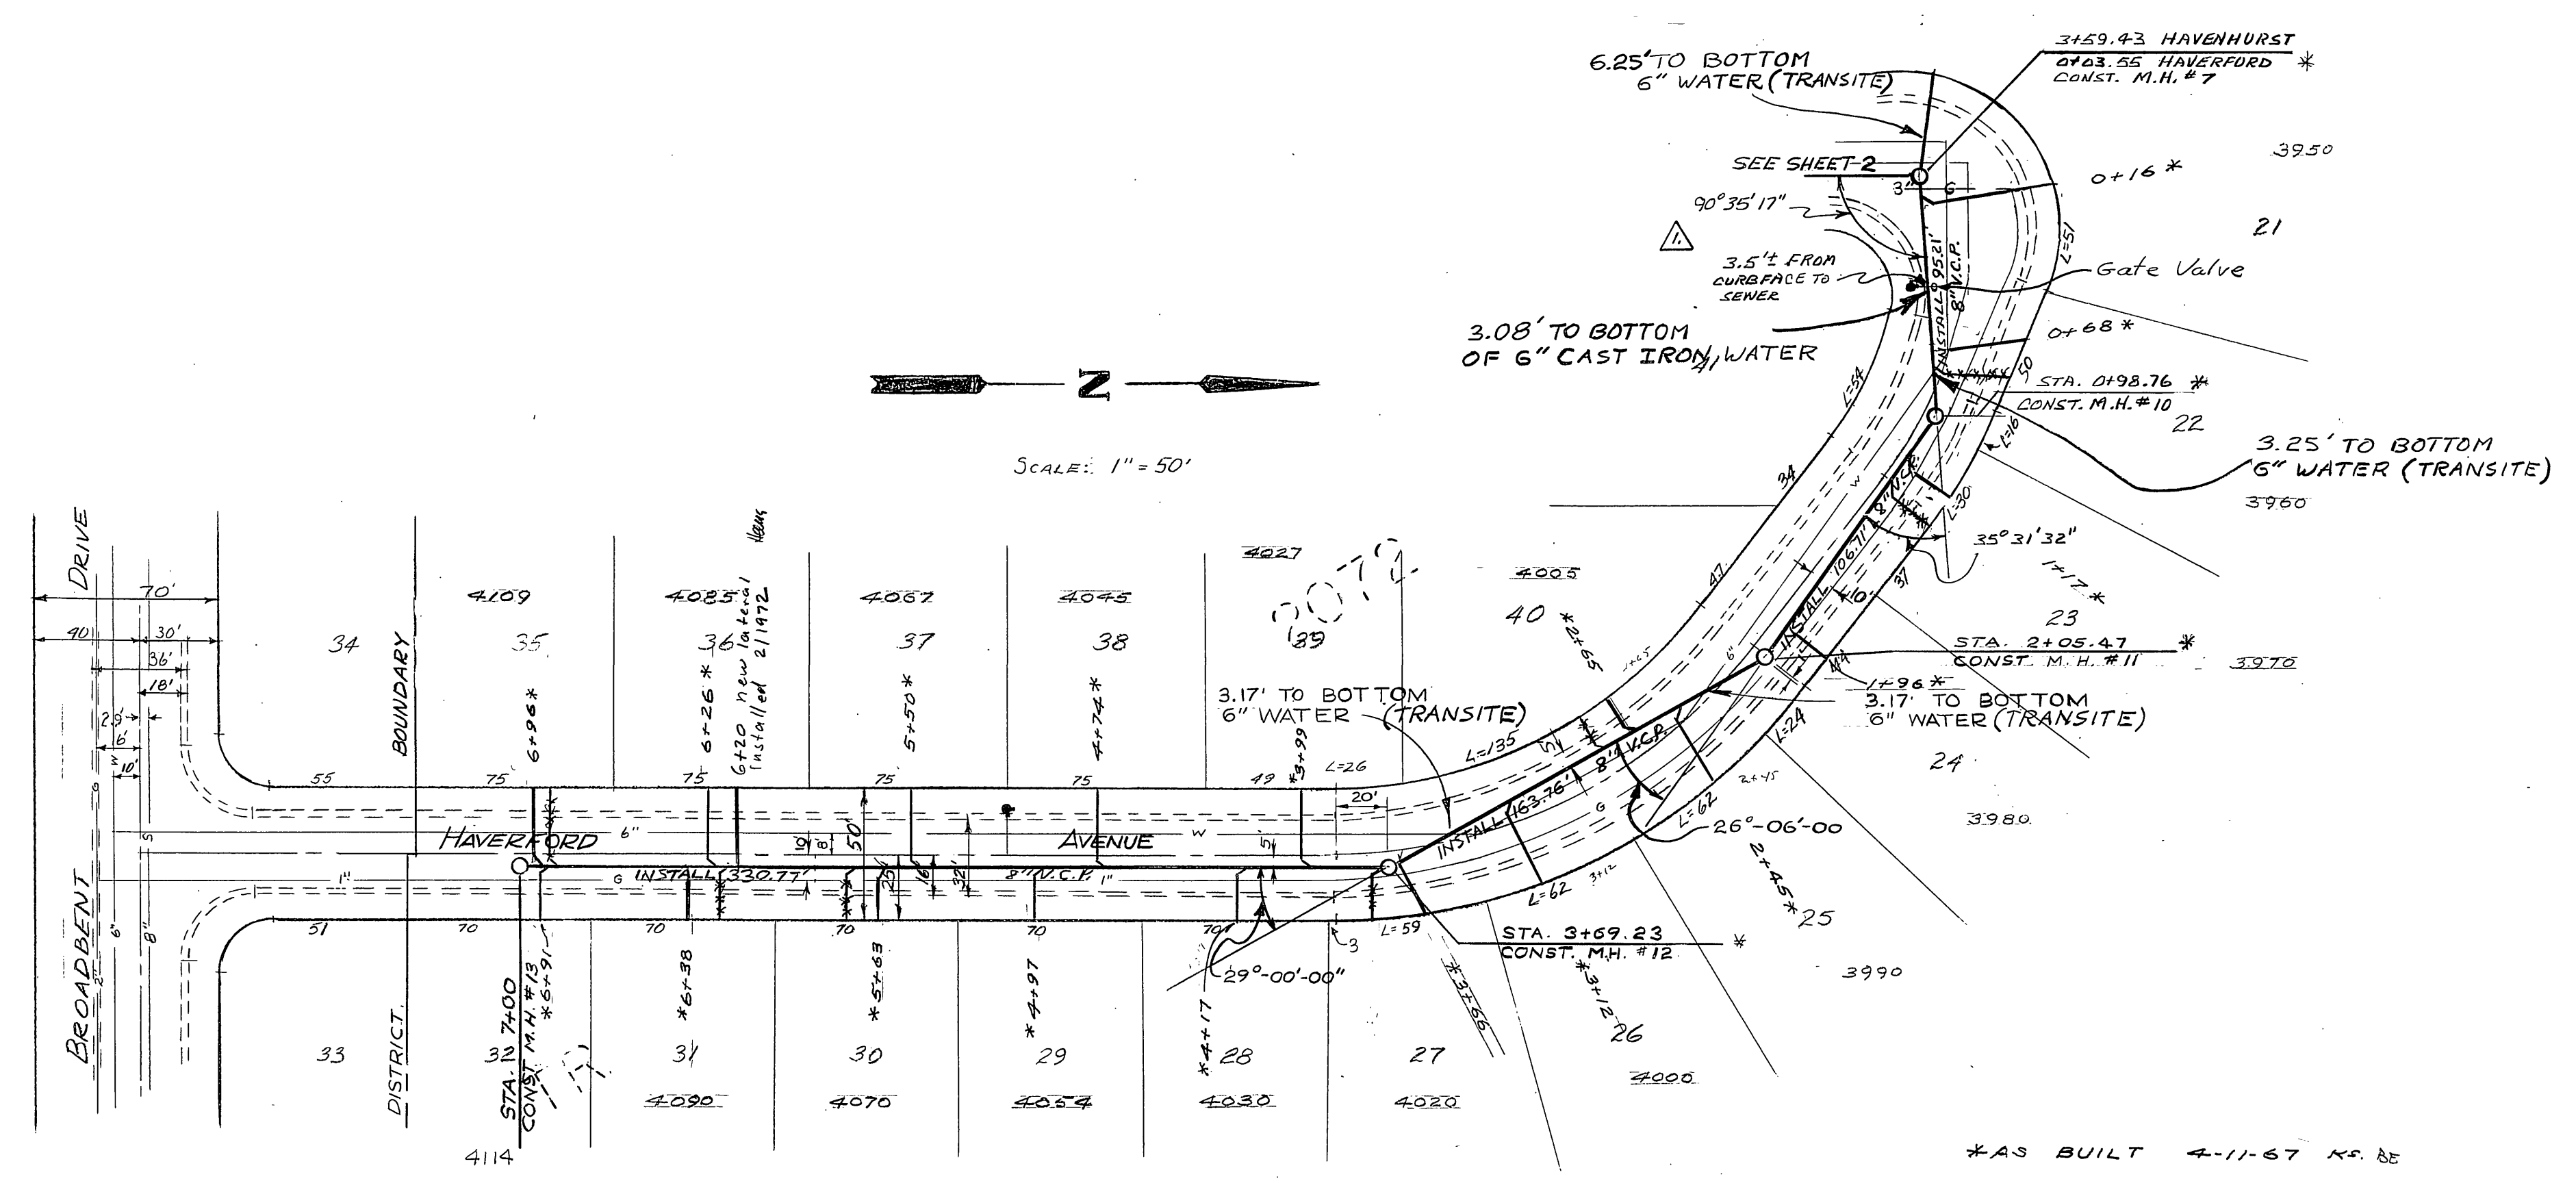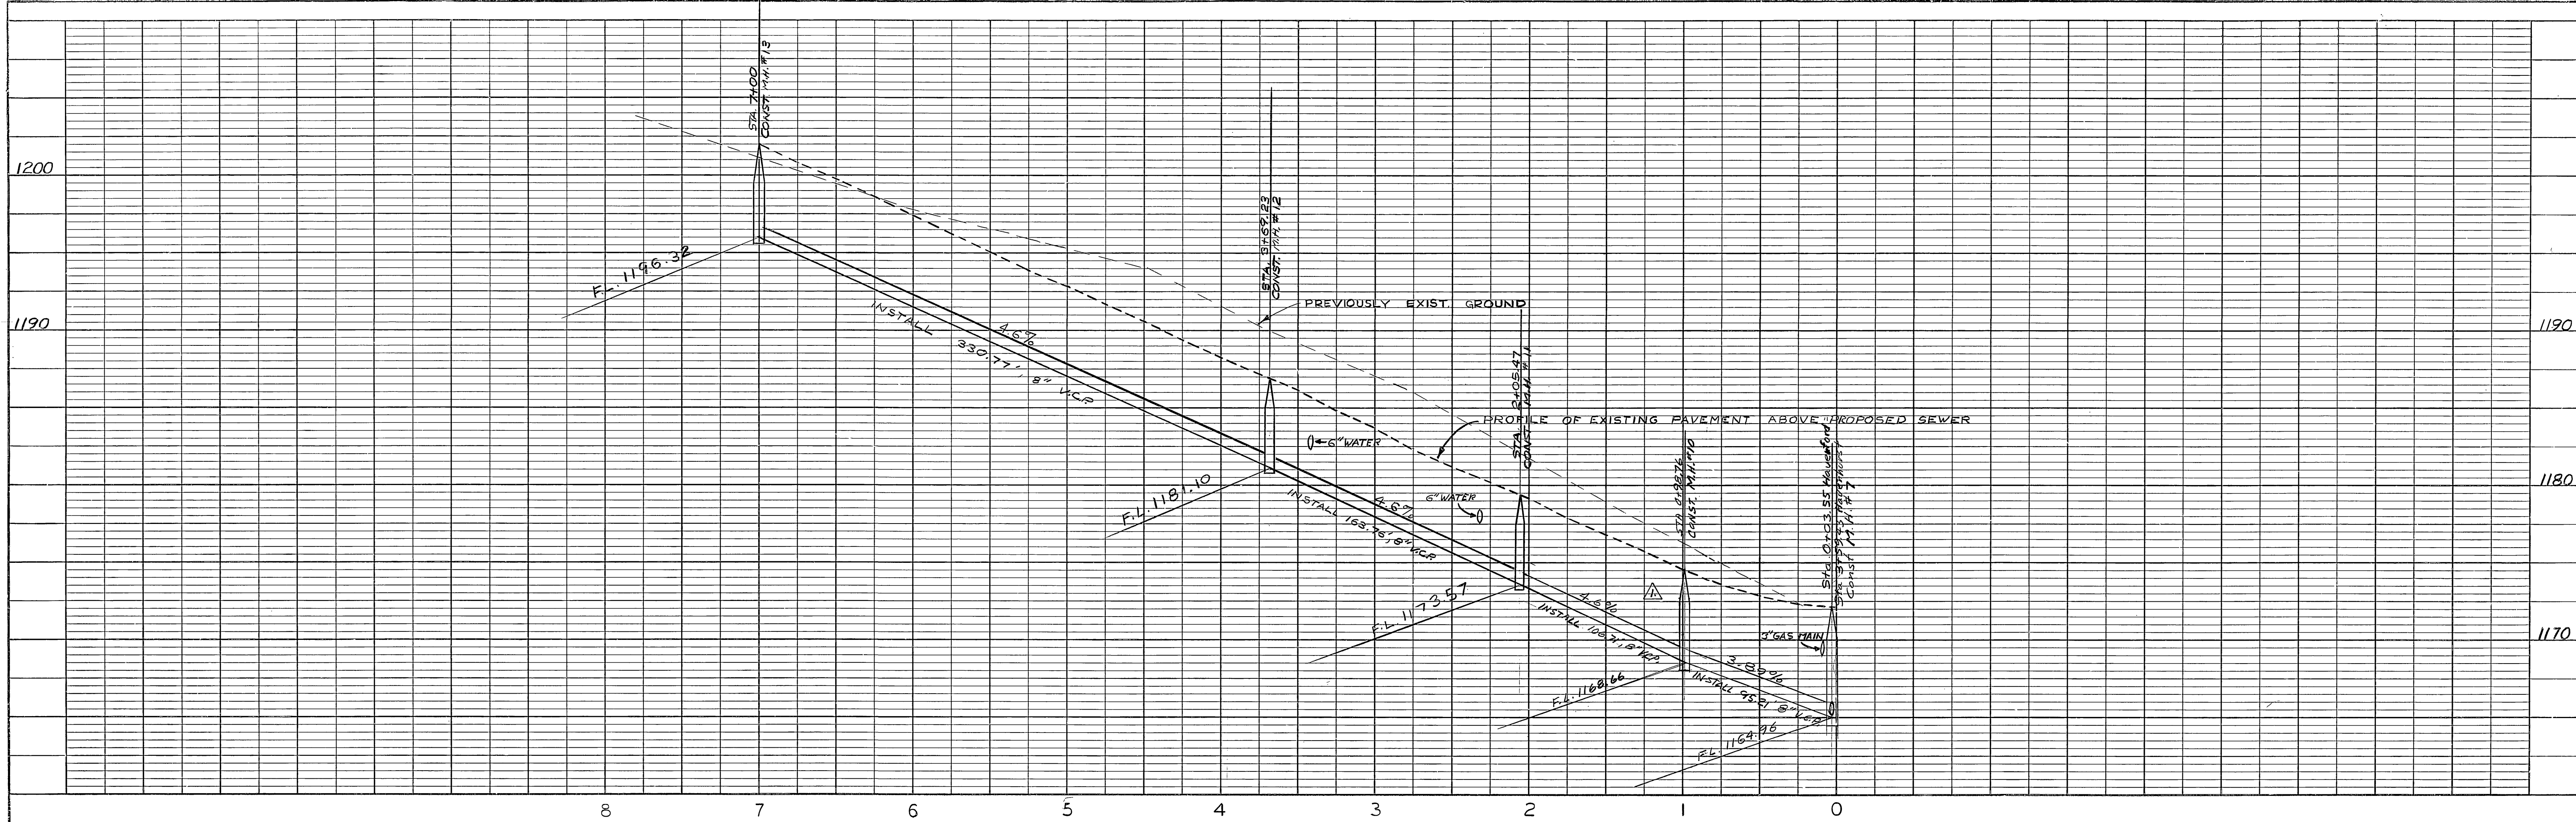


REVISIONS		
MARK	DATE	DESCRIPTION
Δ	10-14-66	REVISED SEWER ALIGNMENT


DESIGNED BY RRS	SUBMITTED BY <i>Robertson</i>	APPROVED BY <i>[Signature]</i>	PROJ. NO. 6058
DRAWN BY R. E. DCK	PARK DEPT. TRAFFIC DIV.	DIRECTOR OF PUBLIC WORKS	S-608
CHECKED BY H. W. [Signature]	RECOMMENDED BY [Signature]	DATE 6-8-66	SHEET 3 OF 5

NO.	PROF.	DATE
	SURVEYED	
	PLANNED	
	CHECKED	
	BY M. S. NOTED	
	STRUCTURE NOMINATIONS CHECKED	

NO.	PLAN	DATE
	SURVEYED	
	PLANNED	
	CHECKED	
	BY M. S. NOTED	
	STRUCTURE NOMINATIONS CHECKED	

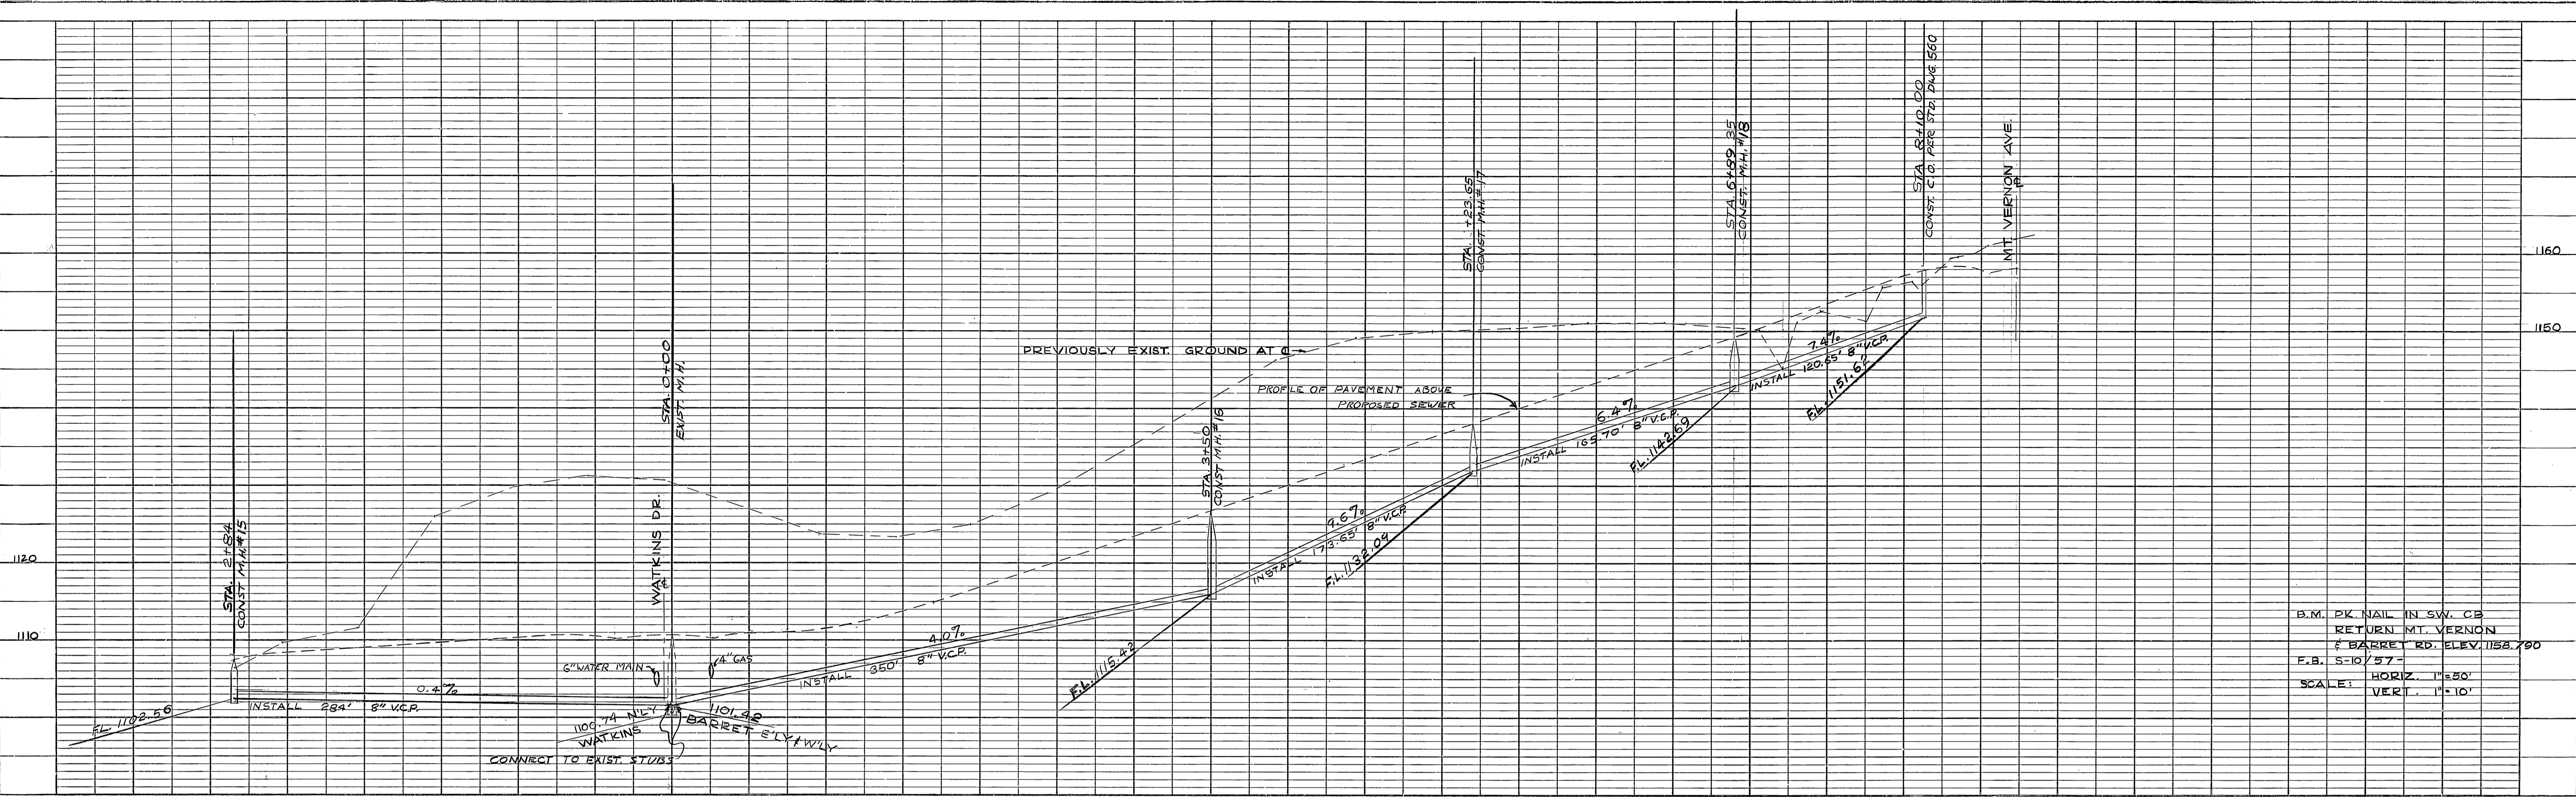

B.M. PK NAIL IN SW. CB  
 RETURN MT. VERNON  
 # BARRET RD. ELEV. 1158.790  
 F.B. S-10/57-  
 SCALE: HORIZ. 1"=50'  
 VERT. 1"=10'

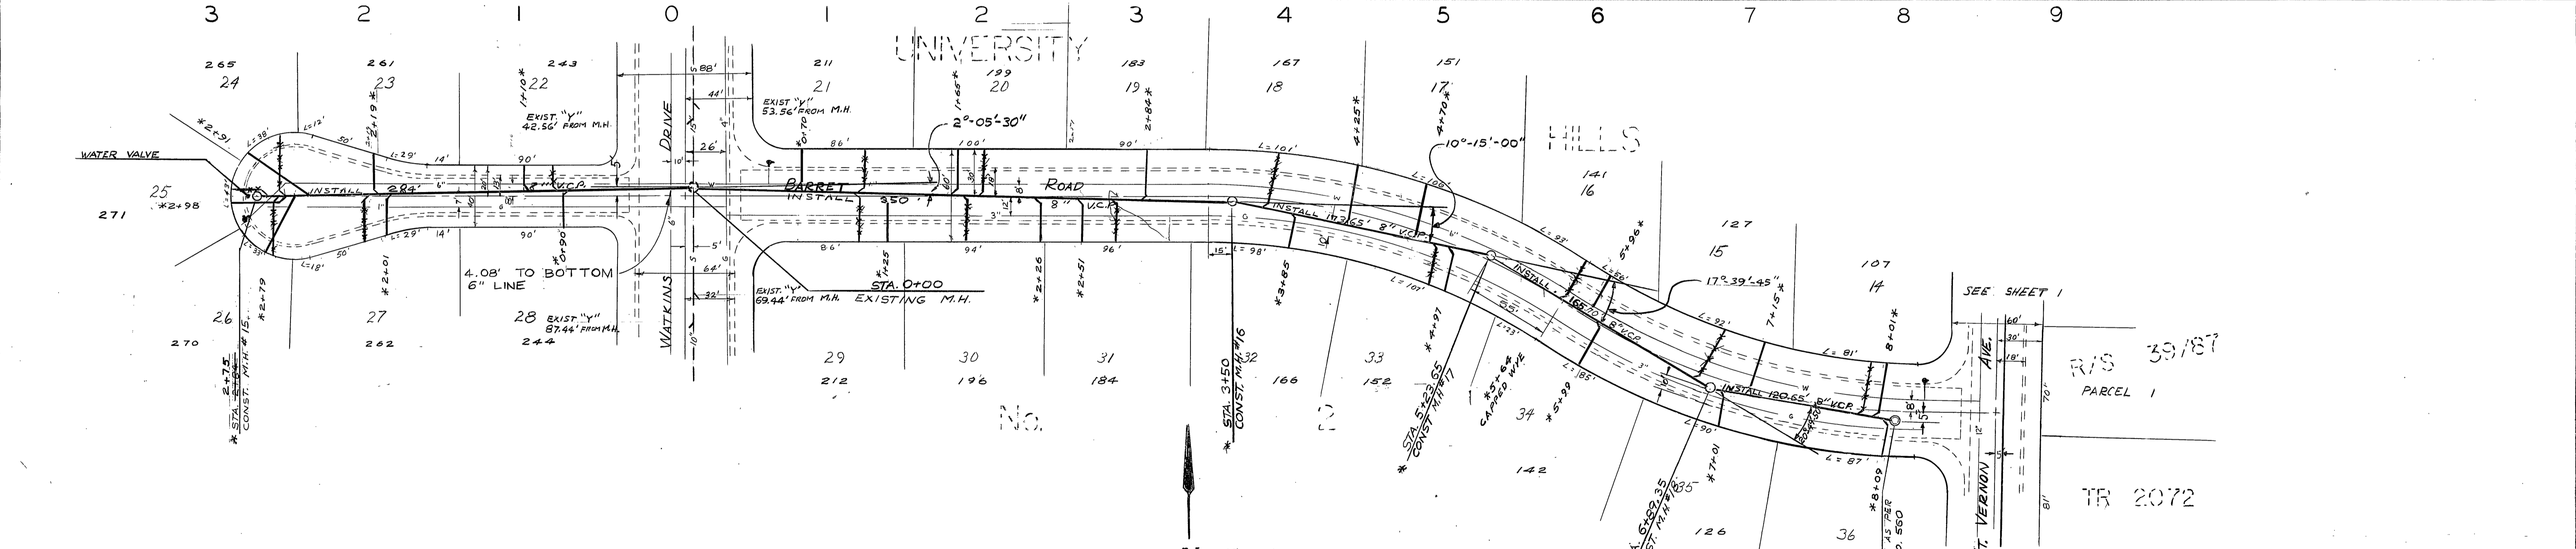

\* AS BUILT 4-11-67 KS  
 85



PROFILE

NO.	DATE

PLAN

NO.	DATE

REVISIONS		CITY OF RIVERSIDE, CALIFORNIA DEPARTMENT OF PUBLIC WORKS	
MARK	DATE	DESCRIPTION	
DESIGNED BY RRS		SUBMITTED BY <i>W. H. &amp; K. H.</i>	
DRAWN BY R. F. EDCK		APPROVED BY <i>[Signature]</i> DIRECTOR OF PUBLIC WORKS	
CHECKED BY <i>[Signature]</i>		RECOMMENDED BY <i>[Signature]</i>	
		DATE 6-8-66	PROJ. NO. 6058
			S-608
			SHEET 4 OF 5

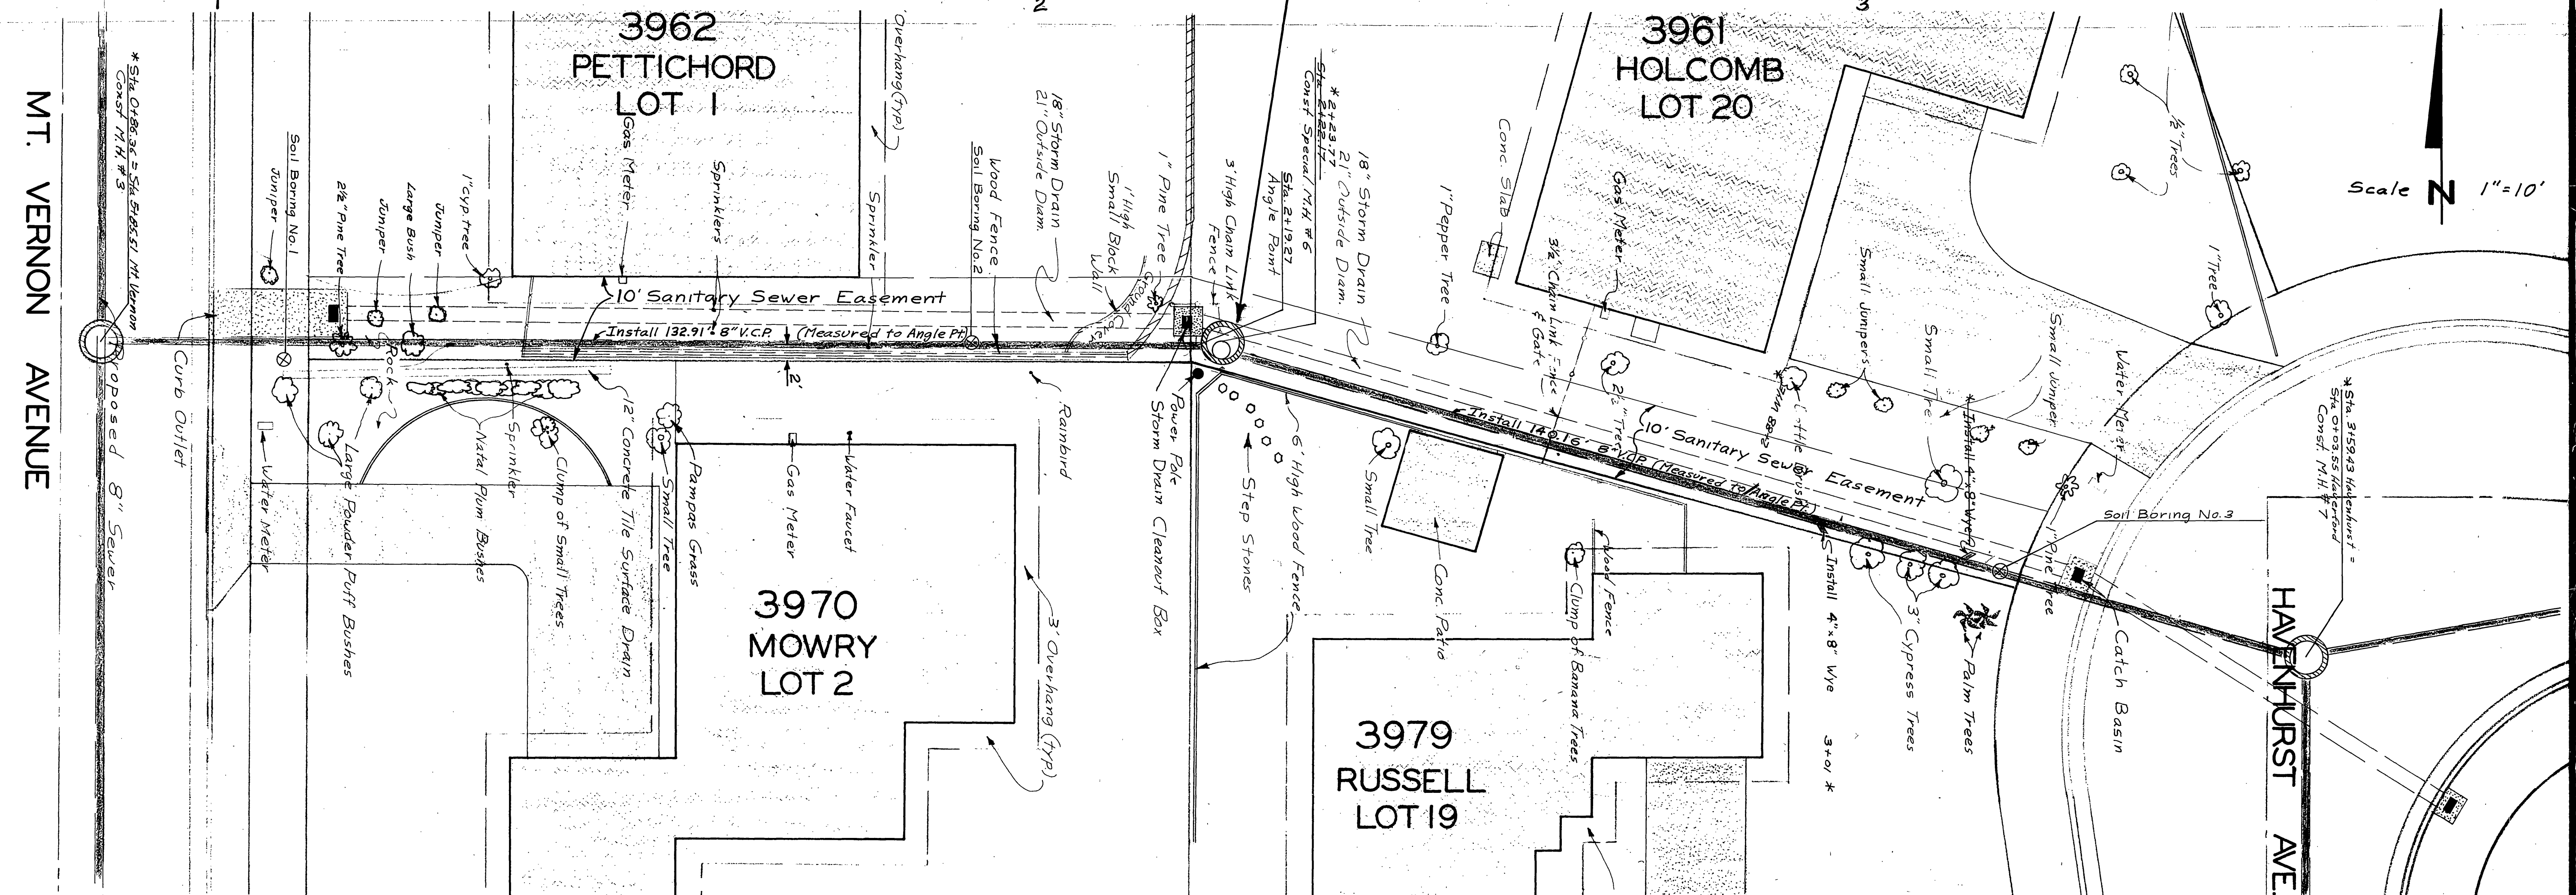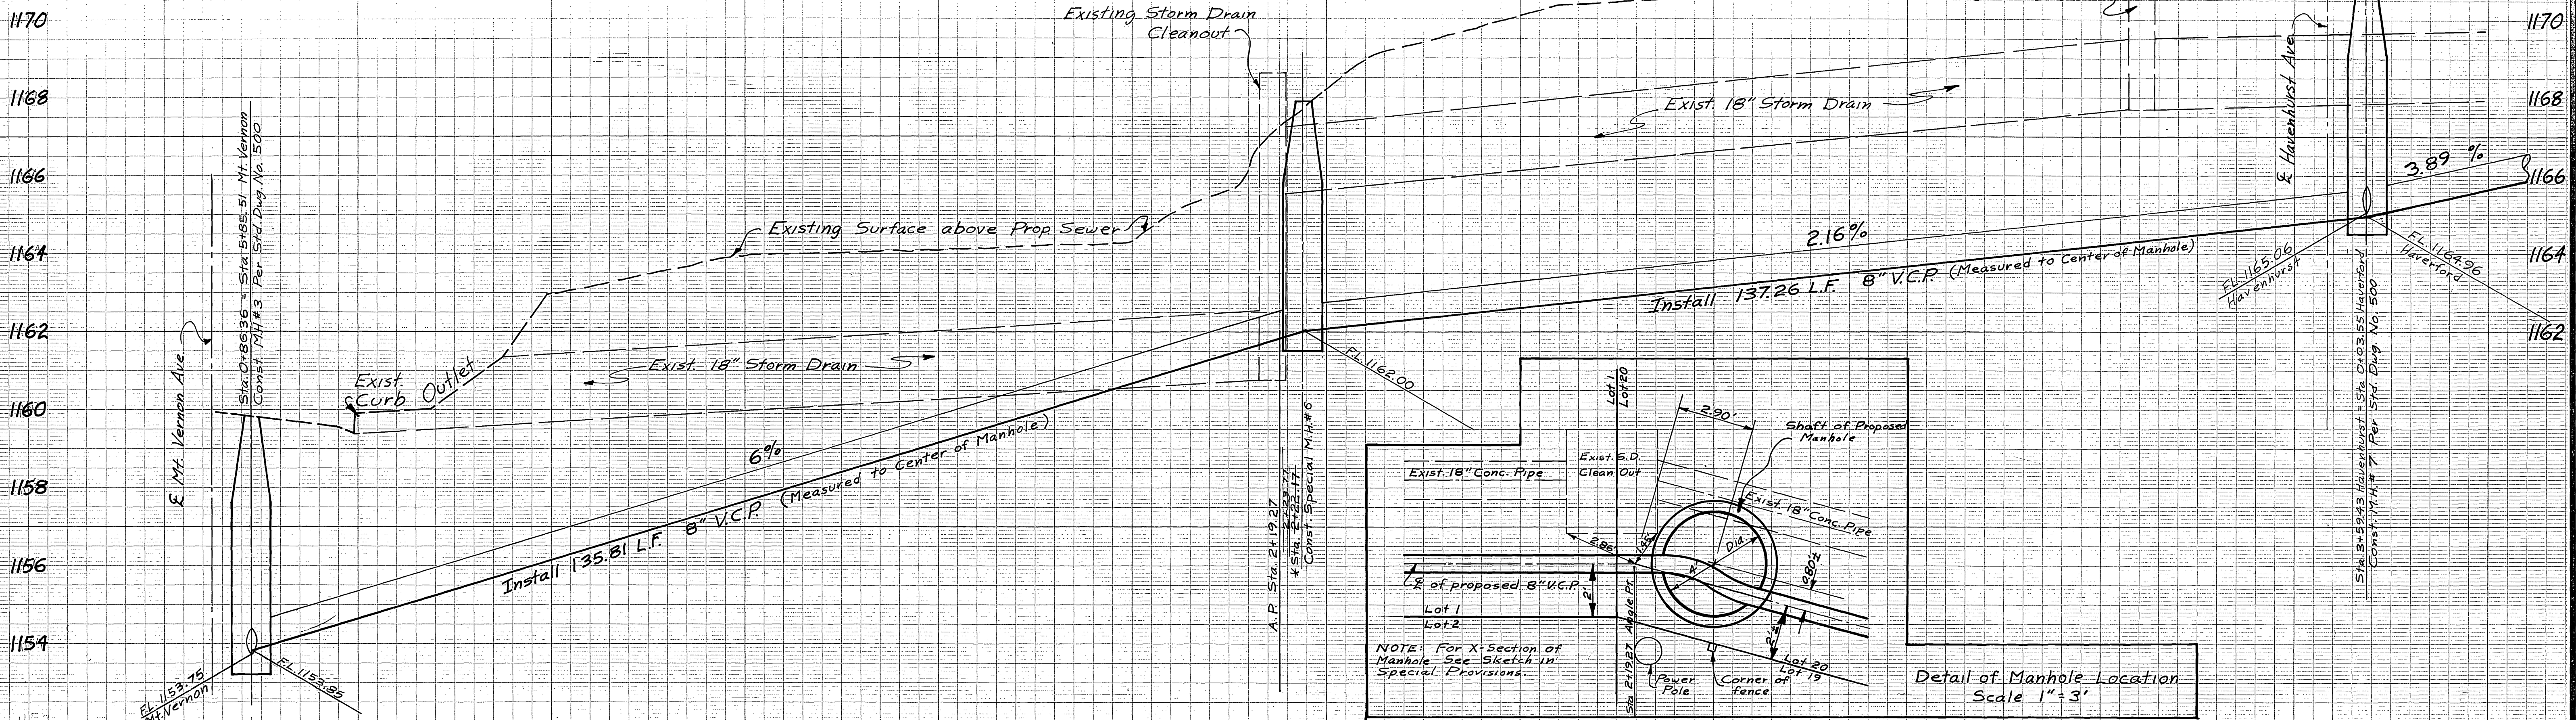

MT. VERNON AVENUE

HAVENHURST AVE

Scale N 1"=10'

\*AS BUILT 4-11-67 K.S. bc

CITY OF RIVERSIDE, CALIFORNIA DEPARTMENT OF PUBLIC WORKS		HAVENHURST — HAVERFORD SANITARY SEWER DISTRICT		PROJECT NO. 6058
APPROVED BY	DATE	APPROVED BY	DATE	S-608
OFFICE ENGINEER		DIRECTOR OF PUBLIC WORKS		SHEET 5 OF 5
PARK DEPARTMENT		DATE 10-20-66		FILE NO.
TRAFFIC DIVISION				
ASSISTANT CITY ENG				
DESIGNED BY	DRAWN BY	CHECKED BY		

REF: FB.727/45-52, FB. M-1/41-42  
 HORIZ. SCALE: 1" = 10' VERT. SCALE: 1" = 2'