

Note: Laterals to be located in the field.

Bench Mark: Top of 4\"/>

GENERAL NOTES

1. Construction shall be in accordance with the City of Riverside, Department of Public Works, Standard Specifications No. 461 and Standard Drawings.
2. It shall be the responsibility of the contractor to clear the right of way in accordance with the provisions of the law as it affects each utility including irrigation lines and appurtenances and at no cost to the City.
3. Joints in vitrified clay pipe sewers shall conform to ASTM Standard C-425-60T, or the latest revision thereof.
4. Pipe shall be bedded per Case II, Standard Drawing No. 452, unless otherwise specified on plan.
5. Location of wyes and laterals to be determined in the field.
6. All stubs and laterals to be constructed in accordance with Standard Drawing No. 562. Stubs shall be plugged and capped.

REVISIONS		
MARK	DATE	DESCRIPTION
	1/24/66	Revised sewer grades, 92M
DESIGNED BY	R.J.M.	CHECKED BY Babo
DRAWN BY	R.J.M.	
RECOMMENDED BY		ASSISTANT CITY ENGINEER

R. 853

J. F. DAVIDSON-CIVIL ENGINEER
R.E. NO. 862
RIVERSIDE, CALIFORNIA
APPROVED BY *George C. M. Cuts* DATE 2/4/65

CITY OF RIVERSIDE, CALIFORNIA
DEPARTMENT OF PUBLIC WORKS



Sewer PLAN & PROFILE
TRACT 3166
COUNTRY CLUB DRIVE

HORIZ. SCALE 1" = 40'
VERT. SCALE 1" = 8'

DESIGNED BY R.J.M. CHECKED BY Babo
DRAWN BY R.J.M.
RECOMMENDED BY *[Signature]* ASSISTANT CITY ENGINEER

APPROVED BY *[Signature]* DIRECTOR OF PUBLIC WORKS
DATE *[Signature]*

NO. **S-611**
SHEET 1 OF 3

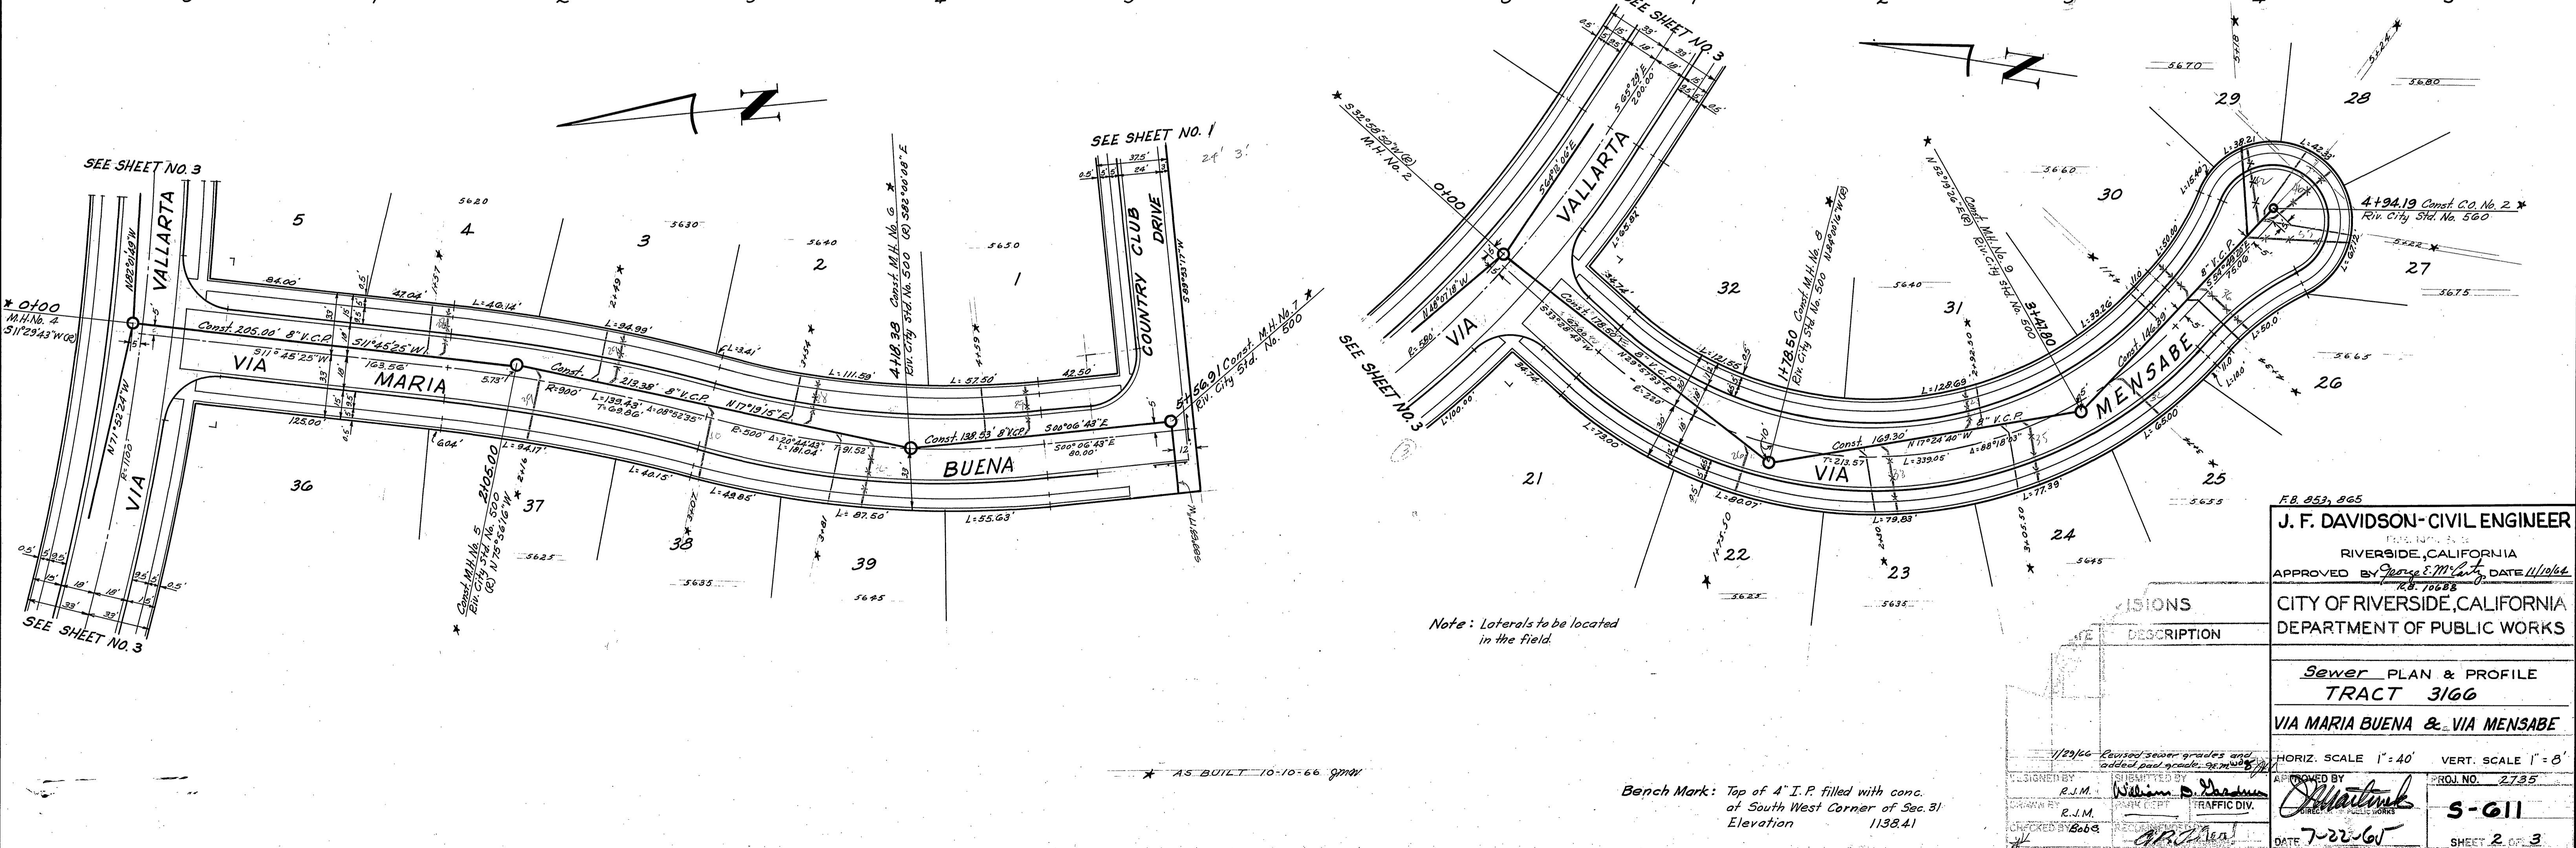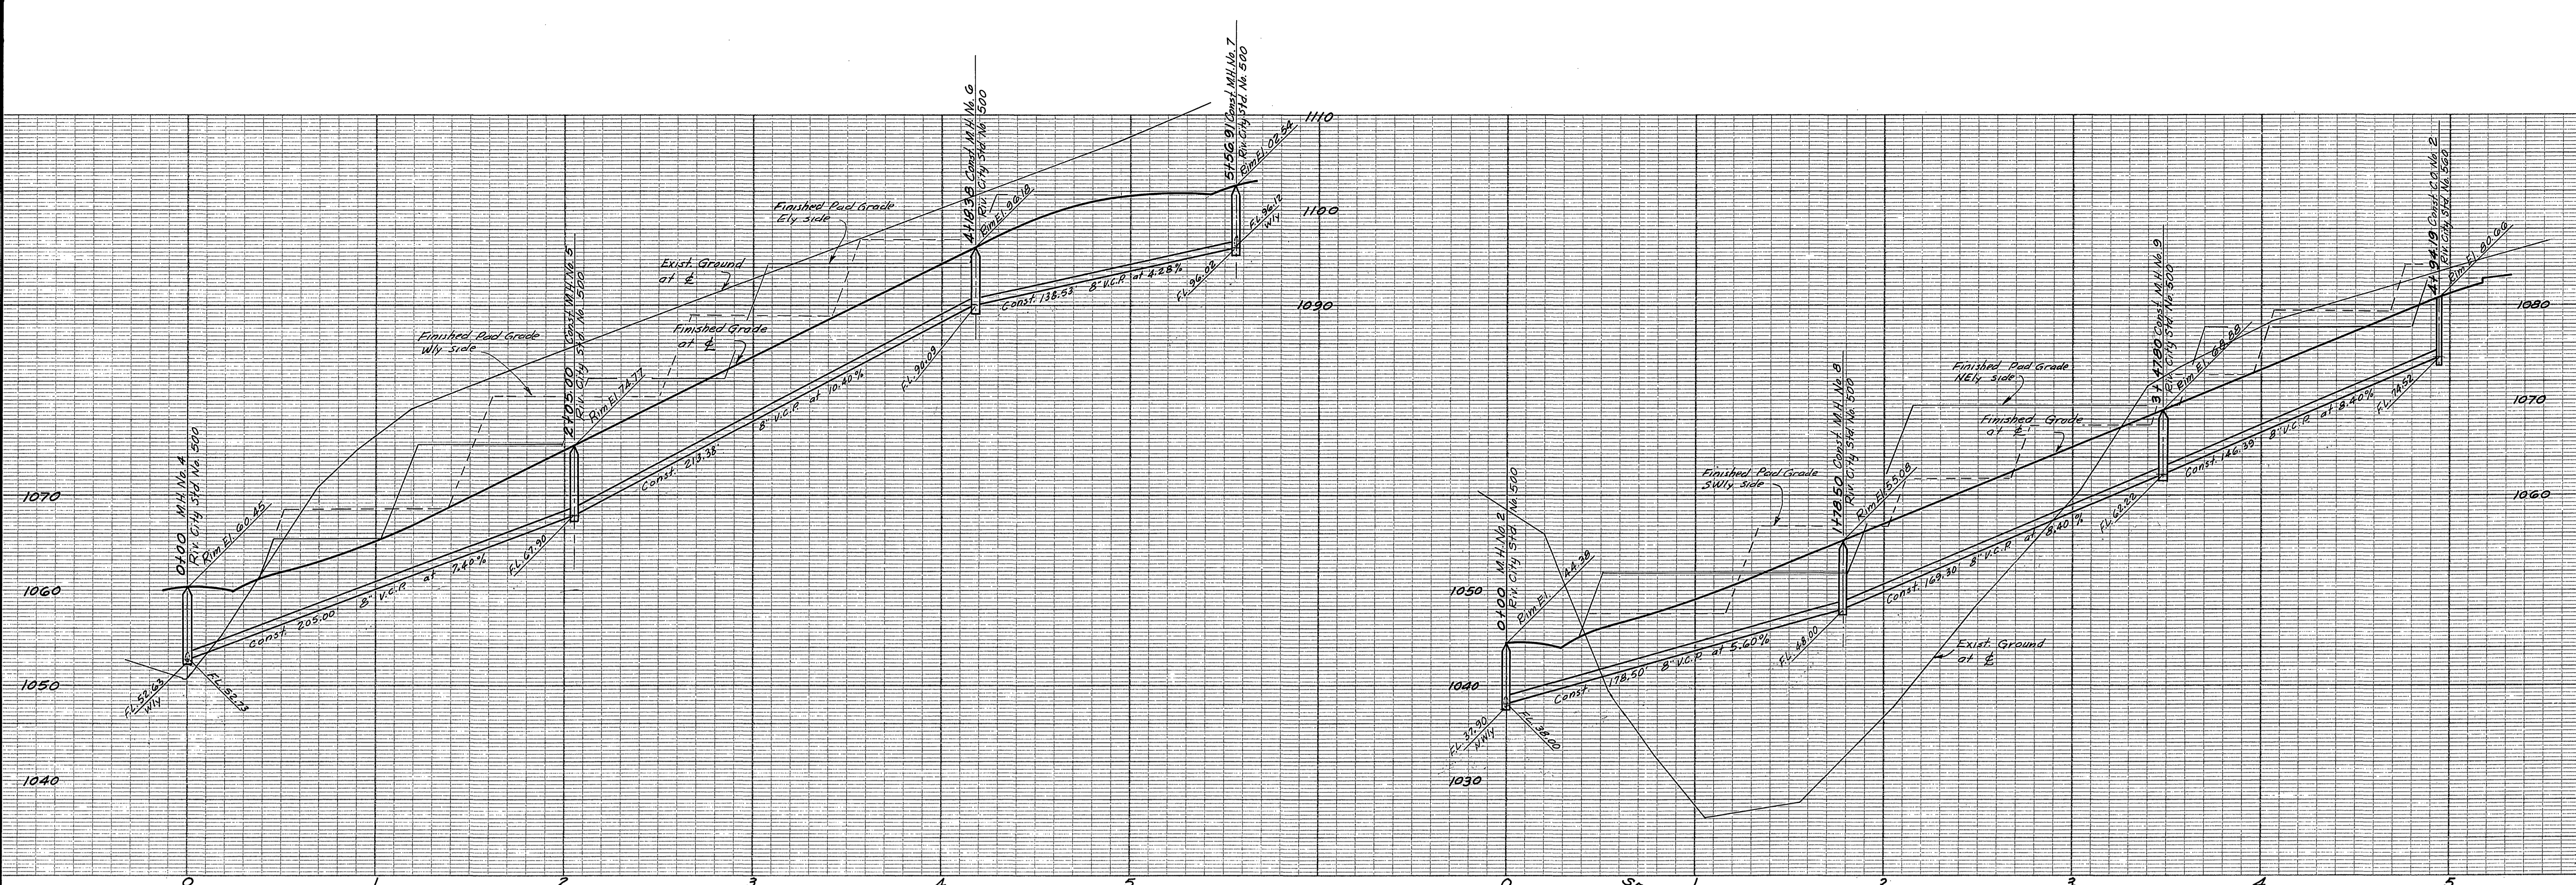

Note: Laterals to be located in the field.

AS BUILT 10-10-66 gmm

Bench Mark: Top of 4" I.P. filled with conc. at South West Corner of Sec. 31 Elevation 1138.41

J. F. DAVIDSON-CIVIL ENGINEER
 RIVERSIDE, CALIFORNIA
 APPROVED BY *George E. M...* DATE 11/10/64
 R.S. 10688
 CITY OF RIVERSIDE, CALIFORNIA
 DEPARTMENT OF PUBLIC WORKS

NO.	DESCRIPTION
1	Sewer Plan & Profile
2	TRACT 3166
3	VIA MARIA BUENA & VIA MENSABE

1/23/66 Revised sewer grades and added pad grade...
 DESIGNED BY R.J.M. William D. Davidson
 DRAWN BY R.J.M. PARK DEPT. OF PUBLIC WORKS
 CHECKED BY Bobe
 DATE 7-22-65

HORIZ. SCALE 1" = 40' VERT. SCALE 1" = 8'
 AUTHORIZED BY *William D. Davidson*
 PROJ. NO. 2795
S-611
 SHEET 2 OF 3

