


57

N MARKET

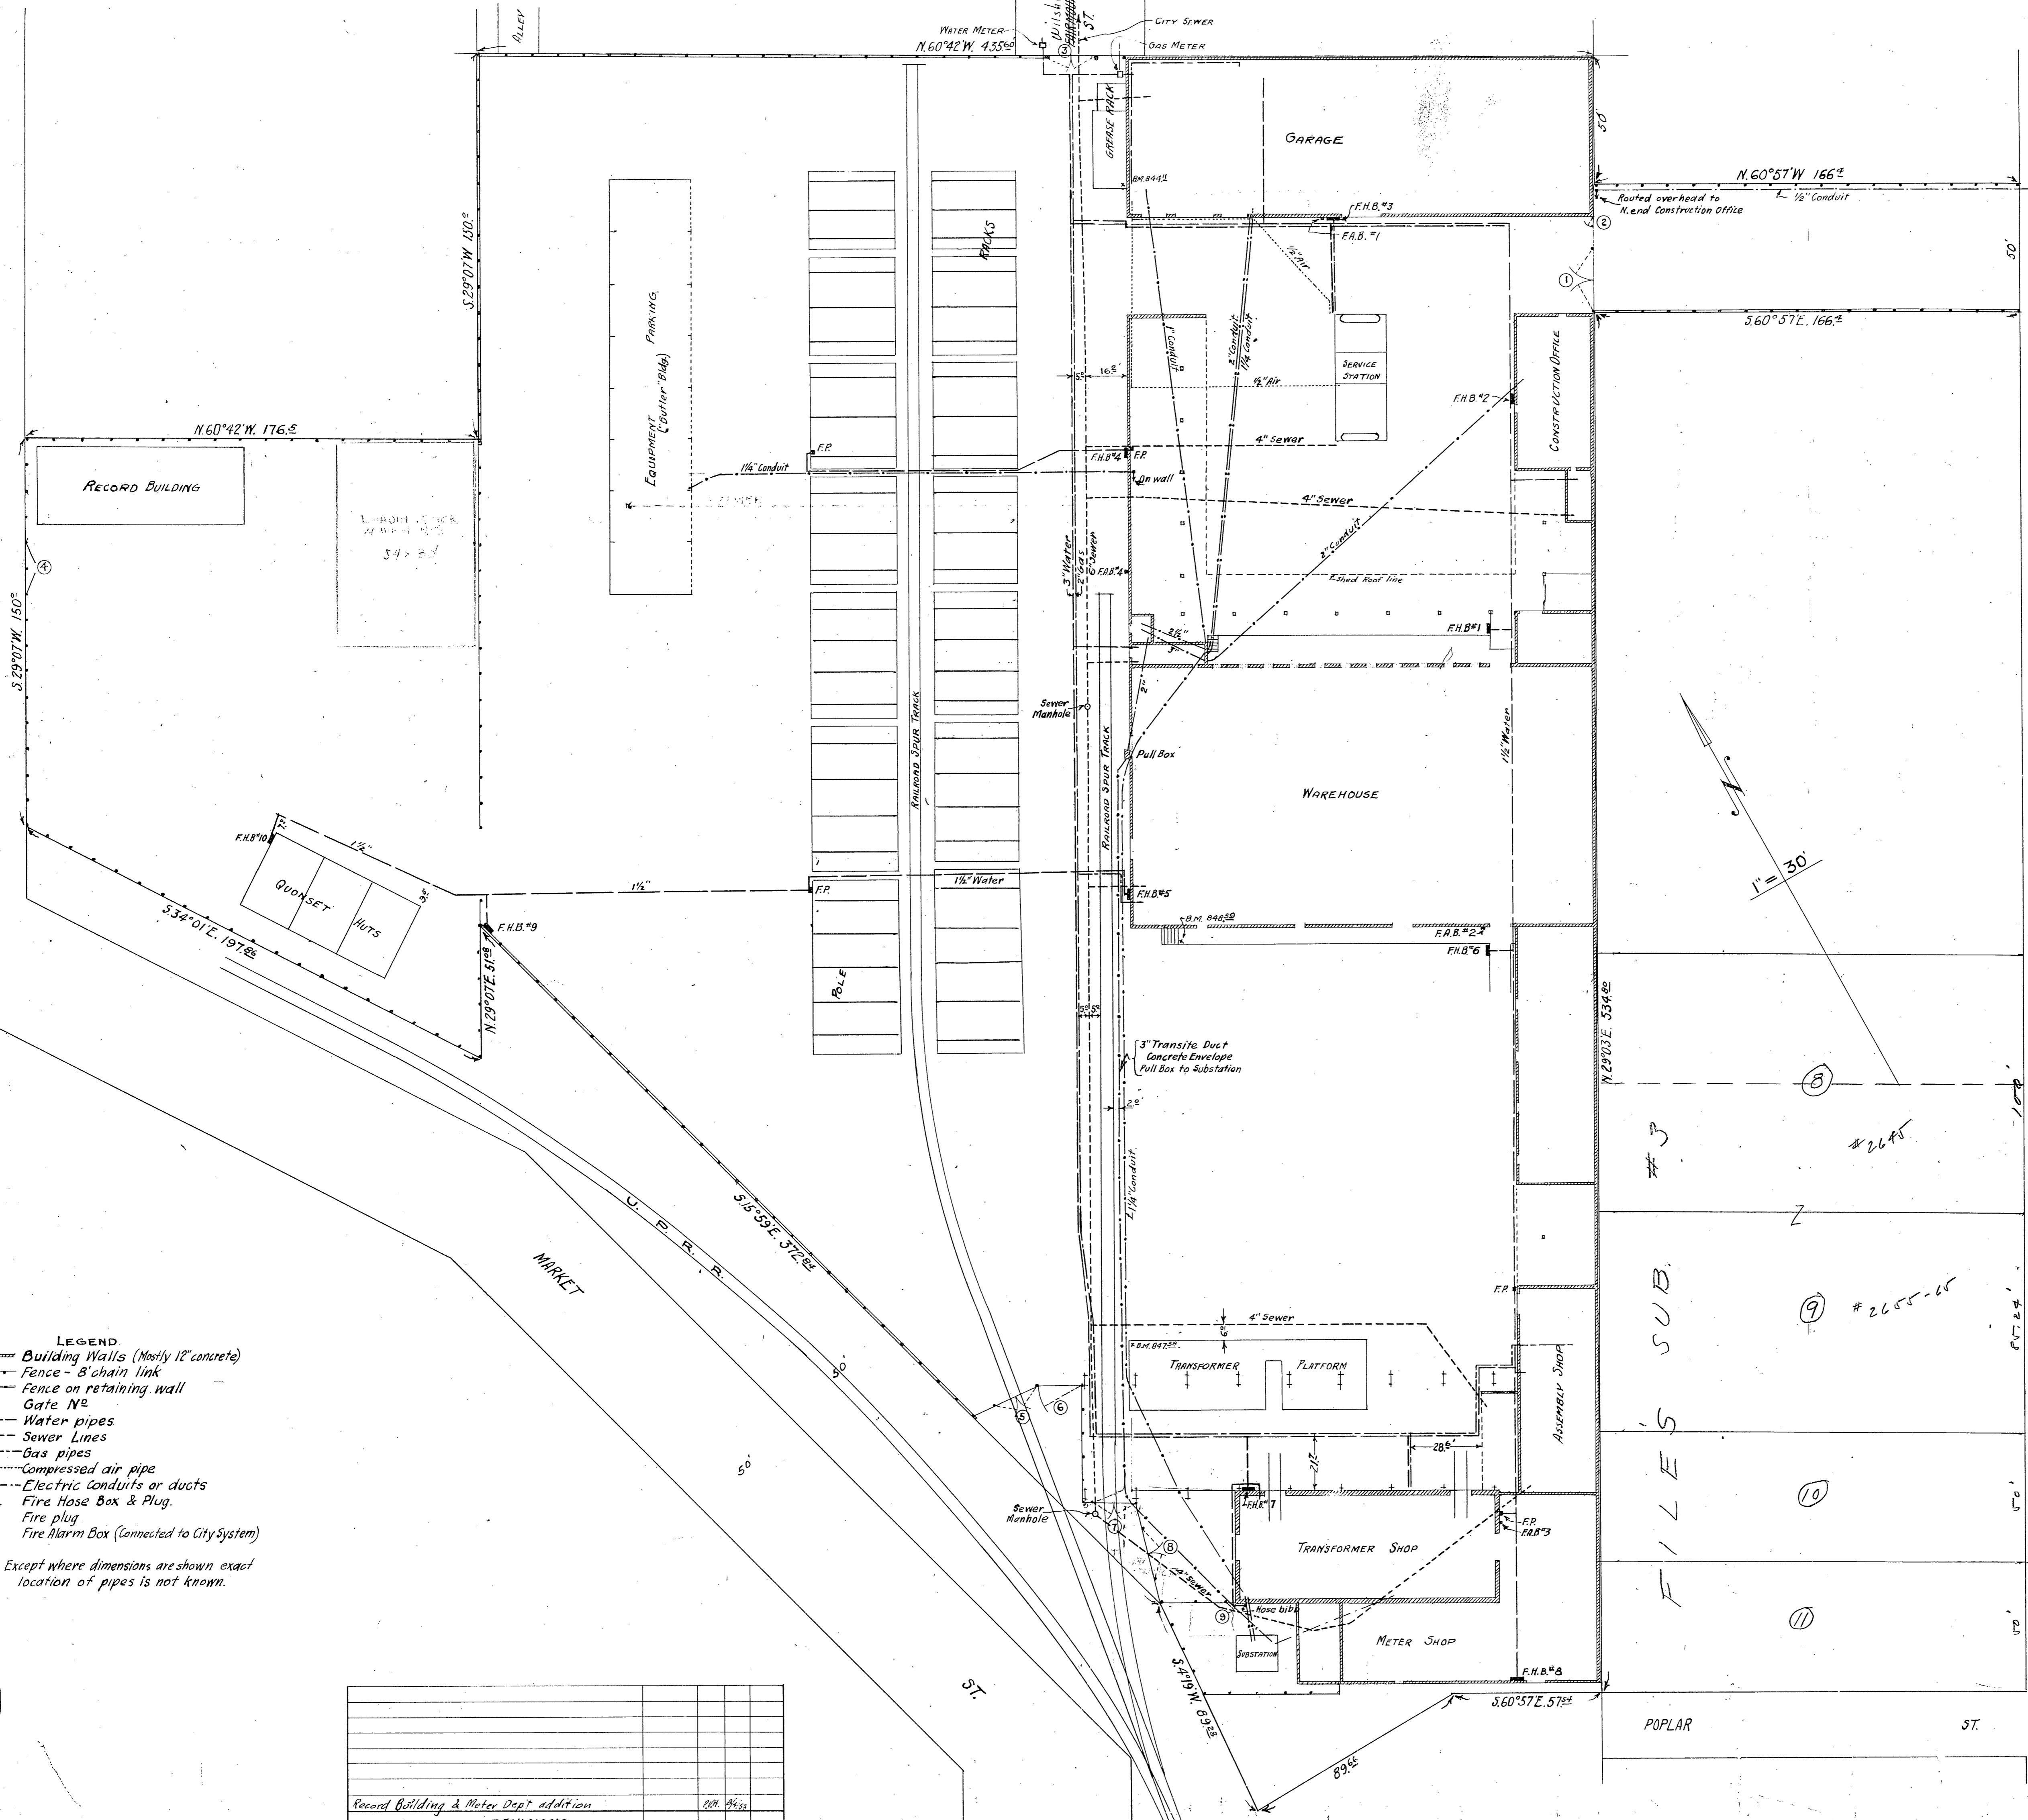

1 ST.

N MAIN

FILES SUB.

POPLAR

ST.

- LEGEND**
- Building Walls (Mostly 12" concrete)
 - Fence - 8' chain link
 - Fence on retaining wall
 - Gate No.
 - Water pipes
 - Sewer Lines
 - Gas pipes
 - Compressed air pipe
 - Electric conduits or ducts
 - F.H.B. Fire Hose Box & Plug.
 - F.P. Fire plug
 - F.A.B. Fire Alarm Box (connected to City System)

Note: Except where dimensions are shown exact location of pipes is not known.

REVISIONS	AUTHORITY	BY	DATE	APP'D
Record Building & Meter Dept addition			8/23/50	

MAP OF
RIVERSIDE INDUSTRIAL GROUP
 SHOWING
 UNDERGROUND WATER SEWER GAS & ELECTRIC CONDUITS
 Drawing J.N.K. & P.V.H. 1/4/50
 APPROVED _____
 CALIFORNIA ELECTRIC POWER COMPANY

RECEIVED
 JUN 17 1965
 DEPT. OF PUBLIC WORKS

3-628