


B.M. ELEV. 781.78' X ON F.H. BOLT S.W. CORNER
MAGNOLIA & MONROE.

F.B. 242/72-76
E.B. 242/80

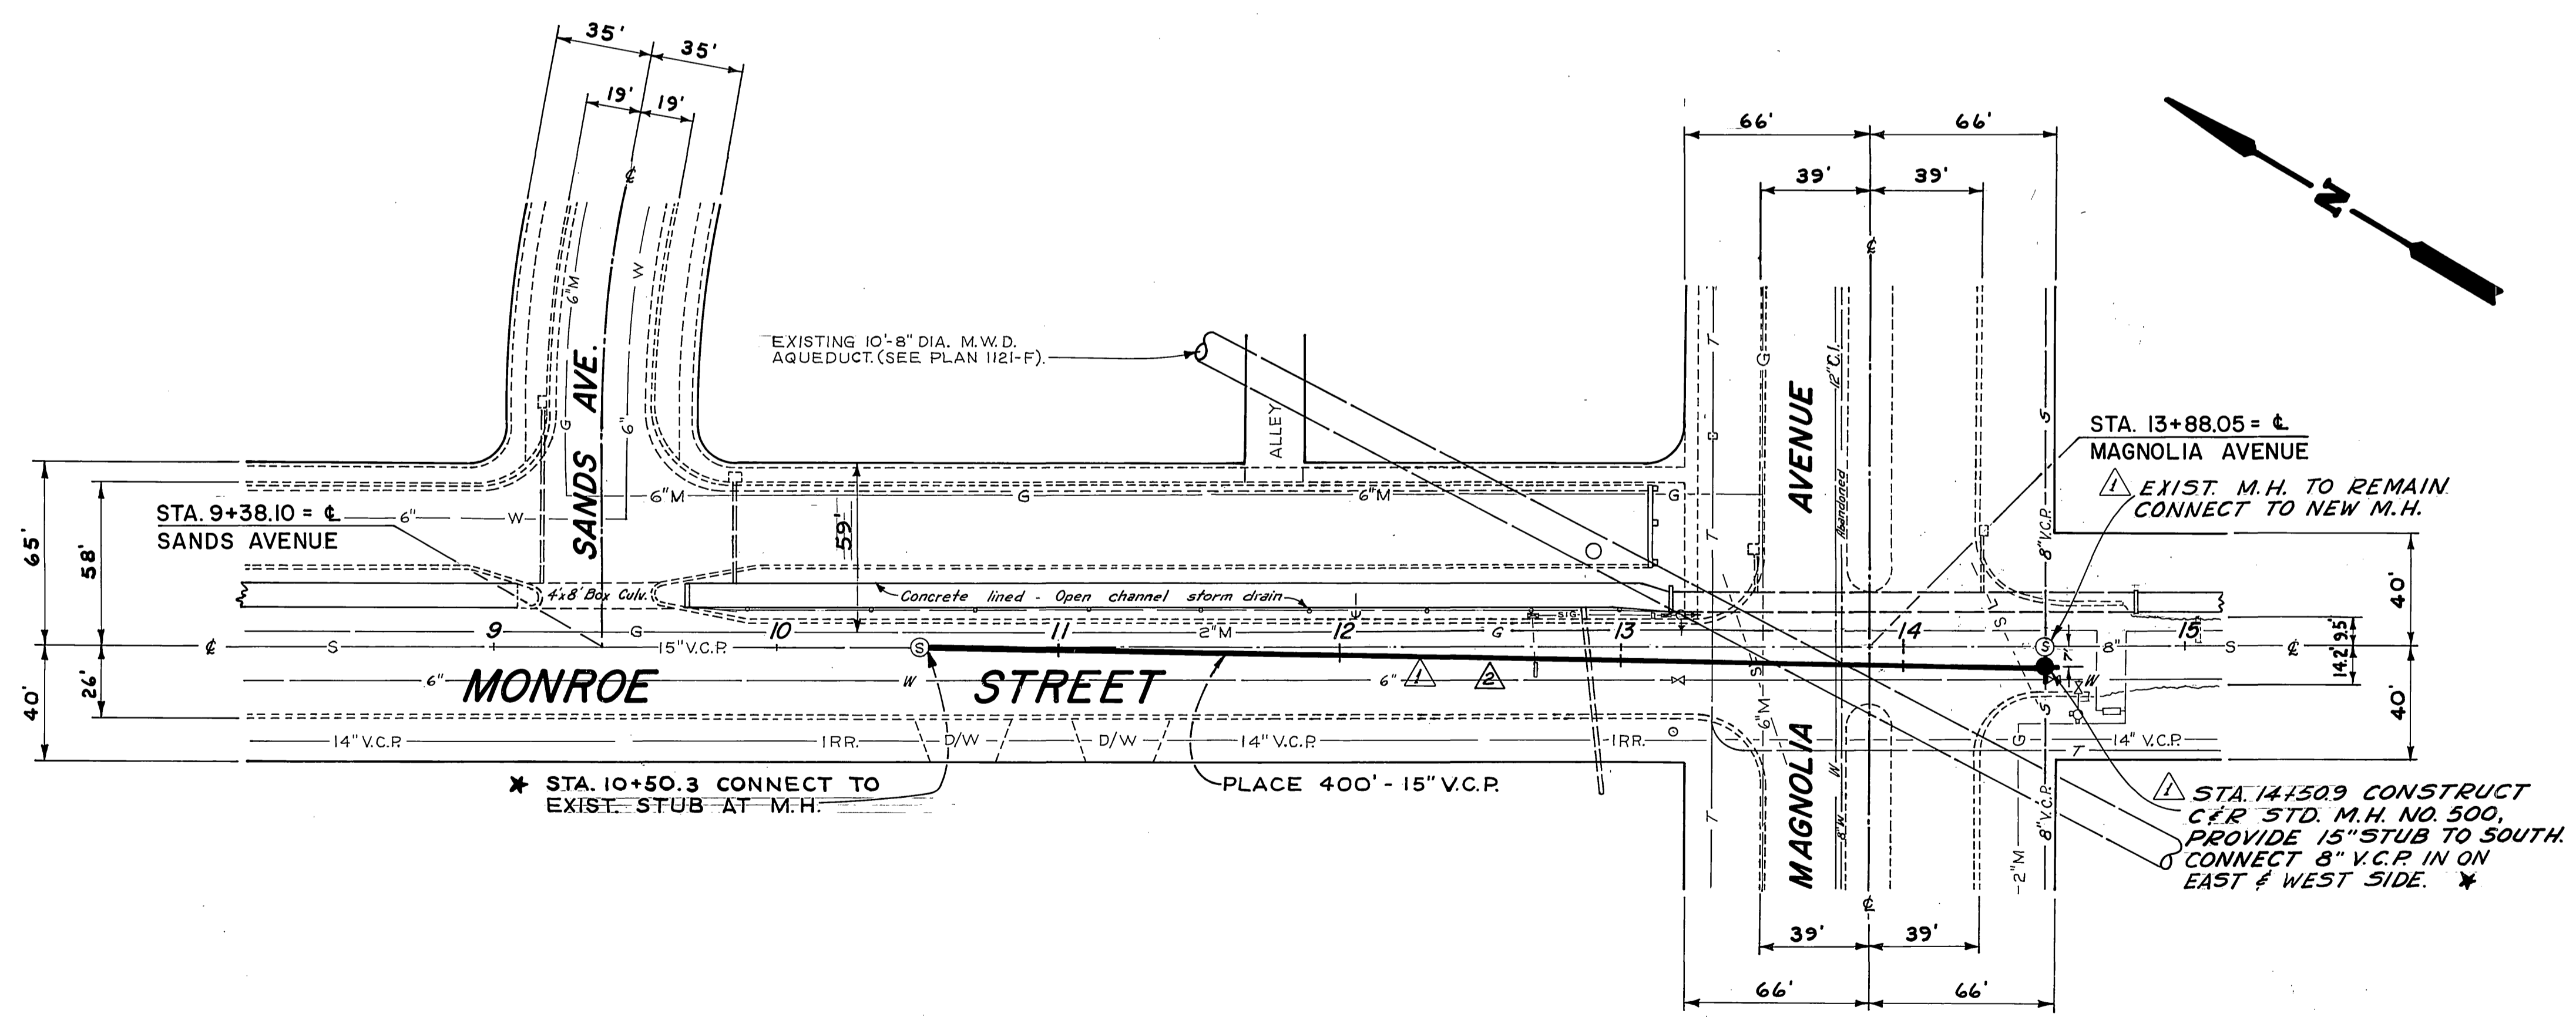

* AS BUILT 3/23/66 gma/lb

Relocated Manhole <i>DO NOT</i> <i>SR</i> <i>DM</i> 2-9-66 AS BUILT <i>DO NOT</i> 3-1-66		CITY OF RIVERSIDE, CALIFORNIA DEPARTMENT OF PUBLIC WORKS		INDEXED R.R. PROJECT NO. 5085	
APPROVED BY: <i>[Signature]</i> DATE: 2-9-66 OFFICE ENGINEER: <i>[Signature]</i> DATE: 12-27-65		APPROVED BY: <i>[Signature]</i> DATE: 12-29-65 DIRECTOR OF PUBLIC WORKS		MONROE TRUNK SEWER AT MAGNOLIA	
MARK: REVISIONS: APPR. DATE:		DESIGNED BY: <i>[Signature]</i> DRAWN BY: <i>[Signature]</i> CHECKED BY: <i>[Signature]</i>		SHEET 1 OF 1	
HORIZ. SCALE: 1" = 40' VERT. SCALE: 1" = 4'				FILE NO.	