


POLICE BUILDING-SEWER REPLACEMENT-ALLEY BET. ORANGE & LEMON STS. S/O ELEVENTH ST

AS BUILT 4-5-65

S-688  
1 of 1


DATE	4-5-65
BY	[Signature]
CHECKED BY	[Signature]
SCALE	1" = 10'-0"



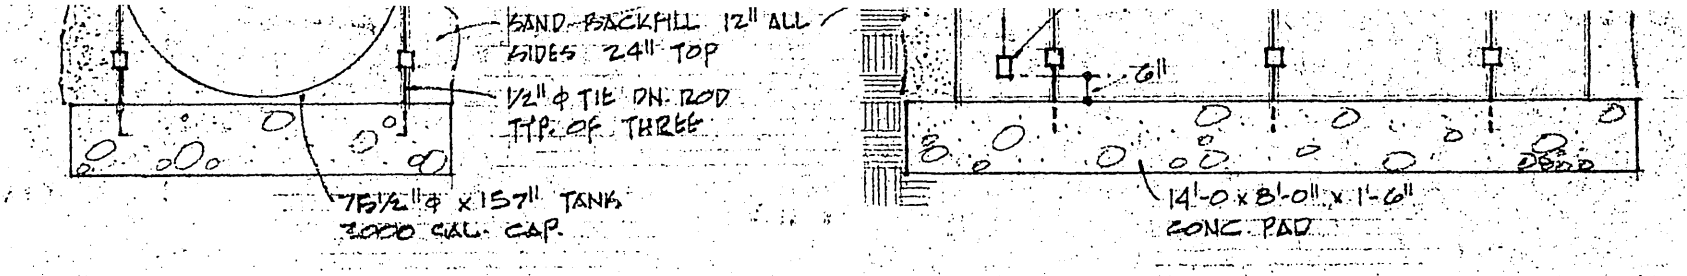


H.B.	HOUSE
W.C.	WATER
P.O.	PLUMB
E.R.	ROOF
W.C.	WATER
U.	URINAL
LAV.	LAVATORY
S.	SINK
S.S.	SERVICE
D.F.	DESK
SH.	SHOWER
S.W./C.O.	SINK
A.P.	ACCESS
GALV.	GALVANIZED
C.I.	CAST IRON
V.C.P.	VITRIFIED CLAY PIPE
FIN. FLE. EL.	FINISH FLOOR ELEVATION
INV. EL.	INVERT ELEVATION
P.O.C.	POINT OF CONNECTION
CONN.	CONNECTION
W/	WITH
TYP.	TYPICAL
D.B.T.	DETAIL
SHT.	SHEET
CONT.	CONTINUED
EXIST.	EXISTING
FIN.	FINISH
FLE.	FLOOR
FR.	FROM
ABV.	ABOVE
BELO.	BELOW
CL.G.	CEILING
BLDG.	BUILDING
MIN.	MINIMUM
MECH.	MECHANICAL
EQUIP.	EQUIPMENT
R.M.	ROOM
N.P.C.	NOT

FUEL OIL STORAGE TANK SCALE 1/4" = 1'-0" DETAIL A P-1

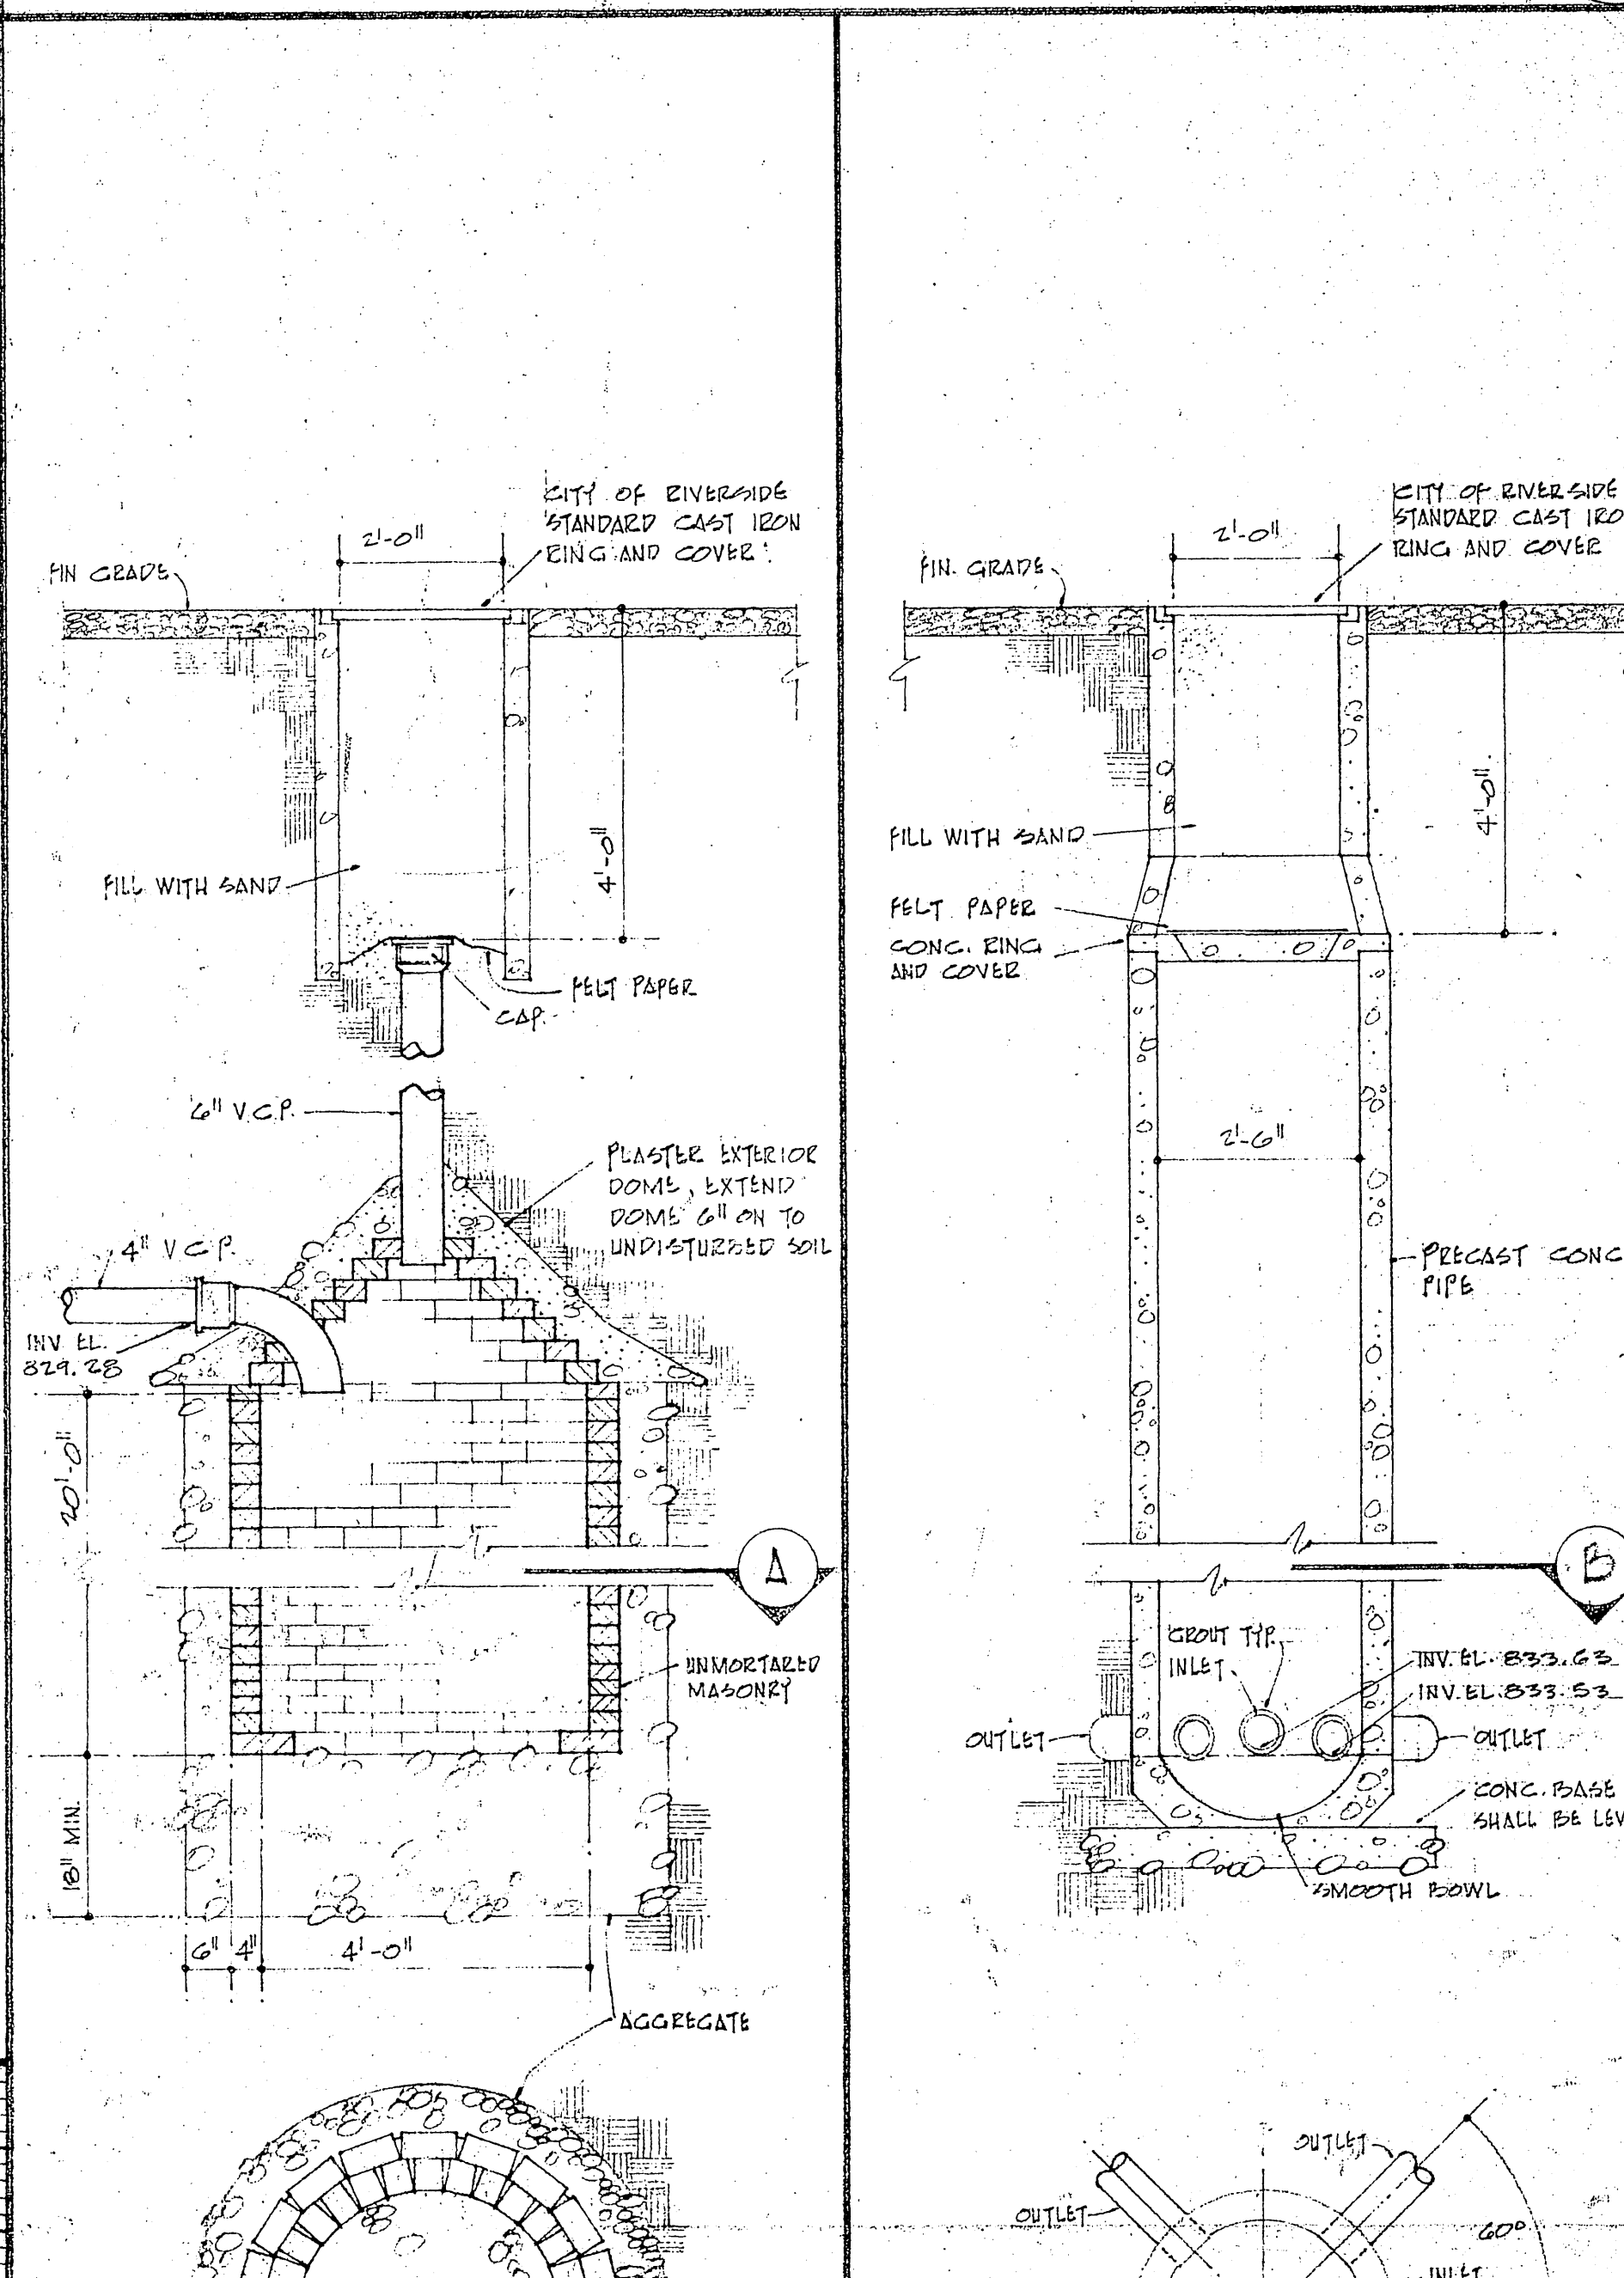


1. PUMP
2. THE CONNECTION COMPLETE
3. THESE PLANS PLUMBING FROM THE
4. INSTALL ALL MECHANICAL
5. ALL WASTE WATER ATHERN
6. INSTALL SHALLOW

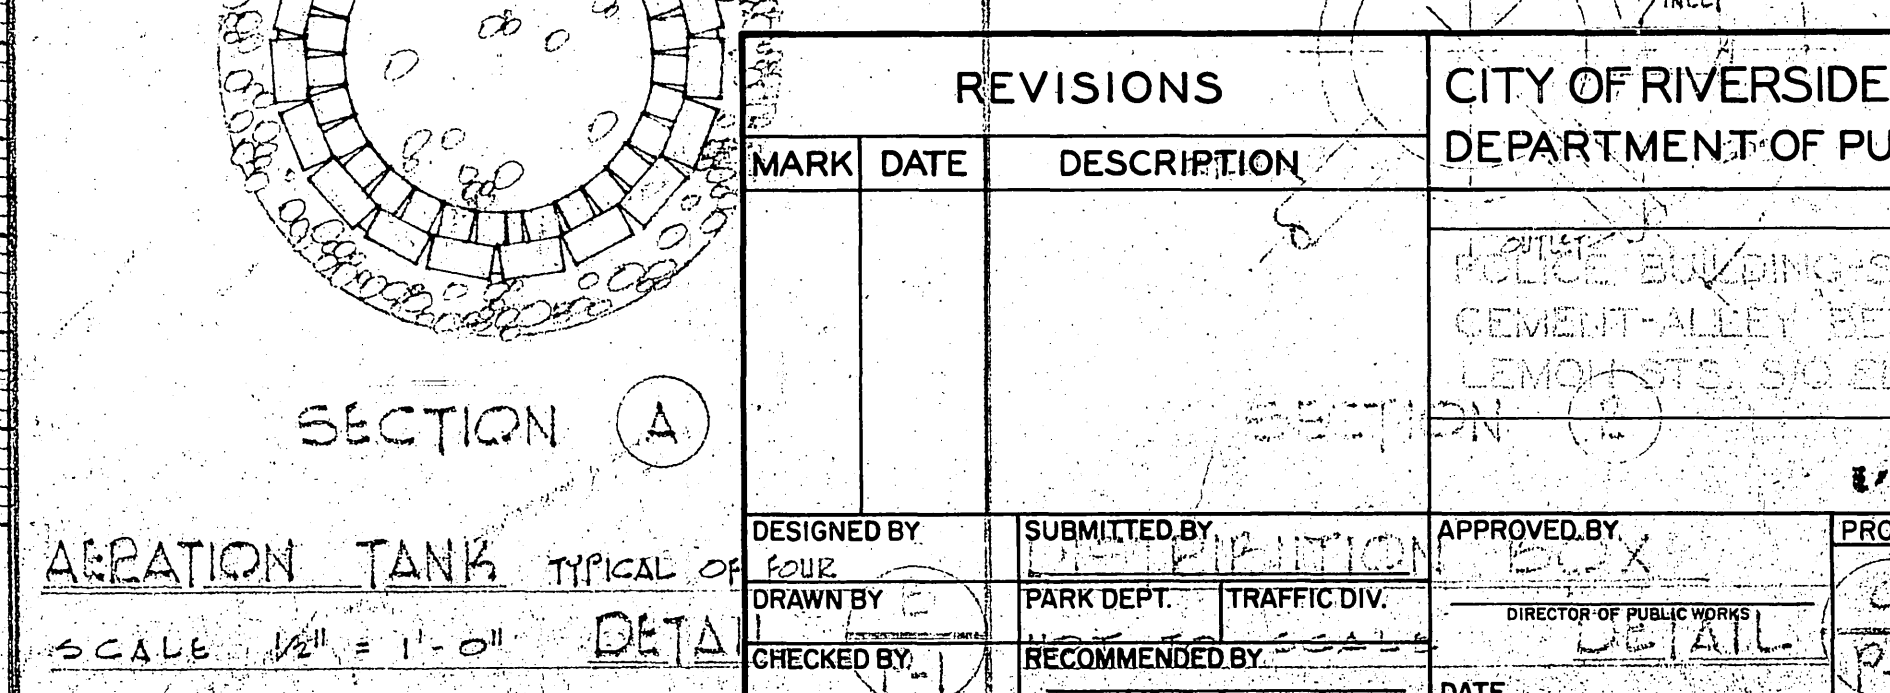


REVISIONS		CITY OF RIVERSIDE, CALIFORNIA DEPARTMENT OF PUBLIC WORKS	
MARK	DATE	DESCRIPTION	


DESIGNED BY: [Signature] SUBMITTED BY: [Signature] APPROVED BY: [Signature] PROJ. NO. 688  
 DRAWN BY: [Signature] PARK DEPT. TRAFFIC DIV. DIRECTOR OF PUBLIC WORKS  
 CHECKED BY: [Signature] RECOMMENDED BY: [Signature] DATE: [Signature] SHEET 1 OF 1

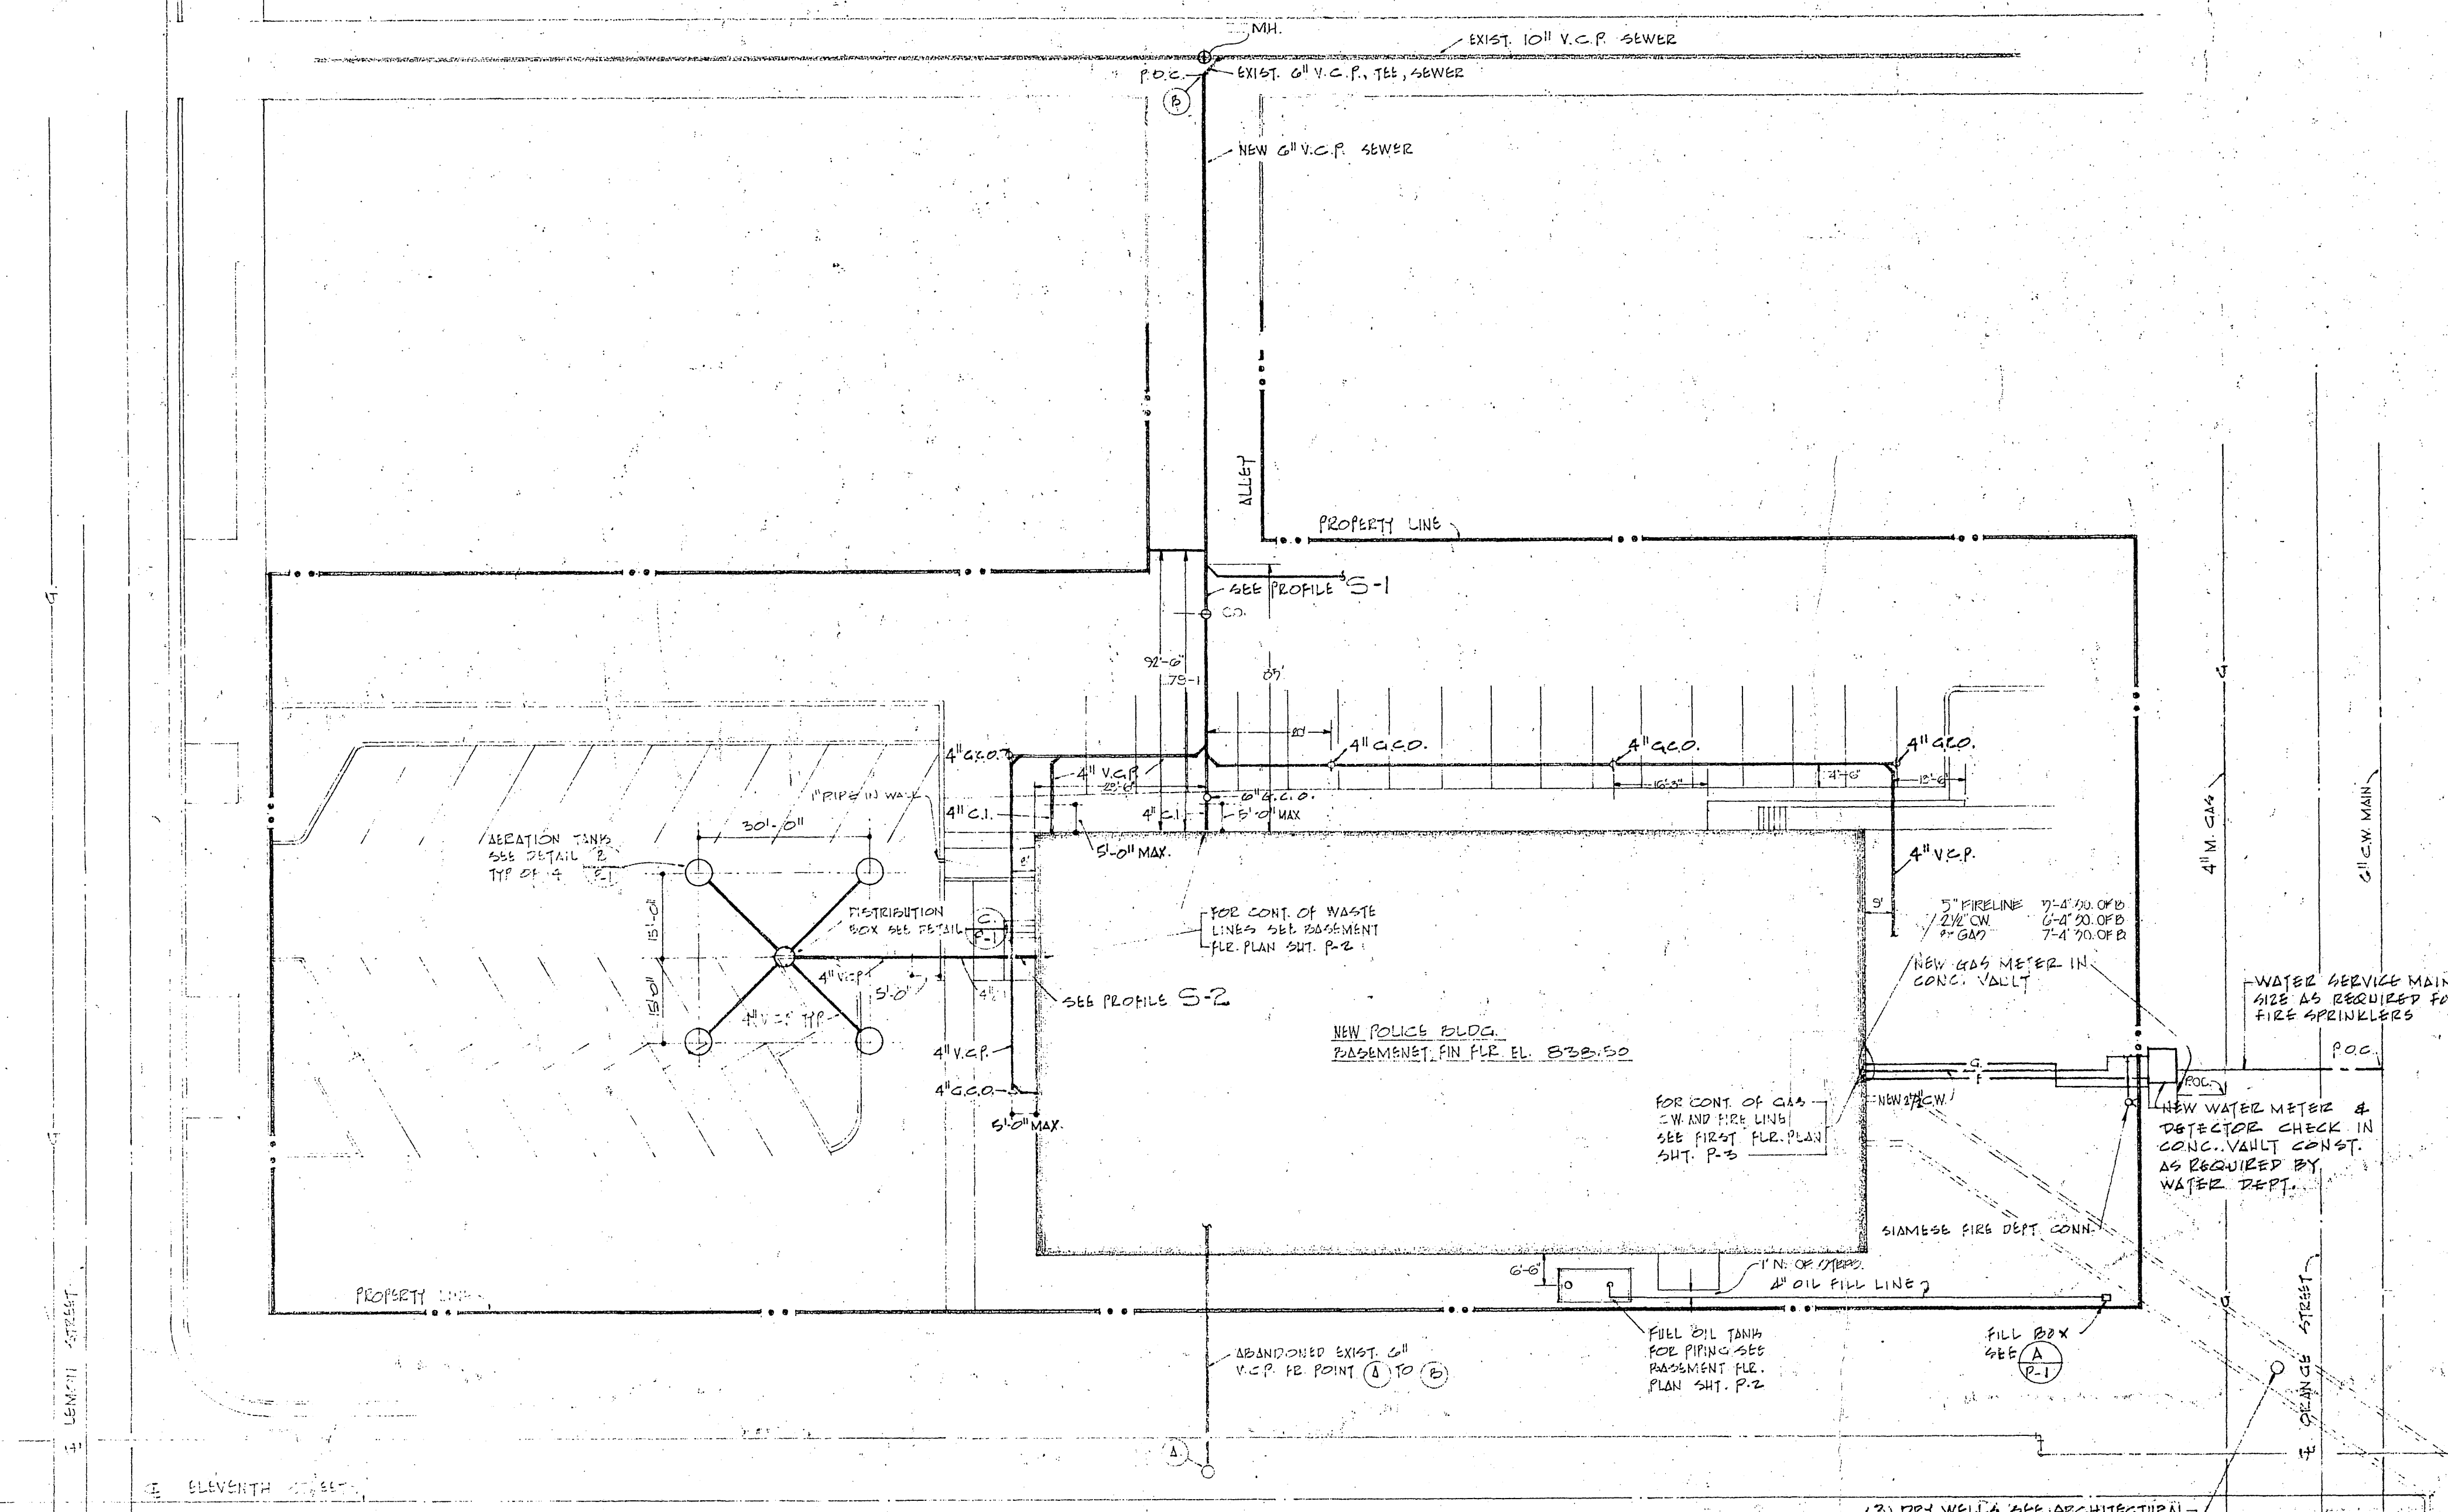

PLOT PLAN SCALE 1" = 20'-0"

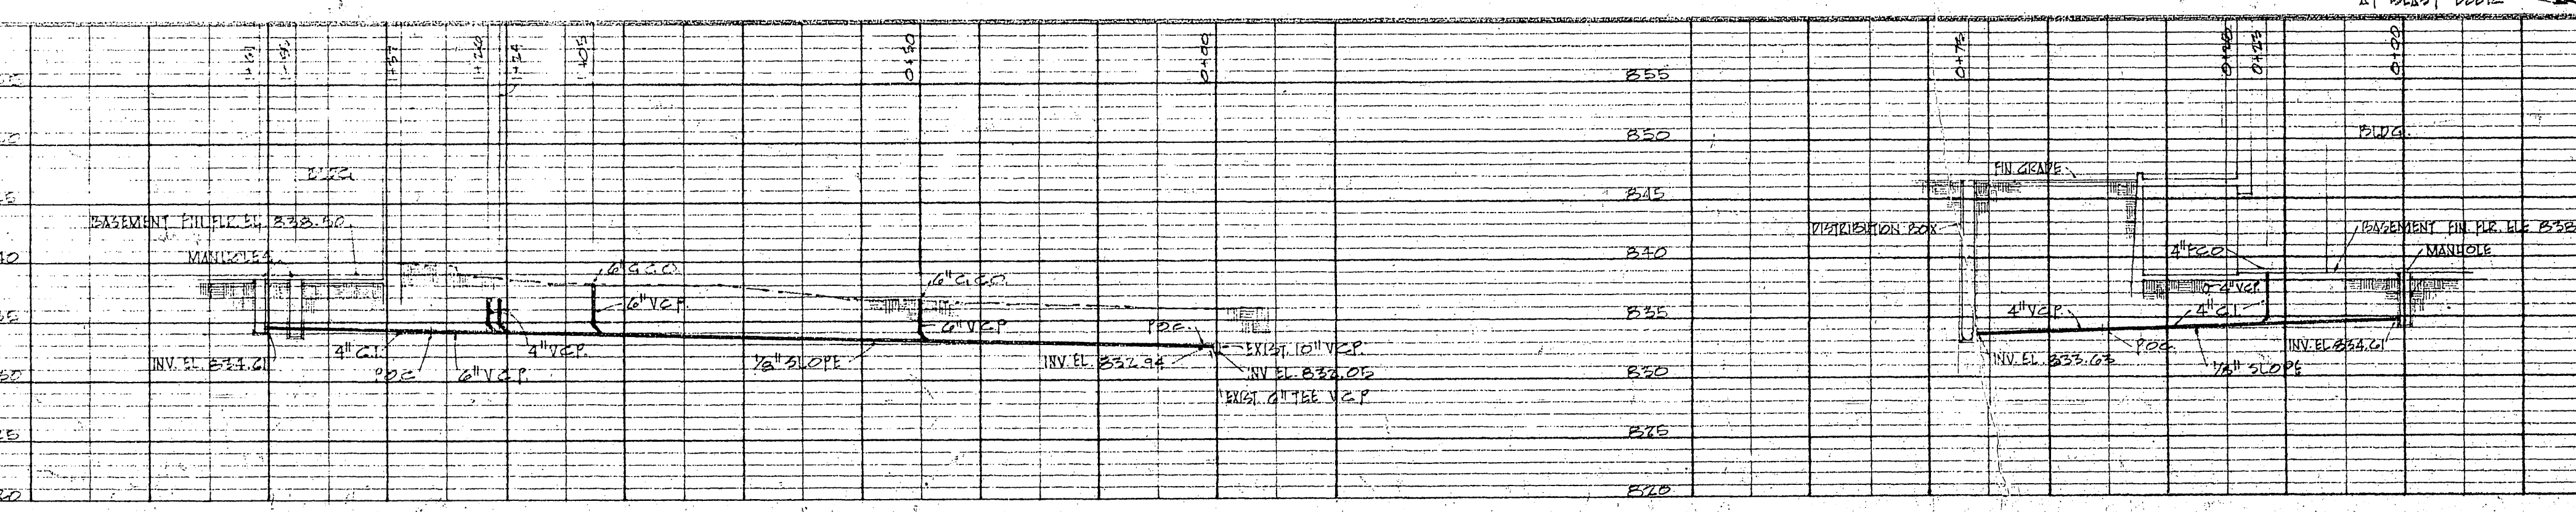

PROFILE S-1 SCALE HORIZ. 1" = 20'-0" VERT. 1" = 10'-0"

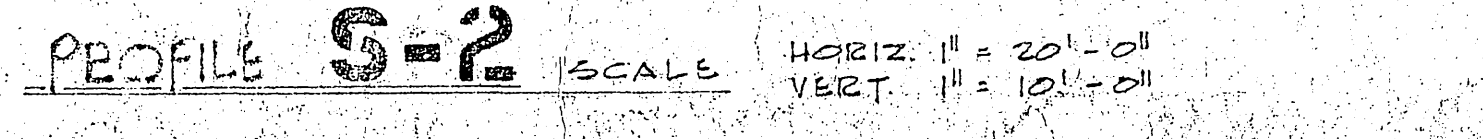

PROFILE S-2 SCALE HORIZ. 1" = 20'-0" VERT. 1" = 10'-0"

POLICE FACILITIES BUILDING  
 CITY OF RIVERSIDE  
 RIVERSIDE CALIFORNIA

REVISIONS	DRAWN BY PUGHASTY	STORMS & LOWE Consulting Engineers 2825 WEST VERNON AVE. LOS ANGELES 8, CALIF. PHONE AKAMINSTER 5-8491
	CHECKED BY	
	DATE DEC. 62	
COMMISSION NO. 6015001.15		

RUHNAU-EVANS-BROWN & STEINMANN  
 architecture engineering planning  
 MISSION INN ROTUNDA RIVERSIDE CALIFORNIA  
 BRANDOW & JOHNSTON CONSULTING ENGINEERS